



Addendum Number: ADD-02  
Addendum Date: 01.25.23  
  
Project Number: 19-040  
Project Name: Wentzville Public Works  
Owner: City of Wentzville, MO




**Documents:**

1. WPW Pre-Bid Agenda & Meeting Notes
  - a. Refer to attached pre-bid agenda and meeting notes from pre-bid conference held 01-19-23.
2. WPW Bidding RFI Responses 01-24-23
  - a. Refer to attached requests for information received from bidding contractors through 01-24-23 and corresponding responses.
3. Exhibit D- Scope of Work
  - a. Refer to attached document which includes revisions and additional information as a result of pre-bid meeting and E-bidding system questions.
4. Exhibit G- Substitution Procedures & Form
  - a. Refer to attached document which includes revised specification sections.

**Specifications:**

1. 000101 – Table of Contents
  - a. Revised to accommodate added sections.
2. 002600 – Procurement Substitution Procedures
  - a. Revised requests for substitutions deadline date provided in section 1.4-A-1.
3. 012500 – Substitution Request Form
  - a. Revised requests for substitutions deadline date
4. 019113 – General Commissioning Requirements
  - a. Added specification section.
5. 042200 – Concrete Masonry Units
  - a. Removed section 1.1-A-2 as product is not required for project.
  - b. Removed section 1.4-C as product is not required for project.
  - c. Revised section 1.5-B to reflect mockup panel requirements using materials required for project.
  - d. Revised section 2.2-B to add additional product requirements.
  - e. Removed section 2.2-C as product is not required for project.
  - f. Revised section 2.4-E-1 mortar color requirements.
  - g. Revised section 2.4-I water-repellent location and product requirements.
  - h. Removed section 2.7 as materials are not required for product.
6. 064116 – Plastic Laminate Clad Architectural Cabinets
  - a. Added specification section.
7. 072100 – Thermal Insulation

THIS ADDENDUM AMENDS THE DRAWINGS AND SPECIFICATIONS OF THE ABOVE-REFERENCED PROJECT AND IS  
HEREBY INCORPORATED INTO THE CONTRACT DOCUMENTS AS A PART THEREOF.

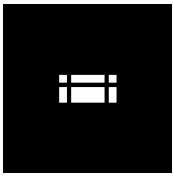


- a. Revised section 1.1-A to indicate products required for project within specification.
  - b. Revised section 2.1 to add product required for project.
  - c. Revised section 2.2-B to indicate where product is required for project.
  - d. Revised section 2.4-B to indicate correct thickness and R-value noted in section details.
  - e. Added section 2.4-C to provide information for product required for project.
- 8. 074113 – Metal Roof Panels
  - a. Added specification section.
- 9. 074213 – Metal Wall Panels
  - a. Added specification section.
- 10. 099123 – Painting & Coating
  - a. Revised section 2.3-A to reference product required for project.
- 11. 133419 – Metal Building Systems
  - a. Revised section 2.5 to reference section 072100 for insulation
- 12. 230913 – Instrumentation and Control Devices for HVAC
  - a. Revised sections 2.5 F & G to clarify that CO and NO2 sensors within the fleet maintenance building shall be provided as part of the vehicle emission monitoring system.
- 13. 235500 – Fuel Fired Heaters
  - a. Added Superior Radiant Products as an acceptable manufacturer for High Intensity Radiant heaters.
- 14. 323115 – Chain-link Fences & Gates
  - a. Revised section 2.2-A to indicate correct requirements.
  - b. Revised section 2.2-C to indicate correct requirements.
  - c. Removed section 2.6-D as gate padlocks not required for project.
  - d. Revised section 2.6-E to indicate correct post type noted in gate drawing details


**Drawings:**

- 1. C-001 – General Notes
  - a. Revised Earthwork Calculations to match bid instructions for rock.
- 2. C-300 – Grading Plan, C-400 – Utility Plan, C-500 – Erosion Control Plan, C-600 – Storm Sewer Profiles, C-601 – Storm Sewer Hydraulics
  - a. Revised Storm Alignment for 202-200.
  - b. Revised Conduit Layout for C-400.
- 3. C-603 – Detention Basin Details
  - a. Revised Basin Alignment Profile due to the revised storm sewer alignment.
- 4. C-900 – Proposed Drainage Area Map
  - a. Revised due to revised storm sewer alignment.
- 5. S000 – General Notes
  - a. Modified: masonry compressive strength to updated ASTM minimum.




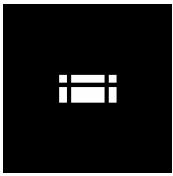

6. S001 – Special Inspections & B.F.D.
  - a. Modified: base shear and seismic response coefficients in basis for design.
  - b. Modified: basic wind speeds in basis for design.
  - c. Added: PEMB deflection criteria to basis for design.
7. S002 – Schedules
  - a. Added: concrete pedestal schedule.
  - b. Modified: base plate type C, multiple column schedule fields.
8. S003 – Typical Details
  - a. Added: V/S003 showing typical detail of exterior steel column foundation at site paving.
9. S101 – Foundation Plan – Overall
  - a. Modified: grids and dimensions coordinating with changes on subsequent sheets.
10. S101A – Foundation Plan – Area A
  - a. Modified: foundation elevations near watershop and truck loading dock.
  - b. Added: multiple concrete pedestals north of truck loading dock.
  - c. Added: multiple section cuts to plan.
11. S101B – Foundation Plan – Area B
  - a. Added: multiple section cuts to plan.
  - b. Added: dimensions to typical slab drains at overhead doors.
12. S101C – Foundation Plan – Area C
  - a. Added: multiple section cuts to plan.
  - b. Added: plan note at elevated slab for added clarity.
  - c. Modified: several pad footing sizes and locations near mezzanine area.
  - d. Added: dimensions to typical slab drains at overhead doors.
13. S201 – Foundation Details
  - a. Modified: M/S201 reinforcement callout and added text note.
  - b. Added: multiple new details (N, P, Q) to sheet
14. S202 – Foundation Details
  - a. Modified: F/S201 dowel connection in elevated slab.
  - b. Added: multiple new details (G, H, J, K, L) to sheet.
15. S401A – Roof Framing Plan – Area A
  - a. Added: pre-engineered canopy to plan.
  - b. Added: multiple section cuts to plan.
16. S401B – Roof Framing Plan – Area B
  - a. Added: multiple section cuts to plan.
  - b. Modified: several detail callouts.
17. S401C – Roof Framing Plan – Area C
  - a. Added: multiple section cuts to plans.
  - b. Added: plan blowup/callout at mezzanine.

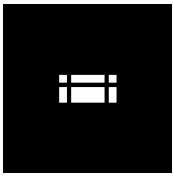

- c. Modified: several detail callouts.
  - d. Modified: elevations of several framing elements, including CMU walls and steel beams.
  - e. Modified: beam sizes & reactions at crane rail support.
18. S501 – Framing Details
- a. Modified: A/S501 and F/S501, added lateral deflection criteria note for PEMB supplier at crane rail locations.
  - b. Added: multiple new details (E, F) to sheet.
19. S502 – Framing Details
- a. Reorganized sheet.
  - b. Modified: details A and E to different plan locations.
  - c. Modified: details A, C, and D to separate fleet wall panel from low roof deck.
20. S505 – Framing Details
- a. Modified: detail D/S505 to show full kicker connection.
  - b. Added: multiple new details (E, F, G, H) to sheet.
21. S506 – Framing Details
- a. Added sheet to set with multiple new framing details
22. E000 Electrical Legend
- a. Revised - low voltage wire to reference specifications for raceway requirements.
23. E100 Electrical Site Plan
- a. Revised - future vehicle charging conduits to be under panel SBAB.
  - b. Added - wall pack to water shop corner of building.
  - c. Added - keynote and vehicle detector loop to motorized gates.
  - d. Revised – parking lot lighting detail to remove structural base dimensions.
24. E100A Electrical Site Photometrics
- a. Revised - exterior lighting due to wall-pack change.
25. E101A Lighting Level 1 RCP – Area A
- a. Added - emergency load control relay to Water Shop.
26. E101B Lighting Level 1 RCP – Area B
- a. Added - emergency load control relay to Sign Shop and Street Storage.
27. E102 Lighting Level 1 RCP – Wash & Salt Storage Buildings
- a. Revised - lighting controls for wash bay to use wet location occ sensors.
28. E201A Power Level 1 Plan – Area A
- a. Added - third section to panel SBAB.
  - b. Added - receptacle for second break room microwave.
  - c. Added - receptacle and switch for break room garbage disposer.
  - d. Revised - air compressor disconnect to 2-pole.
29. E201B Power Level 1 Plan – Area B
- a. Revised - air compressor disconnect to 2-pole.
  - b. Revised - overhead door power to include contactor.
30. E201C Power Level 1 Plan – Area C

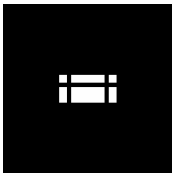


- a. Revised - disconnects for air compressor to fused disconnects.
- b. Revised - overhead door power to include contactor.
- 31. E202 Power Level 1 Plan – Wash & Salt Storage Buildings
  - a. Revised - disconnects for equipment in brine control to 2-pole.
  - b. Revised - overhead door disconnects to be Nema 4X.
- 32. E301A Equipment Connection Level 1 Plan – Area A
  - a. Revised - location of VAV 1-5.
  - b. Removed - Equipment Connection Schedule.
- 33. E301B Equipment Connection Level 1 Plan – Area B
  - a. Added - generator remote shutdown switch in main electrical room.
  - b. Removed - Equipment Connection Schedule.
- 34. E301C Equipment Connection Level 1 Plan – Area C
  - a. Revised - connection to MAU-1.
  - b. Removed - Equipment Connection Schedule.
- 35. E302 Equipment Connection Level 1 Plan – Wash & Salt Storage Buildings
  - a. Removed - Equipment Connection Schedule.
  - b. Revised – wash bay unit heaters to 15KW at 480V.
- 36. E303B Equipment Connection Roof Plan – Area B
  - a. Revised - connection to RTU-1.
  - b. Removed - Equipment Connection Schedule.
- 37. E303C Equipment Connection Roof Plan – Area C
  - a. Removed - Equipment Connection Schedule.
- 38. E400 Lighting Schedules
  - a. Revised - illumination for parking lot light fixtures.
  - b. Revised - wall pack illumination and internal control.
  - c. Revised - standalone high bay occ sensors to be wet location.
  - d. Revised - automatic load control relay to include 0-10V override.
  - e. Added - alternate manufacturers to various fixture types.
- 39. E401 Lighting Schedules
  - a. Revised - relay panel schedule LCP-EM to remove area's A & B.
  - b. Revised - automatic load control detail to include 0-10V dimming override.
- 40. E500 Electrical One-Line Diagram
  - a. Added - third section to panel SBAB.
  - b. Added - shunt trip to future PV breaker in SWBD-N.
  - c. Revised - wire size to transformer SBBA for voltage drop.
- 41. E502 Electrical Schedules
  - a. Revised - fault current and voltage drop calculation table.
- 42. E503 Panel Schedules
  - a. Added - third section to panel SBAB.
  - b. Added - main breaker to panel SBAA.
  - c. Added - connections to break room garbage disposer and microwave.
  - d. Revised - VAV breakers in panel SBA1.
  - e. Revised - connection to RTU-1.
  - f. Revised - panel AIC ratings to reference short circuit calculation table.
- 43. E504 Panel Schedules


THIS ADDENDUM AMENDS THE DRAWINGS AND SPECIFICATIONS OF THE ABOVE-REFERENCED PROJECT AND IS  
HEREBY INCORPORATED INTO THE CONTRACT DOCUMENTS AS A PART THEREOF.



- a. Revised - connection to MAU-1.
  - b. Revised - panel AIC ratings to reference short circuit calculation table.
  - c. Revised - breaker sizes for air compressor circuits SBF1-6,8,10 and SBF1-12,14,16.
  - d. Revised - breaker sizes for 3 post lift circuit SBF1-18,20,22.
44. E505 Panel Schedules
- a. Revised - wire size for circuit SBW1-1.
  - b. Revised - panel SBBA to be Nema 4X.
  - c. Revised - panel AIC ratings to reference short circuit calculation table.
  - d. Revised - breaker and wire size for power washer circuit SBW1-8,10,12.
  - e. Revised - wash bay unit heater connection to match floor plan.
45. E600 Electrical Details and Schedules
- a. Revised - parking lot pole base receptacle detail to show orientation.
  - b. Added - overhead door master control panel detail.
46. TN100 Technology Site Plan
- a. Removed – devices in rear parking lot.
  - b. Removed – keynote TN31.
47. P101A Plumbing Level 1 Plan – Area A
- a. Added - floor drain for water shop 217
  - b. Revised – Sanitary and vent piping to connect to both new floor drain and trench drain
  - c. Added – gas piping to route from main building plan south to wash bay
48. P101B Plumbing Level 1 Plan – Area B
- a. Revised – Updated storm inverts
  - b. Revised – Updated Sanitary invert for civil
  - c. Revised – Updated storm downspout inverts
  - d. Revised – Updated gas piping to be no smaller than ¾" and added tags downstream of GPR(s)
  - e. Updated – Added IMB and cold water piping with shutoff valve for refrigerator in breakroom
  - f. Revised – Added hydrant detail callout
28. P101C Plumbing Level 1 Plan – Area C
- a. Revised – Storm downspout invert
  - b. Revised – SOI1 invert for civil
  - c. Removed – Sanitary piping for FD that is no longer needed on mezzanine.
  - d. Added – Floor drain for warehouse equipment and revised sanitary and vent piping connecting to the mezzanine.
  - e. Revised – Removed Floor drain and associated sanitary and vent piping in room 431
29. P102 – Wash and Salt Storage
- a. Added - Routed gas pipe from main building plan north for equipment in wash bay
  - b. Revised – Updated SOI2 inverts and sanitary inverts for civil
  - c. Revised – Updated vent piping
30. P203B – Plumbing Roof Plan – Area B
- a. Added – Gas piping size

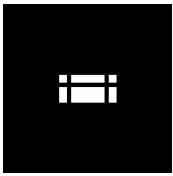

31. P203C – Plumbing Roof Plan – Area C
  - a. Removed – VTR and detail callout for mezzanine FD removed
32. P300 – Plumbing Sanitary Riser
  - a. Updated – Updated riser sections to reflect new changes for addendum
33. P301 – Plumbing Sanitary Riser
  - a. Updated – Updated riser sections to reflect new changes for addendum
34. P400 – Plumbing Enlarged Plans
  - a. Added – Hose bibb to Street Storage.
35. P401 – Plumbing Enlarged Plans
  - a. Revised – Floor drain in mechanical room revised for clarity
  - b. Updated – Added gas pipe tag size and gas load
  - c. Updated – Removed garbage disposal
  - d. Updated – Added hose bibb to mud room and men's locker room
  - e. Updated – Added cold water piping, backflow, and shutoff for Ice Machine
  - f. Updated – Added dishwasher callout
  - g. Updated – Added WCOs to the fixtures in the women's locker room
  - h. Updated – Added shower floor in women's locker room
36. P402 – Plumbing Enlarge Plans
  - a. Updated – Sanitary instead of plan south will go plan east to connect to new drain in area A and connect to trench drain in area A.
  - b. Removed – Sanitary and vent piping plan south to connect to trench drain
37. P403 – Plumbing Enlarged Plans
  - a. Updated – gas piping to MAU on mezzanine with size and tag.
  - b. Revised – Updated FD location and added condensate with detail callout
  - c. Removed – FD plan north of MAU with associated sanitary and vent
38. P501 – Plumbing Details
  - a. Updated – Added new ice machine detail
  - b. Removed – Old ice machine detail and beverage dispenser detail
  - c. Removed – VTR detail and all associated callouts on P203A, P203B, P203C
39. P600 – Schedules
  - a. Updated – Gas pressure regulator schedule to accurately reflect equipment needs
  - b. Added – Gas pressure sizing schedule for wash bay gas piping.
  - c. Removed – Garbage disposal removed from fixture schedule
  - d. Added – DCV to schedule
  - e. Added – Shower floor to schedule
40. FP101A – Fire Protection Plan – Area A
  - a. Added – TYCHO LFP Antifreeze system to Northeast corner of Water Shop to serve loading docks.
  - b. Added -- associated keynotes for antifreeze system
41. FP500 – Fire Protection Details
  - a. Added – added detail for Tycho LFP antifreeze system.
42. M101A – Mechanical HVAC Level 1 Plan – Area A
  - a. Added – Plan Note M55 requiring an access panel for VAV 1-06.
43. M101B – Mechanical HVAC Level 1 Plan – Area B

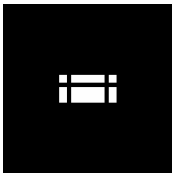

- a. Revised – Note M45 for revised RA duct size.
- 44. M101C – Mechanical HVAC Level 1 Plan – Area B
  - a. Added – 26"x12" transfer grille and duct.
- 45. M600 – Mechanical Schedules
  - a. Revised – MAU Schedule Note B.
- 46. M601 – Mechanical Schedules
  - a. Revised – Sizes of UH-10 and UH-11.
- 47. M702 – Mechanical Controls
  - a. Revised – Exhaust fan controls.
  - b. Added – Generator monitoring controls

**Attachments:**

Documents

WPW Pre-Bid Agenda & Meeting Notes, WPW Bidding RFI Responses 01-24-23, Exhibit D- Scope of Work, Exhibit G- Substitution Procedures & Form

Specifications

000101, 002600, 012500, 019113, 042200, 064116, 072100, 074113, 074213, 099123, 133419, 230913, 235500, 323115

Drawings

C-100, C-300, C-400, C-500, C-600, C-601, C-603, C-900, S000, S001, S002, S003, S101, S101A, S101B, S101C, S201, S202, S401A, S401B, S401C, S501, S502, S505, S506, E000, E100, E100A, E101A, E101B, E102, E201A, E201B, E201C, E202, E301A, E301B, E301C, E302, E303B, E303C, E400, E401, E500, E502, E503, E504, E505, E600, TN100, P101A, P101B, P101C, P102, P203B, P203C, P300, P301, P400, P401, P402, P403, P501, P600, FP101A, FP500, M101A, M101B, M101C, M600, M601, M702

## New Public Works Facility Wentzville, Missouri

### Pre-Bid Conference **Agenda & Meeting Notes** General Construction Bid Package January 19, 2023 – 10:00am

1. Introductions
  - a. Wentzville, Missouri
    - i. Susan Spiegel – Director of Public Works
    - ii. Devon Dezort – Assistant Director of Public Works
    - iii. Alice Winkelman – Procurement Manager
  - b. Navigate Building Solutions, LLC will be the Construction Manager
    - i. Jen Kissinger- Director
    - ii. Ray Hutsel – Senior Project Manager
  - c. hdesigngroup - Architects
    - i. Bryon Oster – Project Manager/Associate
2. Project Overview:
  - a. The scope of work for the project includes construction and site improvements for a new Wentzville Public Works Facility to be located at 1295 Interstate Drive (site is located southeast of Interstate Drive and Wilmar Road) in Wentzville, Missouri. The project consists of a new 49,000 sf, one story, Public Works building, which will be the new home for the Public Works Administrative offices, the Water, Street, Stormwater, and Signal operations. Also, the Fleet and Facility Operations. The complex will also include a new 2,235 sf Wash Building, a new 10,530 sf, fabric and concrete block Salt Storage structure, and some covered parking.
  - b. The project includes several bid alternates that also will be considered for award.
  - c. Project will be a single General Contractor bid package. All subcontractors shall submit bids to known GC bidders. Reference City website for list of plan holders.
  - d. **FULL SCOPE OF WORK ISSUED IN BID DOCUMENTS. BIDDER MUST REVIEW ALL DOCUMENTS PRIOR TO BID.**
  - e. Contracts will be held by the City.
  - f. Project Construction Cost Estimate is \$28 to \$29 million
3. A non-mandatory site visit for bidders to walk the property will be held following this meeting.
4. **Bidders are required to submit their bid response electronically through the City's E-bidding system no later than 2:00 PM Central Time on February 16<sup>th</sup>, 2023.**  
Bids received after 2:00 PM will not be accepted.  
  
**Fax or email bids will not be accepted.**  
  
Bids submitted to NAVIGATE's office **will not** be accepted.  
  
**No late bids will be accepted.**
5. No public bid opening will be held. Through the City's E-Bidding system, bidders have had the ability to view the bid tabulation from any computer or mobile device as soon as the bid is electronically unsealed / opened.

When the City electronically unseals the bid, the bid tabulation will be immediately available on the E-Bidding system on our website at <https://wentzvillemo.ionwave.net/Login.aspx>. When you get to the log-in screen, you do not need to log-in. Just click "Closed Bids"; then click that particular bid. (The bid will not show up under "Closed Bids" until after the bid closing date/time.) As you scroll down, you will see "Bid Tabulation".

6. Anticipated Board of Aldermen approval is March 8, 2023. We anticipate the final contract and notice to proceed on March 27, 2023.
7. Please take time to become familiar with the E-bidding platform BEFORE bid day. A lot of information and several documents are required as part of the bidding submission, so **please do not wait** until Bid Day to do this. **Uploading of several documents can be done early, so please do.**
  - a. Attributes Tab
  - b. Line Items Tab (Bid Form). All alternate pricing must be submitted at the time of the bid.
  - c. Response Attachments Tab:
  - d. Upload References Form
  - e. Upload Qualifications Form
  - f. Upload copy of Bid Bond: Each bid must be accompanied by a cashier's check or certified check, or a Bid Bond executed by the Bidder and an approved surety company payable to the Owner, in an amount not less than five percent (5%) of the sum total of the base bid. A copy must be uploaded into the E-bidding platform. The apparent first and second low bidders are required to submit their original bid bond to the City's Procurement Division within 48 hours after Bid Opening.
8. Bidders are to submit written questions through the E-bidding system. In order to ensure all potential respondents, receive the same information, the City will post its response through the E-bidding system. No verbal interpretation will be recognized; any and all such interpretations shall be confirmed in an addendum to the bid by the City. The final day to submit questions is February 6, 2023. The final addendum will be issued by February 9, 2023.

Bid Questions will be answered through the E-bidding system and also listed in any subsequent Bid Addenda. No questions will be responded to through emails or phones.
9. Product Substitutions: Requests for product substitutions will be considered during bidding. If Contractor's intends to include substitutions it shall be at the Contractor's risk and responsibility to demonstrate that the substitution is a "functional equivalent" product. Substitution request must be sent directly to Bryon Oster at hdesigngroup via email at [bryon@hdesigngroup.com](mailto:bryon@hdesigngroup.com). Refer to the bidding documents for additional requirements. Requests must be received by February 6, 2023. Approved Substitutions will be issued in an addendum. **Refer to Exhibit G – Substitution Procedures, Substitution Request Form (during bidding).**
10. Bidders are responsible for checking the City's website for the issuance of any addendums. The City of Wentzville's Bidding Opportunities website shall be the official site for information as related to this IFB.

To ensure fair consideration for all bidders, the City prohibits communication to or with any City department(s), elected officials, or employee(s) during the submission process, except as provided above. Additionally, the City prohibits communications initiated by a bidder to the City official(s) or employee(s) evaluating or considering the bids prior to the time an award decision is made. Any communication between Bidder and the City will be initiated by the appropriate City official(s) or employee(s) in order to obtain information or clarification needed to develop a proper, accurate evaluation of the bid. Such communications initiated by a bidder may be grounds for disqualifying the offending bidder from consideration for award of the bid and/or any future bid(s).



11. A payment bond and performance bond in the amount of one hundred (100%) percent of the bid amount will be required of the selected bidder. **Cost of the bond must be included in the Lump Sum Base Bid amount.**
12. Bids will be held good and may not be withdrawn for a period of 90 calendar days from receipt of bids.
13. Project is tax exempt.
14. This Supplemental Bid Information must be completed and received by the City of Wentzville in its entirety no later than 24 hours following the bid opening. The Supplemental Bid Information (Exhibit C) will be sent to all contractors submitting bids for this project through a separate action via the e-bidding system. The completed Supplemental Bid information is required to be submitted via the e-bidding system within 24 hours of the bid closing date and time (February 17, 2023 by 2:00pm). Bidders are required to submit their bid response electronically through the City's E-bidding system. Faxed or emailed bids will not be accepted. **It was clarified further in the meeting that e-bidding will not allow submission of the Supplemental Bid information (form) on the day of the bid. City of Wentzville Procurement Department will send the necessary notice to all submitted bidders directions on how to submit the Supplemental Bid information within 24 hours.**
15. The project is prevailing wage. All wages paid for work performed on site must comply with the Missouri Division of Labor Standards Annual Wage Order Number 29 for St. Charles County, Missouri.
16. Certified Payroll will be a requirement of this project.
17. Bidders shall review the City-Contractor Agreement, Scope of Work, Supplemental Contract Terms, and Exhibit F – Modifications/Explanation of the Change Order Fee issued in the bid documents. By submitting a bid, the bidders agrees to the terms in the contract.
18. The Owner will waive the building permit review and permit fees, and the Engineering review and construction permit fees only. Contractors, or subcontractors are responsible for all other fees. Refer to Exhibit D – Scope of Work for more details. Update on permitting provided. **Plans and specifications issued for permits on December 15, 2022. Engineering has completed their review, comments received and are, or will be, issued by addendum. Permit is anticipated soon. The Building Permit review is ongoing.**
19. The owner will also apply for and obtain the DNR Land Disturbance permit.
20. The Owner shall provide all quality control testing and this contractor will be responsible for coordinating with a testing agency to prepare concrete test cylinders and to perform other onsite testing work as required by the specifications and special inspections requirements. **Updated provided. RFQ issued, Statement of Qualifications received, and review is currently in progress. Post Bid Meeting Note: It was mentioned that we will provide the selected firm via addendum, but his will not be possible as the final selection/approval will not be made by 2/9/23.**
21. The owner has hired Faith Group as the commissioning agent for the mechanical and electrical systems and the building envelope testing. The GC will be responsible for coordinating with them.
22. Contractor will be responsible for all SWPPP inspections, weekly and/or after a rain events. These will be submitted to the Construction Manager weekly and within 24 hrs. of each weather event. This contractor is also responsible for installation, maintenance, and removal of the silt fence during the course of construction and at the end of construction. **It was clarified in the meeting that the City will conduct their own inspections (and provide feedback), but the GCs are responsible for all SWPP inspections.**

23. Contractor shall supply and install lockable entry gates and site fence. The contractor is responsible for preparing a Site Logistics Plan and submitting it for final approval by the construction manager and owner. Site gates shall be secured at the end of each day.
24. Contractor parking shall be onsite to the extent available. Contractors are responsible for providing any additional off-site parking/shuttle for construction trades if needed beyond the site availability. No parking on residential adjacent streets is permitted by construction trades. Otherwise, workers shall carpool to the site. Local ride-share lots are available.
25. Builder's Risk to be carried by the General Contractor. Deductibles to be paid by General Contractor.
26. The geotechnical report has been included in the bidding documents. Bidders should review these documents and Exhibit D – Scope of Work for the site clearing, site preparation, site grading, and soil remediation work below the building slab, paving, and footings. Bidders are responsible for all recommended soil remediation indicated as part of their BASE BID.
27. The contractual project duration shall be proposed by bidders in the e-bidding system Bid Form. The proposed duration will be used as key criteria along with other information on the Bid Form to select and award a General Contractor. The project duration will be incorporated into the Contract between the Owner and the General Contractor.
28. Upon execution of this contract, this contractor must submit to the CM a detailed critical path baseline construction schedule outlining each construction activity and phase. This schedule must fall within the Master Project Schedule outlined below and be submitted no later than twenty-one (21) days following execution of the contract.
29. Liquidated Damages do apply to this contract. Liquidated damages will be assigned based on the Master Project Schedule issued in the bid documents and as outlined in the draft Owner Contract.
30. The contractor will be responsible for all project as-built, including as-built surveys certified by the Land Surveyor or Engineer registered in the State of Missouri. Contractor shall provide as-built drawings in accordance with Chapter 11 of the Wentzville Engineering Design Criteria and Division 1100 of the Wentzville Standard Specifications. **It was noted that the City of Wentzville requirements will be included by addendum.**
31. The Contractor will be required to have a full-time project superintendent on site when their employees or subcontractors are present.
32. Master Project Schedule Milestone Dates (It is the responsibility of the contractor to check the e-bidding system for up to date information.):
 

Request for Bids	January 12, 2023
Pre-Bid Meeting	January 19, 2023 at 10:00 AM
Last Day for Questions & Product Substitution Requests	February 6, 2023 at 5:00 PM
Last Bid Addenda Issued (if necessary)	February 9, 2023 at 5:00 PM
Bids Due	February 16, 2023 at 2:00 PM
Supplemental Bid Information Due	February 17, 2023 at 2:00 PM
Final Board Approval	March 8, 2023
Anticipated Notice to Proceed / Mobilization	March 27, 2023
Groundbreaking	Date TBD by Owner
Critical Submittals Submitted for Review (30 or 45 calendar days after award- see Exhibit D)	
All Submittals Submitted for Review ( 120 calendar days after award - see Exhibit D)	
Topping Out Ceremony	Date TBD (Coordinated with Owner)
General Contractor Internal Pre-Punch	6 weeks prior to Substantial Completion

Substantial Completion / Punchlist Populated (Day \_\_\_\_\*)

\*Based on Bidder's proposed duration

All Life Safety Inspections & Occupancy Inspections to be completed and occupancy permit obtained on or before Substantial Completion date.

Final Completion / Completion of Punchlist

30 calendar days after Substantial Completion

Final Acceptance

90 calendar days after Substantial Completion

33. Contractor accepts all risks associated with adverse weather. No time extensions will be granted related to claims of adverse weather. No claims for extra costs will be granted related to adverse weather and/or taking action to deal with adverse weather and/or the effects of adverse weather. All provisions in the City-Contractor Agreement otherwise respecting weather are superseded by this provision, and are of no force and effect.
34. Contractor must include Professional Liability and errors and omissions insurance (to be provided by Contractor or the responsible subcontractor providing the work) for the delegated design scopes of work that are required by specifications to designed by a professional engineer. Drawings and calculations shall be signed and sealed by a Professional Engineer registered in the State of Missouri. See Scope of Work for full list of Delegated Design Items.
35. The City will cut down all large hardwood trees (greater than 8" diameter) as this work must be completed by March 31, 2023. The GC will be responsible for removing the fallen trees and stumps when completing the site demolition and clearing work. **Clarification on the size of trees to be cut down by the City will be included in future addendum.**
36. If selected for a pre-award conference, Contractor will be contacted after the bid opening by NAVIGATE. The pre-award conference will be conducted the week of February 20, 2023.
37. Contact for questions about the E-Bidding System:  
Contact: Alice Winkelman, Procurement Manager  
Phone: (636) 639-2026
38. Some questions have already been received and we are working on answers to be provided in Addendum 2. **If not included in Addendum 2, the answers will follow in the next addendum.**
39. A copy of the minutes and the Pre-Bid Sign-in Sheet will also be issued by Addendum 2. **Pre-Bid Sign-in Sheet is attached.**
40. **Question: If we are going to pursue an Alternate to Trane, does this require the submittal of a substitution request?**  
**Answer: Yes**
41. **Question: What are the Professional Liability requirements?**  
**Answer: The General Contractors subcontractors who will be delegated responsibility for design must carry a minimum of Professional Liability of \$2M per claim.**
42. **Question: Does the \$28 to \$29 million include Alternates?**  
**Answer: No.**
43. **Question: Who pays utility fees?**  
**Answer: The typical property owner/development or service agreement fees from Ameren Electric, Ameren Gas, and Brightspeed are the responsibility of the Owner. Contractor to coordinate with and provide all indicated infrastructure and installations indicated on the plans to support the public utility provided services and equipment.**

44. Question: Can the company's e-Bidding registration allow for multiple users to receive email notices of bid addendums?

Answer: Each individual that wants to receive an email need to be a user on the supplier's account. Next, each of those users needs to have "Receive Emails" checked on their profile. See screenshot:

Edit User

Save Audit / Login History

My Profile

* User Name / Login	vionwave
Title	
Prefix	
* First Name	Ion Wave Support
Middle Name	
* Last Name	CS Support
* Email	support@d.ionwave.net
Office Phone	( ) - Ext: <input type="text"/> <input type="checkbox"/> International
Fax Phone	( ) - Ext: <input type="text"/> <input type="checkbox"/> International
Mobile Phone	( ) - <input type="checkbox"/> International
* Time Zone	Central Time

To keep your existing password, leave all the Password boxes blank.

Current Password	<input type="password"/>
New Password	<input type="password"/>
Verify New Password	<input type="password"/>

Notification Preferences

Receive Emails	<input checked="" type="checkbox"/>
----------------	-------------------------------------

45. Question: Please clarify who pays for the Wentzville Fire Department Site Plan Review and New Construction permit?

Answer: The cost of the Wentzville Fire Department Site Plan Review and New Construction permit will be applied for and paid for by the City of Wentzville. All other permits required by the Wentzville Fire District will be applied for and paid for by the Contractor (subcontractors), i.e.: Fire Main Underground, Fire Sprinkler Systems, Fire Alarm Systems, etc. Reference Exhibit D – Scope of Work #17.

46. Question: Is there any settlement plate observations required?

Answer: Checking with the Geotechnical Engineer. Answer to follow in future addendum.

47. Question: Can you clarify which soil remediations are included in the Base Bid and which are not?

Answer: This question has already been asked via the e-Bidding system. Answer will be provided by addendum.

NOTE: If any of the Pre-Bid Meeting question have not been addressed, please submit them in writing via the e-Bidding system.

## Pre-Bid Meeting Attendees

Date: January 19, 2023 @ 10:00 AM

Project: City of Wentzville – New Public Works Facility

Location: Wentzville City Hall – 1001 Schroeder Creek Blvd, Wentzville, MO 63385

Name	Company	Email Address	Phone
Adam Wright	Wright Construction	Bids@WrightConstruct.com	636-220-6850
Colby Patterson	Wright Construction	Bids@WrightConstruct.com	636-220-6850
Dennis Dyas	K&S Associates	estimating@ksgestl.com	314 647 3535
TORV MOORMAN	KCI	Tmoorman@kciconstruction.com	314-486-4170
KEVIN MILLER	McGRATH & Assoc.	KMILLER@MCGRATHCONSTRUCTION.COM	314-250-5908
MICHAEL PERASE	HARAMSEE LLC	MICHAEL@HARAMSEE.LLC.COM	314 568 5016
Andy Kesperic	ATI	andy@automotivetechnology.com	314-406-1359
JEFF SMITH	ATI	jeffs@automotivetechnology.com	(314) 239-4404
Alex Hertzman	BINGMAN CONSTRUCTION	GAH@BINGMANCC.COM	636-384-3378
Jacob Kleekamp	United Construction	JakeK@unitedconst.com	314-280-2493
Brady Wildschuets	Elite Mechanical	brady@elitemechanicalllc.com	636-373-2973
NICHOLAS KREKELER	JTL	nkrekeler@jtlstl.com	314-686-2136
John VanAsdale	McGrath	juanasdale@mcgrathconstruction.com	314 312 7285
LARRY JUERN	Demien Construction	Bids@demienconstruction.com	636-332-5500
STEVE LAYNE	LCS	SLAYNE@LCSCONSTRUCT.COM	636-734-6968
TRAVIS ODNEAL	RUSSELL	TODNEAL@RUSSELLCO.COM	573-489-8373
DOD KLINGLER	ICS CONSTRUCTION SERVICES	DKLINGLER@ICS-SI.COM	314-534-6664

### WPW Bidding RFI Responses 01-24-23

1. Please confirm whether we are to include any site remediation cost in our base bid as it appears that will be handled via unit prices/allowance as needed, however exhibit D item 104 mentions undercutting and filling areas.
  - See revisions to Exhibit D – Scope of Work, Items 102, 103, 104, and 110 for work to be included in the Base Bid, or to be completed on a unit price basis against the allowance.
2. Under temporary facilities and controls in section 3.3 it mentions to install temporary service or connect to owners existing service. Are there any exiting services on site we can connect to?
  - Water, sewer, gas, communication utilities and overhead electrical are on-site near the entry road; however, utility taps are required.
3. Can we set an allowance for the fire protection permit so contractors are bidding apples to apples.
  - No, the cost of the Wentzville Department Site Plan Review and New Construction permit will be applied for and paid for by the City of Wentzville. All other permits required by the Wentzville Fire Protection District will be applied for and paid for by Contractor (subcontractors), i.e.: Fire Main Underground, Fire Sprinkler Systems, Fire Alarm Systems, or any other required permits from the WFPD.
4. Item 84 in exhibit D does not seem feasible in today's construction market. Please revise to 30 or 60 days.
  - City is reviewing this request and will respond in a future addendum.
5. Can you please provide a spec section for casework/millwork
  - Requested specification section 064116 Plastic Laminate Clad Architectural Cabinets is now provided via Addendum 02 package issued 01-24-23 and uploaded to the E-bidding system.
6. Can AISC Certification be waived if they conform to AISC standards?
  - AISC Certification is required and will not be waived.
7. I would like to request spec sections 012200 - Unit Prices and 012300 - Alternates be added to Division 1 - General Requirements.
  - Bid Alternates and Unit Prices have been added to Exhibit D – Scope of Work **for information only**, so that Contractors can distribute for subcontractor/supplier pricing. Contractors must submit Bid Alternates via the e-Bidding system and Unit Prices on Exhibit C – Supplemental Bid Information form.
8. Consider pre-qualifying steel fabricators who are not AISC certified.
  - AISC Certification of steel fabricators is required and will not be waived.
9. Specifications do not contain spec section 079500 - Expansion Control.

- Requested specification section 079500 Expansion Control was provided via Addendum 01 package issued 01-11-23 and uploaded to the E-bidding system.
10. There are no specifications for 074113 - Roof and Wall Panels as referenced in spec section 133419 - Metal Building Systems.
- Requested specification sections 074113 Metal Roof Panels & 074213 Metal Wall Panels are now provided via Addendum 02 package issued 01-24-23 and uploaded to the E-bidding system.
11. Will 1-5/8" pipe be acceptable for temporary fence framework?
- Yes, 1-5/8" pipe is acceptable for temporary fence framework.
12. Spec section 323115 2.2A states that steel pipe should comply with ASTM F1043 Group IC - yield strength 50,000psi. Spec section 323115 2.2B has pipe lbs/ft requirements of Group IA which do not match Group IC. Please advise whether to use Group IC or group IA.
- Specification 323115 section 2.2A revised to indicate ASTM F1043 Group IA requirements to coordinate with section 2.2B requirements.
13. Spec section 323115 3.2C states line posts to be spaced 8' on center. Sheet AS203 of the drawings show line posts spaced at 10' on center. Please advise intended post spacing.
- 8' on center spacing indicated in specification 323115 section 3.2C is correct since fencing will be wind bearing. Notations on sheet AS203 will be revised to note 8' OC spacing to coordinate.
14. Spec section 323115 2.6E states cantilever gate posts shall be 4" OD Grade 1 pipe. Sheet AS203 of the drawings show 4" square SCH40 posts for the cantilever gates. Please advise whether to use 4" round pipe or 4" square tube.
- Specification 323115 section 2.6E revised to indicate 4" square SCH40 posts to coordinate with sheet AS203 notations.
15. Should the 8' chain link gates be equipped with privacy slats to match fencing?
- Fencing privacy screening to be fabric screening as detailed and specified, not privacy slats. Fabric privacy screening to be installed on all perimeter chain-link gates and fencing.
16. What color are the privacy slats to be for chain link fence?
- Fencing privacy screening to be fabric screening as detailed and specified, not privacy slats. Fabric privacy screening is to be black in color.
17. At the prebid it was mentioned Wentzville will cut down all trees, and GC will remove. The civil plans mention The City of Wentzville will complete the removal of trees and vegetation. Please confirm who is removing the trees.
- Notation on sheet C-101 was revised via Addendum 01 package issued 01-11-23 and uploaded to the E-bidding system. Updated notation indicates "Owner to cut down all large hardwood trees and contractor will be responsible for stump removal, tree removal, haul off and clearing."

18. Is the GC providing the Brine Storage Containers? If so, could we please have more information on them.

- Brine storage tanks to be CFCI. Reference specification 111129 Vehicle Shop Equipment section 2.10E Accessories table for storage tank information.

19. I am a resident of Wentzville, and work for a St. Louis based Union company very interested in pursuing the Low Voltage elements of the new Wentzville Public Works.

Within the Bid Specification of the Supplemental Bid Information "Exhibit C", it lists the following three elements as a 1 Bid Line Item:

- Division 26 – Electric
- Division 27 – Communications (Low Voltage)
- Division 28 – Safety, Access & Security (Low Voltage)

As these Divisions carry completely different skillsets, certifications, and are separated in the Wentzville Specifications Manual, should they not be collected independently, per Division?

With all three lumped together, there will be no way for Wentzville to determine if they are getting a competitive response for these individual efforts.

There are a variety of local Union "Low Voltage" (Non-Electrical) Companies that would be happy to give Wentzville a competitive solution for Div. 27 and/or 28.

- The City has not packaged any of the individual spec sections as separate bid packages. The entire project is being bid to General Contractors (GCs). It is up to the GCs to determine how they package their bid packages and how they evaluate and select subcontractors. It is in the GCs best interest to provide the most competitive and complete bid for each specification. We suggest the inquiring bidder provide competitive bids for their preferred scope of work/spec sections to all potential GCs who are bidding the project for consideration. Subcontractors can inquire with our Owner Representative Navigate Building Solutions for a list of potential GCs who are looking at the project or refer to the list of Plan Holders on the e-Bidding system



**Exhibit D**  
**Scope of Work for General Contractor for**  
**the New Wentzville Public Works Facility**  
**Updated 1/25/23 for Addendum 2**

The Construction Manager (CM) referred to below is Navigate Building Solutions, LLC. The Owner referred to below is the City of Wentzville. The Contractor referred to below is the General Contractor. This bid package includes, but is not limited to, the following:

1. Scope shall include all work outlined by the project documents (plans and specifications) issued by H-Design Group dated January 12, 2023.
2. This contractor shall include in the base bid price an unknown site conditions allowance of \$200,000. Allowance shall include all overhead, profit, and fees as is allowed for Change Orders in contract Exhibit F, Modification/Explanation of Change Order Fee. Unit prices provided on the Supplemental Bid Information Form shall be used where applicable to work paid from the Allowance. Any savings to this allowance shall be reconciled via a deduct Change Order which shall include the associated overhead, profit, and fees. This allowance may only be used at the sole discretion of the CM and Owner. This allowance may not be used to address the effects of weather conditions. Allowance amount is pre-entered into the eBidding system line item.
3. Contractor is aware of the potential for Liquidated Damages. Contractor shall be responsible to maintain scheduled items for the Contractor's work as included in the Master Project Schedule below. Contractor shall reference the City-Contractor Agreement included in the bid documents. Contractor agrees to pay the Owner, or to deduct from the Contract Sum, not as a penalty, but as liquidated damages, the amounts listed in the contract drafts provided.
4. Upon execution of this contract, this contractor must submit to the CM a detailed critical path baseline construction schedule outlining each construction activity and phase. This schedule must fall within the Master Project Schedule outlined below and be submitted no later than twenty-one (21) days following execution of the contract. Contractors are required to provide updated work schedules at a minimum on a monthly basis with each pay application. Contractor's detailed activity schedule/critical path schedule shall adhere to the Master Project Schedule and shall provide for expeditious and practicable execution of the Work. Should the Contractor fall behind schedule by more than 5 workdays due to the fault of this Contractor, the Contractor shall provide a recovery schedule to the CM within 5 days of request by the CM.

**Master Project Schedule Milestone Dates (It is the responsibility of the contractor to check the e-bidding system for up to date information for Items a – g):**

a. Issue Request for Bids	January 12, 2023
b. Pre-Bid Meeting and Site Visit	January 19, 2023
c. Last Bidder Questions & Requests for Substitutions Due	February 6, 2023
d. Last Bid Addenda Issued	February 9, 2023
e. Bids Due	February 16, 2023 at 2:00 PM
f. Supplemental Bid Information Due	February 17, 2023 at 2:00 PM
g. Final Board Approval	March 8, 2023
h. Anticipated Notice to Proceed / Mobilization	March 27, 2023

(18 days after BOA approval)

- |   |  |
|---|--|
| i. Groundbreaking   | Date TBD by Owner                        |
| j. Critical Submittals Submitted for Review<br>(Retaining Wall, Footings/Foundations, HVAC<br>Equipment, Electric Gear, & Generator<br>PEMB   | 30 days after NTP<br>45 days after NTP   |
| k. All Remaining Submittals Submitted for Review  | 120 days after NTP                       |
| l. Topping Out Ceremony   | Date TBD (Coordinated with Owner)        |
| • Main Public Works Building 'Dry-In':  | Based on Bidder's Schedule               |
| • Watertight roof   |  |
| • Exterior wall air barrier in place  |  |
| • All windows / storefront / curtainwall installed,<br>or openings filled with temporary watertight<br>construction   |  |
| m. Internal Contractor Internal Pre-Punch   | 6 wks. prior to Sub. Comp.               |
| n. Substantial Completion / Punchlist Populated<br>(Day ____*)<br>Schedule<br>Note: All Life Safety Inspections & Occupancy<br>Inspections to be completed on or before<br>Substantial Completion date. | *Based on Bidder's                       |
| o. Final Completion / Completion of Punchlist   | 30 calendar days after Subst. Completion |

5. The contractual project duration shall be proposed by bidders in the e-bidding system Bid Form. The proposed duration will be used as key criteria along with other information submitted via the eBidding system to select and award a General Contractor. The project duration will be incorporated into the Contract between the Owner and the General Contractor.
6. Contractor accepts all risks associated with adverse weather. No time extensions will be granted related to claims of adverse weather. No claims for extra costs will be granted related to adverse weather and/or taking action to deal with adverse weather and/or the effects of adverse weather. All provisions in the City-Contractor Agreement otherwise respecting weather are superseded by this provision, and are of no force and effect.
7. Any claims for delay to critical path activities shall be submitted to the Construction Manager within 24 hours of occurrence, identifying the event and the impacted critical path activity. The Construction Manager will review to determine if the claim will be considered a valid delay. Each day claimed shall be tracked on a log for review at the bi-weekly Owner meetings.
8. Contractor is required to provide detailed work schedule (short term schedule) on a weekly basis. Contractor's detailed work schedule shall adhere to the Master Project Schedule and the accepted contractual project duration. Contractor shall meet the requirements of the Master Project Schedule.
9. Provide all supervision, labor, tools, equipment, and materials to complete the work.
10. Perform all unloading, loading, distribution and hoisting of materials for this scope of work.

11. Furnish, install, maintain, and remove temporary on-site trailers and storage containers as required to perform the work. Trailer shall include a conference room with table and chairs for Owner and Architect meetings, and other meetings as needed.
12. Perform all work in accordance with OSHA standards (including OSHA 10-hour requirement). This Contractor is responsible for OSHA required safety railings (installation, maintenance, and removal) including appropriate OSHA approved system for roof edge protection for all trades.
13. Provide ladders for all contractors to access the upper floor until the stairs are in place and available for use.
14. The Owner will provide the MO DNR Land Disturbance permit. The Contractor will comply with all requirements of the MO DNR Land Disturbance permit.
15. The Contractor will apply for and obtain the City of Wentzville Building permit. The City of Wentzville will waive the building permit review and building permit fees. The Contractor is still responsible for scheduling and obtaining all City of Wentzville building inspections and final approvals, temporary and final occupancy permits.
16. The City of Wentzville will waive the Engineering review fees and construction permit fees only. The Contractor is responsible to include all other required City of Wentzville engineering and utilities inspection costs, tap fees, connection fees, etc.
17. The cost of the Wentzville Fire Department Site Plan Review and New Construction permit will be applied for and paid for by the City of Wentzville. All other permits required by the Wentzville Fire District will be applied for and paid for by the Contractor (subcontractors), i.e.: Fire Main Underground, Fire Sprinkler Systems, Fire Alarm Systems, etc. Coordinate with Fire District for inspection of fire lines and fire hydrants. Site fire line into the building shall be flushed prior to interior drywall construction.
18. This Contractor (or its subcontractors) are responsible for all other permits, if required and fees required by state, county, local, regional, and federal authorities, and agencies associated with this scope of work, i.e.: mechanical, electrical, plumbing permits, pre-engineered building, and canopies, retaining wall, etc. and all permit requirements and inspection requirements associated with such items of work.
19. This Contractor is also required to obtain a Business License from the City of Wentzville if required.
20. The City of Wentzville will cut down all large hardwood trees (greater than 8") as this work must be completed by March 31, 2023. Contractor will be responsible for removing the fallen trees, stumps, and all remaining smaller trees and vegetation.
21. Coordinate all work with the Construction Manager's representative.
22. Bi-weekly meetings at the jobsite will be held with the Owner Representative. The work of this contractor must be performed in accordance with the decisions and schedules formulated at these meetings so as not to delay the work. The Contractor's Project Manager and Foreman/Superintendent must be present at these meetings. This contractor shall keep minutes of these meetings and forward them to the CM for review within 4 working days after the meeting.
23. Weekly meetings at the jobsite MUST be held with this contractor and its subcontractor's Foreman/Project Managers to coordinate installation of all systems. The Owner, Architect and the CM shall be invited to all of these meetings and will attend at their discretion. This contractor shall keep minutes of these meetings and forward them to the CM for review weekly.

24. General Contractor and its HVAC, Plumbing, Fire Protection, Electrical, and Equipment subcontractors will be expected to coordinate above-ceiling work prior to installation, including the creation of drawing overlays to identify and address interferences prior to installation as needed.
25. This Contractor shall provide all surveying and layout required to complete the work.
26. Review all drawings and specifications and accept responsibility for requirements, general notes, notes, specifications, and details as they relate to this scope of work.
27. General Contractor will install, maintain, and remove all SWPPP scope of work. Contractor will provide all SWPPP reports per MDNR standards. Provide SWPPP reports to the CM on a weekly basis and immediately following each rain event.
28. This Contractor is responsible for locating all public and private utilities.
29. Provide street cleaning to remove dirt, mud, and debris generated by the project site as needed to maintain a clean surface at existing drives, parking lots and public roads.
30. Take note of nearest water source and the schedule for water line installation; if no water is available on site, provide alternate means for tire wash down of trucks prior to leaving the site.
31. Provide barricades, signage, flagging and flagman for traffic control and public safety during the execution of the work. Coordination of all road closures (full or partial) with CM and city officials.
32. Protect adjacent properties and utilities as required during the execution of this work. Provide shoring or underpinning as required for safe excavations to meet OSHA requirements and to protect adjacent streets, sidewalks, utilities, and existing structure(s). If this requires engineered shoring systems, this Contractor will provide as needed for this scope of work.
33. This Contractor to cleanup all rubbish and debris from site and building on a daily basis. This includes off-site disposal of all rubbish and debris along with excess spoils, unsuitable materials, excess materials such as concrete, sand and masonry materials. Trucks or dumpsters to haul off material by this Contractor.
34. This Contractor shall furnish all dumpsters for the entire project and shall include cost to haul offsite and legally dispose of all construction rubbish and debris.
35. This contractor to broom clean all floors at least once a week to ensure housekeeping stays up to par.
36. This Contractor shall provide a heavy construction cleaning prior to punch list creation so all surfaces can be observed by the design team. Clean exterior and interior surfaces exposed to view; remove temporary labels, stains, putty, soil, paint and foreign substances from all surfaces, including glass and painted surfaces; polish transparent and glossy surfaces; clean equipment and fixtures to a sanitary condition; replace air filters in mechanical equipment; clean roofs, gutters, and downspouts; remove obstructions and flush debris from drainage systems; clean site; sweep paved areas and rake clean other surfaces; remove trash and surplus materials from the site; clean and polish all floors; clean and polish all hardware; and repair all Work damaged during cleaning.
37. Provide final cleaning of all buildings and site prior to occupancy.
38. Contractor will provide temporary construction toilets for the project for all Contractors, visitors, etc.

39. Contractor will provide ice, cups and distribute drinking water as needed for workers performing this scope of work.
40. This Contractor and all subcontractors will be responsible to review all specifications and drawings.
41. Contractor must not burn in the concrete at the carpet tile, vinyl, or other resilient flooring locations. Contractor to ensure floors are kept dry and clean so that the concrete can dry in order to accept adhesive for flooring products. Include moisture mitigation as required by the specifications.
42. The Owner, Architect, and CM will be very stringent on the quality of exposed concrete floors during punch list. It is ultimately in this Contractor's scope of work to protect all finish products through education, signage, and temporary protection. Proper concrete protection from staining must be observed and will be enforced. Steel must not be placed on slab to avoid staining. Diaper hydraulic powered equipment to avoid oil and gasoline staining. Pipe cutting machines shall not be used on the concrete slabs where the exposed concrete finishes are scheduled. Any rubber-tired traffic shall be kept at a minimum and shall be protected with drop cloths.
43. Plan concrete floor pours such that a single pour covers any continuous area of sealed concrete floors.
44. No lignite to be allowed in any interior or exterior flatwork concrete.
45. Contractor to furnish first aid and safety supplies as needed for this scope of work.
46. Contractor is solely responsible for site/project safety for this scope of work.
47. Contractor to maintain Site Specific Safety Plan which shall be completed and kept in their job trailer at all times.
48. Contractor to grout fill frames per architectural details and notes.
49. Provide code compliant seismic support and bracing as required by the contract documents.
50. Provide fire stop systems as required for the installation of this scope of work.
51. Provide stenciling of rated walls according to the AHJ requirements.
52. Include cost to furnish and install toilet accessories as indicated.
53. Include wall blocking as needed for ALL specialty items (toilet accessories, signage, wall mounted furniture, TV's, etc. regardless of OFCI, OFOI, or CFCI status.
54. Contractor to provide and maintain weather protection for material and work as required by the project schedule. Contractor to also provide any cold or hot weather measures for weather sensitive materials like concrete, masonry, roofing materials, air/vapor barrier, etc. This shall include but is not limited to tenting and heating for masonry installation. Delays will not be awarded for construction activities impacted by hot/cold temperatures. If wet site conditions are hindering the progress onsite and access for trades, this Contractor shall provide temporary rock access to those areas to maintain the project schedule.
55. Include water pumping and dewatering necessary to proceed with work being performed under this bid package. Refer to Geotechnical Report for anticipated groundwater.

56. This Contractor is responsible for securing the building once it is reasonably possible to do with temporary or permanent measures at the close of every day. Any temporary openings in walls are to be secured at the end of the work day.
57. This Contractor to supply, install, maintain, move, and remove temporary site fence with gates. Contractor shall submit their own proposed Site Logistics Plan for review. The Owner, CM, Contractor, and Architect will meet to review and discuss site logistics and finalize an agreed upon plan of action for construction parking, office/storage containers, temporary toilets, temporary site fence, etc.
58. Provide and remove temporary rock parking for visitors to the site, temporary construction parking, staging, and laydown areas. Location of all staging/trailer placement/access to be coordinated and approved by the Construction Manager.
59. General Contractor shall place rock around the building perimeter to create an all-weather access path for crane access and exterior wall construction as needed to maintain schedule.
60. Contractor is responsible for any coordination of staging or relocation for materials for this scope of work after initial unloading.
61. Soil testing, concrete testing and the Special Inspections listed on structural plans shall be performed by Owner's consultant and paid for by Owner. Contractor will assist and coordinate/schedule with the agency to perform onsite testing work as needed/required by the documents. If the agency must re-test or re-inspect for failed tests/inspections or if the Contractor fails to notify the testing agency of a cancelled test/inspection, this Contractor shall compensate the Owner for such tests.
62. The Owner will utilize the Faith Group as the third party Commissioning agent for the mechanical and electrical systems and exterior envelope. General Contractor to assist with coordinating and scheduling such inspections, start-ups, testing, and final owner demonstration, training sessions, etc. .
63. No smoking shall be allowed inside the building once interior construction begins.
64. Full-time onsite superintendent is required when any Work is taking place. Contractors shall consider the size and complexity of this project when determining the balance of the project's project management staff. Contractor shall assign staff as needed to maintain project progress and oversight. Contractor shall assign project manager/engineer/superintendent to the project with relative similar industry and project-type experience, availability, and workload capacity.
65. The contractor shall use Procore Project Management software program for coordination of project RFIs, submittals, change orders, etc. Contractor shall be the administrator and maintain all records in the program, and shall grant access to the Owner, CM, and design team members. Include the cost associated with the use of such program. Alternate Submittal Exchange may be requested, and must be a cloud-based system that can be accessed by multiple users including the contractor, design team, construction manager, and owner for collaboration of document exchange for the project.
66. This Contractor shall produce a submittal log at the beginning of the project that is populated with all of the required submittals for this scope of work and assign due dates for submission to the Architect and due dates for return from the Architect. This log must be submitted to the CM and Architect for review on a Bi-weekly basis.



67. The Project Milestone Dates identify when all submittals shall be submitted for review. This milestone does not relieve the Contractor of completing select submittals sooner, as needed to meet the overall project schedule for installation of the work.
68. This Contractor shall maintain an RFI log for this scope of work. This log must be submitted to the CM and Architect for review on a Bi-weekly basis. Log to include:
- a. RFI number
  - b. Topic of RFI
  - c. Date submitted
  - d. Date requested response by
  - e. Date returned
  - f. Status- Open or Closed
69. This Contractor must prepare and make available upon request, a procurement log for this scope of work for all long lead materials and equipment. Procurement log must include date of order, date of confirmation of order, expected delivery date, actual delivery date, and comments noting any changes to dates and reasons for change.
70. This Contractor shall organize and arrange for pre-installation meetings for this scope of work for all major scopes of work with the subcontractors and manufacturers prior to commencement of those activities and invite the Owner, Architect, and CM to all pre-installation meetings (must give at least 2 weeks' notice of meetings). This contractor shall keep minutes of those meetings and forward to the CM and Architect for review.
71. This Contractor will be responsible for submitting daily logs containing the number of workers, equipment, work accomplished, daily weather, deliveries, visitors to the site, any inspections passed or failed, problems encountered, and other relevant data as may be required. These reports must be emailed to the CM daily, within 24 hours of work performance, utilizing an Apple iPad app called Construction Superintendent.
72. Provide photographs of all below slab, in slab, and in-wall rough in prior to cover-up. Organize photos electronically and label with location on corresponding floor plan. Submit 'rough in photograph' package at the end of the project. CM may ask for progress photos during project as needed for reference or coordination.
73. This Contractor shall arrange, schedule, organize and video tape as it pertains to this scope of work all equipment start-ups and Owner Training sessions per contract documents. These training sessions shall be recorded professionally by a videographer, including lapel mics for person providing the training, etc. A DVD including copies of each training session (organized as individual Chapters) shall be provided as part of the closeout documents. **All Owner Demonstration and Training sessions will be scheduled to occur between Substantial Completion and Final Completion.**
74. This Contractor must populate a closeout log and submit to the CM and Architect for review to verify that all required items have been included. Once approved, this log will be used to track required closeout items prior to final payment. This contractor is highly encouraged to submit O&M requirements as soon as possible in advance of final acceptance to help eliminate delay in payment.

75. This Contractor is responsible for any temporary heating/cooling, humidifying/dehumidifying as needed to maintain the project schedule and as needed prior to starting the permanent HVAC equipment. Use of the new HVAC system will not be allowed during construction. Contractor is also responsible for any extended warranties needed to provide the Owner with the required contractual warranty durations.
76. This Contractor shall be responsible for the cost of temporary utilities usage for all trades during the course of construction including but not limited to gas, electric, sewer, water. Contractor is responsible for any backflow preventer costs/water usage costs for hydrant use. Upon Substantial Completion, CM will work with Contractor and Owner to transfer all utilities into the Owner's name.
77. Contractor shall coordinate, furnish, and install temporary transformer according to Ameren requirements.
78. Prepare subgrade/pad for the Ameren transformer per Ameren UE Specifications. Ameren will furnish, deliver, and install the transformer pad and transformer.
79. Provide fuel for generator testing. At turnover of emergency generator, this Contractor is to completely fill generator fuel tank.
80. Clean all HVAC equipment and replace all filters with new filters at the time of building turnover to the Owner.
81. All ductwork ends are to be sealed before arriving at site and seals at end of runs to be maintained.
82. This Contractor will compile for the Owner a 'record set' of all documents and drawings, as it pertains to this scope of work, for the project at Substantial Completion. This shall be 'red-lined' copies of all project changes throughout the course of the project to identify all systems as they were actually installed on the project for the Owner's records. These must be electronically recorded and submitted to the Owner in pdf format.
83. As-built Surveys will be required by this Contractor at the Completion of the Project, including for Site Utilities, rain gardens, detention basins, etc. to submit to Utility company/department or City/County for final approval. A portion of retainage will be held until all surveyed as-builts have been submitted and accepted by the utility company and authorities having jurisdiction. **As-built surveys must be prepared by a Land Surveyor or Engineer registered in the State of Missouri. Contractor shall also provide as-built drawings in accordance with Chapter 11 of the Wentzville Engineering Design Criteria and Division 11 of the Wentzville Standard Specifications.**
84. Contractor is required to hold their alternate pricing that was included in the bid form for 3 months after the bid date, unless noted otherwise in the alternate description. Contractor will notify CM when decisions need to be made regarding the acceptance of bid alternates in order to maintain deliveries, installation, and the master project schedule.
85. The Master Project Milestone Dates include all work proposed in the Bid Alternates. No time extensions will be granted for accepted Alternates.
86. Unit prices provided on the Bid Form and incorporated into the contract shall apply to the condition described in the unit price, regardless of which subcontractor performs the work or when the work is being performed.
87. Construction work shall only be allowed during hours permitted by the City of Wentzville. If Contractor opts to work outside of those hours, they must contact the CM/City/Owner to obtain permission.



88. During the warranty period of the project, this Contractor shall document, maintain, and update a Warranty Log of all warranty items, weekly, to be shared with the Client and CM. Contractor shall acknowledge the Owner's warranty call within 4 hours and keep the Owner apprised of the resolution status. Any roof or building envelope leaks or elevator issues or any issue that interferes with regular building operations shall be considered as urgent / emergencies. Contractor to provide a 24-hour on-call service for such urgent or emergency items.
89. Builder's Risk to be carried by the General Contractor. Deductibles to be paid by General Contractor.
90. Contractor is required to maintain access to the work as needed to maintain schedule.
91. No change orders will be issued for material cost increases or impacts of tariffs that occur during the project.
92. The Owner will provide and maintain two time-lapse cameras to record progress of construction. General Contractor to provide two sturdy 20-foot tall mounting posts in location to be coordinated with the Owner. General Contractor to mount cameras on pole. Provide access to the pole for periodic maintenance once a month for the duration of the project. Remove poles at the completion of the project. Turn over cameras to the Owner.
93. This Contractor shall provide an opportunity for a ground-breaking ceremony. General Contractor to provide a twelve-inch high mound of loose dirt, three feet wide and forty feet long, to be removed after ceremony.
94. This Contractor shall provide an opportunity for a topping out ceremony. General Contractor to coordinate with Owner to provide location, parking, accessible steel beam and hoisting for ceremony.
95. If this contractor chooses to backfill foundation walls prior to that time which is approved/allowed by the structural engineer, this Contractor is responsible for designing, installing, rental (and eventual removal) of all temporary shoring of foundation walls prior to backfill.
96. Provide housekeeping pads.
97. Provide site bollards complete with footing, anchoring, concrete fill, painting, and plastic covers.
98. Signage – Contractor to furnish and install the equipment signage called for on the Equipment plans and specifications. Also, the parking lot handi-cap signs. All other signage will be provided by the owner. Contractor is responsible for coordinating building construction with the signage requirements including required blocking and any required electrical rough-in.
99. Remove remaining fallen trees and stumps and complete all required site demolition work. Strip all vegetation, roots, soft, organic, frozen, and unsuitable soils in the construction areas and either haul off or stockpile for later use in non-bearing areas.
100. Strip topsoil, stockpile, and stabilize until ready for use. Spread topsoil to the depth required by civil and landscape drawings and landscape specifications.
101. All areas must be left at the end of each day so that there is no standing water. Grade temporary swales to drain site, if necessary, to achieve this requirement.

102. After stripping of site and completion of initial cuts to required subgrades (-1' below paving section in the parking/drive areas and -3' below slab on grade section in the building areas), and prior to fill operations, proof roll the structure and parking areas.

Replace of areas that rut or deflect (greater than 1") with properly compacted fill. Scarify and compact the subgrade soils to a depth of at least 6" below the surface in accordance with the geotechnical report recommendations. **If remediation of the existing soils is required after completing the site stripping and initial cuts, this work will be completed on a unit price basis, and is should not be included in the base bid.**

103. After subgrade preparation, complete site grading and compacted fill placement to three feet below the building and one foot below parking area required subgrades Contractor to determine the final fill material quantities and types. If onsite materials are utilized, Contractor is responsible for any additional work (moisture conditioning) to achieve required compaction **and this work should be included in the Base Bid.**
104. Include in the base bid imported, 1" minus gradation crushed limestone fill to a depth of 3' below building slab subgrades and 1' below parking and drive areas pavement subgrades. Include also 2' below the bearing level of footings/column pads. **Lien concrete can also be utilized for remediation under the footings.**
105. Include recompacting of the bottom of footing excavations, as directed by the materials testing agency, if the footing excavation has disturbed the compacted subgrade materials.
106. Proof roll subgrade again, prior to placing base rock for the final paving.
107. Provide properly compacted fill in all utility trenches within the building and parking areas.
108. Utilize equipment as recommended in the geotechnical report as weather and site conditions require.
109. If more or less remediation is required beyond what is included as outlined above, the change in work will be addressed by Unit Prices included on the Bid Form. In such case, unit quantities must be tracked by the Contractor and confirmed by the Materials Testing agency.
110. **Lime stabilization of all pavement areas. Clarify. Moisture conditioning, if required, is to be included in the Base Bid. See Item 103.**
111. No change orders will be awarded for additional forming or additional concrete in over excavated footings.
112. Pressure test and chlorinate site water lines. Provide test reports to Owner verifying acceptable pressures and chlorination. Coordinate with utility company / fire district and obtain approval from those parties as required.
113. Verify that all plumbing fixtures are mounted at ADA height required by AHJ.
114. Include all caulking and sealants for all systems and materials furnished and installed on the bid documents.
115. Provide access panels needed for all work installed under this contract.
116. Provide a mockup per documents of the building envelope materials and construction techniques. The mockup should reflect the project document details and be installed exactly as indicated on

the drawings. The purpose of the mockup is to not only review and achieve an approval of the materials, but also to ensure the transition of the materials results in a good water tight condition. Contractor to follow the mockup guidelines outlined in the project documents. If the Contractor questions a detail provided, it should be submitted as an RFI and discussed with the project team prior to the construction of the mockup.

117. Contractor (or the responsible subcontractor providing the delegated design) must include Professional Liability and errors and omissions insurance for the design-build, or delegated design scopes of work that are required by specifications to designed by a professional engineer. The General Contractor or subcontractor providing the design must carry a minimum of Professional Liability of \$2M per claim. Drawings and calculations shall be signed and sealed by a Professional Engineer registered in the State of Missouri. The following items are delegated design by this Contractor:
- a. Heavy duty, simulated stone look vinyl fencing and footings
  - b. Site retaining wall
  - c. Pre-engineered metal building
  - d. Pre-engineered/prefabricated covered parking structures.
  - e. Salt Building Fabric Structure
  - f. Fire Suppression System (including hangers, seismic restraints, etc.)
  - g. Fire Alarm System (including wiring diagrams, etc.)
  - h. Plumbing trapeze hangers and the seismic restraints
  - i. Mechanical hangers and supports and seismic restraints
  - j. Electrical hanger and supports and seismic restraints
  - k. Structural Steel Connections (See Spec Section 051200)
  - l. Cold Formed Metal Framing (See Spec Section 054000)
  - m. Guardrails for mezzanine and truck dock areas
  - n. Aluminum-Framed Storefronts (See Spec Section 084113)
  - o. Glazed Aluminum Curtain Walls (See Spec Section 084113)
  - p. Glazing (Spec Section 08800)
118. Review with the Owner/Fire Marshall before ordering the Knox box. Verify/obtain final location of the Knox box prior to installation.
119. The CONTRACTOR shall provide one project sign. The sign will include the Owner's logo, design team logos, Construction Manager logo and the CONTRACTOR logo. They shall also include the project rendering, the project name and expected completion timeframe. No other project signs will be allowed on the project for advertisement unless approved in advance by the owner. The sign needs to a minimum of 4' by 8'. The sign will be installed at a location to be approved by the Owner.
120. All disturbed landscape areas must be replaced to their pre-construction condition at the end of the project unless noted otherwise on the Project Documents. This includes areas disturbed by this Contractor outside of the parcel boundary, on adjacent properties, and along the ROW.
121. Contractor will submit to the CM a detailed Schedule of Values for review and approval prior to the submission of the first pay application.
122. Contractor must reference and comply with all City Standards in construction of the new facilities.

123. The typical property owner/development or service agreement fees from Ameren Electric, Ameren Gas, and Brightspeed are the responsibility of the Owner. Contractor to coordinate with and provide all indicated infrastructure and installations indicated on the plans to support the public utility provided services and equipment.
124. Mechanical, electrical, and plumbing subcontractors will assist Owner's Representative with completing Ameren BizSavers Program Incentive documentation within 30 days of Substantial Completion, including backups for labor and material costs for mechanical equipment, light fixtures, lighting controls, and other electric equipment which qualifies for incentives. Subcontractors shall also provide all invoices from suppliers for these items as required by Ameren for backup.
125. BID ALTERNATES (PROVIDE Lump Sum ADD or DEDUCT Amount)

**Provided for information only. Contractor to provide all Alternate Bids via e-Bidding system.**

Alternate 1 – Eliminate covered parking at the Main Building to include the prefabricated canopy structure, related storm piping, and lighting.

Alternate 2 – Provide medium duty EMPC concrete paving (Note 26 - Detail 13/C700) in lieu of areas called out to be light duty asphalt paving (Note 27 – Detail 12/C700) and medium duty asphalt paving (Note 15 – Detail 14/C700) at the North Parking Lot.

Alternate 3 – Provide approved substitute manufacturer to Trane as requested in Specifications Sections 230923 (Direct-Digital Control for HVAC), 237413 (Indoor Indirect-Fired Heating & Ventilating Units, and 237413 (Outdoor Packaged Heating & Cooling Units).

Alternate 4 – Provide engineered quartz tops at wet areas (Rooms 108, 119, 120, 123, 213, 214, 301, and 411) in lieu of solid surface tops.

Alternate 5 – Provide plastic laminate tops at dry areas (Rooms 112, 117, 211, 216, 308, and 403) in lieu of solid surface tops in accordance with the Finish Drawings

126. **UNIT PRICES:** The unit rates below are to include all general conditions, overhead, and profit. Rates are to be applied either as add or deduct rates; the same rate will apply for either condition. There will be only one rate allowed per unit price regardless of when in the construction process the rate is being applied or what trade is performing it.

**Provided for information only. Contractor to submit all Unit Prices on Exhibit C – Supplemental Bid Information Form.**

Unit Price No. 1: Removal and haul-off of rippable rock. Per CY

Unit Price No. 2: Removal and haul-off of non-rippable rock. Per CY

Unit Price No. 3: Removal and haul-off of trench rock. Per CY

Unit Price No. 4: Removal and disposal of existing buried concrete man-made structures. Per CY

Unit Price No. 5: Removal, haul-off and disposal of unsuitable soils and placement of lean concrete for soil remediation. Per CY

Unit Price No. 6: Removal, haul-off and disposal of unsuitable soils and import & compaction of 1" granular material for soil remediation per recommendations in Geotechnical Report. Per CY

Unit Price No. 7: Removal, haul-off and disposal of unsuitable soils and import & compaction of suitable soils per recommendations in Geotechnical Report. Per CY

Unit Price No. 8: Lime treatment of on-site unsatisfactory soils, tilled into a depth directed by Geotechnical Engineer. Include tilling, spreading and recompaction of treated soil. Per CY

Unit Price No. 9: Moisture conditioning existing subgrade material by aerating soil with a disk and allowing to air dry. Include spreading and recompaction. Per CY

Unit Price No. 10: Load and haul-off of surplus soils. Per CY

Unit Price No. 11: Import, placement and compaction of suitable soil. Per CY

Unit Price No. 12: 1" clean rock placement and compaction Per CY

Unit Price No. 13: 1" minus rock placement and compaction Per CY

Unit Price No. 14: Eliminate seed/straw, furnish, and install additional sod. Per SF

Unit Price No. 15: Furnish and install enhanced flooring adhesive capable of withstanding up to 99% Relative Humidity of slabs (compatible with flooring products) on new concrete slabs. Per SF

Unit Price No. 16: Furnish and install additional heavy duty, simulated stone vinyl fence. Per LF

Unit Price No. 17: Eliminate chain link/fabric screen fence. Per LF

## SECTION 002600 - PROCUREMENT SUBSTITUTION PROCEDURES

### 1.1 DEFINITIONS

- A. Procurement Substitution Requests: Requests for changes in products, materials, equipment, and methods of construction from those indicated in the Procurement and Contracting Documents, submitted prior to receipt of bids.
- B. Substitution Requests: Requests for changes in products, materials, equipment, and methods of construction from those indicated in the Contract Documents, submitted following Contract award. See Section 012500 "Substitution Procedures" for conditions under which Substitution requests will be considered following Contract award.

### 1.2 QUALITY ASSURANCE

- A. Compatibility of Substitutions: Investigate and document compatibility of proposed substitution with related products and materials. Engage a qualified testing agency to perform compatibility tests recommended by manufacturers.

### 1.3 PROCUREMENT SUBSTITUTIONS

- A. Procurement Substitutions, General: By submitting a bid, the Bidder represents that its bid is based on materials and equipment described in the Procurement and Contracting Documents, including Addenda. Bidders are encouraged to request approval of qualifying substitute materials and equipment when the Specifications Sections list materials and equipment by product or manufacturer name.
- B. Procurement Substitution Requests will be received and considered by Owner when the following conditions are satisfied, as determined by Architect; otherwise, requests will be returned without action:
  - 1. Extensive revisions to the Contract Documents are not required.
  - 2. Proposed changes are in keeping with the general intent of the Contract Documents, including the level of quality of the Work represented by the requirements therein.
  - 3. The request is fully documented and properly submitted.

### 1.4 SUBMITTALS

- A. Procurement Substitution Request: Submit to Architect. Procurement Substitution Request must be made in writing by prime contract Bidder only in compliance with the following requirements:
  - 1. Requests for substitution of materials and equipment will be considered if received no later than **February 6, 2023**.
  - 2. Submittal Format: Submit one copy of each written Procurement Substitution Request, using form bound in Project Manual.
    - a. Identify the product or the fabrication or installation method to be replaced in each request. Include related Specifications Sections and drawing numbers.
    - b. Provide complete documentation on both the product specified and the proposed substitute, including the following information as appropriate:
      - 1) Point-by-point comparison of specified and proposed substitute product data, fabrication drawings, and installation procedures.

**City of Wentzville MO Public Works Facility**

**Wentzville, Missouri**

**PROJECT NO.: 19-040**

- 2) Copies of current, independent third-party test data of salient product or system characteristics.
  - 3) Samples where applicable or when requested by Architect.
  - 4) Detailed comparison of significant qualities of the proposed substitute with those of the Work specified. Significant qualities may include attributes such as performance, weight, size, durability, visual effect, sustainable design characteristics, warranties, and specific features and requirements indicated. Indicate deviations, if any, from the Work specified.
  - 5) Material test reports from a qualified testing agency indicating and interpreting test results for compliance with requirements indicated.
  - 6) Research reports, where applicable, evidencing compliance with building code in effect for Project, from ICC-ES.
  - 7) Coordination information, including a list of changes or modifications needed to other parts of the Work and to construction performed by Owner and separate contractors, which will become necessary to accommodate the proposed substitute.
- c. Provide certification by manufacturer that the substitute proposed is equal to or superior to that required by the Procurement and Contracting Documents, and that its in-place performance will be equal to or superior to the product or equipment specified in the application indicated.
  - d. Bidder, in submitting the Procurement Substitution Request, waives the right to additional payment or an extension of Contract Time because of the failure of the substitute to perform as represented in the Procurement Substitution Request.
- B. Architect's Action:
1. Architect may request additional information or documentation necessary for evaluation of the Procurement Substitution Request. Architect will notify all bidders of acceptance of the proposed substitute by means of an Addendum to the Procurement and Contracting Documents.
- C. Architect's approval of a substitute during bidding does not relieve Contractor of the responsibility to submit required shop drawings and to comply with all other requirements of the Contract Documents.

END OF DOCUMENT 002600

EXHIBIT G - Substitution Procedures &  
Substitution Request Form

Revised 1/25/23 - Addendum 2

City of Wentzville MO Public Works Facility  
Wentzville, Missouri  
PROJECT NO.: 19-040

SECTION 012500 - SUBSTITUTION REQUEST FORM

This form is to be used to submit product(s) for Architect or Engineers approval. Requests for substitution will be considered if received no later than February 6, 2023. Submit this document to Architect per section 012500.

To: \_\_\_\_\_

We hereby submit for your consideration the following product instead of the specified items for the above project:

Specification Section: \_\_\_\_\_

Proposed Substitution: \_\_\_\_\_

Attach complete Product description, drawings, photographs, performance and test data, and other information necessary for evaluation.

A. Will changes be required to building design in order to properly install proposed substitution?

YES \_\_\_\_ NO \_\_\_\_

If yes, explain \_\_\_\_\_

\_\_\_\_\_

B. What difference exists between proposed substitution and specified item?

\_\_\_\_\_

\_\_\_\_\_

C. Does manufacturer's warranty of proposed substitution differ from that specified?

YES \_\_\_\_ NO \_\_\_\_

If yes, explain \_\_\_\_\_

D. Will maintenance and service parts be locally available for substitution?

YES \_\_\_\_ NO \_\_\_\_

If yes, explain \_\_\_\_\_

COMPANY NAME \_\_\_\_\_

CONTACT PERSON \_\_\_\_\_

TELEPHONE \_\_\_\_\_



## SECTION 012500 - SUBSTITUTION PROCEDURES

### PART 1 - GENERAL

#### 1.1 SUMMARY

- A. Section includes administrative and procedural requirements for substitutions.
- B. Related Requirements:
  - 1. Document 002600 "Procurement Substitution Procedures" for requirements for substitution requests prior to award of Contract.
  - 2. Section 016000 "Product Requirements" for requirements for submitting comparable product submittals for products by listed manufacturers.

#### 1.2 DEFINITIONS

- A. Substitutions: Changes in products, materials, equipment, and methods of construction from those required by the Contract Documents and proposed by Contractor.
  - 1. Substitutions for Cause: Changes proposed by Contractor that are required due to changed Project conditions, such as unavailability of product, regulatory changes, or unavailability of required warranty terms.
  - 2. Substitutions for Convenience: Changes proposed by Contractor or Owner that are not required in order to meet other Project requirements but may offer advantage to Contractor or Owner.
- B. Comparable Products: Naming of specified items on the Drawings and in the specifications, means that such named items are specifically required by the Architect and/or Owner. When the words "or comparable product" follows such named item(s), a substitution request must be submitted when proposing a product other than the named product. Requests for substitutions must be received by the Architect within the time frame set hereinafter.

#### 1.3 ACTION SUBMITTALS

- A. Substitution Requests: Submit three copies of each request for consideration. Identify product or fabrication or installation method to be replaced. Include Specification Section number and title and Drawing numbers and titles.

## City of Wentzville MO Public Works Facility

### Wentzville, Missouri

PROJECT NO.: 19-040

1. Substitution Request Form: Use form provided in Project Manual . All Substitutions to the Project must be submitted for review prior to use on the Project, and be submitted on a fully executed request form with appropriate documentation.
  - a. Prior to Bidding: Use CSI Form 1.5C, Substitution Request Form During the Bidding Phase.
  - b. After Bidding Phase: Use CSI Form 13.1A, Substitution Request Form After the Bidding Phase.
2. Documentation: Show compliance with requirements for substitutions and the following, as applicable:
  - a. Statement indicating why specified product or fabrication or installation method cannot be provided, if applicable.
  - b. Coordination of information, including a list of changes or revisions needed to other parts of the Work and to construction performed by Owner and separate contractors that will be necessary to accommodate proposed substitution.
  - c. Detailed comparison of significant qualities of proposed substitutions with those of the Work specified. Include annotated copy of applicable Specification Section. Significant qualities may include attributes, such as performance, weight, size, durability, visual effect, sustainable design characteristics, warranties, and specific features and requirements indicated. Indicate deviations, if any, from the Work specified.
  - d. Product Data, including drawings and descriptions of products and fabrication and installation procedures.
  - e. Samples, where applicable or requested.
  - f. Certificates and qualification data, where applicable or requested.
  - g. List of similar installations for completed projects, with project names and addresses as well as names and addresses of architects and owners.
  - h. Material test reports from a qualified testing agency, indicating and interpreting test results for compliance with requirements indicated.
  - i. Research reports evidencing compliance with building code in effect for Project, from ICC-ES .
  - j. Detailed comparison of Contractor's construction schedule using proposed substitutions with products specified for the Work, including effect on the overall Contract Time. If specified product or method of construction cannot be provided within the Contract Time, include letter from manufacturer, on manufacturer's letterhead, stating date of receipt of purchase order, lack of availability, or delays in delivery.
  - k. Cost information, including a proposal of change, if any, in the Contract Sum.
  - l. Contractor's certification that proposed substitution complies with requirements in the Contract Documents, except as indicated in substitution request, is compatible with related materials and is appropriate for applications indicated.
  - m. Contractor's waiver of rights to additional payment or time that may subsequently become necessary because of failure of proposed substitution to produce indicated results.
3. Architect's Action (or Design Team member's action): If necessary, Architect will request additional information or documentation for evaluation within seven days of receipt of a request for substitution. Architect will notify Contractor of acceptance or rejection of proposed substitution within 15 days of receipt of request, or seven days of receipt of additional information or documentation, whichever is later.
  - a. Forms of Acceptance: Addenda, Change Order, Construction Change Directive, or Architect's Supplemental Instructions for minor changes in the Work.
  - b. Use product specified if Architect does not issue a decision on use of a proposed substitution within time allocated.
  - c. Architect (or member of the design team) will note action taken.

- d. Architect (or member of the design team) is not obligated nor required to review any and all Substitution requests.
- e. Architect (or member of the design team) is not obligated to inform Proposers of Substitutions of incomplete and/or non-accepted requests for Substitution.

#### 1.4 QUALITY ASSURANCE

- A. Compatibility of Substitutions: Investigate and document compatibility of proposed substitution with related products and materials. Engage a qualified testing agency to perform compatibility tests recommended by manufacturers.

#### 1.5 PROCEDURES

- A. Coordination: Revise or adjust affected work as necessary to integrate work of the approved substitutions.

#### 1.6 SUBSTITUTIONS

- A. Substitutions for Cause: Submit requests for substitution immediately on discovery of need for change, but not later than 15 days prior to time required for preparation and review of related submittals.
  - 1. Conditions: Architect will consider Contractor's request for substitution when the following conditions are satisfied. If the following conditions are not satisfied, Architect will return requests without action, except to record noncompliance with these requirements:
    - a. Requested substitution is consistent with the Contract Documents and will produce indicated results.
    - b. Substitution request is fully documented and properly submitted.
    - c. Requested substitution will not adversely affect Contractor's construction schedule.
    - d. Requested substitution has received necessary approvals of authorities having jurisdiction.
    - e. Requested substitution is compatible with other portions of the Work.
    - f. Requested substitution has been coordinated with other portions of the Work.
    - g. Requested substitution provides specified warranty.
    - h. If requested substitution involves more than one contractor, requested substitution has been coordinated with other portions of the Work, is uniform and consistent, is compatible with other products, and is acceptable to all contractors involved.
    - i. Specified product or method of construction cannot be provided within the Contract Time.
    - j. Specified product or method of construction cannot be provided in a manner that is compatible with other materials, and where the Contractor certifies that the substitution will overcome the incompatibility.

## City of Wentzville MO Public Works Facility

### Wentzville, Missouri

PROJECT NO.: 19-040

- k. Specified product or method of construction cannot provide a warranty required by the Contract Documents and where the Contractor certifies that the proposed substitution will provide the specified warranty.
  2. Acceptance of Substitutions for Cause. Architect (or member of the design team) will review proposed Substitution in time indicated in previous Sections. If necessary, Architect (or member of the design team) will request additional information or documentation for evaluation purposes. Only acceptable substitutions will receive notification of status. Substitutions shall be considered unacceptable unless a form of acceptance is received by the Proposer.
    - a. Forms of Acceptance for Substitutions of Cause: Change Order, Construction Change Directive, or Supplemental Instructions for minor changes in the Work.
- B. Substitutions for Convenience: Architect will consider requests for substitution if received within 60 days after the Notice to Proceed . Requests received after that time may be considered or rejected at discretion of Architect.
  1. Conditions: Architect will consider Contractor's request for substitution when the following conditions are satisfied. If the following conditions are not satisfied, Architect will return requests without action, except to record noncompliance with these requirements:
    - a. Substitutions for Convenience will only be reviewed once - no additional information may be submitted after initial review.
    - b. Requested substitution offers Owner a substantial advantage in cost, time, energy conservation, or other considerations, after deducting additional responsibilities Owner must assume. Owner's additional responsibilities may include compensation to Architect for redesign and evaluation services, increased cost of other construction by Owner, and similar considerations.
    - c. Requested substitution does not require extensive revisions to the Contract Documents.
    - d. Requested substitution is consistent with the Contract Documents and will produce indicated results.
    - e. Substitution request is fully documented and properly submitted.
    - f. Requested substitution will not adversely affect Contractor's construction schedule.
    - g. Requested substitution has received necessary approvals of authorities having jurisdiction.
    - h. Requested substitution is compatible with other portions of the Work.
    - i. Requested substitution has been coordinated with other portions of the Work.
    - j. Requested substitution provides specified warranty.
    - k. If requested substitution involves more than one contractor, requested substitution has been coordinated with other portions of the Work, is uniform and consistent, is compatible with other products, and is acceptable to all contractors involved.
  2. Acceptance of Substitution for Convenience: Architect (or member of the design team) will release accepted substitutions in Addendum and by no other means.
- C. The Contractor's submittal and Architect's acceptance of Shop Drawings, Product Data or Samples that relate to construction activities not complying with the Contract Documents does not constitute an acceptance or validate request for substitution, nor does it constitute approval.
- D. Under no circumstances does the Architect's and/or Owner's acceptance of any such substitution relieve the Contractor from timely, full and proper performance of the Work.

**1.7 ARCHITECT'S REVIEW PROCESS**

- A. Submittal requests for proposed substitutions will be processed using the following procedures:
1. Submittals will be dated upon arrival and reviewed in the order they were received.
  2. Submittals will be placed by receiving person in a designated folder for the purpose of Substitution Reviews.
  3. Submittals will be reviewed by a member of the design team's staff (or respective consultant). Reviewer(s) will not be designated until after receipt of submittal of substitutions.
  4. Reviewer's General Attitude will be the following:
    - a. Burden of proof is upon the Proposer or Submitter of the Substitution.
    - b. Reviewer will not review the submittal and will deem it "Not Approved" if the Substitution does not indicate all required options to meet the requirements of the Contract Documents (i.e. Reviewer will not select options between models and/or lines of products).
    - c. Reviewer should not be required to conduct an exhaustive review of the submittal. Submittal of a Manufacturer's catalogs which do not clearly indicate proposed product and/or product options will be immediately rejected.
    - d. Reviewer should not be required to seek information from Manufacturer's literature on file in the office, from an improperly submitted electronic submittal, or information from other locations or sources.
    - e. Substitute must meet or exceed the requirements and performance of the specified or indicated item(s) within the Contract Documents.
    - f. Review is complete when, in the Reviewer's opinion, significant deficiency(ies) are established. In such case, review of data covering other points of the Specifications is not required.
  5. Reviewer will note action taken from list below, the date, and his/her initials or name:
    - a. Substitution Approved
    - b. Substitution Approved As Noted
    - c. Substitution Rejected
    - d. Substitution Request Received Too Late
    - e. If no action has been taken, the Contractor shall deem the Substitution "Not Approved."
  6. Substitutions will be filed in the Architect's office until completion of the Project.

**1.8 ELECTRONIC SUBMITTAL OF SUBSTITUTIONS**

- A. Substitution Request submittals will be accepted for review when submitted electronically under the following conditions; Substitution Request submittals may be rejected immediately at Architect (or member of design team) which are not submitted in accordance with the criteria below:
1. A fully executed Substitution Request form must accompany each Substitution Request submittal.
  2. Submittals shall be submitted to the Architect of Record as reference in the Project Team Directory. Submittals directed to the attention of anyone other than the person named will not be considered.

**City of Wentzville MO Public Works Facility**

**Wentzville, Missouri**

PROJECT NO.: 19-040

3. Submittals of Substitutions for any reason must be received within the indicated time limits set forth by this Document.
4. Documentation requirements as set forth in this Section are applicable to Electronic Submittals.
  - a. Submittals in which the Manufacturer's entire catalog is submitted will be immediately rejected.

PART 2 - PRODUCTS (Not Used)

PART 3 - EXECUTION (Not Used)

END OF SECTION 012500

**INVITATION FOR BIDS**

COVER PAGE  
TABLE OF CONTENTS  
BIDDING INSTRUCTIONS  
SPECIAL REQUIREMENTS  
EXHIBIT A- QUALIFICATIONS  
EXHIBIT B- REFERENCES

**CONTRACT DOCUMENTS & SPECIFICATIONS**

CITY-CONTRACTOR AGREEMENT & TERMS & CONDITIONS  
GENERAL CONDITIONS  
EXHIBIT C- SUPPLEMENTAL BID INFORMATION  
EXHIBIT D- SCOPE OF WORK  
EXHIBIT E- SUPPLEMENTAL CONTRACT TERMS  
EXHIBIT F- MODIFICATIONS/ EXPLANATION OF CHANGE ORDER FEE  
EXHIBIT G- SUBSTITUTION PROCEDURES & SUBSTITUTION REQUEST FORM (DURING BIDDING)  
WAGE RATE ORDER #29

GEOTECHNICAL REPORT

**DIVISION 00 - PROCUREMENT AND CONTRACTING REQUIREMENTS**

002600.....PROCUREMENT SUBSTITUTION PROCEDURES

**DIVISION 01 - GENERAL REQUIREMENTS**

011000.....SUMMARY  
012100 .....ALLOWANCES  
012500.....SUBSTITUTION PROCEDURES  
012500.....SUBSTITUTION REQUEST-FORM  
012700.....CONTRACT MODIFICATION PROCEDURE  
013100.....PROJECT MANAGEMENT & COORDINATION  
013200.....CONSTRUCTION PROGRESS DOCUMENTATION  
013300.....SUBMITTAL PROCEDURE  
014000.....QUALITY REQUIREMENTS  
014050.....REQUIRED SPECIAL INSPECTIONS  
014200.....REFERENCES  
015000.....TEMPORARY FACILITIES & CONTROLS  
016000.....PRODUCT REQUIREMENTS  
017300.....EXECUTION  
017419.....CONSTRUCTION WASTE MANAGEMENT  
017700.....CLOSEOUT PROCEDURES  
017823.....OPERATION & MAINTENANCE DATA  
017836.....WARRANTIES  
017839.....PROJECT RECORD DOCUMENTS  
017900.....DEMONSTRATION & TRAINING  
019113.....GENERAL COMMISSIONING REQUIREMENTS

**DIVISION 03 - CONCRETE**

033000.....CAST-IN-PLACE CONCRETE  
033099.....UNDERSLAB VAPOR RETARDER

**DIVISION 04 - MASONRY**

042200.....CONCRETE MASONRY UNITS  
047200.....CALCIUM SILICATE MASONRY UNITS

**City of Wentzville MO Public Works Facility**

**Wentzville, Missouri**

PROJECT NO.: 19-040

**DIVISION 05 - METALS**

051200.....STRUCTURAL STEEL FRAMING  
052100.....STEEL JOIST FRAMING  
053100.....STEEL DECKING  
054000.....COLD-FORMED METAL FRAMING  
055000.....METAL FABRICATIONS

**DIVISION 06 - WOODS, PLASTICS & COMPOSITES**

061000.....ROUGH CARPENTRY  
061600.....SHEATHING  
061643.....EXTERIOR FIBERGLASS MAT FACED SHEATHING  
064116.....PLASTIC LAMINATE CLAD ARCHITECTURAL CABINETS

**DIVISION 07 - THERMAL & MOISTURE PROTECTION**

072100.....THERMAL INSULATION  
072140.....FOAMED-IN-PLACE MASONRY WALL INSULATION  
072419.....WATER-DRAINAGE EXTERIOR INSULATION & FINISH SYSTEM (EIFS)  
072726.....FLUID-APPLIED MEMBRANE AIR BARRIER  
074113.....METAL ROOF PANELS  
074213.....METAL WALL PANELS  
074215.....METAL LINER PANELS  
074293.....SOFFIT PANELS  
074623.....PRE-FINISHED COMPOSITION SIDING  
075423.....THERMOPLASTIC-POLYOLEFIN (TPO) ROOFING  
076200.....SHEET METAL FLASHING & TRIM  
077253.....SNOW GUARDS  
079200.....JOINT SEALANTS  
079500.....EXPANSION CONTROL

**DIVISION 08 - OPENINGS**

081113.....HOLLOW METAL DOORS & FRAMES  
081416.....FLUSH WOOD DOORS  
082550.....FIBERGLASS DOORS & FRAMES  
083600.....INSULATED SECTIONAL OVERHEAD DOORS  
084113.....ALUMINUM FRAMED ENTRANCES & STOREFRONTS  
084413.....GLAZED ALUMINUM CURTAINWALL  
085653.....SECURITY WINDOWS  
087100.....DOOR HARDWARE  
088000.....GLAZING

**DIVISION 09 - FINISHES**

092216.....NON-STRUCTURAL METAL FRAMING  
092900.....GYPSUM BOARD  
093000.....TILING  
095123.....ACOUSTICAL CEILING TILES  
096500.....RESILIENT FLOORING  
096813.....TILE CARPETING  
099123.....INTERIOR PAINTING  
099123.....PAINTING & COATING

**DIVISION 10 - SPECIALTIES**

102113.....TOILET COMPARTMENTS  
102800.....TOILET, BATH & LAUNDRY ACCESSORIES



104413.....FIRE EXTINGUISHER CABINETS  
104416.....FIRE EXTINGUISHERS  
105113.....METAL LOCKERS  
105300.....PREFABRICATED CANOPY SYSTEM  
105600.....STORAGE EQUIPMENT

**DIVISION 11 - EQUIPMENT**

111100.....VEHICLE SERVICE EQUIPMENT  
111113.....COMPRESSED AIR VEHICLE SERVICE EQUIPMENT  
111129.....VEHICLE SHOP EQUIPMENT  
112419.....VACUUM EQUIPMENT

**DIVISION 12 - FURNISHINGS**

123623.....PLASTIC LAMINATE CLAD COUNTERTOPS  
123661.13.....SIMULATED STONE COUNTERTOPS  
123661.16.....SOLID SURFACE COUNTERTOPS

**DIVISION 13 - SPECIAL CONSTRUCTION**

133419.....METAL BUILDING SYSTEMS  
133600.....PRE-ENGINEERED FABRIC STRUCTURE

**DIVISION 14 - ELEVATORS & LIFTS**

144500.....VEHICLE LIFTS

**DIVISION 20 - MECHANICAL SUPPORT**

200548.....SEISMIC CONTROLS FOR MEPFT

**DIVISION 21 - FIRE SUPPRESSION**

210010.....GENERAL FIRE SUPPRESSION REQUIREMENTS  
210500.....COMMON WORK RESULTS FOR FIRE SUPPRESSION  
210515.....BASIC FIRE SUPPRESSION PIPING MATERIALS & METHODS  
210548.....SEISMIC CONTROLS FOR FIRE SUPPRESSION  
210553.....IDENTIFICATION FOR FIRE SUPPRESSION PIPING & EQUIPMENT  
211100.....FIRE SUPPRESSION WATER SERVICE PIPING  
211313.....WATER BASED FIRE SUPPRESSION SYSTEMS  
213113.....ELECTRIC-DRIVE CENTRIFUGAL FIRE PUMPS

**DIVISION 22 - PLUMBING SPECIFICATION**

220010.....GENERAL PLUMBING REQUIREMENTS  
220015.....COORDINATION  
220500.....COMMON WORK RESULTS FOR PLUMBING  
220513.....COMMON MOTOR REQUIRMENTS FOR PLUMBING EQUIPMENT  
220515.....BASIC PIPING MATERIALS & METHODS  
220516.....EXPANSION FITTINGS & LOOPS FOR PLUMBING PIPING  
220519.....METERS & GAUGES FOR PLUMBING PIPING  
220523.....GENERAL-DUTY VALVES FOR PLUMBING PIPING  
220529.....HANGERS & SUPPORTS FOR PLUMBING PIPING  
220534.....HOT WATER TEMPERATURE MAINTENANCE SYSTEM FOR PLUMBING PIPING  
220548.....SEISMIC CONTROLS FOR PLUMBING  
220550.....VIBRATION ISOLATION FOR PLUMBING PIPING & EQUIPMENT  
220553.....IDENTIFICATION FOR PLUMBING PIPING & EQUIPMENT  
220700.....PLUMBING INSULATION  
221100.....WATER DISTRIBUTION PIPING & SPECIALTIES

**City of Wentzville MO Public Works Facility**

**Wentzville, Missouri**

PROJECT NO.: 19-040

221111.....MECHANICALLY JOINED PLUMBING PIPING SYSTEMS  
221113.....WATER DISTRIBUTION SYSTEMS  
221114.....STAINLESS STEEL WATER DISTRIBUTION PIPING & SPECIALTIES  
221115.....CPVC WATER DISTRIBUTION SYSTEMS & SPECIALTIES  
221123.....DOMESTIC WATER PUMPS  
221300.....SANITARY DRAINAGE & VENT PIPING & SPECIALTIES  
221313.....SANITARY SEWER SYSTEMS  
221400.....STORM DRAINAGE PIPING & SPECIALTIES  
223300.....ELECTRIC DOMESTIC WATER HEATERS  
223400.....FUEL FIRED DOMESTIC WATER HEATERS  
224000.....PLUMBING FIXTURES  
227000.....NATURAL GAS SYSTEMS  
227010.....MECHANICALLY JOINED NATURAL GAS PIPING SYSTEMS

**DIVISION 23 - HEATING, VENTILATING, & AIR-CONDITIONING SPECIFICATION**

230010.....GENERAL MECHANICAL REQUIREMENTS  
230015.....ELECTRICAL COORDINATION FOR MECHANICAL EQUIPMENT  
230500.....COMMON WORK RESULTS FOR HVAC  
230510.....BASIC PIPING MATERIALS & METHODS  
230513.....COMMON MOTOR REQUIREMENTS FOR HVAC EQUIPMENT  
230514.....VARIABLE FREQUENCY DRIVES  
230529.....HANGERS & SUPPORTS FOR HVAC PIPING & EQUIPMENT  
230548.....SEISMIC CONTROLS FOR MECHANICAL  
230550.....VIBRATION ISOLATION FOR HVAC  
230553.....IDENTIFICATION FOR HVAC PIPING & EQUIPMENT  
230593.....TESTING, ADJUSTING & BALANCING FOR HVAC  
230700.....HVAC INSULATION  
230913.....INSTRUMENTATION & CONTROL DEVICES FOR HVAC  
230915.....VEHICLE EMISSION MONITORING SYSTEM  
230923.....DIRECT DIGITAL CONTROL FOR HVAC  
232300.....REFRIGERANT PIPING  
233113.....METAL DUCTS  
233300.....AIR DUCT ACCESSORIES  
233413.....AXIAL HVAC FANS  
233416.....CENTRIFUGAL HVAC FANS  
233423.....HVAC POWER VENTILATORS  
233600.....AIR TERMINAL UNITS  
233713.....DIFFUSERS, REGISTERS & GRILLES  
234200.....ULTRAVIOLET LIGHT EMITTERS  
235100.....BREECHINGS, CHIMNEYS & STACKS  
235500.....FUEL FIRED HEATERS  
237333.....INDIRECT-FIRED HEATING & VENTILATING UNITS  
237413.....OUTDOOR PACKAGED HEATING & COOLING UNITS  
238126.....SPLIT SYSTEM AIR CONDITIONERS  
238500.....ELECTRIC HEATING UNITS

**DIVISION 26 - ELECTRICAL SPECIFICATION**

260010.....GENERAL ELECTRICAL REQUIREMENTS  
260500.....COMMON WORK RESULTS FOR ELECTRICAL  
260502.....EQUIPMENT WIRING SYSTEMS  
260504.....PROVISIONS FOR ELECTRICAL UTILITY SERVICE  
260519.....LOW-VOLTAGE ELECTRICAL POWER CONDUCTORS & CABLES  
260526.....GROUNDING & BONDING FOR ELECTRICAL SYSTEMS  
260529.....HANGERS & SUPPORTS FOR ELECTRICAL SYSTEMS

260533.....RACEWAYS & BOXES FOR ELECTRICAL SYSTEMS  
260543.....UNDERGROUND DUCTS & RACEWAYS FOR ELECTRICAL SYSTEMS  
260548.....SEISMIC CONTROLS FOR ELECTRICAL SYSTEMS  
260553.....IDENTIFICATION FOR ELECTRICAL SYSTEMS  
260573.....OVERCURRENT PROTECTIVE DEVICE COORDINATION  
260923.....LIGHTING CONTROL DEVICES  
262200.....LOW-VOLTAGE TRANSFORMERS  
262413.....SWITCHBOARDS  
262416.....PANELBOARDS  
262726.....WIRING DEVICES  
262813.....FUSES  
262816.....ENCLOSED SWITCHES & CIRCUIT BREAKERS  
263213.....PACKAGED ENGINE DRIVEN GENERATORS  
263600.....TRANSFER SWITCHES  
263650.....GENERATOR CONNECTION CABINETS  
264113.....LIGHTNING PROTECTION  
264313.....SURGE PROTECTIVE DEVICES  
265100.....INTERIOR LIGHTING  
265600.....EXTERIOR LIGHTING

**DIVISION 27 - COMMUNICATIONS**

270010.....GENERAL COMMUNICATIONS REQUIREMENTS  
270500.....COMMON WORK RESULTS FOR COMMUNICATIONS  
270543.....UNDERGROUND DUCTS & RACEWAYS FOR COMMUNICATION SYSTEMS  
270548.....SEISMIC CONTROLS FOR COMMUNICATIONS  
271000.....STRUCTURED CABLING SYSTEM  
271100.....TELECOMMUNICATIONS EQUIPMENT ROOM FITTINGS  
271300.....COMMUNICATIONS BACKBONE CABLING  
271500.....COMMUNICATIONS HORIZONTAL CABLING  
274100.....AUDIO VIDEO SYSTEMS  
274116.....AUDIO VIDEO SYSTEMS EQUIPMENT  
275123.....INTERCOMMUNICATIONS & PROGRAM SYSTEMS

**DIVISION 28 - ELECTRONIC SAFETY & SECURITY SPECIFICATION**

280010.....GENERAL ELECTRONIC SAFETY & SECURITY REQUIREMENTS  
280015.....COMMON WORK RESULTS FOR ELECTRONIC SAFETY & SECURITY  
280020.....CONDUCTORS & CABLES FOR ELECTRONIC SAFETY & SECURITY  
280501.....COMMON WORK RESULTS FOR ELECTRONIC SECURITY  
280548.....SEISMIC CONTROLS FOR ELECTRONIC SAFETY & SECURITY  
281010.....CONDUCTORS & CABLES FOR ELECTRONIC SECURITY  
281300.....ACCESS CONTROL  
282300.....VIDEO SURVEILLANCE  
284600.....FIRE DETECTION & ALARM

**DIVISION 31 – EARTHWORK**

310516.....AGGREGATE BASE COURSE  
311000.....SITE CLEARING  
312000.....EARTHWORK  
312320.....EROSION & SEDIMENT CONTROL  
313116.....TERMITE CONTROL

**DIVISION 32 - EXTERIOR IMPROVEMENTS**

321216.....ASPHALTIC CONCRETE PAVING

**City of Wentzville MO Public Works Facility**

**Wentzville, Missouri**

PROJECT NO.: 19-040

321313.....CONCRETE PAVING  
323173.....CONCRETE PAVING JOINT SEALANTS  
323111.....GATE OPERATORS  
323115.....CHAIN LINK FENCES & GATES  
329000.....LANDSCAPING  
329210.....SEEDING & SODDING

**DIVISION 33 - UTILITIES**

334100.....STORM SEWER SYSTEMS

**DIVISION 41 - MATERIAL PROCESSING & HANDLING EQUIPMENT**

412200.....CRANES & HOISTS

**DIVISION 45 - INDUSTRY-SPECIFIED MANUFACTURING EQUIPMENT**

453900.....FABRICATED EQUIPMENT

END OF TABLE OF CONTENTS

## SECTION 002600 - PROCUREMENT SUBSTITUTION PROCEDURES

### 1.1 DEFINITIONS

- A. Procurement Substitution Requests: Requests for changes in products, materials, equipment, and methods of construction from those indicated in the Procurement and Contracting Documents, submitted prior to receipt of bids.
- B. Substitution Requests: Requests for changes in products, materials, equipment, and methods of construction from those indicated in the Contract Documents, submitted following Contract award. See Section 012500 "Substitution Procedures" for conditions under which Substitution requests will be considered following Contract award.

### 1.2 QUALITY ASSURANCE

- A. Compatibility of Substitutions: Investigate and document compatibility of proposed substitution with related products and materials. Engage a qualified testing agency to perform compatibility tests recommended by manufacturers.

### 1.3 PROCUREMENT SUBSTITUTIONS

- A. Procurement Substitutions, General: By submitting a bid, the Bidder represents that its bid is based on materials and equipment described in the Procurement and Contracting Documents, including Addenda. Bidders are encouraged to request approval of qualifying substitute materials and equipment when the Specifications Sections list materials and equipment by product or manufacturer name.
- B. Procurement Substitution Requests will be received and considered by Owner when the following conditions are satisfied, as determined by Architect; otherwise, requests will be returned without action:
  - 1. Extensive revisions to the Contract Documents are not required.
  - 2. Proposed changes are in keeping with the general intent of the Contract Documents, including the level of quality of the Work represented by the requirements therein.
  - 3. The request is fully documented and properly submitted.

### 1.4 SUBMITTALS

- A. Procurement Substitution Request: Submit to Architect. Procurement Substitution Request must be made in writing by prime contract Bidder only in compliance with the following requirements:
  - 1. Requests for substitution of materials and equipment will be considered if received no later than **February 6, 2023**.
  - 2. Submittal Format: Submit one copy of each written Procurement Substitution Request, using form bound in Project Manual.
    - a. Identify the product or the fabrication or installation method to be replaced in each request. Include related Specifications Sections and drawing numbers.
    - b. Provide complete documentation on both the product specified and the proposed substitute, including the following information as appropriate:
      - 1) Point-by-point comparison of specified and proposed substitute product data, fabrication drawings, and installation procedures.

**City of Wentzville MO Public Works Facility**

**Wentzville, Missouri**

**PROJECT NO.: 19-040**

- 2) Copies of current, independent third-party test data of salient product or system characteristics.
  - 3) Samples where applicable or when requested by Architect.
  - 4) Detailed comparison of significant qualities of the proposed substitute with those of the Work specified. Significant qualities may include attributes such as performance, weight, size, durability, visual effect, sustainable design characteristics, warranties, and specific features and requirements indicated. Indicate deviations, if any, from the Work specified.
  - 5) Material test reports from a qualified testing agency indicating and interpreting test results for compliance with requirements indicated.
  - 6) Research reports, where applicable, evidencing compliance with building code in effect for Project, from ICC-ES.
  - 7) Coordination information, including a list of changes or modifications needed to other parts of the Work and to construction performed by Owner and separate contractors, which will become necessary to accommodate the proposed substitute.
- c. Provide certification by manufacturer that the substitute proposed is equal to or superior to that required by the Procurement and Contracting Documents, and that its in-place performance will be equal to or superior to the product or equipment specified in the application indicated.
  - d. Bidder, in submitting the Procurement Substitution Request, waives the right to additional payment or an extension of Contract Time because of the failure of the substitute to perform as represented in the Procurement Substitution Request.
- B. Architect's Action:
1. Architect may request additional information or documentation necessary for evaluation of the Procurement Substitution Request. Architect will notify all bidders of acceptance of the proposed substitute by means of an Addendum to the Procurement and Contracting Documents.
- C. Architect's approval of a substitute during bidding does not relieve Contractor of the responsibility to submit required shop drawings and to comply with all other requirements of the Contract Documents.

END OF DOCUMENT 002600

SECTION 012500 - SUBSTITUTION REQUEST FORM

This form is to be used to submit product(s) for Architect or Engineers approval. **Requests for substitution will be considered if received no later than February 6, 2023.** Submit this document to Architect per section 012500.

To: \_\_\_\_\_

We hereby submit for your consideration the following product instead of the specified items for the above project:

Specification Section: \_\_\_\_\_

Proposed Substitution: \_\_\_\_\_

Attach complete Product description, drawings, photographs, performance and test data, and other information necessary for evaluation.

A. Will changes be required to building design in order to properly install proposed substitution?

YES \_\_\_\_ NO \_\_\_\_

If yes, explain \_\_\_\_\_

\_\_\_\_\_

B. What difference exists between proposed substitution and specified item?

\_\_\_\_\_

\_\_\_\_\_

C. Does manufacturer's warranty of proposed substitution differ from that specified?

YES \_\_\_\_ NO \_\_\_\_

If yes, explain \_\_\_\_\_

D. Will maintenance and service parts be locally available for substitution?

YES \_\_\_\_ NO \_\_\_\_

If yes, explain \_\_\_\_\_

\_\_\_\_\_  
COMPANY NAME

\_\_\_\_\_  
CONTACT PERSON

\_\_\_\_\_  
TELEPHONE

## SECTION 019113 - GENERAL COMMISSIONING REQUIREMENTS

### PART 1 - GENERAL

#### 1.1 RELATED DOCUMENTS

- A. Drawings and general provisions of the Contract, including General and Supplementary Conditions and other Division 01 Specification Sections, apply to this Section.

#### 1.2 SUMMARY

- A. Section Includes:
  - 1. General requirements for coordinating and scheduling commissioning activities.
  - 2. Commissioning meetings.
  - 3. Commissioning reports.
  - 4. Use of commissioning process test equipment, instrumentation, and tools.
  - 5. Construction checklists, including, but not limited to, installation checks, startup, performance tests, and performance test demonstration.
  - 6. Commissioning tests and commissioning test demonstration.
  - 7. Adjusting, verifying, and documenting identified systems and assemblies.
- B. Related Requirements:
  - 1. Section "Submittal Procedures" for submittal procedure requirements for commissioning process.
  - 2. Section "Closeout Procedures" for Certificate of Construction-Phase Commissioning Process Completion submittal requirements.
  - 3. Section "Operation and Maintenance Data" for preliminary operation and maintenance data submittal requirements.
- C. References:
  - 1. Commissioning is performed in accordance with relevant criteria documented in the ACG Commissioning Guideline for Building Owners, Design Professionals, and Commissioning Service Providers (AABC Commissioning Group) ISBN 0-910289-04-02.

#### 1.3 DEFINITIONS

- A. Acceptance Criteria: Threshold of acceptable work quality or performance specified for a commissioning activity, including, but not limited to, construction checklists, performance tests, performance test demonstrations, commissioning tests, and commissioning test demonstrations.



- B. Basis-of-Design Document: A document prepared by Architect that records concepts, calculations, decisions, and product selections used to comply with Owner's Project Requirements and to suit applicable regulatory requirements, standards, and guidelines.
- C. Commissioning Plan: A document, prepared by Commissioning Authority, that outlines the organization, schedule, allocation of resources, and documentation of commissioning requirements.
- D. Commissioning: A quality-focused process for verifying and documenting that the facility and all of its systems and assemblies are planned, designed, installed, and tested to comply with Owner's Project Requirements. The requirements specified here are limited to the construction phase commissioning activities. The scope of the commissioning process is defined in the Preliminary Commissioning Plan.
- E. Construction-Phase Commissioning-Process Completion: The stage of completion and acceptance of commissioning process when resolution of deficient conditions and issues discovered during commissioning process and retesting until acceptable results are obtained has been accomplished.
  - 1. Commissioning process is complete when the Work specified of this Section and related Sections has been completed and accepted, including, but not limited to, the following:
    - a. Completion of tests and acceptance of test results.
    - b. Resolution of issues, as verified by retests performed and documented with acceptance of retest results.
    - c. Comply with requirements in Section "Demonstration and Training."
    - d. Completion and acceptance of submittals and reports.
- F. Owner's Project Requirements: A document that details the functional requirements of a project and the expectations of how it will be used and operated, including Project goals, measurable performance criteria, cost considerations, benchmarks, success criteria, and supporting information. This document is prepared either by the Owner or for the Owner by the Architect or Commissioning Authority.
- G. Owner's Witness: Commissioning Authority, Owner's Project Manager, or Architect-designated witness authorized to authenticate test demonstration data.
- H. "Systems," "Assemblies," "Subsystems," "Equipment," and "Components": Where these terms are used together or separately, they shall mean "as-built" systems, assemblies, subsystems, equipment, and components.
- I. Test: Performance tests, performance test demonstrations, commissioning tests, and commissioning test demonstrations.

#### 1.4 COMPENSATION

- A. If Architect, Commissioning Authority, other Owner's witness, or Owner's staff perform additional services or incur additional expenses due to actions of Contractor listed below, compensate Owner for such additional services and expenses.
  - 1. Failure to provide timely notice of commissioning activities schedule changes.
  - 2. Failure to meet acceptance criteria for test demonstrations.

#### 1.5 COMMISSIONING TEAM

- A. Members Appointed by Contractor(s):
  - 1. Commissioning Coordinator: A person or entity employed by Contractor to manage, schedule, and coordinate commissioning process.
  - 2. Project superintendent and other employees that Contractor may deem appropriate for a particular portion of the commissioning process.
  - 3. Subcontractors, installers, suppliers, and specialists that Contractor may deem appropriate for a particular portion of the commissioning process.
  - 4. Appointed team members shall have the authority to act on behalf of the entity they represent.
- B. Members Appointed by Owner:
  - 1. Commissioning Authority, plus consultants that Commissioning Authority may deem appropriate for a particular portion of the commissioning process.
  - 2. Owner representative(s), facility operations and maintenance personnel, plus other employees, separate contractors, and consultants that Owner may deem appropriate for a particular portion of the commissioning process.
  - 3. Architect, plus employees and consultants that Architect may deem appropriate for a particular portion of the commissioning process.

#### 1.6 INFORMATIONAL SUBMITTALS

- A. Comply with requirements in Section "Submittal Procedures" for submittal procedure general requirements for commissioning process.
- B. Commissioning schedule.
- C. Two-week look-ahead schedules.
- D. Commissioning Coordinator Letter of Authority:
  - 1. Within 10 days after approval of Commissioning Coordinator qualifications, submit a letter of authority for Commissioning Coordinator, signed by a principal of Contractor's firm. Letter shall authorize Commissioning Coordinator to do the following:

- a. Make inspections required for commissioning process.
  - b. Coordinate, schedule, and manage commissioning process of Contractor, subcontractors, and suppliers.
  - c. Obtain documentation required for commissioning process from Contractor, subcontractors, and suppliers.
  - d. Report issues, delayed resolution of issues, schedule conflicts, and lack of cooperation or expertise on the part of members of the commissioning team.
- E. Commissioning Coordinator Qualification Data: For entity coordinating Contractor's commissioning activities to demonstrate their capabilities and experience.
  - 1. Experienced: When used with an entity or individual, "experienced" means having successfully completed a minimum of three previous projects similar in nature, size, and extent to this Project; being familiar with special requirements indicated; and having complied with requirements of authorities having jurisdiction.
- F. Test Reports:
  - 1. Templates: Immediately following submittal approval, submit original equipment manufacturer's installation and startup requirements. Such requirements may be included in the submittal of the Installation, Operation and Maintenance (IOM) manual.
  - 2. Installing Contractors' Quality Assurance Process: Immediately following submittal approval, submit the forms used as part of the installing contractor's quality assurance process.
  - 3. Pre-Startup Report: Prior to startup of equipment or a system, submit signed, completed construction checklists.
  - 4. Test Data Reports: At the end of each day in which tests are conducted, submit test data for tests performed.
  - 5. Commissioning Issue Reports: Daily, at the end of each day in which tests are conducted, submit commissioning issue reports for tests for which acceptable results were not achieved.
  - 6. Weekly Progress Report: Weekly, at the end of each week in which tests are conducted, submit a progress report.
- G. Construction Checklists
  - 1. Templates: Construction Checklist templates shall be submitted immediately following the equipment submittal approval, before the start of the field commissioning process.
  - 2. Completed Construction Checklists: Submitted each checklist immediately following completion of the field commissioning process.
  - 3. Submit for:
    - a. Material checks.
    - b. Installation checks.
    - c. Startup procedures, where required.
- H. Commissioning Final Report:

1. The CxA shall provide a final report following the completion of Testing, excluding seasonal and deferred Tests. Seasonal and deferred test results shall be attached to or inserted in the final report in a clear and readily identified manner. The report is to outline compliance and non-compliance with the construction documents, as well as identify concerns relative to future performance

## PART 2 - PRODUCTS

### 2.1 TEST EQUIPMENT, INSTRUMENTATION, AND TOOLS

- A. Test equipment and instrumentation required to perform the commissioning process shall remain the property of Contractor unless otherwise indicated.
- B. Test equipment and instrumentation required to perform commissioning process shall comply with the following criteria:
  1. Be manufactured for the purpose of testing and measuring tests for which they are being used and have an accuracy to test and measure system performance within the tolerances required to determine acceptable performance.
  2. Calibrated and certified.
    - a. Calibration performed and documented by a qualified calibration agency according to national standards applicable to the tools and instrumentation being calibrated. Calibration shall be current according to national standards or within test equipment and instrumentation manufacturer's recommended intervals, whichever is more frequent, but not less than within six months of initial use on Project. Calibration tags shall be permanently affixed.
    - b. Repair and recalibrate test equipment and instrumentation if dismantled, dropped, or damaged since last calibrated.
  3. Maintain test equipment and instrumentation.
  4. Use test equipment and instrumentation only for testing or monitoring Work for which they are designed.

### 2.2 PROPRIETARY TEST EQUIPMENT, INSTRUMENTATION, AND TOOLS

- A. Proprietary test equipment, instrumentation, and tools are those manufactured or prescribed by tested equipment manufacturer and required for work on its equipment as a condition of equipment warranty, or as otherwise required to service, repair, adjust, calibrate, or perform work on its equipment.
  1. Identify proprietary test equipment, instrumentation, and tools required in the test equipment identification list submittal.
  2. Proprietary test equipment, instrumentation, and tools shall become the property of Owner at Substantial Completion.

## 2.3 CONSTRUCTION CHECKLISTS FORMAT AND ORGANIZATION

### A. Commissioning Report:

1. Include a table of contents and an index to each test.
2. Include major tabs for each Specification Section.
3. Include minor tabs for each test.
4. Within each minor tab, include the following:
  - a. Test specification.
  - b. Pre-startup reports.
  - c. Approved test procedures.
  - d. Test data forms, completed and signed.
  - e. Commissioning issue reports, showing resolution of issues, and documentation related to resolution of issues pertaining to a single test. Group data forms, commissioning issue reports showing resolution of issues, and documentation related to resolution of issues for each test repetition together within the minor tab, in reverse chronological order (most recent on top).

### B. General Format and Organization

1. Construction Checklists shall be submitted in portable document format (PDF); with outline-organized bookmarks for major and minor tabs and tab contents itemized for specific reports.
2. PDF Files shall be organized using a logical filing structure based on the following categories.
  - a. Division
  - b. Location
  - c. Project Phasing
  - d. Application
  - e. Chronology

### C. Tracking

1. Maintain a log that tracks each Construction Checklist by:
  - a. Division.
  - b. Section.
  - c. Location.
  - d. Application.
  - e. Date completed.
  - f. Date submitted.
2. Issue timely transmittals that notify the Commissioning Authority of updates to the Construction Checklists.

## PART 3 - EXECUTION

### 3.1 COMMISSIONING PLAN

- A. A Preliminary Commissioning Plan shall be developed by the Commissioning Authority.

### 3.2 EQUIPMENT

#### A. Division 22

- 1. Domestic Water Heaters
- 2. Domestic Water Heater Pumps
- 3. Expansion/Storage Tanks

#### B. Division 23

- 1. Roof Top Units (RTU)
- 2. Aquatic Air Handling Units (PAHU)
- 3. Variable Air Volume Units (VAV)
- 4. Supply Air Valves
- 5. Return Air Valves
- 6. Exhaust Air Valves
- 7. Exhaust Fans
- 8. Hot Water Boilers
- 9. Pool Boilers
- 10. Heating Water Pumps
- 11. Hydronic Cabinet Unit Heaters
- 12. Air Separator
- 13. Building Automation System (BAS)

#### C. Division 26

- 1. Lighting controls
- 2. Variable frequency drives (VFDs)

### 3.3 PREPARATION

- A. Review preliminary construction checklists and preliminary test procedures and data forms.

### 3.4 CONSTRUCTION CHECKLISTS

- A. Construction checklists cannot modify or conflict with the Contract Documents.
- B. Create construction checklists based on actual systems and equipment to be included in Project.

- C. Material Checks: Compare specified characteristics and approved submittals with materials as received. Include factory tests and other evaluations, adjustments, and tests performed prior to shipment if applicable.
  - 1. Service connection requirements, including configuration, size, location, and other pertinent characteristics.
  - 2. Included optional features.
  - 3. Delivery Receipt Check: Inspect and record physical condition of materials and equipment on delivery to Project site, including agreement with approved submittals, cleanliness, and lack of damage.
  - 4. Installation Checks:
    - a. Location according to Drawings and approved Shop Drawings.
    - b. Configuration.
    - c. Compliance with manufacturers' written installation instructions.
    - d. Attachment to structure.
    - e. Access clearance to allow for maintenance, service, repair, removal, and replacement without the need to disassemble or remove other equipment or building elements. Access coordinated with other building elements and equipment, including, but not limited to, ceiling and wall access panels, in a manner consistent with OSHA fall-protection regulations and safe work practices.
    - f. Utility connections are of the correct characteristics, as applicable.
    - g. Correct labeling and identification.
    - h. Startup Checks: Verify readiness of equipment to be energized. Include manufacturer's standard startup procedures and forms.
- D. Startup: Perform and document initial operation of equipment to prove that it is installed properly and operates as intended according to manufacturer's standard startup procedures, at minimum.
- E. Performance Tests:
  - 1. Static Tests: As specified elsewhere, including, but not limited to, duct and pipe leakage tests, insulation-resistance tests, and water-penetration tests.
  - 2. Component Performance Tests: Tests evaluate the performance of an input or output of components under a full range of operating conditions.
  - 3. Equipment and Assembly Performance Tests: Test and evaluate performance of equipment and assemblies under a full range of operating conditions and loads.
  - 4. System Performance Tests: Test and evaluate performance of systems under a full range of operating conditions and loads.
  - 5. Intersystem Performance Tests: Test and evaluate the interface of different systems under a full range of operating conditions and loads.
- F. Deferred Construction Checklists: Obtain Owner approval of proposed deferral of construction checklists, including proposed schedule of completion of each deferred construction checklist, before submitting request for Certificate of Construction-Phase Commissioning Process Completion. When approved, deferred construction checklists may be completed after date of

Construction-Phase Commissioning Completion. Include the following in a request for Certificate of Construction-Phase Commissioning Process Completion:

1. Identify deferred construction checklists by number and title.
2. Provide a target schedule for completion of deferred construction checklists.
3. Written approval of proposed deferred construction checklists, including approved schedule of completion of each deferred construction checklist.

- G. Delayed Construction Checklists: Obtain Owner approval of proposed delayed construction checklists, including proposed schedule of completion of each delayed construction checklist, before submitting request for Certificate of Construction-Phase Commissioning Process Completion. When approved, delayed construction checklists may be completed after date of Construction-Phase Commissioning Completion. Include the following in a request for Certificate of Construction-Phase Commissioning Process Completion:

1. Identify delayed construction checklist by construction checklist number and title.
2. Provide a target schedule for completion of delayed construction checklists.
3. Written approval of proposed delayed construction checklists, including approved schedule of completion of each delayed construction checklist.

### 3.5 GENERAL EXECUTION REQUIREMENTS

- A. Schedule and coordinate commissioning process with the Construction Schedule.
- B. Perform activities identified in construction checklists, including tests, and document results of actions as construction proceeds.
- C. Report test data and commissioning issue resolutions.
- D. Schedule personnel to participate in and perform Commissioning-Process Work.
- E. Installing contractors' commissioning responsibilities include, but are not limited to, the following:
  1. Operating the equipment and systems they install during tests.
  2. In addition, installing contractors may be required to assist in tests of equipment and systems with which their work interfaces.

### 3.6 COMMISSIONING COORDINATOR RESPONSIBILITIES

- A. Management and Coordination: Manage, schedule, and coordinate commissioning process, including, but not limited to, the following:
  1. Coordinate with subcontractors on their commissioning responsibilities and activities.
  2. Obtain, assemble, and submit commissioning documentation.
  3. Conduct periodic on-site start-up and commissioning meetings.



4. Develop and maintain the commissioning schedule. Integrate commissioning schedule into the Construction Schedule. Update Construction Schedule at specified intervals.
5. Review and comment on preliminary test procedures and data forms.
6. Report inconsistencies and issues in system operations.
7. Verify that tests have been completed and results comply with acceptance criteria, and that equipment and systems are ready before scheduling test demonstrations.
8. Direct and coordinate test demonstrations.
9. Coordinate witnessing of test demonstrations by Owner's witness.
10. Coordinate and manage training. Be present during training sessions to direct video recording, present training, and direct the training presentations of others. Comply with requirements in Section "Demonstration and Training."
11. Prepare and submit specified commissioning reports.
12. Track commissioning issues until resolution and retesting is successfully completed.
13. Retain original records of Commissioning-Process Work, organized as required for the commissioning report. Provide Owner's representative access to these records on request.

### 3.7 COMMISSIONING TESTING

- A. Quality Control: Construction checklists, including tests, are quality-control tools designed to improve the functional quality of Project. Test demonstrations evaluate the effectiveness of Contractor's quality-assurance process.
- B. Owner's witness will be present to witness commissioning work requiring the signature of an owner's witness, including, but not limited to, test demonstrations. Owner's project manager will coordinate attendance by Owner's witness with Contractor's published Commissioning Schedule. Owner's witness will provide no labor or materials in the commissioning work. The only function of Owner's witness will be to observe and comment on the progress and results of commissioning process.
- C. Construction Checklists:
  1. Complete construction checklists as Work is completed.
  2. Distribute construction checklists to installing contractors before they start work.
  3. Installers:
    - a. Verify installation using approved construction checklists as Work proceeds.
    - b. Complete and sign construction checklists weekly for work performed during the preceding week.
  4. Provide Commissioning Authority access to construction checklists.
- D. Installation Compliance Issues: Record as an installation compliance issue Work found to be incomplete, inaccessible, at variance with the Contract Documents, nonfunctional, or that does not comply with construction checklists. Record installation compliance issues on the construction checklist at the time they are identified. Record corrective action and how future Work should be modified before signing off the construction checklist.

- E. Pre-Startup Audit: Prior to executing startup procedures, review completed installation checks to determine readiness for startup and operation. Report conditions, which, if left uncorrected, adversely impact the ability of systems or equipment to operate satisfactorily or to comply with acceptance criteria. Prepare pre-startup report for each system.
- F. Test Procedures and Test Data Forms:
1. Test procedures shall define the step-by-step procedures to be used to execute tests and test demonstrations.
  2. Test procedures shall be specific to the make, model, and application of the equipment and systems being tested.
  3. Completed test data forms are the official records of the test results.
  4. Commissioning Authority will provide to Contractor preliminary test procedures and test data forms for performance tests and commissioning tests after approval of Product Data, Shop Drawings, and preliminary operation and maintenance manual.
  5. Instead of the Commissioning Authority providing test procedures and test data forms, Commissioning Authority may elect to use original equipment manufacturers' installation and startup requirements, or tests that are a part of the installing contractor's internal quality assurance process.
  6. Review preliminary test procedures and test data forms, and provide comments within 14 days of receipt from Commissioning Authority. Review shall address the following:
    - a. Equipment protection and warranty issues, including, but not limited to, manufacturers' installation and startup recommendations, and operation and maintenance instructions.
    - b. Applicability of the procedure to the specific software, equipment, and systems approved for installation.
- G. Performance of Tests:
1. The sampling rate for tests is 100 percent. The sampling rate for test demonstrations is 100 percent unless otherwise indicated. (Reference commissioning plan for sampling rates).
  2. Perform and complete each step of the approved test procedures in the order listed.
  3. Record data observed during performance of tests on approved data forms at the time of test performance and when the results are observed.
  4. Record test results that are not within the range of acceptable results on commissioning issue report forms in addition to recording the results on approved test procedures and data forms according to the "Commissioning Compliance Issues" Paragraph in this Article.
  5. On completion of a test, sign the completed test procedure and data form. Tests for which test procedures and data forms are incomplete, not signed, or which indicate performance that does not comply with acceptance criteria will be rejected. Tests for which test procedures and data forms are rejected shall be repeated and results resubmitted.
- H. Performance of Test Demonstration:

1. Perform test demonstrations on the first test for any equipment type or class, and on a sample of subsequent tests. The sampling rate for test demonstrations shall be 100 percent unless otherwise indicated in the individual test specification.
2. Notify Owner's witness at least one week in advance of each test demonstration.
3. Perform and complete each step of the approved test procedures in the order listed.
4. Record data observed during performance of test demonstrations on approved data forms at the time of demonstration and when the results are observed.
5. Provide full access to Owner's witness to directly observe the performance of all aspects of system response during the test demonstration. On completion of a test demonstration, sign the completed data form and obtain signature of Owner's witness at the time of the test to authenticate the reported results.
6. Test demonstration data forms not signed by Contractor and Owner's witness at the time of the completion of the procedure will be rejected. Test demonstrations for which data forms are rejected shall be repeated and results shall be resubmitted.
  - a. Exception for Failure of Owner's Witness to Attend: Failure of Owner's witness to be present for agreed-on schedule of test demonstration shall not delay Contractor. If Owner's witness fails to attend a scheduled test, Contractor shall proceed with the scheduled test. On completion, Contractor shall sign the data form for Contractor and for Owner's witness, and shall note the absence of Owner's witness at the scheduled time and place.
7. False load test requirements are specified in related sections.
  - a. Where false load testing is specified, provide temporary equipment, power, controls, wiring, piping, valves, and other necessary equipment and connections required to apply the specified load to the system. False load system shall be capable of steady-state operation and modulation at the level of load specified. Equipment and systems permanently installed in this work shall not be used to create the false load without Architect's written approval.

I. Deferred Tests:

1. Deferred Test List: Identify proposed deferred tests and provide a target schedule for completion of deferred tests. When approved, deferred tests may be completed after the date of Construction-Phase Commissioning Completion.
2. Schedule and coordinate deferred tests. Schedule deferred tests when specified conditions are available. Notify Architect and Commissioning Authority at least one week (minimum) in advance of tests.
3. Where deferred tests are specified, coordinate participation of necessary personnel and of Architect, Commissioning Authority, and Owner's witness. Schedule deferred tests to minimize occupant and facility impact. Obtain Architect's approval of the proposed schedule.

J. Commissioning Compliance Issues:

1. Test results that are not within the range of acceptable results are commissioning compliance issues.

2. Track and report commissioning compliance issues until resolution and retesting are successfully completed.
3. If a test demonstration fails, determine the cause of failure. Direct timely resolution of issue and then repeat the demonstration. If a test demonstration must be repeated due to failure caused by Contractor work or materials, reimburse Owner for billed costs for the participation in the repeated demonstration.
4. Test Results: If a test demonstration fails to meet the acceptance criteria, perform the following:
  - a. Complete a commissioning compliance issue report form promptly on discovery of test results that do not comply with acceptance criteria.
  - b. Submit commissioning compliance issue report form within two days of the test failure.
  - c. Determine the cause of the failure.
  - d. Establish responsibility for corrective action if the failure is due to conditions found to be Contractor's responsibility.
5. Commissioning Compliance Issue Report: Provide a commissioning compliance issue report for each issue. Do not report multiple issues on the same commissioning compliance issue report.
  - a. Exception: If an entire class of devices is determined to exhibit the identical issue, they may be reported on a single commissioning compliance issue report. (For example, if all return-air damper actuators that are specified to fail to the open position are found to fail to the closed position, they may be reported on a single commissioning issue report. If a single commissioning issue report is used for multiple commissioning compliance issues, each device shall be identified in the report, and the total number of devices at issue shall be identified.
6. Diagnose and correct failed test demonstrations as follows:
  - a. Perform diagnostic tests and activities required to determine the fundamental cause of issues observed.
  - b. Record each step of the diagnostic procedure prior to performing the procedure. Update written procedure as changes become necessary.
  - c. Record the results of each step of the diagnostic procedure.
  - d. Record the conclusion of the diagnostic procedure on the fundamental cause of the issue.
  - e. Determine and record corrective measures.
  - f. Include diagnosis of fundamental cause of issues in commissioning compliance issue report.
7. Retest:
  - a. Schedule and repeat the complete test procedure for each test demonstration for which acceptable results are not achieved. Obtain signature of Owner's witness on retest data forms. Repeat test demonstration until acceptable results are achieved. Except for issues that are determined to result from design errors or omissions, or

other conditions beyond Contractor's responsibility, compensate Owner for direct costs incurred as the result of repeated test demonstrations to achieve acceptable results.

- b. For each repeated test demonstration, submit a new test data form, marked "Retest."

8. Do not correct commissioning compliance issues during test demonstrations.

- a. Exceptions will be allowed if the cause of the issue is obvious and resolution can be completed without noticeable delays to the test process. If corrections are made under this exception, note the deficient conditions on the test data form.

### 3.8 COMMISSIONING MEETINGS

- A. Schedule and conduct commissioning meetings. Comply with requirements in Section "Project Management and Coordination."

### 3.9 SEQUENCING

- A. Sequencing of Commissioning Verification Activities: For a particular material, item of equipment, assembly, or system, perform the following in the order listed unless otherwise indicated:

1. Construction Checklists:

- a. Material checks.
- b. Installation checks.
- c. Startup, as appropriate. Some startup may depend on component performance. Such startup may follow component performance tests on which the startup depends.
- d. Performance Tests:
  - 1) Static tests, as appropriate.
  - 2) Component performance tests. Some component performance tests may depend on completion of startup. Such component performance tests may follow startup.
  - 3) Equipment and assembly performance tests.
  - 4) System performance tests.
  - 5) Intersystem performance tests.

2. Commissioning tests.

- B. Before performing commissioning tests, verify that materials, equipment, assemblies, and systems are delivered, installed, started, and adjusted to perform according to construction checklists.

- C. Verify readiness of materials, equipment, assemblies, and systems by performing tests prior to performing test demonstrations. Notify Architect if acceptable results cannot be achieved due to conditions beyond Contractor's control or responsibility.
- D. Commence tests as soon as installation checks for materials, equipment, assemblies, or systems are satisfactorily completed. Tests of a particular system may proceed prior to completion of other systems, provided the incomplete work does not interfere with successful execution of test.

### 3.10 SCHEDULING

- A. Commence commissioning process as early in the construction period as possible.
- B. Commissioning Schedule: Integrate commissioning activities into Construction Schedule. See Section "Construction Progress Documentation."
  - 1. Include detailed commissioning activities in monthly updated Construction Schedule and short-interval schedule submittals.
  - 2. Schedule the start date and duration for the following commissioning activities:
    - a. Submittals.
    - b. Preliminary operation and maintenance manual submittals.
    - c. Installation checks.
    - d. Startup, where required.
    - e. Third party tests.
    - f. Performance tests.
    - g. Performance test demonstrations.
    - h. Commissioning tests.
    - i. Commissioning test demonstrations.
  - 3. Schedule shall include a line item for each installation check, startup, and test activity specific to the equipment or systems involved.
  - 4. Determine milestones and prerequisites for commissioning process. Show commissioning milestones, prerequisites, and dependencies in monthly updated critical-path-method construction schedule and short-interval schedule submittals.
- C. Two-Week Look-Ahead Commissioning Schedule:
  - 1. Two weeks prior to the beginning of tests, submit a detailed two-week look-ahead schedule. Thereafter, submit updated two-week look-ahead schedules weekly for the duration of commissioning process.
  - 2. Two-week look-ahead schedules shall identify the date, time, beginning location, Contractor personnel required, and anticipated duration for each startup or test activity.
  - 3. Use two-week look-ahead schedules to notify and coordinate participation of Owner's witnesses.
- D. Owner's Witness Coordination:

1. Coordinate Owner's witness participation via Architect.
2. Notify Architect of commissioning schedule changes at least two work days in advance for activities requiring the participation of Owner's witness.

### 3.11 COMMISSIONING REPORTS

#### A. Test Reports:

1. Pre-startup reports include observations of the conditions of installation, organized into the following sections:
  - a. Equipment Model Verification: Compare contract requirements, approved submittals, and provided equipment. Note inconsistencies.
  - b. Preinstallation Physical Condition Checks: Observe physical condition of equipment prior to installation. Note conditions including, but not limited to, physical damage, corrosion, water damage, or other contamination or dirt.
  - c. Preinstallation Component Verification Checks: Verify components supplied with the equipment, preinstalled or field installed, are correctly installed and functional. Verify external components required for proper operation of equipment correctly installed and functional. Note missing, improperly configured, improperly installed, or nonfunctional components.
  - d. Summary of Installation Compliance Issues and Corrective Actions: Identify installation compliance issues and the corrective actions for each. Verify that issues noted have been corrected.
  - e. Evaluation of System Readiness for Startup: For each item of equipment for each system for which startup is anticipated, document in summary form acceptable to Owner completion of equipment model verification, preinstallation physical condition checks, preinstallation component verification checks, and completion of corrective actions for installation compliance issues.
2. Test data reports include the following:
  - a. "As-tested" system configuration. Complete record of conditions under which the test was performed, including, but not limited to, the status of equipment, systems, and assemblies; temporary adjustments and settings; and ambient conditions.
  - b. Data and observations, including, but not limited to, data trend logs, recorded during the tests.
  - c. Signatures of individuals performing and witnessing tests.
  - d. Data trend logs accumulated overnight from the previous day of testing.
3. Commissioning Compliance Issue Reports: Report as commissioning compliance issues results of tests and test demonstrations that do not comply with acceptance criteria. Report only one issue per commissioning compliance issue report. Use sequentially numbered facsimiles of commissioning compliance issue report form included in this Section, or other form approved by Owner. Distribute commissioning compliance issue reports to parties responsible for taking corrective action. Identify the following:

- a. Commissioning compliance issue report number. Assign unique, sequential numbers to individual commissioning compliance issue reports when they are created, to be used for tracking.
  - b. Action distribution list.
  - c. Report date.
  - d. Test number and description.
  - e. Equipment identification and location.
  - f. Briefly describe observations about the performance associated with failure to achieve acceptable results. Identify the cause of failure if apparent.
  - g. Diagnostic procedure or plan to determine the cause (include in initial submittal)
  - h. Diagnosis of fundamental cause of issues as specified below (include in resubmittal).
  - i. Fundamental cause of unacceptable performance as determined by diagnostic tests and activities.
  - j. When issues have been resolved, update and resubmit the commissioning issue report forms by completing Part 2. Identify resolution taken and the dates and initials of the persons making the entries.
  - k. Schedule for retesting.
4. Weekly progress reports include information for tests conducted since the preceding report and the following:
  - a. Completed data forms.
  - b. Equipment or system tested, including test number, system or equipment tag number and location, and notation about the apparent acceptability of results.
  - c. Activities scheduled but not conducted per schedule.
  - d. Commissioning compliance issue report log.
  - e. Schedule changes for remaining Commissioning-Process Work, if any.
5. Data trend logs shall be initiated and running prior to the time scheduled for the test demonstration.
  - a. Trend log data format shall be multiple data series graphs. Where multiple data series are trend logged concurrently, present the data on a common horizontal time axis. Individual data series may be presented on a segmented vertical axis to avoid interference of one data series with another, and to accommodate different axis scale values. Graphs shall be sufficiently clear to interpret data within the accuracy required by the acceptance criteria.
  - b. Attach to the data form printed trend log data collected during the test or test demonstration.
  - c. Record, print out, and attach to the data form operator activity during the time the trend log is running. During the time the trend log is running, operator intervention not directed by the test procedure invalidates the test results.
6. System Alarm Logs: Record and print out a log of alarms that occurred since the last log was printed. Evaluate alarms to determine if the previous day's work resulted in any conditions that are not considered "normal operation."



- a. Conditions that are not considered "normal operation" shall be reported on a commissioning issue report attached to the alarm log. Resolve as necessary. The intent of this requirement is to discover control system points or sequences left in manual or disabled conditions, equipment left disconnected, set points left with abnormal values, or similar conditions that may have resulted from failure to fully restore systems to normal, automatic control after test completion.
- B. Test Reports Format:
  1. Hard copy test reports shall comply with requirements in Section "Submittal procedures".
  2. Electronic test reports shall comply with requirements in Section "Submittal procedures".
- C. Digital Test Reports
  1. Digital Test Reports are completed on-site using test report software operating on a mobile platform (eg: cell-phones, tablets, laptops).
  2. Digital Test Reports may be used to replace hand-written field data, subject to approval by Commissioning Authority and Owner.
- D. Commissioning Final Report:
  1. The CxA shall provide a final report following the completion of Testing, excluding seasonal and deferred Tests. Seasonal and deferred test results shall be attached to or inserted in the final report in a clear and readily identified manner. The report is to outline compliance and non-compliance with the construction documents, as well as identify concerns relative to future performance

### 3.12 COMMISSIONING PROCESS COMPLETION

- A. When Contractor considers that construction-phase commissioning process, or a portion thereof which Owner agrees to accept separately, is complete, Contractor shall prepare and submit to Owner and Commissioning Authority through Architect a comprehensive list of items to be completed or corrected. Failure to include an item on such list does not alter Contractor's responsibility to complete commissioning process.
- B. On receipt of Contractor's list, Commissioning Authority will make an inspection to determine whether the construction-phase commissioning process or designated portion thereof is complete. If Commissioning Authority's inspection discloses items, whether included on Contractor's list, which is not sufficiently complete as defined in "Construction-Phase Commissioning Process Completion" Paragraph in the "Definitions" Article, Contractor shall complete or correct such items on notification by Commissioning Authority. In such case, Contractor shall then submit a request for another inspection by Commissioning Authority to determine construction-phase commissioning process completion.
- C. Contractor shall promptly correct deficient conditions and issues discovered during commissioning process. Costs of correcting such deficient conditions and issues, including additional testing and inspections, the cost of uncovering and replacement, and compensation

for Architect's and Commissioning Authority's services and expenses made necessary thereby,  
shall be at Contractor's expense.

END OF SECTION 019113

## SECTION 042200 - CONCRETE UNIT MASONRY

### PART 1 - GENERAL

#### 1.1 SUMMARY

- A. Section Includes:
  - 1. Interior and Exterior concrete masonry units
  - 2. (Removed)
  - 3. Mortar and grout.
  - 4. Steel reinforcing bars.
  - 5. Masonry joint reinforcement.
  - 6. Ties and anchors.
  - 7. Miscellaneous masonry accessories.

#### 1.2 RELATED SECTION

- A. Thermal Insulation

#### 1.3 PRECONSTRUCTION TESTING

- A. Preconstruction Testing Service: General Contractor will engage a qualified independent testing agency to perform preconstruction testing indicated below. Retesting of materials that fail to comply with specified requirements shall be done at Contractor's expense.
  - 1. Concrete Masonry Unit Test: For each type of unit required, according to ASTM C 140 for compressive strength.
  - 2. Mortar Test (Property Specification): For each mix required, according to ASTM C 109/C 109M for compressive strength, ASTM C 1506 for water retention, and ASTM C 91 for air content.
  - 3. Mortar Test (Property Specification): For each mix required, according to ASTM C 780 for compressive strength.
  - 4. Grout Test (Compressive Strength): For each mix required, according to ASTM C 1019.
  - 5. Prism Test: For each type of construction required, according to ASTM C 1314.

#### 1.4 SUBMITTALS

- A. Product Data: For each type of product indicated.
- B. Shop Drawings:
  - 1. Masonry Units: Show sizes, profiles, coursing, and locations of special shapes.
  - 2. Reinforcing Steel: Detail bending and placement of unit masonry reinforcing bars. Comply with ACI 315, "Details and Detailing of Concrete Reinforcement."
  - 3. Fabricated Flashing: Detail corner units, end-dam units, and other special applications.
- C. (Removed)
- D. List of Materials Used in Constructing Mockups: List generic product names together with manufacturers, manufacturers' product names, model numbers, lot numbers, batch numbers, source of supply, and other information as required to identify materials used. Include mix proportions for mortar and grout and source of aggregates.
  - 1. Submittal is for information only. Neither receipt of list nor approval of mockup constitutes approval of deviations from the Contract Documents unless such deviations are specifically brought to the attention of Architect and approved in writing.

## City of Wentzville MO Public Works Facility

### Wentzville, Missouri

PROJECT NO.: 19-040

- E. Material Certificates: For each type and size of the following:
  - 1. Masonry units.
    - a. Include data on material properties.
    - b. For masonry units used in structural masonry, include data and calculations establishing average net-area compressive strength of units.
  - 2. Cementitious materials. Include brand, type, and name of manufacturer.
  - 3. Preblended, dry mortar mixes. Include description of type and proportions of ingredients.
    - a. Grout mixes. Include description of type and proportions of ingredients.
    - b. Reinforcing bars.
    - c. Joint reinforcement.
    - d. Anchors, ties, and metal accessories.
- F. Mix Designs: For each type of mortar and grout. Include description of type and proportions of ingredients.
  - 1. Include test reports for mortar mixes required to comply with property specification. Test according to ASTM C 109/C 109M for compressive strength, ASTM C 1506 for water retention, and ASTM C 91 for air content.
  - 2. Include test reports, according to ASTM C 1019, for grout mixes required to comply with compressive strength requirement.
- G. Statement of Compressive Strength of Masonry: For each combination of masonry unit type and mortar type, provide statement of average net-area compressive strength of masonry units, mortar type, and resulting net-area compressive strength of masonry determined according to Tables 1 and 2 in ACI 530.1/ASCE 6/TMS 602.
- H. Cold-Weather and Hot-Weather Procedures: Detailed description of methods, materials, and equipment to be used to comply with requirements.

#### 1.5 QUALITY ASSURANCE

- A. Masonry Standard: Comply with ACI 530.1/ASCE 6/TMS 602, Quality Assurance to be equal to Level B.
- B. Sample Panels: Build sample "mock up" panel on site with selected **masonry materials**.
  - 1. Build sample panels approximately 48" high by 48" wide **of CMU block**. Mock up to include typical installation of thru-wall flashing, ties, horizontal reinforcing, mortar net, weeps, expansion joint and caulking method.
- C. Sample panel construction will be reviewed and approved by owner and architect for quality to be maintained during the construction of the buildings. Mock up to remain on site until wall construction is completed.

#### 1.6 PROJECT CONDITIONS

- A. Cold-Weather Requirements: Do not use frozen materials or materials mixed or coated with ice or frost. Do not build on frozen substrates. Remove and replace unit masonry damaged by frost or by freezing conditions. Comply with cold-weather construction requirements contained in ACI 530.1/ASCE 6/TMS 602.
- B. Hot-Weather Requirements: Comply with hot-weather construction requirements contained in ACI 530.1/ASCE 6/TMS 602.

- C. Protection of Masonry: During construction, cover tops of walls, projections, and sills with waterproof sheeting at end of each day's work. Cover partially completed masonry when construction is not in progress.
  - 1. Extend cover a minimum of 24 inches down both sides of walls and hold cover securely in place.
  - 2. Where one wythe of multiwythe masonry walls is completed in advance of other wythes, secure cover a minimum of 24 inches down face next to unconstructed wythe and hold cover in place.
- D. Do not apply uniform floor or roof loads for at least 12 hours and concentrated loads for at least three days after building masonry walls or columns.
- E. Stain Prevention: Prevent grout, mortar, and soil from staining the face of masonry to be left exposed or painted. Immediately remove grout, mortar, and soil that come in contact with such masonry.
  - 1. Protect base of walls from rain-splashed mud and from mortar splatter by spreading coverings on ground and over wall surface.
  - 2. Protect sills, ledges, and projections from mortar droppings.
  - 3. Protect surfaces of window and door frames, as well as similar products with painted and integral finishes, from mortar droppings.
  - 4. Turn scaffold boards near the wall on edge at the end of each day to prevent rain from splashing mortar and dirt onto completed masonry.
- F. Cold Weather Protection:
  - 1. Do not lay masonry when the temperature of outside air is below 40 deg. F, unless means are provided to heat and maintain the temperature of the masonry materials and protect the completed work from freezing, and as may be permitted with the use of non-chloride accelerator. Protection shall consist of heating and maintaining the temperature of the masonry materials to at least 40 deg F, and maintaining an air temperature above 40 deg. F on both sides of the masonry for at least 48 hours as follows:
    - a. Cold-Weather Construction: Heat mixing water and sand to produce mortar and grout temperatures between 40 and 120 deg F (4 and 49 deg C). Maintain mortar and grout above freezing. Heat masonry units to 40 deg F (4 deg C) if grouting.
    - b. Cold-Weather Protection: Cover masonry with insulating blankets or provide enclosure and heat to maintain temperatures above 32 deg F (0 deg C) for 48 hours after construction. Install wind breaks when wind velocity exceeds 15 mi./h (25 km/h).
  - 2. Do not lay masonry units which are wet or frozen. Do not build on frozen subgrade or setting beds.
  - 3. Remove any ice or snow formed on masonry bed by carefully applying heat until top surface is dry to the touch.
  - 4. Remove and replace masonry damaged by freezing conditions.
  - 5. Do not use additives or accelerators with calcium chloride. Other accelerators may be used but only with approval of Architect.
- G. Hot-Weather Requirements: Comply with hot-weather construction requirements contained in ACI 530.1/ASCE 6/TMS 602.
- H. Protect unit masonry work when temperature and humidity conditions produce excessive evaporation of water from mortar and grout. Provide artificial shade and wind breaks and use cooled materials as required. Do not apply mortar to substrates with temperatures of 100 deg F and above

**City of Wentzville MO Public Works Facility**

**Wentzville, Missouri**

PROJECT NO.: 19-040

**PART 2 - PRODUCTS**

**2.1 MASONRY UNITS, GENERAL**

- A. Defective Units: Referenced masonry unit standards may allow a certain percentage of units to contain chips, cracks, or other defects exceeding limits stated in the standard. Do not use units where such defects will be exposed in the completed Work.
- B. Fire-Resistance Ratings: Where indicated, provide units that comply with requirements for fire-resistance ratings indicated as determined, by equivalent masonry thickness, or by other means, as acceptable to authorities having jurisdiction.

**2.2 CONCRETE MASONRY UNITS**

- A. Shapes: Provide shapes indicated and for lintels, corners, jambs, sashes, movement joints, headers, bonding, and other special conditions.
- B. Standard Concrete Masonry Units:
  - 1. Unit size: Thickness as shown on plans with nominal face dimensions of 8 x 16" ASTM C 90
  - 2. Compressive Strength: Provide units with minimum average net-area compressive strength of 2800 minimum psi
  - 3. Density Classification:
    - a. Lightweight units less than 105 lbs/cubic foot. Acceptable for all walls not directly exposed to exterior.
    - b. Normal weight units greater than 125 lbs/cubic foot. Acceptable for all walls exposed to exterior or for use below grade.
  - 4. Color: Standard gray
  - 5. All block used for exterior and wash bay applications shall contain water repellant admix to improve unit/wall performance.
  - 6. Water Repellant Sealer: See specification 099123 Painting & Coating.
- C. (Removed)
- D. Approved Manufacturers
  - 1. Acme Brick Company
  - 2. Building Products
  - 3. LeMay Block
  - 4. Midwest Products Group
  - 5. Joplin Building Material Company

**2.3 MASONRY LINTELS**

- A. Masonry Lintels: Prefabricated or built-in-place masonry lintels made from bond beam CMUs with reinforcing bars placed as indicated and filled with coarse grout.

**2.4 MORTAR AND GROUT MATERIALS**

- A. Portland Cement: ASTM C 150, Type I. Provide natural color or white cement as required to produce mortar color to match surrounding units.
- B. Hydrated Lime: ASTM C 207, Type S.

- C. Portland Cement-Lime Mix: Packaged blend of portland cement and hydrated lime containing no other ingredients.
- D. Masonry Cement: ASTM C 91.
  - 1. Products: Subject to compliance with requirements, available products that may be incorporated into the Work include, but are not limited to, the following:
    - a. Capital Materials Corporation; Flamingo Color Masonry Cement.
    - b. Cemex S.A.B. de C.V.; Brikset Type N, Citadel Type S, Dixie Type S, Kosmortar Type N.
    - c. Holcim (US) Inc.; Mortamix Masonry Cement, Rainbow Mortamix Custom Buff Masonry Cement, White Mortamix Masonry Cement.
    - d. Lafarge North America Inc.; Magnolia Masonry Cement, Lafarge Masonry Cement, Trinity White Masonry Cement.
    - e. Lehigh Cement Company; Lehigh Masonry Cement, Lehigh White Masonry Cement.
    - f. National Cement Company, Inc.; Coosa Masonry Cement.
- E. Mortar Cement: ASTM C 1329.
  - 1. Products: Subject to compliance with requirements, available products that may be incorporated into the Work include, but are not limited to, the following:
    - a. Lafarge North America Inc.; Lafarge Mortar Cement or Magnolia Superbond Mortar Cement.
      - 1) Lehigh Cement Company; Lehigh Custom Color Portland/Lime Cement.
      - 2) Color to be standard gray mortar.
- F. Aggregate for Mortar: ASTM C 144.
  - 1. For joints less than 1/4 inch thick, use aggregate graded with 100 percent passing the No. 16 sieve.
  - 2. White-Mortar Aggregates: Natural white sand or crushed white stone.
- G. Aggregate for Grout: ASTM C 404.
- H. Cold-Weather Admixture: Nonchloride, noncorrosive, accelerating admixture complying with ASTM C 494/C 494M, Type C, and recommended by manufacturer for use in masonry mortar of composition indicated.
  - 1. Products: Subject to compliance with requirements, available products that may be incorporated into the Work include, but are not limited to, the following:
    - a. Euclid Chemical Company (The); Accelguard 80.
    - b. Grace Construction Products, W. R. Grace & Co. - Conn.; Morset.
    - c. Sonneborn Products, BASF Aktiengesellschaft; Trimix-NCA.
- I. Water-Repellent Admixture (exterior and wash bay walls only): Liquid water-repellent mortar admixture intended for use with concrete masonry units, containing integral water repellent. See specification 099123 Painting & Coating for water repellent coating requirements.

## 2.5 REINFORCEMENT

- A. Uncoated Steel Reinforcing Bars: ASTM A 615/A 615M or ASTM A 996/A 996M, Grade 420 (Grade 60).
- B. Masonry Joint Reinforcement, General: ASTM A 951/A 951M.
  - 1. Interior Walls: Hot-dip galvanized, carbon steel.
  - 2. Exterior Walls: Hot-dip galvanized, carbon steel.

**City of Wentzville MO Public Works Facility**

**Wentzville, Missouri**

PROJECT NO.: 19-040

3. Wire Size for Side Rods: 0.148-inch diameter.
4. Wire Size for Cross Rods: 0.148-inch diameter.
5. Wire Size for Veneer Ties: 0.148-inch.
6. Spacing of Cross Rods, Tabs, and Cross Ties: Not more than 16 inches o.c.
7. Provide in lengths of not less than 10 feet, with prefabricated corner and tee units.

- C. Masonry Joint Reinforcement for Single-Wythe Masonry: Either ladder or truss type with single pair of side rods.

**2.6 TIES AND ANCHORS**

- A. Materials: Provide ties and anchors specified in this article that are made from materials that comply with the following unless otherwise indicated.

1. Hot-Dip Galvanized, Carbon-Steel Wire: ASTM A 82/A 82M; with ASTM A 153/A 153M, Class B-2 coating.
2. Steel Sheet, Galvanized after Fabrication: ASTM A 1008/A 1008M, Commercial Steel, with ASTM A 153/A 153M, Class B coating.
3. Steel Plates, Shapes, and Bars: ASTM A 36/A 36M.

- B. Adjustable Anchors for Connecting to Structural Steel Framing: Provide anchors that allow vertical or horizontal adjustment but resist tension and compression forces perpendicular to plane of wall.

1. Anchor Section for Welding to Steel Frame: Crimped 1/4-inch- (6.35-mm-) diameter, hot-dip galvanized steel wire.
2. Tie Section: Triangular-shaped wire tie, sized to extend within 1 inch (25 mm) of masonry face, made from 0.187-inch- (4.76-mm-) diameter, hot-dip galvanized steel wire.

- C. Adjustable Anchors for Connecting to Concrete: Provide anchors that allow vertical or horizontal adjustment but resist tension and compression forces perpendicular to plane of wall.

1. Connector Section: Dovetail tabs for inserting into dovetail slots in concrete and attached to tie section; formed from 0.060-inch- (1.52-mm-) thick, steel sheet, galvanized after fabrication.
2. Tie Section: Triangular-shaped wire tie, sized to extend within 1 inch (25 mm) of masonry face, made from 0.187-inch- (4.76-mm-) diameter, hot-dip galvanized steel wire.
3. Corrugated Metal Ties: Metal strips not less than 7/8 inch (22 mm) wide with corrugations having a wavelength of 0.3 to 0.5 inch (7.6 to 12.7 mm) and an amplitude of 0.06 to 0.10 inch (1.5 to 2.5 mm) made from 0.060-inch- (1.52-mm-) thick, steel sheet, galvanized after fabrication with dovetail tabs for inserting into dovetail slots in concrete and sized to extend to within 1 inch (25 mm) of masonry face.

- D. Partition Top anchors: 0.105-inch- (2.66-mm-) thick metal plate with 3/8-inch- (9.5-mm-) diameter metal rod 6 inches (152 mm) long welded to plate and with closed-end plastic tube fitted over rod that allows rod to move in and out of tube. Fabricate from steel, hot-dip galvanized after fabrication.

- E. Rigid Anchors: Fabricate from steel bars 1-1/2 inches (38 mm) wide by 1/4 inch (6.35 mm) thick by 24 inches (610 mm) long, with ends turned up 2 inches (51 mm) or with cross pins unless otherwise indicated.

1. Corrosion Protection: Hot-dip galvanized to comply with ASTM A 153/A 153M.

- F. Anchor Bolts: Headed or L-shaped steel bolts complying with ASTM A 307, Grade A (ASTM F 568M, Property Class 4.6); with ASTM A 563 (ASTM A 563M) hex nuts and, where indicated, flat washers; hot-dip galvanized to comply with ASTM A 153/A 153M, Class C; of dimensions indicated.



2.7 (Removed)

A. (Removed)

B. (Removed)

2.8 MISCELLANEOUS MASONRY ACCESSORIES

- A. Compressible Filler: Premolded filler strips complying with ASTM D 1056, Grade 2A1; compressible up to 35 percent; of width and thickness indicated; formulated from neoprene, urethane or PVC.
- B. Preformed Control-Joint Gaskets: Made from styrene-butadiene-rubber compound, complying with ASTM D 2000, Designation M2AA-805 or PVC, complying with ASTM D 2287, Type PVC-65406 and designed to fit standard sash block and to maintain lateral stability in masonry wall; size and configuration as indicated.
- C. Bond-Breaker Strips: Asphalt-saturated, organic roofing felt complying with ASTM D 226, Type I (No. 15 asphalt felt).
- D. Reinforcing Bar Positioners: Wire units designed to fit into mortar bed joints spanning masonry unit cells and hold reinforcing bars in center of cells. Units are formed from 0.148-inch steel wire, hot-dip galvanized after fabrication. Provide units designed for number of bars indicated.
  - 1. Products: Subject to compliance with requirements, available products that may be incorporated into the Work include, but are not limited to, the following:
    - a. Dayton Superior Corporation, Dur-O-Wal Division; D/A 810, D/A 812 or D/A 817.
    - b. Heckmann Building Products Inc.; No. 376 Rebar Positioner.
    - c. Hohmann & Barnard, Inc.; #RB or #RB-Twin Rebar Positioner.
    - d. Wire-Bond; O-Ring or Double O-Ring Rebar Positioner.

2.9 MORTAR AND GROUT MIXES

- A. General: Do not use admixtures, including pigments, accelerators, retarders, water-repellent agents or other admixtures unless otherwise indicated.
  - 1. Do not use calcium chloride in mortar or grout.
  - 2. Use portland cement-lime, masonry cement, or mortar cement mortar unless otherwise indicated.
  - 3. Add cold-weather admixture (if used) at same rate for all mortar that will be exposed to view, regardless of weather conditions, to ensure that mortar color is consistent.
- B. Preblended, Dry Mortar Mix: Furnish dry mortar ingredients in form of a preblended mix. Measure quantities by strength to ensure accurate properties, and thoroughly blend ingredients before delivering to Project site.
- C. Mortar for Unit Masonry: Comply with ASTM C 270, Property Specification. Provide the following types of mortar for applications stated unless another type is indicated.
  - 1. For masonry below grade or in contact with earth, use Type M or Type S. Minimum Mortar strength: Type M 2500 psi, Type S 1800 psi.
  - 2. For mortar parge coats, use Type M or Type S.
  - 3. For exterior, above-grade, load-bearing walls and parapet walls, use Type S.
  - 4. For interior non-load-bearing partitions and exterior 4" veneers, use Type N.
- D. Grout for Unit Masonry: Comply with ASTM C 476.

**City of Wentzville MO Public Works Facility**

**Wentzville, Missouri**

PROJECT NO.: 19-040

1. Use grout of type indicated or, if not otherwise indicated, of type (fine or coarse) that will comply with Table 1.15.1 in ACI 530.1/ASCE 6/TMS 602 for dimensions of grout spaces and pour height.
2. Proportion grout in accordance with ASTM C 476, paragraph 4.2.2 for specified 28-day compressive strength indicated, but not less than 3000 psi (20.6 MPa)].
3. Provide grout with a slump of 8 to 11 inches as measured according to ASTM C 143/C 143M.

**PART 3 - EXECUTION**

**3.1 TOLERANCES**

**A. Dimensions and Locations of Elements:**

1. For dimensions in cross section or elevation do not vary by more than plus 1/2 inch or minus 1/4 inch .
2. For location of elements in plan do not vary from that indicated by more than plus or minus 1/2 inch .
3. For location of elements in elevation do not vary from that indicated by more than plus or minus 1/4 inch in a story height or 1/2 inch total.

**B. Lines and Levels:**

1. For bed joints and top surfaces of bearing walls do not vary from level by more than 1/4 inch in 10 feet , or 1/2 inch maximum.
2. For conspicuous horizontal lines, such as lintels, sills, parapets, and reveals, do not vary from level by more than 1/8 inch in 10 feet , 1/4 inch in 20 feet , or 1/2 inch maximum.
3. For vertical lines and surfaces do not vary from plumb by more than 1/4 inch in 10 feet , 3/8 inch in 20 feet , or 1/2 inch maximum.
4. For conspicuous vertical lines, such as external corners, door jambs, reveals, and expansion and control joints, do not vary from plumb by more than 1/8 inch in 10 feet , 1/4 inch in 20 feet , or 1/2 inch maximum.
5. For lines and surfaces do not vary from straight by more than 1/4 inch in 10 feet, 3/8 inch in 20 feet, or 1/2 inch maximum.

**C. Joints:**

1. For bed joints, do not vary from thickness indicated by more than plus or minus 1/8 inch , with a maximum thickness limited to 1/2 inch.
2. For head and collar joints, do not vary from thickness indicated by more than plus 3/8 inch or minus 1/4 inch.
3. For exposed head joints, do not vary from thickness indicated by more than plus or minus 1/8 inch.

**3.2 LAYING MASONRY WALLS**

- A. Lay out walls in advance for accurate spacing of surface bond patterns with uniform joint thicknesses and for accurate location of openings, movement-type joints, returns, and offsets. Avoid using less-than-half-size units, particularly at corners, jambs, and, where possible, at other locations.
- B. Use full-size units without cutting if possible. If cutting is required to provide a continuous pattern or to fit adjoining construction, cut units with motor-driven saws; provide clean, sharp, unchipped edges. Allow units to dry before laying unless wetting of units is specified. Install cut units with cut surfaces and, where possible, cut edges concealed.

- C. Bond Pattern for Exposed Masonry: Unless otherwise indicated, lay exposed masonry in stack bond; do not use units with less than nominal 4-inch horizontal face dimensions at corners or jambs.
- D. Built-in Work: As construction progresses, build in items specified in this and other Sections. Fill in solidly with masonry around built-in items.
- E. Fill space between steel frames and masonry solidly with mortar unless otherwise indicated.
- F. Where built-in items are to be embedded in cores of hollow masonry units, place a layer of metal lath, wire mesh, or plastic mesh in the joint below and rod mortar or grout into core.
- G. Fill cores in hollow CMUs with grout 24 inches under bearing plates, beams, lintels, posts, and similar items unless otherwise indicated.

### 3.3 MORTAR BEDDING AND JOINTING

- A. Lay hollow CMUs as follows:
  - 1. With face shells fully bedded in mortar and with head joints of depth equal to bed joints.
  - 2. With webs fully bedded in mortar in all courses of piers, columns, and pilasters.
  - 3. With webs fully bedded in mortar in grouted masonry, including starting course on footings.
  - 4. With entire units, including areas under cells, fully bedded in mortar at starting course on footings where cells are not grouted.
- B. Lay solid masonry units with completely filled bed and head joints; butter ends with sufficient mortar to fill head joints and shove into place. Do not deeply furrow bed joints or slush head joints.
- C. Tool exposed joints slightly concave when thumbprint hard, using a jointer larger than joint thickness unless otherwise indicated.
- D. Cut joints flush for masonry walls to receive plaster or other direct-applied finishes (other than paint) unless otherwise indicated.

### 3.4 MASONRY JOINT REINFORCEMENT

- A. General: Install entire length of longitudinal side rods in mortar with a minimum cover of 5/8 inch on exterior side of walls, 1/2 inch elsewhere. Lap reinforcement a minimum of 6 inches (150 mm).
  - 1. Space reinforcement not more than 16 inches o.c.
  - 2. Space reinforcement not more than 8 inches o.c. in foundation walls and parapet walls.
  - 3. Provide reinforcement not more than 8 inches above and below wall openings and extending 12 inches beyond openings in addition to continuous reinforcement.
- B. Interrupt joint reinforcement at control and expansion joints unless otherwise indicated.
- C. Provide continuity at wall intersections by using prefabricated T-shaped units.
- D. Provide continuity at corners by using prefabricated L-shaped units.

**City of Wentzville MO Public Works Facility**

**Wentzville, Missouri**

PROJECT NO.: 19-040

**3.5 ANCHORING MASONRY TO STRUCTURAL STEEL AND CONCRETE**

- A. Anchor masonry to structural steel and concrete where masonry abuts or faces structural steel or concrete to comply with the following:
  - 1. Provide an open space not less than 1/2 inch wide between masonry and structural steel or concrete unless otherwise indicated. Keep open space free of mortar and other rigid materials.

**3.6 REINFORCED UNIT MASONRY INSTALLATION**

- A. Temporary Formwork and Shores: Construct formwork and shores as needed to support reinforced masonry elements during construction.
  - 1. Construct formwork to provide shape, line, and dimensions of completed masonry as indicated. Make forms sufficiently tight to prevent leakage of mortar and grout. Brace, tie, and support forms to maintain position and shape during construction and curing of reinforced masonry.
  - 2. Do not remove forms and shores until reinforced masonry members have hardened sufficiently to carry their own weight and other loads that may be placed on them during construction.
- B. Placing Reinforcement: Comply with requirements in ACI 530.1/ASCE 6/TMS 602.
- C. Grouting: Do not place grout until entire height of masonry to be grouted has attained enough strength to resist grout pressure.
  - 1. Comply with requirements in ACI 530.1/ASCE 6/TMS 602 for cleanouts and for grout placement, including minimum grout space and maximum pour height.
  - 2. Limit height of vertical grout pours to not more than 4 feet for un-inspected walls. Grout pours over 4 feet must be inspected and comply with requirements of ACI 530.1/ASCE 6 TMS 602.

**3.7 FIELD QUALITY CONTROL**

- A. Testing and Inspecting: Owner will engage special inspectors to perform tests and inspections and prepare reports. Allow inspectors access to scaffolding and work areas, as needed to perform tests and inspections. Retesting of materials that fail to meet specified requirements shall be done at Contractor's expense. Provide written report to Architect and Engineer.
- B. Inspections: Provide Level 1 special inspections according to the International Building Code and Level B Quality Assurance per TMS 402-11/ACI 530-11/ASCE 5-11.
  - 1. Begin masonry construction only after inspectors have verified proportions of site-prepared mortar.
  - 2. Place grout only after inspectors have verified compliance of grout spaces and of grades, sizes, and locations of reinforcement.
  - 3. Place grout only after inspectors have verified proportions of site-prepared grout.
- C. Testing Prior to Construction: One set of tests.
- D. Testing Frequency: One set of tests for each 2,000 sq. ft. of wall area or portion thereof.
- E. Concrete Masonry Unit Test: For each type of unit provided, according to ASTM C 140 for compressive strength.
- F. Mortar Test (Property Specification): For each mix provided, according to ASTM C 780. Test mortar for mortar air content and compressive strength.

- G. Grout Test (Compressive Strength): For each mix provided, according to ASTM C 1019.

### 3.8 PARGING

- A. Parge exterior faces of below-grade masonry walls, where indicated, in 2 uniform coats to a total thickness of 3/4 inch .
- B. Use a steel-trowel finish to produce a smooth, flat, dense surface. Form a wash at top of parging and a cove at bottom.
- C. Damp-cure parging for at least 24 hours and protect parging until cured.

### 3.9 REPAIRING, POINTING, AND CLEANING

- A. In-Progress Cleaning: Clean unit masonry as work progresses by dry brushing to remove mortar fins and smears before tooling joints.
- B. Final Cleaning: After mortar is thoroughly set and cured, clean exposed masonry as follows.
  - 1. Clean concrete masonry by cleaning method indicated in NCMA TEK 8-2A applicable to type of stain on exposed surfaces.
    - a. Acceptable product:
      - 1) Eaco Chem: NMD 80
      - 2) Prosoco: Safety Clean
    - b. Muratic acid may not be used to clean masonry.
  - 2. Seal architectural masonry per painting specifications. Architect must approved final cleaning of architectural block prior to sealing.

### 3.10 REPAIRING, POINTING, AND CLEANING

- A. Remove and replace masonry units that are loose, chipped, broken, stained, or otherwise damaged or that do not match adjoining units. Install new units to match adjoining units; install in fresh mortar, pointed to eliminate evidence of replacement
- B. Pointing: During the tooling of joints, enlarge voids and holes, except weep holes, and completely fill with mortar. Point up joints, including corners, openings, and adjacent construction, to provide a neat, uniform appearance. Prepare joints for sealant application, where indicated.
- C. In-Progress Cleaning: Clean unit masonry as work progresses by dry brushing to remove mortar fins and smears before tooling joints.
- D. Final Cleaning: After mortar is thoroughly set and cured, clean exposed masonry as follows:
  - 1. Remove large mortar particles by hand with wooden paddles and nonmetallic scrape hoes or chisels.
  - 2. Test cleaning methods on sample wall panel; leave one-half of panel uncleaned for comparison purposes. Obtain Architect's approval of sample cleaning before proceeding with cleaning of masonry.
  - 3. Protect adjacent stone and nonmasonry surfaces from contact with cleaner by covering them with liquid strippable masking agent or polyethylene film and waterproof masking tape.
  - 4. Wet wall surfaces with water before applying cleaners; remove cleaners promptly by rinsing surfaces thoroughly with clear water.

**City of Wentzville MO Public Works Facility**

**Wentzville, Missouri**

PROJECT NO.: 19-040

3.11 MASONRY WASTE DISPOSAL

- A. All masonry waste shall be removed from site.

END OF SECTION 042200

SECTION 064116 - PLASTIC-LAMINATE-CLAD ARCHITECTURAL CABINETS

PART 1 - GENERAL

1.1 SUMMARY

A. Section Includes:

1. Plastic-laminate-clad architectural cabinets.
2. Cabinet hardware and accessories.
3. Wood furring, blocking, shims, and hanging strips for installing plastic-laminate-clad architectural cabinets that are not concealed within other construction.

1.2 PREINSTALLATION MEETINGS

- A. Preinstallation Conference: Conduct conference at Project site.

1.3 ACTION SUBMITTALS

A. Product Data: For each type of product.

1. Include data for fire-retardant treatment from chemical-treatment manufacturer and certification by treating plant that treated materials comply with requirements.

B. Shop Drawings:

1. Include plans, elevations, sections, and attachment details.
2. Apply AWI Quality Certification Program label to Shop Drawings.

- C. Samples: For each exposed product and for each color and texture specified.

1.4 INFORMATIONAL SUBMITTALS

- A. Qualification Data: For manufacturer and Installer.

- B. Research reports.

- C. Field quality control reports.

1.5 CLOSEOUT SUBMITTALS

- A. Quality Standard Compliance Certificates: AWI Quality Certification Program certificates.

**City of Wentzville MO Public Works Facility**

**Wentzville, Missouri**

PROJECT NO.: 19-040

1.6 QUALITY ASSURANCE

- A. Manufacturer's Qualifications: Employs skilled workers who custom fabricate products similar to those required for this Project and whose products have a record of successful in-service performance.
  - 1. Manufacturer's Certification: Manufacturer shall meet and fabricate to AWI Quality Standards without having to provide labels or certificates.
- B. Installer Qualifications: Installer shall meet and install to AWI Quality Standards without having to provide labels or certificates.

1.7 FIELD CONDITIONS

- A. Environmental Limitations without Humidity Control: Do not deliver or install cabinets until building is enclosed, wet-work is complete, and HVAC system is operating and maintaining temperature and relative humidity at levels planned for building occupants during the remainder of the construction period.

PART 2 - PRODUCTS

2.1 PLASTIC-LAMINATE-CLAD ARCHITECTURAL CABINETS

- A. Quality Standard: Unless otherwise indicated, comply with the Architectural Woodwork Standards for grades of cabinets indicated for construction, finishes, installation, and other requirements.
- B. Architectural Woodwork Standards Grade: Premium.
- C. Type of Construction: Frameless.
- D. Door and Drawer-Front Style: Flush overlay.
- E. High-Pressure Decorative Laminate: NEMA LD 3, grades as indicated or if not indicated, as required by quality standard.
  - 1. Basis-of-Design Product: Subject to compliance with requirements, provide specified Wilsonart LLC laminate; or comparable product by one of the following:
    - a. Formica Corporation.
    - b. Nevamar/Panolam Surface Systems.
- F. Laminate Cladding for Exposed Surfaces:
  - 1. Horizontal Surfaces: Grade HGS.
  - 2. Postformed Surfaces: Grade HGP.
  - 3. Vertical Surfaces: Grade VGS.



4. Edges: Grade VGS.
  5. Pattern Direction: As indicated.
- G. Concealed Backs of Panels with Exposed Plastic-Laminate Surfaces: High-pressure decorative laminate, NEMA LD 3, Grade BKL.
- H. Drawer Construction: Fabricate with exposed fronts fastened to subfront with mounting screws from interior of body.
- I. Colors, Patterns, and Finishes: Provide materials and products that result in colors and textures of exposed laminate surfaces complying with the following requirements:
1. As selected by Architect from laminate manufacturer's full range in the following categories:
    - a. Solid colors, matte finish.
    - b. Solid colors with core same color as surface, matte finish.
    - c. Wood grains, matte finish.
    - d. Patterns, matte finish.

## 2.2 WOOD MATERIALS

- A. Wood Products: Provide materials that comply with requirements of referenced quality standard for each type of architectural cabinet and quality grade specified unless otherwise indicated.
1. Wood Moisture Content: 4 to 9 percent.
- B. Composite Wood Products: Provide materials that comply with requirements of referenced quality standard for each type of architectural cabinet and quality grade specified unless otherwise indicated.
1. Medium-Density Fiberboard (MDF): ANSI A208.2, Grade M-2 Exterior Glue.

## 2.3 CABINET HARDWARE AND ACCESSORIES

- A. General: Provide cabinet hardware and accessory materials associated with architectural cabinets.
- B. Butt Hinges: 2-3/4-inch, five-knuckle steel hinges made from 0.095-inch- thick metal, and as follows:
1. Semiconcealed Hinges for Flush Doors: ANSI/BHMA A156.9, B01361.
  2. Semiconcealed Hinges for Overlay Doors: ANSI/BHMA A156.9, B01521.
- C. Frameless Concealed Hinges (European Type): ANSI/BHMA A156.9, B01602, 170 degrees of opening, self-closing.

**City of Wentzville MO Public Works Facility**

**Wentzville, Missouri**

PROJECT NO.: 19-040

- D. Back-Mounted Pulls: ANSI/BHMA A156.9, B02011.
- E. Wire Pulls: Back mounted, solid metal, 4 inches long, 5/16 inch in diameter.
- F. Catches: Push-in magnetic catches, ANSI/BHMA A156.9, B03131 Ball friction catches, ANSI/BHMA A156.9, B03013.
- G. Adjustable Shelf Standards and Supports: ANSI/BHMA A156.9, B04071; with shelf rests, B04081.
- H. Shelf Rests: ANSI/BHMA A156.9, B04013; plastic.
- I. Drawer Slides: ANSI/BHMA A156.9.
  - 1. Heavy-Duty (Grade 1HD-100 and Grade 1HD-200): Side mount.
    - a. Type: Full extension.
    - b. Material: Zinc-plated ball bearing slides.
- J. Slides for Sliding Glass Doors: ANSI/BHMA A156.9, B07063; aluminum.
- K. Door Locks: ANSI/BHMA A156.11, E07121.
- L. Drawer Locks: ANSI/BHMA A156.11, E07041.
- M. Door and Drawer Silencers: ANSI/BHMA A156.16, L03011.
- N. Float Glass for Cabinet Doors: ASTM C1036, Type I, Class 1 (clear), Quality-Q3.
  - 1. Thickness: 6.0 mm.
- O. Grommets for Cable Passage: 2-inch OD, molded-plastic grommets and matching plastic caps with slot for wire passage.
  - 1. Color: To be selected by architect.
- P. Exposed Hardware Finishes: For exposed hardware, provide finish that complies with ANSI/BHMA A156.18 for ANSI/BHMA finish number indicated.
  - 1. Dark, Oxidized, Satin Bronze, Oil Rubbed: ANSI/BHMA 613 for bronze base; ANSI/BHMA 640 for steel base; match Architect's sample.
  - 2. Bright Brass, Clear Coated: ANSI/BHMA 605 for brass base; ANSI/BHMA 632 for steel base.
  - 3. Bright Brass, Vacuum Coated: ANSI/BHMA 723 for brass base; ANSI/BHMA 729 for zinc-coated-steel base.
  - 4. Satin Brass, Blackened, Bright Relieved, Clear Coated: ANSI/BHMA 610 for brass base; ANSI/BHMA 636 for steel base.

5. Satin Chromium Plated: ANSI/BHMA 626 for brass or bronze base; ANSI/BHMA 652 for steel base.
6. Bright Chromium Plated: ANSI/BHMA 625 for brass or bronze base; ANSI/BHMA 651 for steel base.
7. Satin Stainless Steel: ANSI/BHMA 630.

- Q. For concealed hardware, provide manufacturer's standard finish that complies with product class requirements in ANSI/BHMA A156.9.

## 2.4 MISCELLANEOUS MATERIALS

- A. Furring, Blocking, Shims, and Hanging Strips: Fire-retardant-treated softwood lumber, kiln-dried to less than 15 percent moisture content.
- B. Anchors: Select material, type, size, and finish required for each substrate for secure anchorage. Provide metal expansion sleeves or expansion bolts for post-installed anchors. Use nonferrous-metal or hot-dip galvanized anchors and inserts at inside face of exterior walls and at floors.
- C. Adhesive for Bonding Plastic Laminate: Unpigmented contact cement Resorcinol.
  1. Adhesive for Bonding Edges: Hot-melt adhesive or adhesive specified above for faces.

## 2.5 FABRICATION

- A. Complete fabrication, including assembly and hardware application, to maximum extent possible before shipment to Project site. Disassemble components only as necessary for shipment and installation. Where necessary for fitting at site, provide ample allowance for scribing, trimming, and fitting.
- B. Shop-cut openings to maximum extent possible to receive hardware, appliances, electrical work, and similar items. Locate openings accurately and use templates or roughing-in diagrams to produce accurately sized and shaped openings. Sand edges of cutouts to remove splinters and burrs.
- C. Install glass to comply with applicable requirements in Section 088000 "Glazing" and in GANA's "Glazing Manual."
  1. For glass in frames, secure glass with removable stops.
  2. For exposed glass edges, polish and grind smooth.

## PART 3 - EXECUTION

### 3.1 INSTALLATION

- A. Before installation, condition cabinets to humidity conditions in installation areas for not less than 72 hours.

**City of Wentzville MO Public Works Facility**

**Wentzville, Missouri**

PROJECT NO.: 19-040

- B. Architectural Woodwork Standards Grade: Install cabinets to comply with quality standard grade of item to be installed.
- C. Anchor cabinets to anchors or blocking built in or directly attached to substrates. Secure with wafer-head cabinet installation screws.
- D. Install cabinets level, plumb, and true in line to a tolerance of 1/8 inch in 96 inches using concealed shims.
  - 1. Scribe and cut cabinets to fit adjoining work, refinish cut surfaces, and repair damaged finish at cuts.
  - 2. Install cabinets without distortion so doors and drawers fit openings and are accurately aligned. Adjust hardware to center doors and drawers in openings and to provide unencumbered operation. Complete installation of hardware and accessory items as indicated.
  - 3. Fasten wall cabinets through back, near top and bottom, and at ends not more than 16 inches o.c. with No. 10 wafer-head screws sized for not less than 1-1/2-inch penetration into wood framing, blocking, or hanging strips.

**3.2 FIELD QUALITY CONTROL**

- A. Inspections: Provide inspection of installed Work through AWI's Quality Certification Program certifying that woodwork, including installation, complies with requirements of the Architectural Woodwork Standards for the specified grade.
  - 1. Inspection entity shall prepare and submit report of inspection.

END OF SECTION 064116

## SECTION 072100 - THERMAL INSULATION

### PART 1 - GENERAL

#### 1.1 SUMMARY

- A. Section Includes:
  - 1. Glass-fiber blanket exterior wall insulation
  - 2. Glass-fiber blanket interior wall sound batt insulation.
  - 3. Metal building wall & roof insulation

#### 1.2 SUBMITTALS

- A. Product Data: For each type of product indicated.
- B. Product test/evaluation reports.

### PART 2 - PRODUCTS

#### 2.1 GLASS-FIBER BLANKET INSULATION-exterior wall cavities

- A. Manufacturers: Subject to compliance with requirements, provide products by one of the following:
  - 1. CertainTeed Corporation.
  - 2. Guardian Building Products, Inc.
  - 3. Johns Manville.
  - 4. Knauf Insulation.
  - 5. Owens Corning.
- B. Unfaced, Glass-Fiber Blanket Insulation: ASTM C 665, Type I; with maximum flame-spread and smoke-developed indexes of 25 and 50, respectively, per ASTM E 84; passing ASTM E 136 for combustion characteristics.
  - 1. Provide R-19 unfaced insulation in all exterior framed wall cavities.
  - 2. Thickness: 6" for 6" metal studs as noted on plans.

#### 2.2 GLASS-FIBER BLANKET INSULATION-interior wall cavities (sound batt)

- A. Manufacturers: Subject to compliance with requirements, provide products by one of the following:
  - 1. CertainTeed Corporation.
  - 2. Guardian Building Products, Inc.
  - 3. Johns Manville.
  - 4. Knauf Insulation.
  - 5. Owens Corning.
- B. Unfaced, Glass-Fiber Blanket Insulation: ASTM C 665, Type I; with maximum flame-spread and smoke-developed indexes of 25 and 50, respectively, per ASTM E 84; passing ASTM E 136 for combustion characteristics.
  - 1. Provide sound batt insulation equal to QuietAone Owens Corning in all interior wall locations.

## City of Wentzville MO Public Works Facility

### Wentzville, Missouri

PROJECT NO.: 19-040

2. Thickness: 3.5" for 3-5/8" metal stud walls note on plans and 6" for 6" metal studs as noted on plans.
3. Thickness for above acoustical ceiling tile: 6"

#### 2.3 RIGID INSULATION

- A. Extruded-Polystyrene Board Insulation: ASTM C 578, with maximum flame-spread and smoke-developed indexes of 75 and 450, respectively, per ASTM E 84.
  1. Provide Extruded-Polystyrene board equal to STYROFOAM CAVITYMATE as manufactured by DOW Chemical Company.
  2. Thickness: 2"
  3. Fasteners: Per manufacturers requirements
  4. Installation: Provide insulation at locations below vehicle lift in Fleet Service building per lift manufacturers guidelines. Install per manufacturers written installation instructions.

#### 2.4 VINYL FACED METAL BUILDING INSULATION- Fleet Service Building

- A. Vinyl Faced Insulation: Insulation shall be equal to Owens-Corning Certified R Metal Building Insulation as manufactured by Owens-Corning, One Owens Corning Parkway, Toledo, OH 43659. Insulation at metal roof and wall panels shall be laminated with a vapor retarder listed below. Insulation shall be installed in strict accordance with manufacturer's recommendations.
- B. Roof Insulation: Beneath standing seam metal roof of Fleet Service Building, install 8" R-25 vinyl faced insulation, draping over the top of the z-purlins at each z-purlin location, with thermal blocks over each purlin. Insulation shall be draped sufficiently to allow 6" of insulation to be snugly placed between the purlins and the metal roof panel. (Do not leave airspace). WMP-10 .0015" white metalized polypropylene film, tri directional scrim reinforcing, and 14# Kraft white paper backing.
- C. Wall Insulation: At exterior walls of Fleet Service Building, install 8" R-25 vinyl faced insulation. WMP-10 .0015" white metalized polypropylene film, tri directional scrim reinforcing, and 14# Kraft white paper backing.

### PART 3 - EXECUTION

#### 3.1 INSTALLATION, GENERAL

- A. Comply with insulation manufacturer's written instructions applicable to products and applications indicated.
- B. Install insulation that is undamaged, dry, and unsoiled and that has not been left exposed to ice, rain, or snow at any time.
- C. Extend insulation to envelop entire area to be insulated. Cut and fit tightly around obstructions and fill voids with insulation. Remove projections that interfere with placement.
- D. Provide sizes to fit applications indicated and selected from manufacturer's standard thickness, widths, and lengths. Apply single layer of insulation units to produce thickness indicated unless multiple layers are otherwise shown or required to make up total thickness.

### 3.2 INSTALLATION OF RIGID INSULATION

- A. Mechanically fasten board to masonry wall with purposed-made plastic friction fit fasteners or use adhesive equal to CGSB 71-BP-24M, Type 1.
- B. Install insulation boards over air/vapor barrier membrane starting at the top of footing and extending vertically to top of wall per section details.
- C. Place boards in a method to maximize contact with bedding, staggering end joints. Butt edges and ends tight to adjacent bards and to protrusions. Fit insulation board tight around masonry brick ties.
- D. If adhesive is used for attachment provide a 6 mm bead of adhesive in a grid pattern to prevent potential air movement behind board. Apply adhesive fully around protrusions.
- E. If plastic friction fit fasteners are used place fasteners securely against board to hold boards firmly in place.
- F. Install insulation that is undamaged, dry, and unsoiled and that has not been left exposed to ice, rain, or snow at any time.
- G. Extend insulation to envelop entire area to be insulated. Cut and fit tightly around obstructions and fill voids with insulation. Remove projections that interfere with placement.

### 3.3 INSTALLATION OF INSULATION FOR FRAMED CONSTRUCTION

- A. Apply insulation units to substrates by method indicated, complying with manufacturer's written instructions. If no specific method is indicated, bond units to substrate with adhesive or use mechanical anchorage to provide permanent placement and support of units.
- B. Glass-Fiber Insulation: Install in cavities formed by framing members according to the following requirements:
  - 1. Use insulation widths and lengths that fill the cavities formed by framing members. If more than one length is required to fill the cavities, provide lengths that will produce a snug fit between ends.
  - 2. Place insulation in cavities formed by framing members to produce a friction fit between edges of insulation and adjoining framing members.
  - 3. Maintain 3-inch clearance of insulation around recessed lighting fixtures not rated for or protected from contact with insulation.
  - 4. Install eave ventilation troughs between roof framing members in insulated attic spaces at vented eaves.
  - 5. For metal-framed wall cavities where cavity heights exceed 96 inches, support unfaced blankets mechanically and support faced blankets by taping flanges of insulation to flanges of metal studs.
- C. Miscellaneous Voids: Install insulation in miscellaneous voids and cavity spaces where required to prevent gaps in insulation using the following materials:

END OF SECTION 072100

## SECTION 074113 - METAL ROOF PANELS

### PART 1 - GENERAL

#### 1.1 SUMMARY

- A. Section Includes:
  - 1. Standing-seam metal roof panels.
  - 2. Snow/ice guard system.
- B. Related Sections:
  - 1. Division 07 Section "Sheet Metal Roofing" for custom-fabricated and on-site, roll-formed sheet metal roofing.

#### 1.2 PERFORMANCE REQUIREMENTS

- A. U.L. Class 90 Rating: The roof system shall carry a U.L. wind uplift classification Class 90 as determined according to UL 580 Tests for Uplift Resistance of Roof Assemblies to ensure structural integrity and possible reduction of insurance rates.
- B. FM Global (Factory Mutual): The roof system has been tested according to FMRC Standard 4471 and approved as a Class 1 Panel Roof. The building manufacture shall provide specific assemblies to meet the required Wind Rating per FM Global.
- C. ASTM E 1592: The roof system shall be tested according to ASTM E 1592 Standard Test Method for Structural Performance of Sheet Metal Roof and Siding Systems by Uniform Static Air pressure difference. See structural plans for wind, snow and deflection limits
- D. Air Infiltration per ASTM E1680
- E. Water Penetration per ASTM E1646
- F. Class A Fire Rating when tested in accordance with test procedure ASTM E108

#### 1.3 SUBMITTALS

- A. Product Data: For product indicated.
- B. Shop Drawings: Show fabrication and installation layouts of metal roof panels; details of edge conditions, side-seam and endlap joints, panel profiles, corners, anchorages, trim, flashings, closures, and accessories; and special details. Distinguish between factory- and field-assembled work.
- C. Coordination Drawings: Roof plans, drawn to scale, based on input from installers of the items involved.
- D. Warranties: Samples of special warranties.



**City of Wentzville MO Public Works Facility**

**Wentzville, Missouri**

PROJECT NO.: 19-040

1.4 QUALITY ASSURANCE

- A. Installer Qualifications: An employer of workers trained and approved by manufacturer.
- B. Fire-Resistance Ratings: Where indicated, provide metal roof panels identical to those of assemblies tested for fire resistance per ASTM E 119 by a qualified testing agency. Identify products with appropriate markings of applicable testing agency.
  - 1. Combustion Characteristics: ASTM E 136.
- C. Preinstallation Conference: Conduct conference at project site.

1.5 WARRANTY

- A. Weather Tightness Warranty: Provide a single source manufacturers 20 year warranty with, "no dollar limit". For a period of 20 years from the date of substantial completion certified by the architect, the roof panel manufacturer shall warrants the building owner that the roof panels, flashin, and relatd items tuse to fasten the roof panels and flashing (including roof jacks and curb attachments pre-approved, in writing by Manufacturer)to the roof structure will not allow the intrusion of water from the exterior of the Manufacturer Roof System into the building envelope, when exposed to ordinary weather conditions and ordinary wear and usage.
- B. Exterior Material and Finish Warranty: Provide manufacturers 20 year finish warranty.

1.6 PANEL MATERIALS

- A. Roof Panel
  - 1. Roof panel shall be equal to factory roll-formed MR-24 roof system panel as manufactured by Butler Manufacturing Company; 24" wide, with 2 major corrugations, 2" high (2-3/4" including seam), 24" on center. The flat of the panel shall contain cross flutes 6" on center perpendicular to the major corrugations the entire length of the panel to reduce wind noise and improve walkability.
  - 2. Panel material as specified shall be 24-gauge galvanized steel, G90 coating, ASTM A 653, G90. Paint with exterior colors of "Butler-Cote" finish system, full-strength, 70 percent "Kynar 500" or "Hylar 5000" fluoropolymer (PVDF) coating. PVDF Coating Warranty: Metal building system manufacturer shall warrant coating for 25 years.
  - 3. Panel of maximum possible length shall be used to minimize endlap; eave panel shall extend beyond the structural line of the sidewall
  - 4. Panel shall be factory prepunched at panel end to match prepunched holes in the eave structural member. Panel end splice shall be factory prepunched and prenotched. Panel end splice shall be floating and allow the roof panel to expand and contract with roof panel temperature change.
  - 5. Ridge assembly shall be designed to allow roof panels to move lengthwise with expansion/contraction as the roof panel temperature changes. Parts shall be factory prepunched for correct field assembly. Panel closure and interior reinforcing strap shall be installed to seal the panel end at the ridge. The attachment fasteners shall not be exposed on the weather side. A lockseam plug shall be used to seal the lockseam portion of the panel. A hi-tensile steel ridge cover shall span from panel closure to panel closure and flex as the roof system expands and contracts
- B. Approved Equals: Conforming to the requirements specified in this specifications section the following manufactures are approved.
  - 1. Berridge Metal Roofing
  - 2. DMI (Dimensional Metals, Inc)
  - 3. Englert, Inc.

4. PAC-CLAD Peterson Aluminum:
5. MBCI
6. Varco Pruden Building

C. Panel Sealants:

1. Sealant Tape: Pressure-sensitive, 100 percent solids, gray polyisobutylene compound sealant tape with release-paper backing; 1/2 inch wide and 1/8 inch thick.
2. Joint Sealant: ASTM C 920; as recommended in writing by metal roof panel manufacturer.
3. Butyl-Rubber-Based, Solvent-Release Sealant: ASTM C 1311.

D. Fasteners:

1. Connection of roof system panel-to-structural member, except at eave, shall be made with clips with movable stainless steel tabs that are seamed into the standing seam sidelap..
2. Panel clip shall be fastened to structural member with Scrubolt™ fastener as per manufacturer's erection drawings, using factory prepunched hole in structural member. Scrubolt fastener shall contain a metal backed rubber washer which serves as a torque indicator.
3. Roof system panel-to-panel connection shall be made with a positive, field-formed standing double-lock seam, formed by a special seaming machine. The machine field forms the final 180 degrees of a 360 degree Pittsburgh double-lock standing seam; all sidelap sealant shall be factory applied.

E. Accessories

1. Thermal blocks: Provide 25 psi ¾"x4" pre-engineered thermal blocks at top of roof purlins as manufactured by Chardan Specialities (419) 636-6900. Install thermal blocks continuous at top of purlins with adhesive as recommended by manufacturers.

1.7 FIELD-INSTALLED THERMAL INSULATION

- A. Refer to Division 07 Section "Thermal Insulation."

1.8 STANDING-SEAM METAL ROOF PANELS

- A. General: All components of the roof system paneling shall be designed in accordance with sound engineering methods and practices.
- B. Roof system paneling shall be designed in accordance with AISI "Specifications for the Design of Light-Gage, Cold-Formed Steel Structural Members" or CAN/CSAS136 "Cold-Formed Steel Structural Members" - latest edition.
- C. All endwall trim and roof transition flashing shall allow the roof panel to move relative to the wall panel and/or the parapet as the roof expands and contracts with temperature change.
- D. Provide factory-formed metal roof panels designed to be installed by lapping and interconnecting raised side edges of adjacent panels with joint type indicated and mechanically attaching panels to supports using concealed clips in side laps. Include clips, cleats, pressure plates, and accessories required for weathertight installation.
- E. The roof shall provide for thermal expansion/contraction without detrimental effect to the roof panel when there is a ±100°F. temperature difference between the inside structural framework of

**City of Wentzville MO Public Works Facility**

**Wentzville, Missouri**

PROJECT NO.: 19-040

the building and the temperature of the roof panels.

- F. Provision for thermal expansion movement of the MR-24 roof system panel shall be accomplished by the use of clips with a movable tab. The stainless steel tab shall be factory centered on the roof clip when installed to assure full movement in either direction. A force of no more than 8 pounds will be required to initiate tab movement. Each clip shall accommodate a minimum of 1.25" in either direction.

**1.9 FABRICATION**

- A. Fabricate and finish metal roof panels and accessories at the factory to greatest extent possible, by manufacturer's standard procedures and processes and as necessary to fulfill indicated performance requirements. Comply with indicated profiles and with dimensional and structural requirements.
- B. Provide panel profile, including major ribs and intermediate stiffening ribs, if any, for full length of panel.
- C. Fabricate metal roof panel side laps with factory-installed captive gaskets or separator strips that provide a tight seal and prevent metal-to-metal contact, in a manner that will seal weathertight and minimize noise from movements within panel assembly.
- D. Sheet Metal Accessories: Fabricate flashing and trim to comply with recommendations in SMACNA's "Architectural Sheet Metal Manual" that apply to the design, dimensions, metal, and other characteristics of item indicated.

**PART 2 - EXECUTION**

**2.1 PREPARATION**

- A. Miscellaneous Framing: Install subpurlins, eave angles, furring, and other miscellaneous roof panel support members and anchorage according to metal roof panel manufacturer's written instructions.

**2.2 METAL ROOF PANEL INSTALLATION**

- A. Lap-Seam Metal Roof Panels: Fasten metal roof panels to supports with fasteners at each lapped joint at location and spacing recommended by manufacturer.
  - 1. Apply panels and associated items for neat and weathertight enclosure. Avoid "panel creep" or application not true to line.
  - 2. Lap ribbed or fluted sheets one full rib corrugation.
  - 3. Provide metal-backed neoprene or EPDM washers under heads of exposed fasteners bearing on weather side of metal roof panels.
  - 4. Locate and space exposed fasteners in uniform vertical and horizontal alignment. Use proper tools to obtain controlled uniform compression for positive seal without rupture of washer.
  - 5. Install screw fasteners with power tools having controlled torque adjusted to compress washer tightly without damage to washer, screw threads, or panels. Install screws in predrilled holes.
  - 6. Provide sealant tape at lapped joints of metal roof panels and between panels and protruding equipment, vents, and accessories.
  - 7. Apply a continuous ribbon of sealant tape to weather-side surface of fastenings on end laps, and on side laps of nesting-type panels; on side laps of corrugated nesting-type,

ribbed, or fluted panels; and elsewhere as needed to make panels weatherproof to driving rains.

8. At panel end splices, nest panels with minimum 6-inch end lap, sealed with butyl-rubber sealant and fastened together by interlocking clamping plates.

- B. Standing-Seam Metal Roof Panels: Fasten metal roof panels to supports with concealed clips at each standing-seam joint at location, spacing, and with fasteners recommended by manufacturer.

1. Install clips to supports with self-drilling-fasteners.
2. Install pressure plates at locations indicated in manufacturer's written installation instructions.
3. Snap Joint: Nest standing seams and fasten together by interlocking and completely engaging factory-applied sealant.
4. Seamed Joint: Crimp standing seams with manufacturer-approved, motorized seamer tool so clip, metal roof panel, and factory-applied sealant are completely engaged.

## 2.3 ACCESSORY INSTALLATION

- A. General: Install accessories with positive anchorage to building and weathertight mounting and provide for thermal expansion. Coordinate installation with flashings and other components.

1. Install components required for a complete metal roof panel assembly including trim, copings, ridge closures, seam covers, flashings, sealants, gaskets, fillers, closure strips, and similar items.
2. Flashing and Trim: Comply with performance requirements, manufacturer's written installation instructions, and SMACNA's "Architectural Sheet Metal Manual." Provide concealed fasteners where possible, and set units true to line and level as indicated. Install work with laps, joints, and seams that will be permanently watertight and weather resistant.
3. Provide elbows at base of downspouts to direct water away from building.

## 2.4 CLEANING

- A. Remove temporary protective coverings and strippable films, if any, as metal roof panels are installed unless otherwise indicated in manufacturer's written installation instructions. On completion of metal roof panel installation, clean finished surfaces as recommended by metal roof panel manufacturer. Maintain in a clean condition during construction.

END OF SECTION 074113

## SECTION 074213 – METAL WALL PANELS

### PART 1 - GENERAL

#### 1.1 SECTION INCLUDES

- A. Metal wall panels
- B. Accessories including fasteners, perimeter trim and penetration treatments.

#### 1.2 REFERENCES

- A. ASTM International.
  - 1. ASTM A792 – Standard Specification for Steel Sheet, 55% Aluminum-Zinc Alloy-Coated by the Hot-Dip Process.
  - 2. ASTM B209; Standard Specification for Aluminum and Aluminum-Alloy Sheet and Plate..
  - 3. ASTM C920 – Standard Specification for Elastomeric Joint Sealants.

#### 1.3 SUBMITTALS

- A. Product Data: Submit manufacturer current technical literature for each type of product.
- B. Delegated Design: Design metal wall panel assembly, submit comprehensive engineering analysis by a qualified professional engineer, using performance requirements and design criteria indicated.
- C. Shop Drawings - Submit detailed drawings showing:
  - 1. Profile
  - 2. Gauge of panel
  - 3. Location, layout and dimensions of panels
  - 4. Location and type of fasteners
  - 5. Shape and method of attachment of all trim
  - 6. Locations and type of sealants
  - 7. Installation sequence.
  - 8. Other details as may be required for a weathertight installation
- D. Samples: Architect may request contractor to provide nominal 3 x 5 inch metal samples of available colors for final color selection/approval.

#### 1.4 QUALITY ASSURANCE

- A. Manufacturer Qualifications: Manufacturer shall have a minimum of ten (10) years experience in the production of metal wall panels. Manufacturer shall demonstrate past experience with examples of projects of similar type and exposure.
- B. Installer Qualifications: Installer shall be authorized by the manufacturer and the work shall be supervised by a person having successfully completed a manufacturer training seminar regarding proper installation of the specified product.

**City of Wentzville MO Public Works Facility**

**Wentzville, Missouri**

PROJECT NO.: 19-040

1.5 DELIVERY, STORAGE AND HANDLING

- A. Deliver panel materials and components in manufacturer's original, unopened, undamaged packaging with identification labels intact.
- B. Store wall panel materials on dry, level, firm, and clean surface. Elevate one end of bundle to allow moisture run-off, cover and ventilate to allow air to circulate and moisture to escape.

1.6 WARRANTY

- A. Material Warranty: Standard form in which manufacturer agrees to repair or replace items that fail in materials or workmanship within specified warranty period. The items covered by the warranty include structural performance and finish performance.
  - 1. Warranty Period: Two (2) years from date of Substantial Completion.

PART 2 - PRODUCTS

2.1 MANUFACTURER

- A. Exterior walls shall be equal to Butlerib II panels as furnished by Butler Manufacturing Company and installed in accordance with the manufacturer's instructions.
- B. Approved Manufacturer's
  - 1. MBCI
  - 2. Morin –Kingspan Group
  - 3. Firestone Building Products
  - 4. Alliance Steel Building Systems
  - 5. ATAS

2.2 PERFORMANCE REQUIREMENTS

- A. Structural Performance: Provide metal wall panel systems designed to resist the following. Testing shall be done based on ASTM E330:
  - 1. Wind Loads: Determine loads based on the following minimum design wind pressures:
    - a. Uniform pressure as indicated on drawings.
  - 2. Deflection Limits: Metal wall panel assemblies shall withstand horizontal deflections no greater than L/180 of the span.
- B. Water Penetration under Static Pressure: Provide metal wall panel systems designed to resist penetration of water under static pressure. Testing shall be based on ASTM E331.
- C. Air Infiltration: Provide metal wall panel assemblies designed to resist air infiltration. Testing shall be done based on ASTM E283.

2.3 WALL PANEL MATERIALS

- A. Steel:
  - 1. Panels shall be 26 gage, 3' wide with four major corrugations, 1-1/2 " high 12" on center with two minor corrugations between each of the major corrugations the entire length of the panel.
  - 2. Panels shall be one piece from base to building eave.

3. The upper end of panels shall be fabricated with a square cut for all other roof panels and slopes
4. Wall panels shall be factory punched or field drilled at panel ends and shall match factory punched or field drilled holes in structurals for proper alignment
5. Panel material as specified shall be 26-gauge or 24-gauge painted Galvalume aluminum-zinc alloy (approximately 55 percent aluminum, 45 percent zinc), ASTM A 792. Paint with exterior colors of "Butler-Cote™" finish system, full-strength, 70 percent "Kynar 500" or "Hylar 5000" fluoropolymer (PVDF) coating. PVDF Coating Warranty: Metal building system manufacturer shall warrant coating for 25 years.

## 2.4 ACCESSORIES

- A. Wall panel accessories: Provide accessories as required for a complete installation. Accessories shall be as indicated on approved shop drawings and per manufacturer's approved standard details. All accessory material shall be 26 gage and finish of metal wall panels.
  1. Wedged ends: Factory crimped end laps.
  2. Closure Strips: Provide closed cell closure strips, minimum 1 inch thick matching metal wall panel profile.
- B. Trim:
  1. Fabricate trim from same material as wall panels. Finish to match metal wall panels.
  2. Locations include, but are not limited to the following: Drips, sills, jambs, corners, framed openings, parapet caps, reveals and fillers.
- C. Panel Sealant:
  1. Joint Sealant: ASTM C920 as recommended in writing by metal wall panel manufacturer.
  2. Butyl-Rubber-Based, Solvent-Release Sealant: ASTM C1311.
- D. Fasteners
  1. Wall panel-to-structural connections shall be made with Torx head Scrubolt fasteners.
  2. Wall panel-to-panel connections shall be made with Torx head self-drilling screws.
  3. Fastener locations shall be as shown on erection drawings as furnished by the Butler Manufacturing Company.
  4. All exposed fasteners shall be factory painted to match wall color.

## 2.5 FABRICATION

- A. Metal wall panels shall be formed to interconnect with edges of adjacent panels which are then mechanically attached through panel to supports using concealed fasteners.
- B. Fabricate metal wall panels to eliminate condensation on interior side of panel and with joints between panels designed to form weathertight seals.
- C. Metal wall panels shall have factory-installed sealant at panel joints to provide a tight seal and minimize noise from movements within panel assembly.
- D. Panels shall be factory formed. Field formed or breakformed panels are not acceptable.

**City of Wentzville MO Public Works Facility**

**Wentzville, Missouri**

PROJECT NO.: 19-040

- E. Trim Accessories: Fabricate steel trim accessories to comply with recommendations outlined in SMACNA's "Architectural Sheet Metal Manual".
- F. Trim Accessories: Provide manufacturer's standard extruded trim.
- G. Mitered Corners: Structurally bonded horizontal outside or inside trimless corners matching metal wall panel material, profile and factory applied finish shall be fabricated by metal wall panel manufacturer.
  - 1. Welded, riveted or field fabricated corners do not meet the requirements of this specification.

**2.6 FINISHES**

- A. Paint Finish:
  - 1. The panel material as specified shall be coated both sides with a layer of (galvalume®)aluminum-zinc alloy (approximately 55% aluminum, 45% zinc) applied by the continuous hot dip method. Triple-spot minimum 0.55 ounce per square foot as determined by the triple-spot test per ASTM Specification A-792.26 with exterior colors of a full strength, 70% Kynar 500®.
  - 2. Manufacturer shall warrant that coating shall not peel, crack or chip for 25 years. For a period of 25 years chalking shall not exceed ASTM D4214 #8 rating and will not fade more than 5 color difference units per ASTM D2244.
  - 3. Color to be selected by architect.

**PART 3 - EXECUTION**

**3.1 EXAMINATION**

- A. Provide field measurements to manufacturer as required to achieve proper fit of the metal wall panels to building envelope. Measurements shall be provided in a timely manner so that there is no impact to construction or manufacturing schedule.
- B. Supporting Steel: All structural supports required for installation of panels shall be by others. Support members shall be installed within the following tolerances:
  - 1. Plus or minus 1/8 inch in 5 feet in any direction along plane of framing.
  - 2. Plus or minus 1/4 inch cumulative in 20 feet in any direction along plane of framing.
  - 3. Plus or minus 1/2 inch from framing plane on any elevation.
  - 4. Plumb or level within 1/8 inch at all changes of transverse for performed corner panel applications.
  - 5. Verify that bearing support has been provided behind vertical joints of horizontal panel systems and vertical joints of horizontal panel systems. Width of support shall be as recommended by manufacturer.
- C. Examine individual panels upon removing from the bundle; notify manufacturer of panel defects. Do not install defective panels.

**3.2 PANEL INSTALLATION**

- A. Apply sealant to vertical joints at concealed fasteners, per manufacturer's recommendations and approved shop drawings.
- B. Installation shall be in accordance with manufacturer's installation guidelines and recommendations.



- C. Install panels plumb, level, and true-to-line to dimensions and layout indicated on approved shop drawings.
- D. Cutting and fitting of panels shall be neat, square and true. Torch cutting is prohibited.

### 3.3 TRIM INSTALLATION

- A. Place trim and trim fasteners only as indicated per details on the approved shop drawings.
- B. Apply sealant tape at trim, per manufacturer's details and approved shop drawings, for weather tight installation.

### 3.4 SEALANT INSTALLATION FOR EXPOSED JOINTS

- A. Clean and prime surfaces to review exterior exposed sealants in accordance with sealant manufacturer's recommendations.
- B. Follow sealant manufacturer's recommendations for joint width-to-depth ratio, application temperature range, size and type of backer rod, and compatibility of materials for adhesion.

### 3.5 CLEANING AND PROTECTION

- A. Remove protective film immediately after installation.
- B. Touch-up, repair or replace metal panels and trim that have been damaged.
- C. After metal wall panel installation, clear weep holes and drainage channels of obstructions, dirt, and sealant.

END OF SECTION 074213

## SECTION 099123 - PAINTING AND COATING

### PART 1 - GENERAL

#### 1.1 SUMMARY

- A. This Section includes surface preparation and the application of paint systems and coatings on the following interior substrates:
  - 1. Concrete masonry units (CMU).
  - 2. Steel.
  - 3. Galvanized metal.
  - 4. Aluminum (not anodized or otherwise coated).
  - 5. Spray-textured ceilings.
- B. This Section includes surface preparation and the application of paint systems and coatings on the following exterior substrates:
  - 1. Brick
  - 2. Steel
  - 3. Aluminum

#### 1.2 SUBMITTALS

- A. Product Data: For each type of product indicated.
- B. Samples: For each finish and for each color and texture required.
- C. Product List: Printout of current "MPI Approved Products List" for each product category specified in Part 2, with the proposed product highlighted.

#### 1.3 QUALITY ASSURANCE

- A. MPI Standards:
  - 1. Products: Complying with MPI standards indicated and listed in "MPI Approved Products List."
  - 2. Preparation and Workmanship: Comply with requirements in "MPI Architectural Painting Specification Manual" for products and paint systems indicated.
- B. Mockups: Apply benchmark samples of each paint system indicated and each color and finish selected to verify preliminary selections made under sample submittals and to demonstrate aesthetic effects and set quality standards for materials and execution.
  - 1. Architect will select one surface to represent surfaces and conditions for application of each paint system specified in Part 3.
    - a. Wall and Ceiling Surfaces: Provide samples of at least 100 sq. ft.
    - b. Other Items: Architect will designate items or areas required.
  - 2. Apply benchmark samples after permanent lighting and other environmental services have been activated.
  - 3. Final approval of color selections will be based on benchmark samples.
    - a. If preliminary color selections are not approved, apply additional benchmark samples of additional colors selected by Architect at no added cost to Owner.

**City of Wentzville MO Public Works Facility**

**Wentzville, Missouri**

PROJECT NO.: 19-040

**1.4 EXTRA MATERIALS**

- A. Furnish extra materials described below that are from same production run (batch mix) as materials applied and that are packaged for storage and identified with labels describing contents.
  - 1. Quantity: Furnish an additional 5 percent, but not less than 1 gal. of each material and color applied.

**PART 2 - PRODUCTS**

**2.1 MANUFACTURERS**

- A. Acceptable Manufacturer:
  - The Sherwin-Williams Company or Approved Equal- "Pro Green"
  - 101 Prospect Avenue NW
  - Cleveland, OH 44115
  - Tel: (800) 321-8194
  - Fax: (216) 566-1392
  - [www.sherwin-williams.com](http://www.sherwin-williams.com)
  - Other acceptable Manufacturers: KWAL, Benjamin Moore, ICI, PPG Pittsburgh Paints
- 1. Provide materials for use within each paint system that are compatible with one another and substrates indicated, under conditions of service and application as demonstrated by manufacturer, based on testing and field experience.
- 2. For each coat in a paint system, provide products recommended in writing by manufacturers of topcoat for use in paint system and on substrate indicated.
- B. Substitutions: Requests for substitution will be considered in accordance with provisions of section 012500 product requirements. When submitting requests for substitution, provide complete product data specified above under submittals, for each substitute product.
- C. VOC Content of Field-Applied Interior Paints and Coatings: Provide products that comply with the following limits for VOC content, exclusive of colorants added to a tint base, when calculated according to 40 CFR 59, Subpart D (EPA Method 24); these requirements do not apply to paints and coatings that are applied in a fabrication or finishing shop:
  - 1. Flat Paints, Coatings, and Primers: VOC content of not more than 50 g/L.
  - 2. Nonflat Paints, Coatings, and Primers: VOC content of not more than 150 g/L.
  - 3. Anti-Corrosive and Anti-Rust Paints Applied to Ferrous Metals: VOC not more than 250 g/L.
  - 4. Floor Coatings: VOC not more than 100 g/L.
  - 5. Shellacs, Clear: VOC not more than 730 g/L.
  - 6. Shellacs, Pigmented: VOC not more than 550 g/L.
  - 7. Flat Topcoat Paints: VOC content of not more than 50 g/L.
  - 8. Nonflat Topcoat Paints: VOC content of not more than 150 g/L.
  - 9. Anti-Corrosive and Anti-Rust Paints Applied to Ferrous Metals: VOC not more than 250 g/L.
  - 10. Floor Coatings: VOC not more than 100 g/L.
  - 11. Shellacs, Clear: VOC not more than 730 g/L.
  - 12. Shellacs, Pigmented: VOC not more than 550 g/L.
  - 13. Primers, Sealers, and Undercoaters: VOC content of not more than 200 g/L.
  - 14. Dry-Fog Coatings: VOC content of not more than 400 g/L.
  - 15. Zinc-Rich Industrial Maintenance Primers: VOC content of not more than 340 g/L.
  - 16. Pre-Treatment Wash Primers: VOC content of not more than 420 g/L.

- D. Chemical Components of Field-Applied Interior Paints and Coatings: Provide topcoat paints and anti-corrosive and anti-rust paints applied to ferrous metals that comply with the following chemical restrictions; these requirements do not apply to paints and coatings that are applied in a fabrication or finishing shop:

1. Aromatic Compounds: Paints and coatings shall not contain more than 1.0 percent by weight of total aromatic compounds (hydrocarbon compounds containing one or more benzene rings).
2. Restricted Components: Paints and coatings shall not contain any of the following:
  - a. Acrolein.
  - b. Acrylonitrile.
  - c. Antimony.
  - d. Benzene.
  - e. Butyl benzyl phthalate.
  - f. Cadmium.
  - g. Di (2-ethylhexyl) phthalate.
  - h. Di-n-butyl phthalate.
  - i. Di-n-octyl phthalate.
  - j. 1,2-dichlorobenzene.
  - k. Diethyl phthalate.
  - l. Dimethyl phthalate.
  - m. Ethylbenzene.
  - n. Formaldehyde.
  - o. Hexavalent chromium.
  - p. Isophorone.
  - q. Lead.
  - r. Mercury.
  - s. Methyl ethyl ketone.
  - t. Methyl isobutyl ketone.
  - u. Methylene chloride.
  - v. Naphthalene.
  - w. Toluene (methylbenzene).
  - x. 1,1,1-trichloroethane.
  - y. Vinyl chloride.

- E. Colors: As selected by Architect from manufacturer's full range.

## 2.2 INTERIOR PAINTING and COATING

(2.5 - 3 mils dry per coat)

- A. MASONRY CMU'S (all areas except Wash Bay)

1. Epoxy Systems

- a. Low Luster Finish

1st Coat: S-W Heavy Duty Block Filler

2nd Coat: S-W Pro Industrial- Hi-Bild-waterbased catalyzed epoxy, B71- V110

(2.5 - 3 mils dry per coat)

3rd Coat: S-W Pro Industrial- Hi-Bild-waterbased catalyzed epoxy, B71-V110  
(2.5 - 3 mils dry per coat)

**City of Wentzville MO Public Works Facility**

**Wentzville, Missouri**

**PROJECT NO.: 19-040**

**B. MASONRY CMU'S (Wash Bay)- Epoxy Block Filler / Epoxy Intermediate Coat / Epoxy or Polysiloxane Finish Coat**

**1. Epoxy Systems**

**a. Low Luster Finish**

- 1st Coat: B42W400 Kem Cati-Coat HS Epoxy Filler
- 2nd Coat: B58W610 Macropoxy 646 Fast Cure Epoxy tinted to the choice of color.  
(2.5 - 3 mils dry per coat)
- 3rd Coat: B58W610 Macropoxy 646 Fast Cure Epoxy tinted to the choice of color.  
(2.5 - 3 mils dry per coat)

**C. METAL (Railing Systems, Door and Door frames)**

**1. Acrylic Systems**

**a. LOWER ODOR/LOW VOC: Semi-Gloss Finish**

- 1st Coat: S-W Pro Industrial Pro-Cryl® Universal Primer, B66-310 Series  
(5-10 mils wet, 2-4 mils dry per coat)
- 2nd Coat: S-W Pro Industrial 0 VOC Acrylic, B66-650 Series
- 3rd Coat: S-W Pro Industrial 0 VOC Acrylic, B66-650 Series  
(7 mils wet)

**D. METAL (steel deck, angles, joists, beams, ductwork, conduit, water & gas piping, etc.)**

**1. Dryfall Systems**

**a. Flat Finish**

- 1st Coat: S-W Pro Industrial Pro-Cryl® Universal Primer, B66-310 Series  
(5-10 mils wet, 2-4 mils dry per coat)
- 2nd Coat: S-W Waterborne Acrylic Dry Fall Flat White, B42W1 Series
- 3rd Coat: S-W Waterborne Acrylic Dry Fall Flat White, B42W1 Series  
(7-11 mils wet, 3-4.5 mils dry per coat)

**E. METAL (exposed structural columns)**

**1. Alkyd System, Gloss Finish**

- a. 1st Coat: S-W Kem Kromik Universal Metal Primer, B50Z Series
- b. 2nd Coat: S-W Industrial Enamel B54 Series
- c. 3rd Coat: S-W Industrial Enamel B54 Series  
(2.5-4 mils wet, 2.2-3.5 mils dry)

**F. EXPOSED CONCRETE FLOORS**

- 1. Provide sealer over all exposed concrete floors not covered with floor covering or indicated as polished concrete or hardener/densifier.
- 2. Sealer to be equal to Infusion Water Based Clear Sealer as supplied by H & C Concrete/Sherwin Williams. 1-800-867-8246 or [www.hcconcrete.com](http://www.hcconcrete.com).

3. Sealer is to be applied to new concrete surface. Moisture cure or apply clear non-residual curing compound.
4. See finish schedule for locations requiring sealer

## 2.3 EXTERIOR PAINTING AND COATINGS

### A. CMU BLOCK

1. All exposed surfaces of masonry shall receive a proper application of Siloxane WB by Sure Klean as manufacturer by Prosoco, Inc., 3741 Greenway Circle, Lawrence, KS 66046; phone (800) 255-4255. The material shall be applied as follows:
  - a. Painting contractor shall apply two coats of weather seal to all masonry surfaces, including mortar joints and other exposed concrete and masonry surfaces.
  - b. Both coatings of materials shall be installed in accordance with the manufacturer's recommendations and the quality of material to be used per square foot of area.

### B. MISCELLANEOUS METALS (Lintels, bollard, gas piping, etc.)

1. Alkyd System, Gloss Finish
  - a. 1st Coat: S-W Kem Kromik Universal Metal Primer, B50Z Series
  - b. 2nd Coat: S-W Industrial Enamel B54 Series
  - c. 3rd Coat: S-W Industrial Enamel B54 Series  
(2.5-4 mils wet, 2.2-3.5 mils dry)

## 2.4 MATERIALS

### A. Paints and Coatings - General:

1. Unless otherwise indicated, provide factory-mixed coatings. When required, mix coatings to correct consistency in accordance with manufacturer's instructions before application. Do not reduce, thin, or dilute coatings or add materials to coatings unless such a procedure is specifically described in manufacturer's product instructions. VOC numbers need to be confirmed by using the products MSDS sheets.

## 2.5 ACCESSORIES

### A. Coating Application Accessories:

1. Provide all primers, sealers, cleaning agents, cleaning cloths, sanding materials, and clean-up materials required per manufacturers specifications.

## PART 3 - EXECUTION

### 3.1 EXAMINATION

- A. Do not begin application of coating until substrates have been properly prepared. Notify Architect of unsatisfactory conditions before proceeding.
- B. If substrate preparation is the responsibility of another installer, notify Architect of unsatisfactory preparation before proceeding.
- C. Proceed with work only after conditions have been corrected and approved by all parties otherwise application of coatings will be considered and acceptance of surface conditions.

### 3.2 SURFACE PREPARATION

- A. Proper product selection, surface preparation, and application affect coating performance. Coating integrity and service life will be reduced because of improperly prepared surfaces. Selection and implementation of proper surface preparation ensures coating adhesion to the substrate and prolongs the service life of the coating system.
- B. Selection of the proper method of surface preparation depends on the substrate, the environment, and the expected service life of the coating system. Economics, surface contamination, and the effect on the substrate will also influence the selection of surface preparation methods.
- C. Pressure wash/clean all surfaces to be painted to remove all dirt, grease, chalk, loose paint and surface contaminates.
- D. The surface must be dry and in sound condition. Remove oil, dust, dirt, loose rust, peeling paint or other contamination to ensure good adhesion.
- E. Remove mildew before painting by washing with a solution of one (1) part liquid household bleach and three (3) parts of warm water. Apply the solution and scrub the mildewed area. Allow the solution to remain on the surface for 10 minutes; however, do not allow the solution to dry on the surface. Rinse thoroughly with clean water and allow the surface to dry 48 hours before painting. Wear protective glasses or goggles, waterproof gloves, and protective clothing. Quickly wash off any of the mixture that comes in contact with your skin. Do not add detergents or ammonia to the bleach/water solution.
- F. No painting should take place when the interior temperature is below 50°F unless the specified product is designed for the marginal conditions.
- G. If the surfaces to be painted are heavily contaminated with grease or oil, clean the highly contaminated areas with Great Lakes Laboratories Extra Muscle Prepaint Cleaner.
- H. Methods
  - 1. Aluminum: Remove all oil, grease, dirt, oxide and other foreign material by cleaning per SSPC-SP1, Solvent Cleaning.
  - 2. Block: Remove all loose mortar and foreign material. Surface must be free of laitance, concrete dust, dirt, form release agents, moisture curing membranes, loose cement, and hardeners. Concrete and mortar must be cured at least 30 days at 75°F unless the manufactures products are designed for application prior to the 30-day period. The pH of the surface should be between 6 and 9, unless the products are designed to be used in high pH environments. On tilt-up and poured-in-place concrete, commercial detergents and abrasive blasting may be necessary to prepare the surface. Fill bug holes, air pockets, and other voids with a cement patching compound.
  - 3. Concrete: This standard gives requirements for surface preparation of concrete by mechanical, chemical, or thermal methods prior to the application of bonded protective coating or lining systems. The requirements of this standard are applicable to all types of cementitious surfaces including cast-in-place concrete floors and walls, precast slabs, masonry walls, and shotcrete surfaces. An acceptable prepared concrete surface should be free of contaminants, laitance, loosely adhering concrete, and dust, and should provide a sound, uniform substrate suitable for the application of protective coating or lining systems.
  - 4. Galvanized Metal: Clean per SSPC-SP1 using detergent and water or a degreasing cleaner to remove greases and oils. Apply a test area, priming as required. Allow the

coating to dry at least one week before testing. If adhesion is poor, Brush Blast per SSPC-SP7 is necessary to remove these treatments.

5. Steel: Structural, Plates, etc.: Clean per SSPC-SP1, solvent cleaning. Solvent cleaning is a method for removing all visible oil, grease, soil, drawing and cutting compounds, and other soluble contaminants. Solvent cleaning does not remove rust or mill scale. Change rags and cleaning solution frequently so that deposits of oil and grease are not spread over additional areas in the cleaning process. Be sure to allow adequate ventilation. On ferrous metal surfaces remove all loose corrosion by using SSPC-SP2 Hand Tool Cleaning and SSPC-SP3 Power Tool Cleaning.

### 3.3 INSTALLATION

- A. Apply all coatings and materials with manufacturer specifications in mind. Mix and thin coatings according to manufacturer's recommendations.
- B. Do not apply to wet or damp surfaces.
  1. Wait at least 30 days before applying to new concrete or masonry. Or follow manufacturer's procedures to apply appropriate coatings prior to 30 days.
  2. Test new concrete for moisture content.
- C. Apply coatings using methods recommended by manufacturer.
- D. Uniformly apply coatings without runs, drips, or sags, without brush marks and with the consistent sheen.
- E. Apply coatings at spreading rate required to achieve the manufacturer's recommended dry film thickness.
- F. Dark colors and deep clear colors: Regardless of number of coats specified, apply as many coats as necessary for complete hide.
- G. Inspection: The coated surface must be inspected and approved by the Architect or Engineer just prior to each coat.

### 3.4 PROTECTION

- A. Protect finished coatings from damage until completion of project.
- B. Touch-up damaged coating after substantial completion, following manufacturer's recommendations for touch up or repair of damaged coatings. Repair any defects that will hinder the performance of the coatings.

END OF SECTION 099123



## SECTION 133419 - METAL BUILDING SYSTEMS

### PART 1 - GENERAL

#### 1.1 SUMMARY

- A. Section Includes:
  - 1. Structural-steel framing.
  - 2. Thermal roof insulation.
  - 3. Accessories.

#### 1.2 SUBMITTALS

- A. Product Data: For each type of metal building system component.
- B. Shop Drawings: For metal building system components. Include plans, elevations, sections, details, and attachments to other work.
- C. Samples: For each type of exposed finish required.
- D. Delegated-Design Submittal: For metal building systems indicated to comply with performance requirements and design criteria, including analysis data and calculations signed and sealed by the qualified professional engineer responsible for their preparation. Details and plans outline basic connection types between metal building components and structural steel components. Beam to Beam and Beam to Column connections shall be sized by metal building professional engineer as standard AISC, Type 2, Bearing connections capable of supporting reactions developed by maximum uniform load capacity on a simple span for beam and beam span given.
- E. Welding certificates.
- F. Metal Building System Certificates: For each type of metal building system, from manufacturer.
  - 1. Letter of Design Certification: Signed and sealed by a qualified professional engineer. Include the following:
    - a. Name and location of Project.
    - b. Order number.
    - c. Name of manufacturer.
    - d. Name of Contractor.
    - e. Building dimensions including width, length, height, and roof slope.
    - f. Indicate compliance with AISC standards for hot-rolled steel and AISI standards for cold-rolled steel, including edition dates of each standard.
    - g. Governing building code and year of edition.
    - h. Design Loads: Include dead load, roof live load, collateral loads, roof snow load, deflection, wind loads/speeds and exposure, seismic design category or effective peak velocity-related acceleration/peak acceleration, and auxiliary loads (cranes).
    - i. Load Combinations: Indicate that loads were applied acting simultaneously with concentrated loads, according to governing building code.
    - j. Building-Use Category: Indicate category of building use and its effect on load importance factors.
- G. Material test reports.
- H. Source quality-control reports.

## City of Wentzville MO Public Works Facility

### Wentzville, Missouri

PROJECT NO.: 20-0067

- I. Field quality-control reports.
- J. Maintenance data.
- K. Warranties: Sample of special warranties.

#### 1.3 QUALITY ASSURANCE

- A. Manufacturer Qualifications: A qualified manufacturer.
  - 1. Engineering Responsibility: Preparation of Shop Drawings and comprehensive engineering analysis by a qualified professional engineer.
- B. Erector Qualifications: An experienced erector who specializes in erecting and installing work similar in material, design, and extent to that indicated for this Project and who is acceptable to manufacturer.
- C. Welding Qualifications: Qualify procedures and personnel according to the following:
  - 1. AWS D1.1/D1.1M, "Structural Welding Code - Steel."
  - 2. AWS D1.3, "Structural Welding Code - Sheet Steel."
- D. Structural Steel: Comply with AISC 360, "Specification for Structural Steel Buildings," for design requirements and allowable stresses.
- E. Cold-Formed Steel: Comply with AISI's "North American Specification for the Design of Cold-Formed Steel Structural Members" for design requirements and allowable stresses.
- F. Preinstallation Conference: Conduct conference at Project site.

#### 1.4 WARRANTY

- 1. Manufacturer's standard one year warranty on materials and workmanship.

### PART 2 - PRODUCTS

#### 2.1 MANUFACTURERS

- A. Manufacturers: Subject to compliance with requirements, available manufacturers offering products that may be incorporated into the Work include, but are not limited to, the following:
  - 1. A&S Building Systems, Inc.; Division of NCI Building Systems, L.P.
  - 2. Alliance Steel
  - 3. American Buildings Company; A Nucor Company
  - 4. Butler Manufacturing Company; a BlueScope Steel company.
  - 5. CBC Steel Buildings; A Nucor Company
  - 6. Ceco Building Systems; Division of NCI Building Systems, L.P.
  - 7. Garco Building Systems; Division of NCI Building Systems, L.P..
  - 8. Mesco Building Solutions; Division of NCI Building Systems, L.P.
  - 9. Metallic Building Company; Division of NCI Building Systems, L.P.
  - 10. Metco Metal Supply.
  - 11. Mid-West Steel Building Company; Division of NCI Building Systems, L.P.
  - 12. Nucor Building Systems A Nucor Company.
  - 13. Olympia Steel Building Systems.
  - 14. Pinnacle Structures, Inc.
  - 15. Star Building Systems; an NCI company.
  - 16. United Structures of America
  - 17. VP Buildings; a BlueScope Steel Company

18. Vulcan Steel Structures, Inc.

## 2.2 METAL BUILDING SYSTEM PERFORMANCE

- A. Delegated Design: Design metal building system, including comprehensive engineering analysis by a qualified professional engineer, using performance requirements and design criteria indicated.
- B. Structural Performance: Metal building systems shall be designed according to procedures in MBMA's "Metal Building Systems Manual."
  - 1. Design Loads: As indicated on Drawings.
  - 2. Deflection Limits: Design metal building system assemblies to withstand design loads with deflections no greater than the following:
    - a. Purlins and Rafters: Vertical deflection of 1/240 of the span.
    - b. Girts: Horizontal deflection of 1/360 of the span.
    - c. Metal Roof Panels: Vertical deflection of 1/240 of the span.
    - d. Metal Wall Panels: Horizontal deflection of 1/240 of the span.
    - e. Design secondary-framing system to accommodate deflection of primary framing and construction tolerances, and to maintain clearances at openings.
  - 3. Drift Limits: Engineer building structure to withstand design loads with drift limits no greater than the following:
    - a. Lateral Drift: Maximum of 1/400 of the building height for systems directly supporting masonry or other brittle wall systems.
  - 4. Metal panel assemblies shall withstand the effects of gravity loads and loads and stresses within limits and under conditions indicated according to ASTM E 1592.
- C. Seismic Performance: Metal building systems shall withstand the effects of earthquake motions determined according to ASCE/SEI 7.
- D. Thermal Movements: Allow for thermal movements resulting from the following maximum change (range) in ambient and surface temperatures by preventing buckling, opening of joints, overstressing of components, failure of joint sealants, failure of connections, and other detrimental effects. Base engineering calculations on surface temperatures of materials due to both solar heat gain and nighttime-sky heat loss.
  - 1. Temperature Change (Range): 120 deg F, material surfaces.

## 2.3 STRUCTURAL-STEEL FRAMING

- A. Primary Framing: Manufacturer's Rigid Frame (RF Series) solid web framing consisting of tapered or uniform depth rafters rigidly connected to tapered or uniform depth columns. System to be designed to withstand required loads and specified requirements. Primary framing includes transverse and lean-to frames; rafter, rake, and canopy beams; sidewall, intermediate, end-wall, and corner columns; connections; and wind bracing.
  - 1. General: Provide frames with attachment plates, bearing plates, and splice members. Factory drill for field-bolted assembly.
- B. End-Wall Framing: Manufacturer's standard primary end-wall framing fabricated for field-bolted assembly.
- C. Secondary Framing: Manufacturer's standard secondary framing, including purlins, girts, eave struts, flange bracing, base members, gable angles, clips, headers, jambs, and other miscellaneous structural members. Unless otherwise indicated, fabricate framing from either cold-formed, structural-steel sheet or roll-formed, metallic-coated steel sheet, prepainted with coil coating.

## City of Wentzville MO Public Works Facility

### Wentzville, Missouri

PROJECT NO.: 20-0067

- D. Bolts: Provide plain-finish bolts for structural-framing components that are primed or finish painted. Provide zinc-plated or hot-dip galvanized bolts for structural-framing components that are galvanized.
- E. Wind Bracing: Portal, torsional, diagonal bracing or diaphragm in accordance with manufacturer's standard design practices; utilizing rods, angles, and other members, with minimum yield strengths as required for design but in most cases, 50 ksi.
- F. Primary Frame Flange Bracing: Attached from purlins or girts to the primary framing, minimum yield strength as required for design but in most cases 60 ksi.
- G. Finish: Factory primed. Apply specified primer immediately after cleaning and pretreating.

#### 2.4 MISCELLANEOUS FRAMING

- A. Base Angles: 2 inch by 3 inch by 0.059 inch (50 mm by 75 mm by 1.5 mm) galvanized steel angles, with minimum yield strength of 55 ksi (380 MPa), anchored to the floor slab or grade beam with power driven fasteners or equivalent at a maximum spacing of 4 feet (1220 mm) on center and not more than 6 inches (150 mm) from the end of any angle member. Anchors are not provided by the metal building manufacturer.
- B. Door Headers and Jambs: Zee- or Cee-shaped; depth as required; with minimum yield strength of 60 ksi (410 MPa).

#### 2.5 INSULATION

- A. See section 072100 for insulation.

#### 2.6 METAL ROOF PANELS

- A. See section 074113 for metal roof panels.

#### 2.7 METAL WALL PANELS

- A. See section 074213 for metal wall panels.

#### 2.8 METAL LINER PANELS

- A. See section 074215 for metal liner panels.

#### 2.9 ACCESSORIES this section may be deleted if covered in section 076200

- A. General: Provide accessories as standard with metal building system manufacturer and as specified. Fabricate and finish accessories at the factory to greatest extent possible, by manufacturer's standard procedures and processes. Comply with indicated profiles and with dimensional and structural requirements.
  - 1. Form exposed sheet metal accessories that are without excessive oil-canning, buckling, and tool marks and that are true to line and levels indicated, with exposed edges folded back to form hems.
- B. Flashing and Trim: Formed from 0.022-inch nominal-thickness, metallic-coated steel sheet or aluminum-zinc alloy-coated steel sheet prepainted with coil coating; finished to match adjacent metal panels.

- C. Gutters: 24 gage verify to match accessories in metal panel spec., metallic-coated steel sheet or aluminum-zinc alloy-coated steel sheet prepainted with coil coating; finished to match roof fascia and rake trim. Match profile of gable trim, complete with end pieces, outlet tubes, and other special pieces as required. Fabricate in minimum 96-inch- long sections, sized according to SMACNA's "Architectural Sheet Metal Manual."
    - 1. Gutter Supports: Fabricated from same material and finish as gutters.
    - 2. Strainers: Bronze, copper, or aluminum wire ball type at outlets.
  - D. Downspouts: 24 gage verify to match accessories in metal panel spec, zinc-coated (galvanized) steel sheet or aluminum-zinc alloy-coated steel sheet prepainted with coil coating; finished to match metal wall panels. Fabricate in minimum 10-foot- long sections, complete with formed elbows and offsets.
    - 1. Mounting Straps: Fabricated from same material and finish as gutters.
    - 2. Continuous or Sectional-Ridge Type: Factory-engineered and -fabricated, continuous unit; 24 gage, metallic-coated steel sheet or aluminum-zinc alloy-coated steel sheet prepainted with coil coating; finished to match metal roof panels. Fabricated in minimum 10-foot- long sections. Provide throat size and total length indicated, complete with side baffles, ventilator assembly, end caps, splice plates, and reinforcing diaphragms.
      - a. Bird Screening: Galvanized steel or aluminum
  - E. Interior metal liner panels: select one less expensive 26 ga Butlerib® II panels exposed fasteners as furnished by Butler Manufacturing Company and installed in accordance with the manufacturer's instructions. more expensive Equal to Pac-Clad 11" wide 24 gage flush panels with concealed fastening. Panel height to be 8'-0" and attached to metal building system girts. Finish to be Kynar 500 and selected from standard colors.
  - F. Pipe Flashing: Premolded, EPDM pipe collar with flexible aluminum ring bonded to base.
- 2.10 SOURCE QUALITY CONTROL
- A. Testing Agency: Contractor will engage a qualified testing agency to evaluate field welds and bolt connections as required per International Building Code.
  - B. Special Inspector: Contractor will engage a qualified special inspector to perform the following tests and inspections and to submit reports. Special inspector will verify that manufacturer maintains detailed fabrication and quality-control procedures and will review the completeness and adequacy of those procedures to perform the Work.
    - 1. Special inspections will not be required if fabrication is performed by manufacturer registered and approved by authorities having jurisdiction to perform such Work without special inspection.
      - a. After fabrication, submit copy of certificate of compliance to authorities having jurisdiction, certifying that Work was performed according to Contract requirements.
  - C. Testing: Test and inspect field connections for metal buildings according to the following:
    - 1. Bolted Connections: Shop-bolted connections shall be tested and inspected according to RCSC's "Specification for Structural Joints Using ASTM A 325 or A 490 Bolts."
    - 2. Field Welded Connections: In addition to visual inspection, connections shall be tested and inspected according to AWS D1.1/D1.1M and the following inspection procedures, at inspector's option:
      - a. Liquid Penetrant Inspection: ASTM E 165.

## City of Wentzville MO Public Works Facility

### Wentzville, Missouri

PROJECT NO.: 20-0067

- b. Magnetic Particle Inspection: ASTM E 709; performed on root pass and on finished weld. Cracks or zones of incomplete fusion or penetration will not be accepted.
  - c. Ultrasonic Inspection: ASTM E 164.
  - d. Radiographic Inspection: ASTM E 94.
- D. Product will be considered defective if it does not pass tests and inspections.
- E. Prepare test and inspection reports.

#### 2.11 FABRICATION

- A. General: Design components and field connections required for erection to permit easy assembly.
  - 1. Mark each piece and part of the assembly to correspond with previously prepared erection drawings, diagrams, and instruction manuals.
  - 2. Fabricate structural framing to produce clean, smooth cuts and bends. Punch holes of proper size, shape, and location. Members shall be free of cracks, tears, and ruptures.
- B. Tolerances: Comply with MBMA's "Metal Building Systems Manual" for fabrication and erection tolerances.
- C. Primary Framing: Shop fabricate framing components to size and section, with baseplates, bearing plates, stiffeners, and other items required for erection welded into place. Cut, form, punch, drill, and weld framing for bolted field assembly.
- D. Secondary Framing: Shop fabricate framing components to size and section by roll-forming or break-forming. Cut, form, punch, drill, and weld secondary framing for bolted field connections to primary framing.

#### PART 3 - EXECUTION

##### 3.1 ERECTION OF STRUCTURAL FRAMING

- A. Erect metal building system according to manufacturer's written erection instructions and erection drawings.
- B. Do not field cut, drill, or alter structural members without written approval from metal building system manufacturer's professional engineer.
- C. Set structural framing accurately in locations and to elevations indicated, according to AISC specifications referenced in this Section. Maintain structural stability of frame during erection.
- D. Base and Bearing Plates: Clean concrete- and masonry-bearing surfaces of bond-reducing materials and roughen surfaces prior to setting plates. Clean bottom surface of plates.
  - 1. Set plates for structural members on wedges, shims, or setting nuts as required.
  - 2. Tighten anchor rods after supported members have been positioned and plumbed. Do not remove wedges or shims but, if protruding, cut off flush with edge of plate before packing with grout.
  - 3. Promptly pack grout solidly between bearing surfaces and plates so no voids remain. Neatly finish exposed surfaces; protect grout and allow to cure. Comply with manufacturer's written installation instructions for shrinkage-resistant grouts.

- E. Align and adjust structural framing before permanently fastening. Before assembly, clean bearing surfaces and other surfaces that will be in permanent contact with framing. Perform necessary adjustments to compensate for discrepancies in elevations and alignment.
  - 1. Level and plumb individual members of structure.
  - 2. Make allowances for difference between temperature at time of erection and mean temperature when structure will be completed and in service.
- F. Primary Framing and End Walls: Erect framing level, plumb, rigid, secure, and true to line. Level baseplates to a true even plane with full bearing to supporting structures, set with double-nutted anchor bolts. Use grout to obtain uniform bearing and to maintain a level base-line elevation. Moist-cure grout for not less than seven days after placement.
  - 1. Make field connections using high-strength bolts installed according to RCSC's "Specification for Structural Joints Using ASTM A 325 or A 490 Bolts" for bolt type and joint type specified.
    - a. Joint Type: Snug tightened or pretensioned.
- G. Secondary Framing: Erect framing level, plumb, rigid, secure, and true to line. Field bolt secondary framing to clips attached to primary framing.
  - 1. Provide rake or gable purlins with tight-fitting closure channels and fasciae.
  - 2. Locate and space wall girts to suit openings such as doors and windows.
  - 3. Locate canopy framing as indicated.
  - 4. Provide supplemental framing at entire perimeter of openings, including doors, windows, louvers, ventilators, and other penetrations of roof and walls.
- H. Steel Joists: Install joists and accessories plumb, square, and true to line; securely fasten to supporting construction according to SJI's "Standard Specifications and Load Tables for Steel Joists and Joist Girders," joist manufacturer's written instructions, and requirements in this Section.
  - 1. Before installation, splice joists delivered to Project site in more than one piece.
  - 2. Space, adjust, and align joists accurately in location before permanently fastening.
  - 3. Install temporary bracing and erection bridging, connections, and anchors to ensure that joists are stabilized during construction.
  - 4. Bolt joists to supporting steel framework using carbon-steel bolts unless high-strength structural bolts are required by the manufacturer.
  - 5. Comply with RCSC's "Specification for Structural Joints Using ASTM A 325 or A 490 Bolts" for high-strength structural bolt installation and tightening requirements.
  - 6. Install and connect bridging concurrently with joist erection, before construction loads are applied. Anchor ends of bridging lines at top and bottom chords if terminating at walls or beams.
- I. Bracing: Install bracing in roof and sidewalls where indicated on erection drawings.
  - 1. Tighten rod and cable bracing to avoid sag.
  - 2. Locate interior end-bay bracing only where indicated.
- J. Framing for Openings: Provide shapes of proper design and size to reinforce openings and to carry loads and vibrations imposed, including equipment furnished under mechanical and electrical work. Securely attach to structural framing.
- K. Erection Tolerances: Maintain erection tolerances of structural framing within AISC 303.

## City of Wentzville MO Public Works Facility

### Wentzville, Missouri

PROJECT NO.: 20-0067

#### 3.2 ACCESSORY INSTALLATION some of this section may deleted if covered in section 076200

- A. General: Install accessories with positive anchorage to building and weathertight mounting and provide for thermal expansion. Coordinate installation with flashings and other components.
  - 1. Install components required for a complete metal roof panel assembly, including trim, copings, ridge closures, seam covers, flashings, sealants, gaskets, fillers, closure strips, and similar items.
  - 2. Install components for a complete metal wall panel assembly, including trim, copings, corners, seam covers, flashings, sealants, gaskets, fillers, closure strips, and similar items.
  - 3. Where dissimilar metals contact each other or corrosive substrates, protect against galvanic action by painting contact surfaces with corrosion-resistant coating, by applying rubberized-asphalt underlayment to each contact surface, or by other permanent separation as recommended by manufacturer.
- B. Flashing and Trim: Comply with performance requirements, manufacturer's written installation instructions, and SMACNA's "Architectural Sheet Metal Manual." Provide concealed fasteners where possible and set units true to line and level as indicated. Install work with laps, joints, and seams that will be permanently watertight and weather resistant.
  - 1. Install exposed flashing and trim that is without excessive oil-canning, buckling, and tool marks and that is true to line and levels indicated, with exposed edges folded back to form hems. Install sheet metal flashing and trim to fit substrates and to result in waterproof and weather-resistant performance.
  - 2. Expansion Provisions: Provide for thermal expansion of exposed flashing and trim. Space movement joints at a maximum of 10 feet with no joints allowed within 24 inches of corner or intersection. Where lapped or bayonet-type expansion provisions cannot be used or would not be sufficiently weather resistant and waterproof, form expansion joints of intermeshing hooked flanges, not less than 1 inch deep, filled with mastic sealant (concealed within joints).
- C. Gutters: Join sections with riveted-and-soldered or lapped-and-sealed joints. Attach gutters to eave with gutter hangers spaced as required for gutter size, but not more than 36 inches o.c. using manufacturer's standard fasteners. Provide end closures and seal watertight with sealant. Provide for thermal expansion.
- D. Downspouts: Join sections with 1-1/2-inch telescoping joints. Provide fasteners designed to hold downspouts securely 1 inch away from walls; locate fasteners at top and bottom and at approximately 60 inches o.c. in between.
  - 1. Provide elbows at base of downspouts to direct water away from building.
  - 2. Tie downspouts to underground drainage system indicated.
- E. Pipe Flashing: Form flashing around pipe penetration and metal roof panels. Fasten and seal to panel as recommended by manufacturer.

END OF SECTION 133419



## SECTION 230913 - INSTRUMENTATION AND CONTROL DEVICES FOR HVAC

### PART 1 - GENERAL

#### 1.1 SECTION INCLUDES

- A. Control panels.
- B. Control dampers.
- C. Operators.
- D. Flow measuring apparatus.
- E. Input/Output sensors and transmitters.
- F. Output control devices.
- G. Power Supplies.
- H. Thermostats.

#### 1.2 DEFINITIONS

- A. BAS: Building Automation System.
- B. Control Wiring: Includes conduit, wire and wiring devices to install complete control systems including motor control circuits, interlocks, thermostats, EP and IP switches and like devices. Includes all wiring from Intelligent Devices and Controllers to all sensors and points defined in the input/output summary shown on the drawings or specified herein and required to execute the sequence of operations
- C. Cv: Design Valve Flow Coefficient.
- D. DDC: Direct Digital Control.
- E. EPDM: Ethylene Propylene Diene Monomer.
- F. High voltage: 50 volts or higher.
- G. Low voltage: Below 50 volts.
- H. PTFE: Polytetrafluoroethylene.
- I. TEFZEL: A modified ETFE (ethylene tetrafluoroethylene) fluoroplastic.

### 1.3 CONTRACTOR RESPONSIBILITIES

- A. Reference Division 23 Section "Electrical Coordination for Mechanical Equipment" for contractor responsibilities.
- B. BAS Contractor:
  - 1. Installation of the BAS shall be by the BAS Contractor or his subcontractors.
  - 2. Low voltage control wiring.
  - 3. Coordinate high voltage control wiring to instrumentation and control devices with Division 26. Where high voltage power is required for instrumentation and control devices that is in addition to what is shown on the drawings, the BAS contractor shall cover the cost of providing this wiring.
  - 4. All interlock wiring regardless of voltage (e.g., exhaust fan interlocked to supply fan).
  - 5. Coordinate with Division 26 that motor starters are provided with auxiliary contacts as required for interlocks.
  - 6. Coordinate power wiring to BAS controllers and instrumentation and control devices with Division 26.
  - 7. Coordinate installation of back-box rough-in for wall-mounted control devices sensors, etc. with Division 26. Coordinate with mechanical contractor all locations, quantities, and sizes required for installation by Division 26.
- C. Sheet Metal Contractor:
  - 1. Installation of automatic control dampers, smoke control dampers, and necessary blank off plates.
  - 2. Access doors where and as required.
- D. Mechanical Contractor:
  - 1. Coordinate conduit and wall box rough-in, power wiring and magnetic starter requirements for controls and mechanical equipment with Division 26.

### 1.4 SUBMITTALS

- A. Refer to Division 01 for submittal procedures.
- B. Product Data: Provide description and engineering data for each control system component. Include dimensions, capacities, size, performance characteristics, electrical characteristics, and finishes of materials.
- C. Shop Drawings: Indicate complete operating data, system drawings, wiring diagrams, and written detailed operational description of sequences. Submit schedule of valves indicating size, flow, and pressure drop for each valve. For automatic dampers indicate arrangement, velocities, and static pressure drops for each system.
- D. Manufacturer's Instructions: Provide for all manufactured components.
- E. Operation and Maintenance Data: Include inspection period, cleaning methods, recommended cleaning materials, and calibration tolerances.
- F. Project Record Documents: Record actual locations of control components, including panels, thermostats, and sensors. Accurately record actual location of control components, including panels, thermostats, and sensors.

- G. Warranty: Submit manufacturer warranty and ensure forms have been filled out in Owner's name and registered with manufacturer.

## 1.5 QUALITY ASSURANCE

- A. Manufacturer Qualifications: Company specializing in manufacturing the Products specified in this section with minimum three years documented experience.
- B. Products Requiring Electrical Connection: Listed and classified by Underwriters Laboratories Inc., as suitable for the purpose specified and indicated.
- C. Measurement devices and sensors shall be calibrated using NIST traceable standards.

## 1.6 WARRANTY

- A. Correct defective Work within a one year period after Substantial Completion.
- B. Provide extended warranty for control devices and equipment as specified herein.

## PART 2 - PRODUCTS

### 2.1 CONTROL PANELS

- A. Construction:
  - 1. Panel shall be UL 508A listed.
  - 2. NEMA 250, general purpose utility enclosures with enameled finished face panel.
  - 3. NEMA 4X utility enclosure for outdoor or wash-down applications.
  - 4. Provide common keying for all panels.

### 2.2 CONTROL DAMPERS

- A. Dampers shall be factory fabricated and sized as shown on drawings and as specified.
- B. Individual damper sections shall not be larger than 48 inches x 60 inches. Provide a minimum of one damper actuator per section.
- C. Performance: Test in accordance with AMCA 500-D.
  - 1. Pressure Drop: Unless otherwise scheduled or indicated on the Drawings, size control dampers as follows:
    - a. Modulating Dampers: Provide dampers with linear flow characteristics. Size modulating dampers based on the smaller of the following.
      - 1) Maximum velocity of 1,500 feet per minute.
      - 2) Maximum Full-open air pressure drop of 0.1 inches W.C.
    - b. Two Position Dampers: Dampers shall be full duct size and selected to minimize pressure drop.
  - 2. Leakage:

City of Wentzville MO Public Works Facility

Wentzville, Missouri

PROJECT NO.: 19-040

- a. Motorized dampers shall not exceed 4.0 CFM/square foot in full closed position at 1 inch W.G. pressure differential across damper.
- D. Frames: Galvanized steel, extruded aluminum, or stainless steel, welded or riveted with corner reinforcement.
  - 1. Use minimum 16 gauge for rectangular dampers.
  - 2. Use minimum 20 gauge for round dampers.
  - 3. For aluminum frames, use 1/8 inch thick material.
  - 4. All damper frames shall have a flange for duct mounting.
  - 5. Reference Part 3 Execution for application of the material type.
- E. Blades: Galvanized steel, extruded aluminum, or stainless steel, maximum blade size 6 inches wide, 48 inches long, attached to minimum 1/2 inch shafts with set screws.
  - 1. Use minimum 16 gauge for rectangular dampers.
  - 2. Use minimum 16 gauge for round dampers.
  - 3. For aluminum blades, use 1/8 inch thick material.
  - 4. The blades shall be suitable for the air velocities to be encountered in the system.
  - 5. Dampers longer than the maximum blade length shall be fabricated in sections.
  - 6. Reference Part 3 Execution for application of the material type.
- F. Blade Seals: Synthetic elastomeric inflatable or Neoprene, mechanically attached, field replaceable.
  - 1. Installed along the top and bottom of the frame and on all mating surfaces.
- G. Jamb Seals: Spring stainless steel.
  - 1. Installed inside the frame sides.
- H. Shaft Bearings: One of the following as recommended by manufacturer for the application:
  - 1. Oil impregnated sintered bronze.
  - 2. Graphite impregnated nylon sleeve with thrust washers at bearings.
  - 3. Lubricant free, stainless steel, single row, ground, flanged, radial, antifriction type with extended inner race.
  - 4. Molded synthetic bearings.
- I. Linkage Bearings: One of the following as recommended by manufacturer for the application:
  - 1. Oil impregnated sintered bronze
  - 2. Graphite impregnated nylon.
- J. Maximum Pressure Differential: 6 inches wg.
- K. Temperature Limits: -40 to 200 degrees F.
- L. Manufacturers:
  - 1. Greenheck.
  - 2. CESCO.
  - 3. Pottorff.
  - 4. Nailor.

5. Ruskin.

M. Reference the Damper Schedule in Part 3 for basis of design damper model and material for the application.

## 2.3 OPERATORS

A. General:

1. Voltage: Voltage selection shall be as required to achieve the required torque for the application.
  - a. Reference Part 3 for Damper Operator Voltage Schedule.
2. Type: Motor operated, with or without gears. Motor type shall be continuous duty.
3. Construction:
  - a. For Actuators Less Than 100 W: Fiber or reinforced nylon gears with steel shaft, copper alloy or nylon bearings, and pressed steel enclosures.
  - b. For Actuators from 100 to 400 W: Gears ground steel, oil immersed, shaft hardened steel running in bronze, copper alloy or ball bearings. Operator and gear trains shall be totally enclosed in dustproof cast-iron, cast-steel or cast-aluminum housing.
  - c. For Actuators Larger Than 400 W: Totally enclosed reversible induction motors with auxiliary hand crank and permanently lubricated bearings.
4. Field Adjustment:
  - a. Spring Return Actuators: Easily switchable from fail open to fail closed in the field without replacement.
  - b. Gear Type Actuators: External manual adjustment mechanism to allow manual positioning when the actuator is not powered.
5. Two-Position Actuators: Single direction, spring return or reversing type. End-switches shall be integral to the actuator to determine actuator status.
6. Modulating Actuators:
  - a. Operation: Capable of stopping at all points across full range, and starting in either direction from any point in range.
  - b. Control Input Signal:
    - 1) Three Point, Tristate, or Floating Point: Clockwise and counter-clockwise inputs. One input drives actuator to open position and other input drives actuator to close position. No signal of either input remains in last position.
    - 2) Proportional: Actuator drives proportional to input signal and modulates throughout its angle of rotation. Suitable for zero- to 10-Vdc or 2- to 10-Vdc and 4- to 20-mA signals.
    - 3) Pulse Width Modulation (PWM): Actuator drives to a specified position according to pulse duration (length) of signal from a dry contact closure, triac sink, or source controller.
  - c. Programmable Multi-Function:
    - 1) Control Input, Position Feedback, and Running Time: Factory or field programmable.
    - 2) Diagnostic: Feedback of hunting or oscillation, mechanical overload, mechanical travel, and mechanical load limit.
    - 3) Service Data: Include, at a minimum, number of hours powered and number of hours in motion.
7. Position Feedback:
  - a. Where indicated on the controls drawings, equip two-position actuators with limits switches or other positive means of a position indication signal for remote monitoring of open and close position.
  - b. Where indicated on the controls drawings, equip modulating actuators with a position feedback through current or voltage signal for remote monitoring.
  - c. Actuator shall contain position indicator and graduated scale indicating open and closed travel limits.

8. Integral Overload Protection:
  - a. Provide against overload throughout the entire operating range in both directions.
  - b. Electronic overload, digital rotation sensing circuitry, mechanical end switches, or magnetic clutches are acceptable methods of protection.
9. Attachment:
  - a. Unless otherwise required for valve interface, provide an actuator designed to be directly coupled to device without the need for connecting linkages.
  - b. Attach actuator to device drive shaft in a way that ensures maximum transfer of power and torque without slippage.
10. Temperature and Humidity:
  - a. Temperature: Suitable for operating temperature range encountered by application.
  - b. Humidity: Suitable for humidity range encountered by application, non-condensing.
11. Enclosure:
  - a. Suitable for ambient conditions encountered by application.
  - b. NEMA 4 for indoor wash-down or wet locations.
  - c. NEMA 4X, Belimo ZS-300, or equivalent; for outdoor applications.
12. Stroke Time:
  - a. Coordinate with stroke time indicated on the control drawings.
  - b. Unless otherwise noted, select operating speed to be compatible with equipment and system operation.

B. Damper Operators:

1. Controls contractor shall size damper operator.
2. Sizing: Provide smooth proportional control with sufficient power for air velocities 20 percent greater than maximum design velocity and to provide tight seal against maximum system pressures. Provide spring return for two position control and for fail safe operation.
  - a. Provide sufficient number of operators to achieve unrestricted movement throughout damper range.
  - b. Provide one operator for maximum 20 sq ft damper section or maximum 7 in-lb/sq ft damper area.
3. Fail Positions:
  - a. Spring return to normal position as indicated on freeze, fire, temperature, or loss of power protection. Normal positions are indicated on the control drawings.
    - 1) Return air damper, normally open.
    - 2) Outside air damper, normally closed.
    - 3) Exhaust/Relief air damper, normally closed.
  - b. Operator shall fail in place for all other applications not listed under spring return.

C. Manufacturers:

1. Damper Operators:
  - a. Belimo.
  - b. Honeywell.
  - c. Johnson Controls.
  - d. Schneider Electric (Invensys).
  - e. Siemens.

## 2.4 FLOW MEASURING APPARATUS

A. Airflow Measuring Stations

1. Sensor quantity and spacing shall comply with the Equal-Area or Log-Tchebycheff method as defined in the ASHRAE Handbook of Fundamentals.
2. Element Construction: Non-corrosive material such as stainless steel, aluminum, or cadmium-plated.
3. Stations and insertion elements utilizing thermal dispersion technology shall utilize hermetically sealed thermistors for each sensor and shall be factory calibrated to NIST traceable standards.
4. Stations and insertion elements using velocity pressure shall be tested and certified in accordance with AMCA 611.
5. Air Inlet Measuring Stations:
  - a. Intended for location within an air inlet to equipment, such as a hood or louver.
  - b. The air inlet measuring station shall utilize the uniform static differential pressure field created by air moving across a fixed inlet that has a factory calibrated and AMCA certified flow equation. The system shall use the actual air stream temperature and absolute pressure to provide Actual and Standardized instantaneous airflow rate information.
  - c. Transmitter:
    - 1) The transmitter shall be housed in a NEMA 1 enclosure with an integral graphic display and keypad for use during the configuration and field characterization process. The display shall be configurable to indicate four measured process variables (volume, velocity, temperature, pressure) during normal operation.
    - 2) The transmitter shall utilize a pair of stacked transducers for each channel.
    - 3) The transmitter shall incorporate an absolute pressure sensing system in order to provide automatic airflow compensation at the installed elevation.
    - 4) The transmitter shall incorporate temperature sensor input(s) as required to perform continuous airflow density compensation for each channel.
    - 5) The Transmitter shall provide BACnet MS/TP (MODBUS RTU) and four field configurable analog outputs designed to interface with the building automation system (BAS). The ability to perform configuration changes and field characterization shall be accomplished via the user interface/display, the need for additional utility software shall not be required.
  - d. Elements:
    - 1) Element constructed of 316 stainless steel, factory mounted in a circular puck constructed of 14 gauge galvanized steel. Housing shall meet NEMA 1.
    - 2) Element shall not induce a measurable pressure drop, adversely affect fan performance or amplify the sound level within the fan system by its presence in the airstream.
    - 3) Element shall not be affected by the presence of moisture, dirt, or debris in the airstream and shall be unaffected by gusting wind.
    - 4) Density corrected for ambient temperature variances and atmospheric pressure due to altitude.
  - e. Range: Minimum 100 to 2,400 fpm.
  - f. Accuracy: Plus/minus 5.0 percent of reading within the calibrated airflow range.
  - g. Manufacturers:
    - 1) Air Monitor Corporation.
    - 2) Approved equal.
6. Signal Processor:
  - a. Microprocessor-based, field programmable, capable of local display of the measured airflow rate.
  - b. Factory calibrated to NIST traceable standards.
  - c. Accuracy: 0.1 percent of full scale, including linearity, hysteresis, dead band, and repeatability.
  - d. Output: 0 to 10 Vdc or 4-20 mA scaled output signal for remote monitoring.

## 2.5 INPUT/OUTPUT SENSORS AND TRANSMITTERS

### A. General:

1. Performance Requirements:
  - a. Device must be compatible with project DDC controllers.
  - b. Elements used shall be general-purpose type.
  - c. Provide transmitters or transducers with sensors as required, with range suitable for the system encountered.
    - 1) Transmitters and transducers shall have offset and span adjustments.
    - 2) Shock and vibration shall not harm the transmitter or transducer.
    - 3) Transmitters and transducers shall have a zeroing capability of readjusting the transmitter zero.
  - d. Accuracy requirements shall include the combined effects of linearity, hysteresis, repeatability, and the transmitter.
2. Output: Linear, proportional type over shielded cable pair, 4 - 20 mA or 0 – 10 Vdc signal.
3. Input Power: Low voltage, nominal 24 Vdc.

B. Temperature Sensors:

1. Use thermistor or RTD type temperature sensing elements with characteristics resistant to moisture, vibration, and other conditions consistent with the application without affecting accuracy and life expectancy. Sensor shall be UL 873 listed for temperature equipment.
2. Performance Requirements:
  - a. Thermistor:
    - 1) Accuracy (All): Plus/minus 0.36 degrees F minimum.
    - 2) Temperature Differential Accuracy: Plus/minus 0.15 degrees F minimum.
    - 3) Resolution: Plus/minus 0.2 degrees F minimum.
    - 4) Heat Dissipation Constant: 2.7 mW per degree C.
    - 5) Drift: 0.04 degree F after 10 years within temperature range.
  - b. RTD:
    - 1) Construct RTD of nickel or platinum with base resistance of 1000 ohms at 70 degrees F. 100 ohm platinum RTD is acceptable if used with project DDC controllers.
    - 2) Accuracy (All): Plus/minus 1 degree F minimum, unless otherwise noted below.
      - a) Room Sensor Accuracy: Plus/minus 0.5 degrees F minimum.
      - b) Chilled Water Accuracy: Plus/minus 0.5 degrees F minimum.
      - c) Temperature Differential Accuracy: Plus/minus 0.15 degrees F minimum.
    - 3) Resolution: Plus/minus 0.2 degree F.
    - 4) Drift: 0.04 degrees F after 10 years within temperature range.
  - c. Sensing Range:
    - 1) Provide limited range sensors if required to sense the range expected for a respective point.
    - 2) Use RTD type sensors for extended ranges beyond minus 30 degrees F to 230 degrees F.
  - d. Wire Resistance:
    - 1) Use appropriate wire size to limit temperature offset due to wire resistance to 1.0 degree F or use temperature transmitter when offset is greater than 1.0 degree F due to wire resistance.
    - 2) Compensate for wire resistance in software input definition when feature is available in the DDC controller.
3. Outside Air Sensors: Watertight inlet fitting shielded from direct rays of the sun.
4. Room Temperature Sensors:
  - a. Construct for surface or wall box, or enclosure with insulated backing suitable for exterior wall mounting.
  - b. Provide the following features:
    - 1) Setpoint reset slide switch, dial wheel, or push-button interface with an adjustable temperature range.



- 2) Momentary override request push button for activation of after-hours operation.
    - 3) Locking cover where noted on the drawings.
  5. Temperature Averaging Elements:
    - a. Use on duct sensors for ductwork 10 sq ft or larger.
    - b. Use averaging elements where prone to stratification with sensor length range between 16-22 ft.
    - c. Provide for all mixed air and heating coil discharge sensors regardless of duct size.
  6. Insertion Elements:
    - a. Use in ducts not affected by temperature stratification or smaller than 10 sq ft.
    - b. Provide dry type, insertion elements for liquids, installed in immersion wells, with minimum insertion length of 2.5 inches for pipe sizes greater than 4 inches.
    - c. Immersion Well Housing: 1/2 inch NPT brass or stainless steel. Stainless steel required for piping 6 inch and larger.
- C. Humidity Sensors:
1. Elements: Accurate within 3 percent full range with linear output.
    - a. Accuracy shall include temperature effects.
  2. Resolution: Plus/minus 1 percent.
  3. Drift: Less than 1 percent full scale per year.
  4. Sensing Range: 0 to 100 percent relative humidity.
  5. Duct Sensors: Insertion type probe with mounting plate. Housing shall be metal, NEMA 250, Type 1.
  6. Outside Air Sensors: With element guard and mounting plate.
- D. Pressure Transmitters:
1. Duct Static Pressure:
    - a. Type: Unidirectional, fixed range.
    - a. Performance Characteristics:
      - 1) Accuracy: Plus/minus one percent of full scale.
      - 2) Thermal Effects: Temperature compensated over a minimum 40 to 120 F range. Zero and span shift of plus/minus 0.06 percent or less of full scale per degree F.
      - 3) Sensing Range: Select sensor so that the high end of the nominal sensor range is not less than 150 percent and not more than 300 percent of maximum expected input.
      - 4) Long Term Thermal Stability: Plus/minus one percent full scale per year.
    - b. Construction:
      - 1) Insertion or traverse type sensor suitable for use in flat oval, rectangular, and round duct configurations.
      - 2) Insertion length selected as appropriate for duct size.
      - 3) Traverse sensors shall have at least one pickup point every 6 inches.
      - 4) Element: Variable capacitance sensing technology.
      - 5) Housing: Fire retardant glass-filled polyester, brass, stainless steel, or aluminum.
  2. Space Static Pressure:
    - a. Type: Bi-directional, fixed range.
    - b. Performance Characteristics:
      - 1) Accuracy: Plus/minus 0.5 percent of full scale.
      - 2) Thermal Effects: Temperature compensated over a minimum 40 to 120 F range. Zero and span shift of plus/minus 0.06 percent or less of full scale per degree F.
      - 3) Sensing Range: Select sensor so that the high end of the nominal sensor range is not less than 150 percent and not more than 300 percent of maximum expected input.
      - 4) Long Term Thermal Stability: Plus/minus 0.5 percent full scale per year.
    - c. Construction:

- 1) Sensing Port Wall Mounting: Wall plate with integral sensor, sized to fit standard single gang electrical box. Back of sensor plate fitted with union fitting for tubing connection.
  - 2) Sensing Port Ceiling Mounting: Round plate with union fitting for tubing connection.
  - 3) Sensor Element: Variable capacitance sensor technology.
  - 4) Sensor Housing: Fire retardant glass-filled polyester, brass, stainless steel, or aluminum.
- d. Construction:
- 1) Suitable for the media temperature and pressure.
  - 2) Element: Diaphragm type, stainless steel.
  - 3) Housing: Fire retardant glass-filled polyester, stainless steel, or aluminum.

E. Equipment Operation Sensors:

1. Status Inputs for Electric Motors:
  - a. Analog Current Transducer:
    - 1) Type: Split core design, cable of being installed or removed without dismantling the primary bus cables.
    - 2) Performance Characteristics:
      - a) Accuracy: Plus/minus 2 percent of selected range.
      - b) Range: Multi-range device, suitable for the amperage encountered with internal zero and span adjustment.
    - 3) Construction:
      - a) 24 V or Self-powered.
      - b) Provide with integral command relay.
      - c) Device shall accept overcurrent up to twice its trip into range.
      - d) Enclosure: UL 94 approved thermoplastic, rated for V-0. No metal parts shall be exposed other than the terminals.
  - b. Binary Current Sensing Relay:
    - 1) Type: Split core with current transformers, adjustable and set to 175 percent of rated motor current.
    - 2) Self-powered with solid-state circuitry and a dry contact output.
    - 3) Adjustable trip point.
    - 4) Contact Type: Single-pole, double-throw (SPDT).
    - 5) LED indicating the on or off status.
    - 6) A conductor of the load shall be passed through the window of the device.
    - 7) Device shall accept overcurrent up to twice its trip into range.

F. Carbon Monoxide Detectors:

1. Carbon monoxide detectors located within the fleet maintenance building shall be provided as part of the Vehicle Emission Monitoring System. Refer to specification 230915 for more information on these devices.
2. Factory calibrated, single or multichannel dual level detectors, using solid state sensors with three year minimum life. Sensor replacement shall take maximum 15 minutes. Suitable over temperature range of 23 to 130 degrees F.
3. Provide individual indicators and contractors for each level, initially calibrated for 25 ppm and 200 ppm.
4. Maximum response time to 100 ppm CO calibration gas: Two minutes.
5. Accuracy: Plus/minus 5 ppm or plus/minus 5 percent of reading, whichever is lower.
6. Drift: Certified by manufacturer to drift no more than 5 percent per year.
7. Calibration: Certified by manufacturer to require calibration no more frequently than once per year.

G. Nitrogen Dioxide Sensors:

1. Nitrogen dioxide sensors located within the fleet maintenance building shall be provided as part of the Vehicle Emission Monitoring System. Refer to specification 230915 for more information on these devices.
2. Single or multichannel dual level detectors, using solid state sensors with three year minimum life. Sensor replacement shall take maximum 15 minutes. Suitable over temperature range of 23 to 130 degrees F.
3. Provide individual indicators and contractors for each level, initially calibrated for 1 ppm and 3 ppm.
4. Accuracy: Plus/minus 5 percent of reading.

## 2.6 OUTPUT CONTROL DEVICES

### A. Control Relays:

1. Provide relay with contact rating, configuration, and coil voltage that is suitable for the application.
2. Provide NEMA 1 enclosure when relay is not installed in a local control panel.
3. Control relays shall be UL listed plug-in type with dust cover and LED "energized" indicator.
4. Time delay relays shall be UL listed solid-state plug-in type with adjustable time delay. Delay shall be adjustable plus/minus 200 percent minimum from setpoint.

### B. Fan Speed Controllers:

1. Solid-state model providing field-adjustable proportional control of motor speed. Equip with filtered circuit to eliminate radio interference.

## 2.7 POWER SUPPLIES

- A. Reference Division 23 Section "Direct Digital Controls for HVAC" for DC power supply requirements.
- B. Control power transformers shall meet NEMA/ANSI standards.
- C. Control power transformers shall be UL listed for Class 2 current-limited service or provided with over-current protection on both primary and secondary circuits for Class 2 current-limited service.
- D. Connected load on the transformer shall not exceed 80 percent of the transformer's rated capacity.
- E. The core and windings shall be completely encased in a UL approved thermoplastic. No metal parts shall be exposed other than the terminals.
- F. Performance Characteristics:
  1. Accuracy: Plus/minus 1 percent at 5.0 A full scale output.
- G. Provide a disconnect switch for each transformer.

## 2.8 THERMOSTATS

### A. General:

1. Non-programmable with the following features:

- a. Button or touch-screen Interface:
      - 1) Temperature information display.
      - 2) Setpoint display and adjust.
    - b. Override.
    - c. Lockout.
  - 2. Performance Requirements:
    - a. Accuracy: Plus/minus 1.0 degree F minimum.
    - b. Resolution: Plus/minus 0.2 degrees F.
    - c. Range:
      - 1) Operating Temperature: 32 degrees F to 122 degrees F minimum.
      - 2) Operating Humidity: 0 percent to 95 percent relative humidity, non-condensing.
      - 3) Setpoint Control:
        - a) Cooling: 54 degrees to 100 degrees F.
        - b) Heating: 40 degrees to 90 degrees F.
    - d. Multi-stage as required to match unit cooling and heating stages scheduled on the drawings.
- B. Line Voltage Thermostats:
- 1. Integral manual On/Off/Auto selector switch, single or two pole as required.
  - 2. Dead band: Maximum 2 degrees F.
  - 3. Covers: Locking with set point adjustment and indication.
  - 4. Setpoint functional range: 45 degrees F to 90 degrees F.
  - 5. Rating: Motor load.
- C. Room Thermostat Accessories:
- 1. Thermostat Covers: Plastic.
  - 2. Insulating Bases: For thermostats located on exterior walls.
  - 3. Thermostat Guards: Locking transparent plastic mounted on separate base.
  - 4. Adjusting Key: As required for device.
  - 5. Aspirating Boxes: Where indicated for thermostats requiring flush installation.

## PART 3 - EXECUTION

### 3.1 EXAMINATION

- A. Verify existing conditions before starting work.
- B. Verify that systems are ready to receive work.
- C. Beginning of installation means installer accepts existing conditions.
- D. Sequence work to ensure installation of components is complementary to installation of similar components in other systems.
- E. Coordinate installation of system components with installation of mechanical systems equipment such as air handling units and air terminal units.

### 3.2 INSTALLATION

- A. Cooperate with other contractors performing work on this project as necessary to achieve a complete and coordinated installation. Each Contractor shall consult the Drawings and Specifications for all trades to determine the nature and extent of others work.
- B. General Workmanship:
  - 1. Install equipment, piping, and wiring/raceway parallel to building lines wherever possible.
  - 2. Provide sufficient slack and flexible connections to allow for vibration of piping and equipment.
  - 3. Install all equipment in readily accessible locations.
  - 4. All installations shall comply with industry specifications and standards for performance, reliability, and compatibility and be executed in strict adherence to local codes and standard practices.
  - 5. Install all products in accordance with manufacturer's instructions.
- C. Sensors:
  - 1. Mount sensors rigidly and adequately for the environment within which the sensor operates.
  - 2. Room temperature sensors shall be installed on concealed junction boxes properly supported by the wall framing.
  - 3. All wires attached to sensors shall be air sealed in their raceways or in the wall to stop air transmitted from other areas affecting sensor readings.
  - 4. Sensors used in mixing plenums and hot and cold decks shall be of averaging type. Averaging sensors shall be installed in a serpentine manner vertically across the duct. Each bend shall be supported with a capillary clip.
  - 5. Do not install temperature sensors within the vapor plume of a humidifier. If installing a sensor downstream of a humidifier, install it at least 10 feet downstream.
  - 6. Install temperature, humidity, and smoke detectors for both supply air and return air applications a minimum of 10'-0" downstream or upstream of the air handling unit and prior to any branch duct takeoffs.
  - 7. Install outdoor air temperature sensors on north wall, complete with sun shield where shown on the plans. If not shown, locate sensors in an accessible location, a minimum of 15 feet away from exhaust or relief air locations.
  - 8. Differential air static pressure.
    - a. Supply Duct Static Pressure: Pipe the high-pressure tap to the duct using a pitot tube. Pipe the low-pressure port to a tee in the high-pressure tap tubing of the corresponding building static pressure sensor (if applicable) or to the location of the duct high-pressure tap and leave open to the plenum.
    - b. Building Static Pressure: Pipe the low-pressure port of the pressure sensor to the static pressure port located on the outside of the building. Pipe the high-pressure port to a location suitable to sense common building pressure or as indicated on the drawings.
      - 1) Panel mount the transducer adjacent to its associated building automation system controller. Provide an independent manometer gauge next to transducer for calibration.
    - c. The piping to the pressure ports on all pressure transducers shall contain a capped test port located adjacent to the transducer.
    - d. All pressure transducers, other than those controlling VAV boxes, shall be located in field device panels, not on the equipment monitored or on ductwork. Mount transducers in a location accessible for service without use of ladders or special equipment.
    - e. All air and water differential pressure sensors shall have gauge tees mounted adjacent to the taps. Water gauges shall also have shutoff valves installed before the tee.

9. Check and verify location of thermostats, humidistats, and exposed control sensors with plans and room details before installation. Locate 48 inches above floor. Align with adjacent lighting switches and humidistats.
  - a. Install devices to meet ADA requirements unless otherwise noted on the plans.
10. Mount outdoor reset thermostats and outdoor sensors indoors, with sensing elements outdoors with sun shield.
11. Provide separable sockets for liquids and flanges for air bulb elements.
12. Provide thermostats in aspirating boxes in areas where flush mounting is required.
13. Provide guards on thermostats in areas indicated on the drawings.
14. Calibrate each instrument installed that is not factory calibrated and provided with calibration documentation.

D. Control Dampers:

1. Install dampers with extruded aluminum or stainless steel frames and blades in corrosive environments and areas with high humidity.
2. Install smooth transitions, not exceeding 30 degrees, to dampers smaller than adjacent duct. Install transitions as close to damper as possible but at distance to avoid interference and impact to performance. Consult manufacturer for recommended clearance.
3. Clearance:
  - a. Locate dampers for easy access and provide separate support of dampers that cannot be handled by service personnel without hoisting mechanism.
  - b. Install dampers with at least 24 inches of clear space on sides of dampers requiring service access.
4. Service Access:
  - a. Dampers and actuators shall be accessible for visual inspection and service.
  - b. Install access door(s) in duct or equipment located upstream of damper to allow service personnel to hand clean any portion of damper, linkage, and actuator. Comply with requirements in Division 23 Section, "Air Duct Accessories."
5. Duct openings shall be free of any obstruction or irregularities that might interfere with blade or linkage rotation or actuator mounting.
6. Install dampers straight and true, level in all planes, and square in all dimensions. Install supplementary structural steel reinforcement for large multiple-section dampers if factory support alone cannot handle loading.
7. Provide mixing dampers of parallel blade construction arranged to mix streams. Where shown on the drawings, provide separate minimum outside air damper section adjacent to return air dampers with separate damper motor.
8. Provide isolation (two position) dampers of parallel blade construction.
9. Provide opposed blade damper configuration for all other applications.
10. Install damper motors on outside of duct in warm areas. Do not install motors in locations at outdoor temperatures.
11. After installation of low-leakage dampers and seals, caulk between frame and duct or opening to prevent leakage around perimeter of damper.

E. Operators:

1. Mount and link control damper actuators according to manufacturer's instructions.
  - a. To compress seals when spring-return actuators are used on normally closed dampers, power actuator to approximately 5 degrees open position, manually close the damper, and then tighten the linkage.
  - b. Check operation of damper/actuator combination to confirm that actuator modulates damper smoothly throughout stroke to both open and closed positions.
  - c. Provide all mounting hardware and linkages for actuator installation.

2. Dampers: Actuators shall be direct-mounted on damper shaft or jackshaft unless shown as a linkage installation. For low-leakage dampers with seals, the actuator shall be mounted with a minimum 5 degree available for tightening the damper seals.

F. Control Panels:

1. Install control panels where shown on the drawings and where required to house controllers for the controlled systems and equipment.
  2. Mount control panels adjacent to associated equipment on vibration free walls or free standing angle iron supports. One cabinet may accommodate more than one system in same equipment room. Provide engraved plastic nameplates for instruments and controls inside cabinet and engraved plastic nameplates on cabinet face.
  3. Coordinate 120V power requirements with Division 26 to panels used for the building automation system and transformers for low voltage power to controllers.
- G. Install "hand/off/auto" selector switches to override automatic interlock controls when switch is in "hand" position.
- H. Provide an insulation standoff on control devices, cables, and other items that do not require flush mounting to ductwork, piping, or equipment.

### 3.3 MAINTENANCE

- A. Refer to Division 01 closeout requirements for additional requirements relating to maintenance service.
- B. Provide service and maintenance of control system for one year from Date of Substantial Completion.
- C. Provide complete service of controls systems, including call backs, and submit written report of each service call.

### 3.4 STARTUP AND DEMONSTRATION

A. Control Dampers:

1. Stroke and adjust control dampers following manufacturer's recommended procedure, from 100 percent open to 100 percent closed back to 100 percent open.
2. Check and document open and close cycle times for applications with a cycle time of less than 30 seconds.
3. For control dampers equipped with positive position indication, check feedback signal at multiple positions to confirm proper position indication.
4. Verify that all two-position dampers operate properly and that the normal positions are correct.
5. Verify that all modulating dampers are functional, that the start and span are correct, that direction and normal positions are correct, and that they achieve proper closure.

### 3.5 DAMPER SCHEDULE

<u>SERVICE</u>	<u>RUSKIN MODEL</u>	<u>MATERIAL</u>
Outside Air Control	CD-50	Aluminum
Corrosive Environments	CD-35	Aluminum or Stainless steel

All Other                                      CD-35      Galvanized Steel

3.6 DAMPER OPERATOR VOLTAGE SCHEDULE

<u>SERVICE</u>	<u>VOLTAGE</u>
Interlocked with HVAC fans	120V
Multi-section dampers	120V
Large dampers (> 60 inches in any dimension)	120V
All other operators control wiring	24V
1. Note: Coordinate with Division 26 if 120V power is required for operator to achieve appropriate torque requirements for damper actuation.	

END OF SECTION 230913



## SECTION 235500 - FUEL FIRED HEATERS

### PART 1 - GENERAL REQUIREMENTS

#### 1.1 SUMMARY

- A. This Section includes the following:
  - 1. Gas-fired unit heaters
  - 2. High-Intensity, Gas-Fired, Radiant Heaters
- B. Related Sections: The following Sections contain requirements that relate to this Section:
  - 1. Division 22 Section "Natural Gas Systems" for natural gas equipment connection requirements.
  - 2. Division 23 Sections for breechings, temperature controls, and other mechanical equipment not specified in this Section, but required for a complete installation.
  - 3. Division 26 Sections for electrical work including motor starters, disconnects, wires/cables, raceways, and other electrical equipment devices not specified in this Section, but required for a complete installation.

#### 1.2 SUBMITTALS

- A. General: Submit the following in accordance with Division 1 and Division 23 Section "Common Work Results for HVAC".
  - 1. Product data including weights, dimensions, metal gages, and data on features and components. Include plan and elevation views of units, minimum clearances, data on ratings and capacities and installation instructions.
  - 2. Maintenance data for products for inclusion in "Operating and Maintenance Manual" specified in Division 1.
  - 3. Wiring diagrams from manufacturers detailing requirements for electrical power and control wiring for heaters. Include ladder-type wiring diagrams for interlock and control wiring required for field installation. Differentiate between portions of wiring that are factory installed and portions that are to be field installed.

#### 1.3 QUALITY ASSURANCE

- A. Comply with NFPA 70, "National Electrical Code."

#### 1.4 SPARE PARTS

- A. General: Furnish spare parts matching products installed, as described below, packaged with protective covering for storage, and identified with labels clearly describing contents.
  - 1. Infrared Heat Igniter: 4 hot-surface burner igniters.

#### PART 2 - PRODUCTS AND MATERIALS

##### 2.1 MANUFACTURERS

- A. Manufacturers: Subject to compliance with requirements, provide products by the following:
  - 1. Unit Heaters, Gas, Propeller Fan:
    - a. Dunham-Bush, Inc.
    - b. Hartzell Fan, Inc.
    - c. Hastings Industries, Inc.
    - d. Lennox Industries, Inc.
    - e. Modine Mfg. Co.
    - f. Rapid Engineering
    - g. Reznor.
    - h. Sterling Heating Equipment Div.
    - i. The Trane Co.
  - 2. High-Intensity, Gas, Infrared Heaters:
    - a. Detroit Radiant
    - b. Modine
    - c. Perfection-Schwank, Inc.
    - d. Reznor.
    - e. Roberts-Gordon, Inc.
    - f. Solaronics, Inc.
    - g. Space-Ray Div.
    - h. Superior Radiant Products.

##### 2.2 FUEL-FIRED HEATERS, GENERAL

- A. Types, Minimum Ratings, Locations, and Mountings: As indicated.
  - 1. Gas-Fired Heaters and Accessory Items: NFPA 54, "National Fuel Gas Code."
    - a. AGA Approval: Heaters design certified and labeled by the American Gas Association.
    - b. Type of Gas: Heaters designed and built to burn natural gas with characteristics the same as those of the gas available at the Project site.
- B. Assembly and Wiring: Heaters factory assembled, piped, wired, and tested.

- C. Heater Electrical Rating: 115 V a.c. except as otherwise indicated.
- D. Propeller Fans: Factory-balanced, resilient-mounted, with aluminum blades and 100-percent steel blade guard.
- E. Motors: Totally enclosed with internal thermal overload protection and complying with Division 15 Section "Motors," except as otherwise indicated.
  - 1. Heater Motors: Energy efficient types as defined in Division 23 section "Common Motor Requirements for HVAC Equipment."
- F. Concentric Terminal Vent Assembly: Combined combustion air inlet and power vent outlet. Include adapter assembly for connection to inlet and outlet pipes, and flanges for wall penetration.
- G. Control Transformer: Integrally mounted. 120 V a.c./24 V a.c.

### 2.3 GAS-FIRED UNIT HEATERS, HIGH EFFICIENCY

- A. General: Comply with ANSI Z83.8, "Gas Unit Heaters."
- B. Housing: Steel, with integral motorized vent exhauster and inserts for suspension mounting rods.
- C. Ignition: Electronically controlled spark with flame sensor.
- D. Burners: Cast iron or aluminized steel.
- E. Automatic Fan Thermal Switch: Delays fan start until discharge air is heated. Delays fan shutdown until air cools to comfort threshold.
- F. Heat Exchanger: Stainless steel.
- G. Unit Fan Type: Propeller.
- H. Automatic Gas Control: Two-stage, 24 V a.c. valve.
- I. Separated Combustion Air Supply: Combustion and heat exchange chambers isolated from heated space atmosphere.

- J. Discharge Louvers: Independently adjustable horizontal blades.

## 2.4 HIGH INTENSITY GAS INFRARED HEATERS

- A. General: Comply with ANSI Z83.19A, "Gas Fired High Intensity Infrared Heaters." and ANSI/NFPA 88B "Standard for Repair Garages".
- B. Electric Ignition: 115 V a.c. rating.
- C. Main Housing: Continuous, one-piece, aluminized-steel unit without gaps between housing and reflectors.
- D. Burner Assembly: Modular, aluminized steel with powder-coat or similar finish plenum chamber secured with stainless steel retainers.
- E. Emitter: Perforated ceramic tiles.
- F. Reflector: Polished aluminum, 97 percent minimum reflectivity.
- G. Parabolic Reflector: Same material as reflectors
- H. Connections to External Piping, Tubing, Vents, or Ducts: Flexible units, AGA-approved for the purpose.
- I. Heater Type: Gravity vented, power burner.
- J. Burner/Ignition: Direct Spark, solid-state ignition module with spark electrode and flame sensor.
- K. Control:
  - 1. External thermostat: Two-stage, wall-mounted type with 40 to 90 deg F operating range and fan on switch.
  - 2. Integrally mounted control transformer.
- L. Accessories:
  - 1. Protective screen and heat-deflector shield.
  - 2. Stainless-steel flexible connector with manual valve for gas supply.
  - 3. Hanger chain with "S" hooks.
  - 4. Preassembled chain suspension kit.

5. Rigid mounting kits.
6. Clearance warning plaque.
7. Two-stage operation.

## 2.5 TEMPERATURE CONTROL

- A. Wires and cables are specified in Division 26.
- B. Thermostats and Components: Specified in other Division 23 sections.

## 2.6 FINISHES

- A. External Casings and Cabinets: Baked enamel over corrosion-resistant treated surface.

## PART 3 - EXECUTION

### 3.1 INSTALLATION AND CONNECTION

- A. Installation and connection of gas-fired heaters and associated fuel and vent features and systems installed and connected in accordance with NFPA 54, applicable local codes and regulations, and manufacturer's printed installation instructions.
  1. Connect gas piping to furnace according to requirements of Division 22 Section "Natural Gas Systems." Provide union with sufficient clearance for burner removal and service.
  2. Connect vents in accordance with Division 23 Section "Breechings, Chimneys and Stacks."
- B. Suspended Units: Suspend from substrate using threaded rods, spring hangers, and building attachments. Secure rods to unit hanger attachments. Adjust hangers so unit is plumb and level.
  1. Spring hangers are specified in Division 23 section "Vibration Isolation for HVAC Piping and Equipment."
- C. Controls: Wiring and connections are specified in Division 26.
- D. Maintain manufacturer's recommended clearance for combustibles.
- E. Install controls as specified in Division 23 Controls section.

### 3.2 IDENTIFICATION

- A. Identify heaters and connections in accordance with Division 23 section "Identification for HVAC Piping and Equipment."

### 3.3 STARTUP

- A. Test functions, operations, and control sequences and protective features. Adjust to assure operation is in accordance with design.
- B. Correct deficiencies identified by tests and observations and retest until specified requirements are met.

### 3.4 CLEANING AND ADJUSTING

- A. Cleaning: Upon completion of installation, inspect heaters and associated components. Remove paint splatters and other spots, dirt, and debris. Touch up scratches and mars of finish to match original finish. Clean unit internally using methods and materials recommended by manufacturer.
- B. Adjusting: Make burner and other unit adjustments for optimum heating performance and efficiency. Adjust heat distribution features, including louvers, vanes, shutters, dampers, and reflectors, to provide optimum heat distribution for objects, personnel, and spaces served.

### 3.5 TRAINING

- A. General: At a time mutually agreed upon between the Construction Manager, Commissioning Agent, and Engineer, provide the services of a factory trained and authorized representative to train Construction Manager, Commissioning Agent, and Engineer for a minimum of two hours on the operation and maintenance of the equipment provided under this section.
- B. Content: Training shall include but not be limited to:
  - 1. Overview of the system and/or equipment as it relates to the facility as a whole.
  - 2. Operation and maintenance procedures and schedules related to startup and shutdown, troubleshooting, servicing, preventive maintenance and appropriate operator intervention.
  - 3. Review data included in the operation and maintenance manuals. Refer to Division 1 Section "Operating and Maintenance Data."

- C. Certification: Contractor shall submit to the Engineer a certification letter stating that the Owner's designated representative has been trained as specified herein. Letter shall include date, time, attendees and subject of training. The certification letter shall be signed by the Contractor and the Owner's representative indicating agreement that the training has been provided.
- D. Schedule: Schedule training with Owner with at least 7 days' advance notice.

END OF SECTION 235500

THIS PAGE INTENTIONALLY LEFT BLANK



## SECTION 323115 –CHAIN LINK FENCES AND GATES

### PART 1 - GENERAL

#### 1.1 SUMMARY

- A. Section Includes:
  - 1. Fence framework, fabric, and accessories.
  - 2. Excavation and anchorages for post bases.
  - 3. Manual gates and related hardware.
  - 4. Electric operated sliding gates.

#### 1.2 SUBMITTALS

- A. Submit the following under provisions of Section 013300.
- B. Product Data: Include descriptive literature and installation instructions.

#### 1.3 QUALITY ASSURANCE

- A. Manufacturer: Company having manufacturing facilities in the United States with a minimum 5 years experience specializing in manufacturing of chain link fence products.
- B. Fence contractor: Contractor having 5 years experience installing similar projects in accordance with ASTM F567.
- C. Tolerances: ASTM current specification and tolerances apply and supersede any conflicting tolerance.
- D. Substitutions: Alternate chain link products may be acceptable by the architect as equal if approved in writing ten days prior to bidding provided that the items submitted meet the specifications contained in this document.
- E. Single source: To ensure system integrity obtain the chain link system, framework, fabric, fittings, gates and accessories from a single source.

### PART 2 - PRODUCTS

#### 2.1 MANUFACTURERS

- A. Subject to compliance with specifications, use products of one of the following:
  - 1. Allied Tube and Conduit Corp.
  - 2. Master Halco, Inc.
  - 3. United States Steel.
  - 4. Approved alternate manufacturer.

#### 2.2 MATERIALS

- A. Fence Framework-Steel pipe Type II: Cold formed electric resistance welded steel pipe complying with ASTM F1043 **Group IA** having minimum steel yield strength of **30,000 psi**. External protective coating F1043 Type B, 0.9 oz/ft<sup>2</sup> (270 g/m<sup>2</sup>) minimum hot-dip zinc coating plus a chromate conversion and a clear polymer coating. Internal coating F1043 Type D, 81% nominal

## City of Wentzville MO Public Works Facility

### Wentzville, Missouri

PROJECT NO.: 19-040

zinc pigmented coating minimum 3 mils (0.0076 mm) thick or Type B, minimum 0.9 oz/ft<sup>2</sup> (275 g/m<sup>2</sup>) zinc.

#### B. Materials

1. End, Corner, and Pull Posts: Galvanized steel; minimum sizes and weights as follows:
  - a. Up to 6 foot fabric height: 2.375 inch outside diameter pipe, 3.65 lbs/lin ft or 3.5 x 3.5 inch roll formed section, 4.85 lbs/lin ft.
  - b. Over 6 foot fabric height: 4-inch outside diameter pipe, 5.79 lbs/lin ft; or 3.5 x 3.5 inch roll formed section, 4.85 lbs/lin ft.
2. Line Posts: Galvanized steel; minimum sizes and weights as follows:
  - a. Up to 6 foot fabric height: 1.90 inch outside diameter pipe, 2.70 lbs/lin ft; or 1.875 x 1.625 inch C-section, 2.78 lbs/lin ft.
  - b. 6 foot to 8 foot fabric height: 2.375 inch outside diameter pipe, 3.65 lbs/lin ft; or 2/25 x 1.875 inch H-section, 2.64 lbs/lin ft.
  - c. Over 8 foot fabric height: 4-inch outside diameter pipe, 5.79 lbs/lin ft; or 2.25 x 1.875 H section, 3.26 lbs/lin ft.
3. Gate Posts: Galvanized steel; for single gate or one leaf of double gate, as follows:
  - a. Up to 6 foot height: 2.875 inch outside diameter pipe, 5.79 lbs/lin ft; or 3.5 x 3.5 roll formed section, 4.85 lbs/lin ft.
  - b. 6 foot to 13 foot height: 4 inch outside diameter pipe, 9.11 lbs/lin ft.
4. Top Rail and Intermediate Rails: Galvanized steel, manufacturer's longest lengths.
  - a. Typical: 1.66 inch outside diameter pipe, 2.27 lbs/lin ft; or 1.625 x 1.25 inch roll formed section, 1.35 lbs/lin ft.
  - b. Couplings: Expansion type, approximately 6 inches long.
  - c. Attaching Devices: Means of attaching top rail securely to each gate, corner, pull, and end post.
  - d. At 18 foot tall fence, provide bottom rail, intermediate rails at 6' & 12', and top rail.

- C. Fabric: **Type II Zinc-Coated Class 4** weight of zinc coating 1.2 oz/square foot **No. 7 gauge** galvanized steel wire in 2 inch mesh, with both top and bottom selvages knuckled.

#### 2.3 FITTINGS

- A. Post caps: ASTM F626 galvanized pressed steel, malleable iron, or aluminum alloy weather tight closure cap for tubular posts. Provide one cap for each post. "C" shaped line post without top rail do not require post caps. When top rail is specified provide line post loop tops to secure top rail.
- B. Rail ends: Galvanized pressed steel per ASTM F626, for connection of rails to post using a brace band.
- C. Top rail sleeves: 7" (178 mm) galvanized steel sleeve per ASTM F626.
- D. Wire ties: 9 gauge (0.148") galvanized steel wire for attachment of fabric to line posts and rails. Pre-formed hog ring ties to be 9 gauge (0.148") galvanized steel or aluminum for attachment of fabric to tension wire. Tie wire and hog rings per ASTM F626.
- E. Brace and tension (stretcher bar) bands: ASTM F626 galvanized 12 gauge (0.105") pressed steel by 3/4" formed to a minimum 300 degree profile curvature for post attachment. Secure bands using minimum 5/16" galvanized carriage bolt and nut.
- F. Tension (stretcher) bars: Galvanized steel one piece length equal to 2 inches (50 mm) less than full height of fabric with a minimum cross-section of 3/16" x 3/4" per ASTM F626. Provide tension (stretcher) bars where chain link fabric is secured to the terminal post.

- G. Truss rod assembly: Galvanized steel minimum 5/16" diameter truss rod with pressed steel tightener, in accordance with ASTM F626.
- H. Carriage bolts and nuts: Galvanized of commercial quality.

#### 2.4 TENSION WIRE

- A. Tension wire: ASTM A824 Type II, zinc coated (galvanized) steel wire, 7 gauge, (0.177") diameter wire having a tensile strength of 75,000 psi (517 MPa).
  - 1. Class 4 1.20 oz/ft<sup>2</sup> (366 g/m<sup>2</sup>)

#### 2.5 CHAIN LINK SWING GATE

- A. Swing gates size per plans. Fabricate chain link swing gates in accordance with ASTM F900. Gate frame to be of welded construction. Weld areas to be protected with zinc-rich paint per ASTM A780. The gate frame members are to be spaced no greater than 8' 0" apart horizontally or vertically. Exterior members to be 1.900" OD pipe, interior members when required shall be 1.660" OD pipe. Pipe to be Grade 1 ASTM F1083 per section 2.03. Chain link fabric to match specification of fence system. Fabric to be stretched tightly and secured to vertical outer frame members using tension bar and tension bands spaced 12" on center and tied to the horizontal and interior members 12" on center using 9 gauge galvanized steel ties per section 2.04.
- B. Hinges, hot dip galvanized pressed steel or malleable iron, structurally capable of supporting gate leaf and allow opening and closing without binding. Non-lift-off type hinge design shall permit gate to swing 180° (3.14 rad)
- C. Latch: Surface mount punch gate lock equal to Lockey Sumo GL2 with CL2LINX Adapter for Chain Link.
- D. Gate posts: Grade 1 pipe ASTM F1083 per section 2.03, size per table below
- E.

Gate fabric height over 6 ft. to 12 ft. (1.2m to 2.4m)	
Gate leaf width	Outside Diameter
Up to 6 ft.	2.875 in.
Over 6 ft. to 12 ft.	4.000 in.
Over 12 ft. to 18 ft.	6.625 in.
Over 18 ft. to 24 ft.	8.625 in.

#### 2.6 CHAIN LINK INTERNAL TRACK ALUMINUM CANTILEVER SLIDE GATE

- A. Aluminum cantilever slide gate single leaf 7' high x length per plan shall be of the internal roller design per ASTM F1184 Type II Class 2. Cantilever slide gate to be constructed of ASTM B221 aluminum members welded and designed for maximum structural integrity. Vertical external and internal members minimum 4" square, spaced maximum 8' 0" on center. Gates having fabric

## City of Wentzville MO Public Works Facility

### Wentzville, Missouri

PROJECT NO.: 19-040

greater than 8' 0" in height require a horizontal member. The top horizontal member shall be a one-piece precision extruded structural framing member having an integral enclosed track. Bottom horizontal member to be minimum 2" x 4". Adjustable diagonal X trusses shall be installed in each gate panel to transfer the alternating forces as the gate slides. The gate opening portion shall be filled with chain link fabric stretched taut and secured to the frame members. Chain link fabric shall match the fence system specification. The overall gate structure shall be a minimum of 40% larger than the gate opening to support the cantilevered portion of the gate in the closed position with minimum deflection per ASTM F1184. Electrically operated gates per ASTM F2200 and UL 325 required the back frame to be filled with fabric. Single leaf cantilever design for openings larger than 30' 0" (9.15 m) up to 40' 0" shall be fabricated by welding together two horizontal top structural/track members creating a dual track system. Single track gates up to 30' 0" (9.15 m) opening require two support posts and two internal truck assemblies. Dual track gates over 30' 0" (9.15 m) up to 40' 0" (12.2 m) require two sets of dual posts and four internal truck assemblies.

- B. Internal truck assemblies shall be capable of swiveling to accommodate gate movement and ensure full contact of the four support wheels and two guide wheels to the internal track surface. The galvanized steel truck assembly post bracket, truck assembly vertical support axle as well as the support wheels shall be designed to handle static and dynamic forces required to support and operate the gate. The truck assembly, support axle and internal wheels shall be comprised of stainless steel or galvanized steel components.
- C. Galvanized steel bottom guide roller brackets containing two 3" rubber wheels shall be supplied to keep the bottom of the gate plumb and in proper alignment.
- D. (Removed)
- E. Cantilever gate posts shall be 4" square SCH40. Single leaf cantilevers up to 30' 0" require three 4" square posts, dual track single leaf cantilevers over 30' 0" up to 40' 0" require two sets of pre fabricated dual 4" square support posts and one 4" (101.6 mm) latch post. (Gate is supported in the center of the dual posts.)

## 2.7 POST SETTING MATERIALS

- A. Concrete: Minimum 28 day compressive strength of 3,000 psi (20 MPa).

## PART 3 - EXECUTION

### 3.1 SITE EXAMINATION

- A. Ensure property lines and legal boundaries of work are clearly established.
- B. Survey of fence location to be provided by general contractor.
- C. Verify areas to receive fencing are completed to final grade.

### 3.2 CHAIN LINK FRAMEWORK INSTALLATION

- A. Install chain link fence system in accordance with ASTM F567 and manufacturer's instructions.
- B. Locate terminal post at each fence termination and change in horizontal or vertical direction of 30° or more.

- C. Space line posts uniformly 8' (2438 mm) on center
- D. Concrete set posts: Excavate holes in firm, undisturbed or compacted soil. Holes shall have diameter 4 times greater than outside dimension of post, and depths approximately 6" deeper than post bottom. Excavate deeper as required for adequate support in soft and loose soils, and for posts with heavy lateral loads. Set post bottom 36" below surface when in firm, undisturbed soil. Place concrete around posts in a continuous pour. Trowel finish around post and slope to direct water away from posts. Drive Anchor set line posts: With protective cap, drive post 36" into ground. Excavate a 6" diameter by 6" deep section around post to accommodate the drive anchor shoe clamp. Drive the 2 diagonal drive anchor angle blades into the soil and securely tighten the angle blades to post via the shoe clamp, backfill hole.
- E. Check each post for vertical and top alignment, and maintain in position during placement and finishing operations.
- F. Bracing: Install horizontal brace and truss assembly at mid-height or above for fences 6' and over at each fabric connection to the terminal post. The diagonal truss rod is installed at the point where the brace rail is attached to the terminal post and diagonally down to the bottom of the adjacent line post. Place the truss rod in tension by adjusting the turnbuckle.
- G. Tension wire: Install tension wires so that it will be located 4" up from bottom the fabric. If top rail is not specified, install the tension wire so that it will be located 4" down from the top of the fabric. Stretch and install tension wire before installing the chain link fabric and attach it to each post using wire ties.
- H. Top rail: Install in lengths of 21'. Connect ends with sleeves forming a rigid connection, allow for expansion and contraction.
- I. Center Rails: Install mid rails between line posts and attach to post using rail end or line rail clamps. A center rail is required for fabric height 12' and over.
- J. Bottom Rails: Install bottom rails between posts and attach to post using rail end or line rail clamps.

### 3.3 CHAIN LINK FABRIC INSTALLATION

- A. Fabric: Install fabric on security side, pull fabric taut; thread the tension bar through fabric and attach to terminal posts with tension bands spaced maximum of 15" on center and attach so that fabric remains in tension after pulling force is released. Install fabric so that it is 2" +/- 1" above finish grade.
- B. Secure fabric using wire ties to line posts at 15" on center and to rails and braces 24" on center, and to the tension wire using hog rings 24" on center. Tie wire shall be secured to the fabric by wrapping it two 360 degree turns around the chain link wire pickets. Cut off any excess wire and bend back so as not to protrude so as to avoid injury if a pedestrian may come in contact with the fence.

### 3.4 CHAIN LINK INSTALLATION

- A. Swing gates: Installation of swing gates and gate posts shall be per ASTM F567. Direction of swing shall be as shown on drawings Gates shall be hung plumb in the closed position with minimal space from grade to bottom of gate leaf. Double gate drop bar receiver shall be set in a

**City of Wentzville MO Public Works Facility**

**Wentzville, Missouri**

PROJECT NO.: 19-040

minimum concrete footing 6" diameter by 24" deep. Gate leaf holdbacks shall be installed on all double gates and all gate leafs greater than 5' in width.

- B. Cantilever slide gates: Install cantilever horizontal slide gates and gate posts in accordance with ASTM F567. Cantilever sliding gates shall be plumb in the closed position with minimal ground clearance and slide with an initial force of 40 lbs. (18.14 kg). Double gate drop bar receiver shall be set in a minimum concrete footing 6" diameter by 24" deep. Install top and bottom safety roller covers and adjacent safety guide posts on ASTM F1184 Type II Class 2 external roller cantilever slide gate applications

3.5 ELECTRICAL GROUNDING

- A. Grounding when required shall be the responsibility of a licensed electrical contractor and included in Contract Section 337900.


3.6 SITE CLEAN UP

- A. Clean up area adjacent to fence line from debris and unused material created by fence installation.

END OF SECTION 323115



\\s01\civ\civil\PROJECTS\2022\2022-033A - CITY OF WENTZVILLE PUBLIC WORKS - WENTZVILLE AND ENGINEERING\CONSTRUCTION DRAWINGS\SET\GENERAL NOTES.dwg

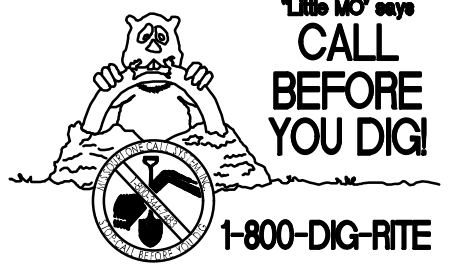

**UNDERGROUND UTILITIES AND OSHA SAFETY NOTE:**  
Underground utilities and structures have been plotted from available information and therefore, their location should be considered approximate only. It is the responsibility of the individual contractors to notify the utility companies before actual construction. All OSHA rules and regulations established for the type of construction required by these plans shall be strictly followed (ie. trenching, blasting, etc.)

	A	B	C	D	E	F	G	H	J	K	L	M	N	P	Q	R	S	T
14	<b>SITE PLAN NOTES:</b>  1. BASIS OF BEARINGS FOR THIS SURVEY WAS ADOPTED FROM THE MISSOURI STATE PLANE COORDINATE SYSTEM, NAD 1983, EAST ZONE.  2. REFERENCE BENCHMARK: MISSOURI DEPARTMENT OF TRANSPORTATION VRS NETWORK, NAVD 88.  3. BUILDING HEIGHT, SITE LIGHTING AND SIGNAGE SHALL BE IN ACCORDANCE WITH THE CITY OF WENTZVILLE REQUIREMENTS.  4. ALL DIMENSIONS ARE TO FACE OF CURB OR FACE OF BUILDING UNLESS NOTED OTHERWISE.  5. REFER TO ARCHITECTURAL PLANS FOR BUILDING DIMENSIONS AND DETAILS.  6. ALL PROPOSED IMPROVEMENTS SHALL BE CONSTRUCTED TO MEET THE CITY OF WENTZVILLE SPECIFICATIONS.  7. PROPOSED CONTOURS DEFICIED ARE AT FINISHED GRADE DRIVE ENHANCES ARE TO BE CONSTRUCTED IN ACCORDANCE WITH THE CITY OF WENTZVILLE SPECIFICATIONS.  8. ALL PARKING LOT LIGHTING SHALL BE FULL CUT-OFF. NO WALL-PACK FLOODLIGHTS WILL BE USED ON THE BUILDING. ALL LIGHT FIXTURES ATTACHED TO THE BUILDING SHALL BE DECORATIVE AND APPROVED BY THE CITY'S PLANNING COMMISSION.  9. SIDEWALKS ALONG ACCESSIBLE ROUTES SHALL NOT HAVE A SLOPE EXCEEDING 1:20. SLOPES GREATER THAN 1:20 MUST BE DESIGNED AS A RAMP.  10. SIDEWALKS, CURB, RAMPS, RAMPS AND ACCESSIBLE PARKING SPACES SHALL BE CONSTRUCTED IN ACCORDANCE WITH THE CURRENT APPROVED "AMERICANS WITH DISABILITIES ACT ACCESSIBILITY GUIDELINES" (ADAAG) ALONG WITH THE REQUIRED GRADES, CONSTRUCTION MATERIALS, SPECIFICATIONS, AND SIGNAGE. IF ANY CONFLICT OCCURS BETWEEN THE ADAAG GUIDELINES AND THE INFORMATION ON THE PLANS, THE ADAAG GUIDELINES SHALL TAKE PRECEDENCE AND THE CONTRACTOR SHALL NOTIFY THE PROJECT ENGINEER PRIOR TO ANY CONSTRUCTION.  11. ALL PUBLIC IMPROVEMENTS SHALL BE REQUIRED TO MEET ADAAG 2010 AND CITY OF WENTZVILLE DESIGN STANDARDS.  12. ALL UTILITIES SHOWN HAVE BEEN LOCATED BY THE ENGINEER FROM AVAILABLE RECORDS. THEIR LOCATION SHOULD BE CONSIDERED APPROXIMATE. THE CONTRACTOR HAS THE RESPONSIBILITY TO NOTIFY ALL UTILITY COMPANIES PRIOR TO CONSTRUCTION TO HAVE EXISTING UTILITIES FIELD LOCATED. THE CONTRACTOR SHALL BE ON RECORD WITH THE MISSOURI ONE CALL SYSTEM. ALL PROPOSED UTILITIES TO BE UNDERGROUND.  13. ALL UTILITY TAPS AND CONNECTIONS ARE TO BE PERFORMED PER UTILITY SERVICE PROVIDER SPECIFICATIONS.  14. ALL PROPOSED IMPROVEMENTS, STORM SEWERS, SANITARY SEWERS, WATER MAIN, GRADING AND DRAINAGE SHALL BE IN CONFORMANCE WITH THE CITY OF WENTZVILLE DETAILS AND SPECIFICATIONS.  15. ALL EXISTING ON-SITE IMPROVEMENTS WITHIN THE DISTURBED AREA LIMITS SHALL REMOVED OR ADJUSTED TO GRADE UNLESS NOTED OTHERWISE.  16. APPROVAL OF THIS PLAN DOES NOT CONSTITUTE APPROVAL OF SIGNAGE.  17. ALL HVAC AND MECHANICAL EQUIPMENT SHALL BE SCREENED ON ALL SIDES FROM PUBLIC VIEW.  18. NO STEPS ARE ALLOWED AT ACCESSIBLE ENTRANCE DOORS.  19. FLOOD AREA: PER FEMA FIRM 29183C20150, DATED JANUARY 20, 2016 - THE PROPERTY IS ZONE X WHICH IS DESCRIBED AS "AREA OF MINIMAL FLOOD HAZARD".  20. ALL PROPOSED PUBLIC UTILITIES SHALL BE INSTALLED WITHIN THE PUBLIC RIGHT-OF-WAY OR WITHIN THE BOUNDARIES OF THE PROPOSED EASEMENTS. THE CITY OF WENTZVILLE ENGINEERING DESIGN CRITERIA SHALL BE IN EFFECT FOR THIS DEVELOPMENT.  21. ANY RETAINING WALLS THAT ARE OVER 3.5 FEET IN HEIGHT SHALL BE DESIGNED BY A RETAINING WALL ENGINEER AND GEOTECHNICAL SERVICES SHALL BE OBTAINED TO DETERMINE A GLOBAL AND FOUNDATION STABILITY ANALYSIS OF THE PROPOSED RETAINING WALL.  22. A DRAINAGE PERMIT IS REQUIRED BY THE CITY OF WENTZVILLE FOR ALL STORM SEWERS.  23. STORMWATER SHALL BE DISCHARGED AT ADEQUATE NATURAL DISCHARGE POINTS. SINKHOLES ARE NOT ADEQUATE NATURAL DISCHARGE POINTS.  24. ALL LANDSCAPING SHALL BE PROVIDED AS REQUIRED BY THE CITY OF WENTZVILLE. REFERENCE LANDSCAPE PLAN.  25. NO ON-SITE ILLUMINATION SOURCE SHALL BE SO SITUATED THAT LIGHT IS CAST DIRECTLY ON ADJOINING PROPERTIES OR PUBLIC ROADWAYS. ILLUMINATION LEVELS SHALL COMPLY WITH THE PROVISIONS OF THE LIGHTING SECTION. CITY OF WENTZVILLE SECTION 410.320, THEREBY LIGHTING INTENSITY SHALL NOT EXCEED 0.5 FOOT CANDLES AT ALL EXTERIOR PROPERTY LINES AND 8.0 F.C. AT THE BASE OF LIGHT STANDARDS.  26. ELECTRIC SERVICE SHALL BE LOCATED UNDERGROUND.  27. ALL OFFSITE AREAS DISTURBED BY UTILITY REMOVALS, SITE PROPERTY (BUSHES, FENCES, MAILBOXES, ETC.) ABANDONMENT OF UTILITIES OR OTHER WORK SHALL BE RESTORED TO A STABILIZED CONDITION. THE GENERAL CONTRACTOR SHALL PROVIDE NOTICE AT LEAST 72 HOURS IN ADVANCE FOR ANY WORK THAT IS COMPLETED ON OFFSITE PROPERTY.  28. THE G.C. WILL BE REQUIRED TO OBTAIN THE BUILDING PERMIT FROM THE CITY PRIOR TO COMMENCING ANY WORK. THERE MAY BE SOME TIMES WHEN THE CITY WILL REQUIRE THAT ALL THE SUBCONTRACTORS BE KNOWN IN ORDER TO COMPLETE THE PERMIT APPLICATION. WHEN ASKED, THE G.C. WILL PROVIDE A LIST TO THE DEVELOPER WITH COMPANY NAMES, ADDRESSES, PHONE/FAX NUMBERS, CONTACT NAMES AND STATE LICENSE NUMBERS.  29. ALL OFFSITE WORK WILL BE COORDINATED WITH THE ADJACENT PROPERTY OWNERS AND WILL NOT COMMENCE WITHOUT THEIR WRITTEN AUTHORIZATION.  30. THE G.C. IS TO FILE A "NOTICE OF COMMENCEMENT" AS REQUIRED BY THE LAWS GOVERNING THE STATE THAT THE PROJECT FAILS IN AND SUBMIT ALL PAPERWORK TO THE CITY OF WENTZVILLE.  31. SIGNAGE SHOWN FOR REFERENCE ONLY. SIGNAGE TO BE REVIEWED AND PERMITTED SEPARATELY FROM SITE PLAN PER SIGNAGE REGULATIONS.																	
13	<b>GENERAL NOTES:</b>  1. ALL CONSTRUCTION SHALL BE IN ACCORDANCE WITH THE CITY OF WENTZVILLE SPECIFICATIONS, ST. CHARLES COUNTY "STANDARD DETAILS", LATEST EDITION, THE PROJECT SPECIFICATIONS BOOK, AND THESE CONSTRUCTION PLANS. IN CASE OF CONFLICTING SPECIFICATIONS FOR DETAILS, THE CIVIL ENGINEER SHALL BE CONTACTED PRIOR TO CONSTRUCTION. GENERALLY, THE MOST STRINGENT SPECIFICATION SHALL APPLY.  2. DURING THE CONSTRUCTION OF THESE IMPROVEMENTS, ANY INTERPRETATION OF THE STANDARD SPECIFICATIONS, AND ANY MATTER WHICH REQUIRES THE APPROVAL OF THE OWNER, MUST BE APPROVED BY THE CITY OF WENTZVILLE ENGINEERING DIVISION BEFORE ANY CONSTRUCTION INVOLVING THAT DECISION COMMENCES. ASSUMPTIONS ABOUT WHAT THESE DECISIONS MAY BE WHICH ARE MADE DURING THE BIDDING PHASE WILL HAVE NO BEARINGS ON THE DECISION.  3. THE CONTRACTOR SHALL BE RESPONSIBLE FOR FURNISHING ALL MATERIAL AND LABOR TO CONSTRUCT THE FACILITY AS SHOWN AND DESCRIBED IN THE CONSTRUCTION DOCUMENTS IN ACCORDANCE WITH THE APPROPRIATE APPROVING AUTHORITIES, SPECIFICATIONS AND REQUIREMENTS. CONTRACTOR SHALL VISIT THE SITE PRIOR TO BIDDING TO DETERMINE EXISTING CONDITIONS.  4. ALL EXISTING UTILITIES SHOWN ARE LOCATED ACCORDING TO THE INFORMATION AVAILABLE TO THE ENGINEER AT THE TIME THE DRAWINGS WERE PREPARED AND HAVE NOT BEEN INDEPENDENTLY VERIFIED BY THE OWNER OR THE ENGINEER. GUARANTEE IS NOT MADE THAT ALL EXISTING UNDERGROUND UTILITIES ARE SHOWN OR THAT THE LOCATION OF THOSE SHOWN ARE ACCURATE. THE LOCATIONS SHOWN ARE FOR BIDDING PURPOSES ONLY. FINDING THE ACTUAL LOCATION OF ANY EXISTING UTILITIES IS THE CONTRACTOR'S RESPONSIBILITY AND SHALL BE DONE BEFORE COMMENCEMENT OF ANY WORK (INCLUDING ORDERING OF MATERIALS) IN THE VICINITY. FURTHERMORE, THE CONTRACTOR SHALL BE FULLY RESPONSIBLE FOR ANY AND ALL DAMAGES DUE TO THE CONTRACTOR'S FAILURE TO EXACTLY LOCATE AND PRESERVE ANY AND ALL UNDERGROUND UTILITIES. THE OWNER OR CEC WILL ASSUME NO LIABILITY FOR ANY DAMAGES SUSTAINED OR COST INCURRED BECAUSE OF THE OPERATIONS IN THE VICINITY OF EXISTING UTILITIES OR STRUCTURES, NOR FOR TEMPORARY BRACING AND SHORING OF SAME. IF IT IS NECESSARY TO SHORE, BRACE, SWING OR RELOCATE A UTILITY, THE UTILITY COMPANY OR DEPARTMENT AFFECTED SHALL BE CONTACTED BY THE CONTRACTOR AND THEIR PERMISSION OBTAINED REGARDING THE METHOD TO USE FOR SUCH WORK.  5. IT IS THE CONTRACTOR'S RESPONSIBILITY TO CONTACT THE VARIOUS UTILITY COMPANIES WHICH MAY HAVE BURIED OR AERIAL UTILITIES WITHIN OR NEAR THE CONSTRUCTION DOCUMENTS BEFORE COMMENCING WORK. THE CONTRACTOR SHALL PROVIDE 72 HOURS MINIMUM NOTICE TO ALL UTILITY COMPANIES PRIOR TO BEGINNING CONSTRUCTION. A LIST OF THE UTILITY COMPANIES WHICH THE CONTRACTOR MUST CALL BEFORE COMMENCING WORK IS PROVIDED ON THE COVER SHEET OF THESE CONSTRUCTION PLANS. THIS LIST SERVES AS A GUIDE ONLY AND IS NOT INTENDED TO LIMIT THE UTILITY COMPANIES WHICH THE CONTRACTOR MAY WISH TO NOTIFY.  6. THE CONTRACTOR SHALL BE RESPONSIBLE FOR OBTAINING ALL REQUIRED CONSTRUCTION PERMITS, 3-WAY CONTRACTS, AND BONDS PRIOR TO CONSTRUCTIONS.  7. THE CONTRACTOR SHALL HAVE AVAILABLE AT THE JOB SITE AT ALL TIMES ONE COPY OF THE CONTRACT DOCUMENTS INCLUDING PLANS, SPECIFICATIONS AND SPECIAL CONDITIONS, COPIES OF ANY REQUIRED CONSTRUCTION PERMITS, AND EROSION CONTROL PLANS AND INSPECTION REPORTS (SWPP).  8. ANY DISCREPANCIES ON THE DRAWINGS SHALL BE IMMEDIATELY BROUGHT TO THE ATTENTION OF THE OWNER & CIVIL ENGINEER BEFORE COMMENCING WORK. NO FIELD CHANGES OR DEVIATIONS FROM DESIGN ARE TO BE MADE WITHOUT PRIOR APPROVAL BY THE OWNER AND NOTIFICATION TO THE ENGINEER. NO CONSIDERATION WILL BE GIVEN TO CHANGE ORDERS FOR WHICH THE OWNER AND CIVIL ENGINEER WERE NOT CONTACTED PRIOR TO CONSTRUCTION OF THE AFFECTED ITEM.  9. ALL COPIES OF COMPACTION, CONCRETE AND OTHER REQUIRED TEST RESULTS ARE TO BE SENT TO THE CIVIL ENGINEER OF RECORD AND THE CITY OF WENTZVILLE ENGINEERING DIVISION DIRECTLY FROM THE TESTING AGENCY. ALL TESTING IS TO BE CONTRACTED BY THE OWNER.  10. THE CONTRACTOR SHALL BE RESPONSIBLE FOR SUBMITTING TO THE CIVIL ENGINEER AND TO CITY A CERTIFIED RECORD SURVEY SIGNED AND SEALED BY A PROFESSIONAL LAND SURVEYOR REGISTERED IN THE STATE OF MISSOURI DEPICTING THE ACTUAL FIELD LOCATION OF ALL CONSTRUCTED IMPROVEMENTS THAT ARE REQUIRED BY THE JURISDICTIONAL AGENCIES FOR THE CERTIFICATION PROCESS. ALL SURVEY COSTS WILL BE THE CONTRACTORS RESPONSIBILITY.  11. ALL NECESSARY INSPECTIONS AND/OR CERTIFICATIONS REQUIRED BY CODES, JURISDICTIONAL AGENCIES AND/OR UTILITY SERVICE COMPANIES SHALL BE PERFORMED PRIOR TO ANNOUNCED BUILDING POSSESSION AND THE FINAL CONNECTION OF SERVICES.  12. CONTRACTORS SHALL VERIFY BENCHMARKS AND DATUMS PRIOR TO COMMENCING CONSTRUCTION OR STAKING OF IMPROVEMENTS.  13. CONTRACTOR SHALL REPLACE ANY FENCING, CURBING, ETC. THAT IS DESTROYED OR DAMAGED DUE TO THE CONSTRUCTION ACTIVITIES.  14. CONTRACTOR IS RESPONSIBLE FOR TRAFFIC CONTROL DEVICES AND PLANS FOR ANY STREET WORK.  15. ALL CONTRACTORS MUST CONFINED THEIR ACTIVITIES TO THE WORK AREA. NO ENCROACHMENTS ONTO DEVELOPED OR UNDEVELOPED AREAS WILL BE ALLOWED. ANY DAMAGE RESULTING SHALL BE THE CONTRACTOR'S RESPONSIBILITY TO REPAIR.  16. THE CONTRACTOR SHALL BE RESPONSIBLE FOR SUBMITTING A TRENCH SAFETY PLAN TO THE DEVELOPER AT THE TIME OF THE PRE-CONSTRUCTION MEETING, OR PRIOR TO BEGINNING CONSTRUCTION OF THESE IMPROVEMENTS. CONTRACTOR SHALL BE RESPONSIBLE FOR MAINTAINING TRENCH SAFETY REQUIREMENTS IN ACCORDANCE WITH MISSOURI STATE LAW AND O.S.H.A. STANDARDS FOR ALL EXCAVATION IN EXCESS OF FIVE FEET IN DEPTH. NO OPEN TRENCHES WILL BE ALLOWED OVERNIGHT. ON-SITE SAFETY IS THE SOLE RESPONSIBILITY OF THE CONTRACTOR.  17. TO THE MAXIMUM EXTENT PRACTICAL, CONSTRUCTION STAGING, WORKER PARKING, AND ANY OTHER POTENTIALLY NOISY OR OFFENSIVE CONSTRUCTION ACTIVITY SHOULD BE LOCATED AS FAR FROM THE RESIDENTIAL NEIGHBORS AS POSSIBLE.  18. CONTRACTOR SHALL KEEP THE CONSTRUCTION SITE SECURE FROM TRESPASSERS AT ALL TIMES.  19. CONTRACTOR SHALL CONTACT CITY BUILDING OFFICIAL TO LEARN OF ANY UNUSUAL CONSTRUCTION SEQUENCING REQUIREMENTS THAT THE CITY MAY REQUIRE. THE CONTRACTOR IS CAUTIONED THAT THIS AND FURTHER OTHER SUCH REQUIREMENTS MAY EXIST AND IT IS THE CONTRACTOR'S RESPONSIBILITY TO INVESTIGATE AND COMPLY WITH THEM.  20. CONTRACTOR IS RESPONSIBLE FOR OBTAINING ANY NECESSARY FENCE OR WALL PERMITS FROM THE CITY.  21. CONTRACTOR IS RESPONSIBLE FOR PROVIDING ADEQUATE TRAFFIC CONTROL PER CITY OF WENTZVILLE STANDARDS.																	
12	<b>PAVING, GRADING, AND DRAINAGE NOTES:</b>  1. ALL PAVING, CONSTRUCTION MATERIALS, AND WORKMANSHIP WITHIN CITY OR COUNTY RIGHT-OF-WAY SHALL BE IN ACCORDANCE WITH THE CITY OF WENTZVILLE STANDARD SPECIFICATIONS AND DETAILS.  2. ALL AREAS IN EXISTING RIGHT-OF-WAY DISTURBED BY SITE CONSTRUCTION SHALL BE RE-GRADED AND LANDSCAPED OR PAVED, (WHATEVER WAS THERE BEFORE DISTURBANCE). ALL DISTURBED AREAS SHALL BE REPAIRED TO THE SAME CONDITION OR BETTER THAN BEFORE AREA WAS DISTURBED.  3. TRAFFIC CONTROL ON ALL STATE, CITY AND COUNTY RIGHTS-OF-WAY SHALL MEET THE REQUIREMENTS OF THE MANUAL OF UNIFORM TRAFFIC CONTROL DEVICES (M.U.T.C.D./M) AND THE REQUIREMENTS OF THE STATE AND ANY LOCAL AGENCY HAVING JURISDICTION. IN THE EVENT THAT THE CONTRACT DOCUMENTS AND THE JURISDICTIONAL AGENCY REQUIREMENTS ARE NOT IN AGREEMENT, THE MOST STRINGENT SHALL GOVERN.  4. THE CONTRACTOR SHALL GRADE THE SITE TO THE ELEVATIONS INDICATED AND SHALL RE-GRADE ANY WASHOUTS WHERE THEY OCCUR AFTER EVERY RAINFALL EVENT UNTIL SOIL IS STABILIZED.  5. ALL AREAS INDICATED AS PAVEMENT SHALL BE CONSTRUCTED IN ACCORDANCE WITH THE TYPICAL PAVEMENT SECTIONS AS INDICATED ON THE DRAWINGS AND THE PROJECT SPECIFICATIONS.  6. WHERE EXISTING PAVEMENT IS INDICATED TO BE REMOVED AND REPLACED, THE CONTRACTOR SHALL SAW CUT TO FULL DEPTH OF EXISTING PAVEMENT. CONTRACTOR SHALL PREPARE A SMOOTH, SOUND, VERTICAL FACE AND MATCH THE EXISTING PAVEMENT ELEVATION UNLESS OTHERWISE NOTED. CONTRACTOR SHALL INSTALL LONGITUDINAL BUTT JOINTS WHEN CONNECTING TO EXISTING CONCRETE PAVEMENT.  7. THE CONTRACTOR SHALL ENSURE THAT ALL PLANTING AREAS ARE NOT OVERLY COMPACTED AND DO NOT CONTAIN LIMBROCK, BRASH DEBRIS OR OTHER DELETERIOUS MATTER. THE CONTRACTOR SHALL EXCAVATE AND REMOVE ALL UNDESIRABLE MATERIAL FROM ALL AREAS ON THE SITE TO BE PLANTED.  8. ALL DRAINAGE STRUCTURES SHALL BE DESIGNED AS REQUIRED DURING AND AT THE END OF CONSTRUCTION TO PROVIDE POSITIVE DRAINAGE FLOWS.  9. STRIP TOPSOIL AND ORGANIC MATTER AND PAVING MATERIAL FROM ALL AREAS UNDER BUILDING, TPOIL MAY BE STOCKPILED ON SITE FOR REPLACEMENT IN GREEN AREAS.  10. FIELD DENSITY TESTS SHALL BE TAKEN AT A FREQUENCY AS REQUIRED IN THE PROJECT SPECIFICATIONS.  11. IN NO CASE SHALL HANDICAP RAMP SLOPES EXCEED 1 VERTICAL TO 12 HORIZONTAL. IN NO CASE SHALL SIDEWALK CROSS SLOPES EXCEED 2.2 PERCENT. IN NO CASE SHALL LONGITUDINAL SIDEWALK SLOPES EXCEED 5.0 PERCENT. CONTRACTOR SHALL CONTACT ARCHITECT AND CIVIL ENGINEER PRIOR TO PAVING IF ANY EXCESSIVE SLOPES ARE ENCOUNTERED. NO CONTRACTOR CHANGE ORDERS WILL BE ACCEPTED FOR A.D.A. COMPLIANCE ISSUES.  12. CONTRACTOR ADJUSTMENT TO SPOT GRADES TO MAINTAIN POSITIVE DRAINAGE IS ALLOWED. ONLY WITH THE PRIOR APPROVAL OF THE CIVIL ENGINEER. CONTRACTOR SHALL CONTACT THE CIVIL ENGINEER PRIOR TO PAVING IF ANY AREAS OF POOR DRAINAGE ARE ENCOUNTERED.  13. SPOT ELEVATIONS SHOWN ARE TO TOP OF PAVING SURFACE OR FINISHED EARTH GRADE UNLESS NOTED OTHERWISE. WHERE APPLICABLE, ADD 0.50 FEET TO SPOT GRADES SHOWN FOR TOP OF CURB ELEVATIONS.  14. ALL SLOPES AND AREAS DISTURBED BY CONSTRUCTION SHALL BE GRADED SMOOTH. THE AREAS SHALL THEN BE STABILIZED AS SPECIFIED IN THE PLANS AND MAINTAINED UNTIL SOIL IS STABILIZED IN ALL AREAS. ANY AREAS DISTURBED FOR ANY REASON PRIOR TO FINAL ACCEPTANCE OF THE JOB SHALL BE CORRECTED BY THE CONTRACTOR AT NO ADDITIONAL COST TO THE OWNER.  15. THE CONTRACTOR SHALL BE RESPONSIBLE FOR THE CONTROL OF DUST AND DIRT RISING AND SCATTERING IN THE AIR DURING CONSTRUCTION AND SHALL PROVIDE WATER SPRINKLING OR OTHER SUITABLE METHODS OF CONTROL. THE CONTRACTOR SHALL COMPLY WITH ALL GOVERNING REGULATIONS PERTAINING TO ENVIRONMENTAL PROTECTION.  16. THE CONTRACTOR TAKE ALL MEASURES NECESSARY TO CONTROL TURBIDITY, INCLUDING BUT NOT LIMITED TO, THE INSTALLATION OF BMPs AT ALL LOCATIONS WHERE THE POSSIBILITY OF TRANSPORTING SUSPENDED SOLIDS INTO THE RECEIVING WATER BODY EXISTS DUE TO THE PROPOSED WORK. BMPs MUST BE MAINTAINED IN EFFECTIVE CONDITION AT ALL LOCATIONS. UNTIL CONSTRUCTION IS COMPLETED AND DISTURBED SOIL AREAS ARE STABILIZED, THEREAFTER, THE CONTRACTOR MUST REMOVE THE TEMPORARY BARRIERS, AT NO TIME SHALL THERE BE ANY OFF-SITE DISCHARGE WHICH VIOLATES LOCAL, STATE, OR FEDERAL WATER QUALITY STANDARDS.  17. THE CONTRACTOR MUST REVIEW AND MAINTAIN A COPY OF THE STORM WATER PERMIT COMPLETE WITH ALL CONDITIONS, ATTACHMENTS, EXHIBITS, AND PERMIT MODIFICATIONS, IN GOOD CONDITION, AT THE CONSTRUCTION SITE. THE COMPLETE PERMIT MUST BE AVAILABLE FOR REVIEW UPON REQUEST BY JURISDICTIONAL AGENCIES.  18. IF ANY EXISTING STRUCTURES, FACILITIES, OR IMPROVEMENTS (PUBLIC OR PRIVATE) TO REMAIN ARE DAMAGED DURING CONSTRUCTION, IT SHALL BE THE CONTRACTOR'S RESPONSIBILITY TO REPAIR AND/OR REPLACE THE EXISTING STRUCTURE, FACILITY, OR IMPROVEMENT AS NECESSARY TO RETURN IT TO EXISTING CONDITIONS OR BETTER.  19. REFERENCE THE SWPPP INCLUDED IN THIS PLAN SET AND IN THE PROJECT SPECIFICATIONS FOR THIS PROJECT.  20. ALL PIPE AND BENDS LESS THAN 42" DIAMETER MUST BE FACTORY MANUFACTURED BENDS.  21. ALL WORK SHALL BE DONE IN COMPLIANCE WITH THE PROJECT GEOTECHNICAL SERVICE REPORT FOR THIS SITE.  22. NO SLOPES SHALL EXCEED 3 HORIZONTAL TO 1 VERTICAL UNLESS JUSTIFIED BY A GEOTECHNICAL REPORT. THAT HAS BEEN ACCEPTED/APPROVED BY THE CITY OF WENTZVILLE.  23. ALL GRADED AREAS SHALL BE PROTECTED FROM EROSION BY EROSION CONTROL DEVICES AND/OR SEEDING AND MULCHING AS REQUIRED BY THE CITY OF WENTZVILLE.  24. SEEDING, SODDING, MULCHING, AND PLANTINGS FOR ALL DISTURBED AREAS SHALL BE SPECIFIED ON THE LANDSCAPE PLAN.  25. ANY LAND DISTURBANCE ACTIVITY INVOLVING MORE THAN ONE (1) ACRE OR MORE OF LAND IS A MAJOR LAND DISTURBANCE AND THE APPROPRIATE PERMITS MUST BE OBTAINED FROM THE MISSOURI DEPARTMENT OF NATURAL RESOURCES.  26. ALL ELEVATIONS SHOWN ON THE GRADING PLAN ARE TO TOP OF PAVEMENT OR FINISHED GROUND UNLESS NOTED OTHERWISE. ELEVATIONS TO POINTS OTHER THAN THE TOP OF PAVEMENT ARE NOTED AS FOLLOWS:  TH-TOF OF PAVEMENT TC-TOF OF CURB TW-TOF OF WALL BW-FINISHED GROUND AT FACE OF WALL GR-FINISHED GROUND AT YARD DRAINS																	
11	<b>STORM SEWER NOTES:</b>  1. ALL CONCRETE PIPE SHALL BE REINFORCED, AND CONFORM TO A.S.T.M. DESIGNATION C76-80 CLASS III UNLESS OTHERWISE NOTED.  2. ALL SEWER CONSTRUCTION AND MATERIALS SHALL BE IN ACCORDANCE WITH THE CITY OF WENTZVILLE STANDARD SPECIFICATIONS AND CONSTRUCTION DETAILS.  3. TYPE "C" BEDDING PER CITY OF WENTZVILLE STANDARDS IS REQUIRED FOR PIPES IN ROCK.  4. ALL TRENCHES UNDER AREAS TO BE PAVED AND UNDER EXISTING PAVING SHALL BE GRANULARLY FILLED WITH 3/4" MINUS CRUSHED LIMESTONE ONLY. BACKFILL SHALL BE PLACED IN ACCORDANCE WITH CITY OF WENTZVILLE STANDARDS.  5. ALL TRENCH BACKFILLS UNDER PAVEMENT WITHIN PUBLIC RIGHT-OF-WAY SHALL BE GRANULAR BACKFILL. TRENCH BACKFILLS UNDER PAVED AREAS, OUTSIDE OF PUBLIC RIGHT-OF-WAY, SHALL BE GRANULAR BACKFILL IN LIEU OF THE EARTH BACKFILL COMPACTED TO 95 PERCENT OF THE STANDARD ASTM D 1557 COMPACTION TEST A.S.T.M. D-698.  6. ALL DIMENSIONS ARE TO THE CENTERLINE OF STRUCTURE EXCEPT FOR END OF PIPES OR FLARED ENDS. FLARED END DIMENSIONS VARY. CONTRACTOR SHALL VERIFY LENGTHS FOR FLARED END SECTIONS PER PROPOSED TYPE OF FLARE END SUBMITTED.  7. PLUMBING CONTRACTOR AND SURVEYOR SHALL CONFORM STRUCTURES PROPOSED ON THESE PLANS MATCH THE PROPOSED STRUCTURES THAT ARE ON-SITE. DUE TO CHANGE OF ELEVATIONS, AND LOCATIONS DEPENDING ON THE STRUCTURE AND TYPE, THE PLUMBING CONTRACTOR SHALL BE RESPONSIBLE FOR ANY PLANS FOR PROPOSING A DIFFERENT TYPE OF STRUCTURE OR PIPE THAN WHAT IS ON THESE PLANS. GENERAL CONTRACTOR SHALL REMBURSE CIVIL ENGINEERS FOR ANY TIME AND MATERIALS TO ADDRESS CHANGES TO STRUCTURES TO REDUCE OVERALL CONSTRUCTION COSTS.																	
10	<b>SANITARY SEWER NOTES:</b>  1. ALL SEWER CONSTRUCTION AND MATERIALS SHALL BE IN ACCORDANCE WITH THE CITY OF WENTZVILLE STANDARD SPECIFICATIONS AND CONSTRUCTION DETAILS.  2. ALL LATERAL SEWER CONSTRUCTION METHODS TO CONFORM TO LATEST STANDARDS AND SPECIFICATIONS FOR THE CITY OF WENTZVILLE STANDARD SPECIFICATIONS AND CONSTRUCTION DETAILS.  3. ALL TRENCHES UNDER AREAS TO BE PAVED AND UNDER EXISTING PAVING SHALL BE GRANULARLY FILLED WITH 3/4" MINUS CRUSHED LIMESTONE ONLY. BACKFILL SHALL BE PLACED IN ACCORDANCE WITH CITY OF WENTZVILLE STANDARDS.  4. TYPE "C" BEDDING PER CITY OF WENTZVILLE STANDARDS REQUIRED FOR PIPES IN ROCK.  5. ALL TRENCH BACKFILLS UNDER PAVEMENT WITHIN PUBLIC RIGHT-OF-WAY SHALL BE GRANULAR BACKFILL. TRENCH BACKFILLS UNDER PAVED AREAS, OUTSIDE OF PUBLIC RIGHT-OF-WAY, SHALL BE GRANULAR BACKFILL IN LIEU OF THE EARTH BACKFILL COMPACTED TO 90 PERCENT OF THE STANDARD ASTM D 1557 COMPACTION TEST A.S.T.M. D-1557.  6. ALL DIMENSIONS ARE TO THE CENTERLINE OF STRUCTURE EXCEPT FOR END OF PIPES OR FLARED ENDS. FLARED END DIMENSIONS VARY. CONTRACTOR SHALL VERIFY LENGTHS FOR FLARED END SECTIONS PER PROPOSED TYPE OF FLARE END SUBMITTED.  7. PLUMBING CONTRACTOR AND SURVEYOR SHALL CONFORM STRUCTURES PROPOSED ON THESE PLANS MATCH THE PROPOSED STRUCTURES THAT ARE ON-SITE. DUE TO CHANGE OF ELEVATIONS, AND LOCATIONS DEPENDING ON THE STRUCTURE AND TYPE, THE PLUMBING CONTRACTOR SHALL BE RESPONSIBLE FOR ANY PLANS FOR PROPOSING A DIFFERENT TYPE OF STRUCTURE OR PIPE THAN WHAT IS ON THESE PLANS. GENERAL CONTRACTOR SHALL REMBURSE CIVIL ENGINEERS FOR ANY TIME AND MATERIALS TO ADDRESS CHANGES TO STRUCTURES TO REDUCE OVERALL CONSTRUCTION COSTS.																	
9	<b>UTILITY NOTES:</b>  1. ALL FILL MATERIAL IS TO BE IN PLACE AND COMPACTED BEFORE INSTALLATION OF PROPOSED UTILITIES.  2. CONTRACTOR SHALL NOTIFY THE UTILITY INSPECTORS 72 HOURS BEFORE CONNECTING TO ANY EXISTING LINE.  3. CONTRACTOR SHALL MAINTAIN A MINIMUM OF 3'-6" COVER ON ALL WATERLINES AND 3'-6" ON ALL SANITARY SEWER LINES.  4. THE CONTRACTOR IS SPECIFICALLY CAUTIONED THAT THE LOCATION AND/OR ELEVATION OF EXISTING UTILITIES AS SHOWN ON THESE PLANS IS BASED ON RECORDS OF THE VARIOUS UTILITY COMPANIES, AND WHERE POSSIBLE, MEASUREMENTS TAKEN IN THE FIELD. THE INFORMATION IS NOT TO BE RELIED ON AS BEING EXACT OR COMPLETE. THE CONTRACTOR MUST CALL THE APPROPRIATE UTILITY COMPANIES AT LEAST 72 HOURS BEFORE ANY EXCAVATION TO REQUEST EXACT FIELD LOCATION OF UTILITIES. IT SHALL BE THE RESPONSIBILITY OF THE CONTRACTOR TO LOCATE ALL EXISTING UTILITIES WHICH COINCIDE WITH THE PROPOSED IMPROVEMENTS SHOWN ON THE PLANS.  5. ALL FILLED PLACED UNDER BUILDINGS, PROPOSED SANITARY AND STORM SEWERS AND/OR PAVED AREAS, INCLUDING TRENCH BACKFILLS SHALL BE COMPACTED TO AT LEAST 90% OF MAXIMUM DRY DENSITY AS DETERMINED BY THE MODIFIED A.S.T.M. D-1557 COMPACTION TEST (ASTM D-1557) UNLESS OTHERWISE SPECIFIED BY THE LOCAL GOVERNING AUTHORITY SPECIFICATIONS. ALL TESTS SHALL BE VERIFIED BY A SOILS ENGINEER.  6. GAS, WATER AND OTHER UNDERGROUND UTILITIES SHALL NOT CONFLICT WITH THE DEPTH OR HORIZONTAL LOCATIONS OF EXISTING AND PROPOSED SANITARY AND STORM SEWERS, INCLUDING TRENCH LATERALS.  7. ALL NECESSARY INSPECTIONS AND/OR CERTIFICATIONS REQUIRED BY CODES AND/OR UTILITY SERVICE COMPANIES SHALL BE PERFORMED PRIOR TO ANNOUNCED BUILDING POSSESSION AND THE FINAL CONNECTION OF SERVICE.  8. ALL UTILITY TRENCH BACKFILL SHALL HAVE GRANULAR BACKFILL AND BE MECHANICALLY COMPACTED.  9. THE CONTRACTOR SHALL VERIFY THE LOCATION, CONDITION AND ELEVATION OF ALL PROPOSED SEWER CONNECTION POINTS PRIOR TO THE START OF CONSTRUCTION. ANY DISCREPANCIES THAT WOULD INTERFERE WITH THE PROPOSED SEWER DESIGN SHALL IMMEDIATELY BE BROUGHT TO THE ATTENTION OF THE ENGINEER.  10. ALL PERMIT FEES AND COSTS ASSOCIATED WITH BRINGING UTILITY, SEWER AND WATER SERVICES TO THE SITE SHALL BE THE RESPONSIBILITY OF THE CONTRACTOR. ALL FEES AND COSTS SHALL BE INCLUDED IN THE CONTRACTORS BID.  11. GENERAL CONTRACTOR SHALL COORDINATE INSTALLATION OF GAS, ELECTRIC AND TELEPHONE SERVICES TO DEVELOPMENT WITH UTILITY COMPANIES. G.C. IS TO PROVIDE TRENCH, WIRE, AND CONDUIT FOR TELEPHONE AND ELECTRICAL SERVICES. BACKFILL AND GRADE SMOOTH FOR A COMPLETE TELEPHONE AND ELECTRIC INSTALLATION.  12. G.C. TO PROVIDE OPENING FOR CITY OF WENTZVILLE TO MAKE TAP. G.C. IS ALSO TO PROVIDE TRENCH, BACKFILL AND GRADE SMOOTH FOR A COMPLETE WATER LINE INSTALLATION.  13. EXISTING SANITARY SEWER SERVICE SHALL NOT BE INTERRUPTED.  14. THE CONTRACTOR SHALL INCLUDE THE COST ESTIMATE PROVIDED BY AMEREN UE - ELECTRIC FOR THE RELOCATION/REMOVAL OF ANY OVERHEAD ELECTRIC OR GUY WIRES IN HISHER BID.  15. THE CONTRACTOR SHALL INCLUDE FOR TELEPHONE INSTALLATION COSTS BY THE LOCAL PHONE COMPANY IN HISHER BID.  16. ALL MANHOLE AND CATCH BASIN TOPS BUILT WITHOUT ELEVATIONS FURNISHED BY THE ENGINEER WILL BE THE RESPONSIBILITY OF THE SEWER CONTRACTOR.  17. ALL WATER LINE CONSTRUCTION AND MATERIALS SHALL MEET THE SPECIFICATIONS AND INSTALLATION REQUIREMENTS OF CITY OF WENTZVILLE OF ST. CHARLES COUNTY.  18. ALL DUCTILE IRON PIPE FOR HYDRANTS AND VALVES SHALL CONFORM TO A.W.W.A. SPECIFICATION C-106 AND/OR C-108. THE DUCTILE IRON FITTINGS SHALL CONFORM TO A.W.W.A. SPECIFICATION C-110. ALL RUBBER GASKET JOINTS FOR WATER DUCTILE IRON PRESSURE PIPE AND FITTINGS SHALL CONFORM TO A.W.W.A. SPECIFICATION C-111.  19. THE EXTERIOR OF SANITARY SEWER MANHOLES SHALL BE WATERPROOFED IN ACCORDANCE WITH MISSOURI DEPARTMENT OF NATURAL RESOURCES SPECIFICATIONS, 10 CSR 8-120 (7)(E).  20. BRICK SHALL NOT BE USED ON MANHOLES.  21. THE CITY OF WENTZVILLE SHALL BE NOTIFIED A MINIMUM OF 72 HOURS IN ADVANCE OF CONSTRUCTION FOR COORDINATION AND INSPECTIONS.  22. ANY EXISTING IMPROVEMENTS DISTURBED, DAMAGED OR DESTROYED DURING CONSTRUCTION SHALL BE REPAIRED OR REPLACED TO EQUAL OR BETTER CONDITION.  23. ALL STORM AND SANITARY TRENCH BACKFILLS SHALL BE WATER JETTED, GRANULAR BACKFILL BE USED UNDER PAVEMENT AREAS. WATER JETTING SHALL BE 100% COMPLETE AND APPROVED PRIOR TO PAVING.  24. ALL SANITARY LATERALS SHALL BE 6" MINIMUM PER CITY OF WENTZVILLE STANDARDS.  25. ALL SANITARY LATERALS SHALL BE PRIVATE.  26. FLUSHING HYDRANTS OR WATER METERS SHALL NOT BE LOCATED IN DRIVEWAYS OR WALKS.  27. CONCRETE PIPE USED FOR STORM SEWER CONSTRUCTION SHALL BE CLASS III, ASTM C-76 WITH A MINIMUM DIAMETER OF 12".  28. ALL STORM SEWER PIPE INSTALLED WITHIN THE PUBLIC RIGHT-OF-WAY SHALL BE CLASS III REINFORCED CONCRETE.  29. LOCATION OF PROPOSED STREET LIGHTS IS APPROXIMATE. SUBMIT PHOTOMETRICS PLAN TO THE CITY OF WENTZVILLE FOR APPROVAL PRIOR TO CONSTRUCTION. STREET LIGHTS SHALL BE INSTALLED IN ACCORDANCE WITH AMEREN UE - ELECTRIC SPECIFICATIONS.  30. SOD WILL BE REQUIRED FOR ANY OFFSITE RESTORATION THAT IS NECESSARY UNLESS SPECIFIED OTHERWISE BY THE PROPERTY OWNERS.																	
8	<b>ABBREVIATIONS:</b>  AL_____ AREA INLET (OPEN 4 SIDES UNLESS NOTED OTHERWISE) DAL_____ DOUBLE AREA INLET (OPEN 4 SIDES UNLESS NOTED OTHERWISE) MH_____ MANHOLE CUI_____ CURB INLET GSI_____ GRADE INLET WITH SIDE INTAKE. (ELEVATION OF INLET TOP IS TO THE TOP OF GRADE. ADD 0.50 FOR TOP OF SIDE INTAKE.) 2GS_____ 2 GRADE INLET WITH SIDE INTAKE. (ELEVATION OF INLET TOP IS TO THE TOP OF GRADE. ADD 0.50 FOR TOP OF SIDE INTAKE.) EP_____ END OF PIPE FE_____ FLARED END SECTION MH_____ INTERCEPTOR MANHOLE TD_____ TRENCH DRAIN ATO_____ ADJUST TO GRADE H_____ DENOTES HYDRAULIC GRADE JUMP TBR_____ TO BE REMOVED TBR_____ TO BE REMOVED & REPLACED																	
7	<b>CITY OF WENTZVILLE GRADING NOTES</b>  1. CONSTRUCTION ACCESS TO SITE SHALL CONSIST OF A MINIMUM 25' x 50' TEMPORARY GRAVEL WASH DOWN AREA, LOCATED ADJACENT TO PAVEMENT. ALL TRUCKS SHALL BE WASHED DOWN PRIOR TO LEAVING SITE.  2. ALL SOFT SOILS SHOULD BE REMOVED, DOWN TO FIRM MATERIAL, PRIOR TO THE PLACEMENT OF FILL MATERIAL. THE SOFT SOILS MAY BE UTILIZED AS FILL, PROVIDED THAT THE MATERIAL IS SPREAD OUT TO DRY SUFFICIENTLY AND CAN BE COMPACTED TO THE REQUIREMENTS OF THE PROJECT SPECIFICATIONS.  3. NO SLOPE SHALL BE STEEPER THAN 3 HORIZONTAL TO 1 VERTICAL. ALL SLOPES SHALL BE SODDED OR SEEDED AND MULCHED.  4. CITY SHALL BE PROVIDED WITH A COPY OF GRADING COMPACTION TESTS RESULTS. IN AREAS OF PROPOSED PAVEMENT, A MINIMUM COMPACTION TO AT LEAST 90% OF MAXIMUM DRY DENSITY, AS DETERMINED BY THE MODIFIED PROCTOR TEST, OR 95% OF MAXIMUM DRY DENSITY, AS DETERMINED BY THE STANDARD PROCTOR TEST WILL BE REQUIRED, OR AS OTHERWISE RECOMMENDED BY THE GEOTECHNICAL SOILS REPORT.  5. ANY TRASH, DEBRIS, PAVEMENT OR FOUNDATION MATERIALS FROM ANY EXISTING OR PREVIOUS ON-SITE BUILDING, STRUCTURE, OR IMPROVEMENT MUST BE REMOVED FOR PROPER DISPOSAL OFF SITE, OR AS RECOMMENDED BY THE OWNERS LICENSED PROFESSIONAL ENGINEER.  6. ANY WELLS OR SPRINGS WHICH MAY EXIST ON THE PROPERTY SHOULD BE LOCATED. WELLS SHALL BE CAPPED AND SEALED IN ACCORDANCE WITH THE REQUIREMENTS OF THE MISSOURI DEPARTMENT OF NATURAL RESOURCES, AND IN A MANNER ACCEPTABLE TO THE CITY OF WENTZVILLE. SPRINGS SHALL BE HANDLED IN ACCORDANCE WITH THE RECOMMENDATIONS OF THE OWNERS LICENSED PROFESSIONAL ENGINEER.  7. ANY CONTAMINATED SOILS ENCOUNTERED DURING GRADING OPERATIONS SHALL BE HANDLED IN ACCORDANCE WITH THE OWNERS LICENSED PROFESSIONAL ENVIRONMENTAL ENGINEERING REPRESENTATIVE.																	
6	<b>ADA NOTES:</b>  1. CONTRACTOR SHALL CONFIRM ALL EXISTING SLOPES FOR ACCESSIBLE ROUTES AS WELL AS THE ACCESSIBLE PARKING STALLS AND ACCESSIBLE ASBLES WITH A SLOPE METER TO CONFIRM MAXIMUM SLOPES ARE NOT EXCEEDED.  2. CONTRACTOR IS REQUIRED TO PROVIDE AS-BUILT SPOT ELEVATIONS ALONG THE ACCESSIBLE ROUTES SHOWN ON THIS PLAN EVERY 10 FEET IN ORDER TO CONFIRM MAXIMUM (2%) CROSS-SLOPE AND MAXIMUM (5%) SLOPES IN THE DIRECTION OF TRAVEL. IN ADDITION, SPOT ELEVATIONS ARE REQUIRED ON ALL CORNERS AND MIDPOINTS OF ACCESSIBLE PARKING STALLS AND ACCESSIBLE ASBLES TO CONFIRM MAXIMUM 2% SLOPES ARE NOT EXCEEDED IN ALL DIRECTIONS. THIS INFORMATION SHALL BE PROVIDED, A MINIMUM OF 2 WEEKS BEFORE STORE TURNOVER.  3. THE GENERAL AND CONCRETE CONTRACTOR SHALL FIELD VERIFY ADA SLOPES DURING CONCRETE POUR. A 2" SMART LEVEL WITH AN ACCURACY TO .02% PERCENT SHALL BE USED FOR VERIFYING SLOPES. ANY SLOPES IN THE ADA AREAS THAT EXCEED A 2% CROSS SLOPE ALONG THE BUILDING, ADA STALLS AND/OR SIDEWALK, 5% RUNNING SLOPE FOR SIDEWALKS AWAY FROM THE PROPOSED CVS BUILDING, AND EXCEED 8.3% ON RAMP SHALL BE REMOVED AND REPLACED AT THE CONCRETE CONTRACTORS EXPENSE. THE SURVEYOR FOR STAKING CAN PROVIDE A REFERENCE FOR ELEVATION HOWEVER CONFIRMATION IS REQUIRED BY SLOPE LEVEL DURING CONSTRUCTION.																	
5	<b>ESTIMATED EARTHWORK QUANTITIES</b>  CUT = 36,106 CUBIC YARDS FILL = 42,220 CUBIC YARDS (1.12 FILL FACTOR) = 6,114 CY OFF ADDITIONAL FILL NEEDED  EARTHWORK QUANTITY NOTES:  1. THE CUT AND FILL QUANTITIES SHOWN ON THIS PLAN ARE FOR PERMITTING PURPOSES ONLY. THE GRADING CONTRACTOR IS CAUTIONED THAT THE QUANTITIES SHOWN ARE THE ENGINEERS ESTIMATE FOR PERMITTING PURPOSES ONLY. THE GRADING CONTRACTOR SHALL COMPLETE HIS/HER OWN ESTIMATE WHEN BIDDING. NO ADDITIONAL COSTS WILL BE ALLOWED FOR GRADING WITHOUT JUSTIFICATION DUE TO PLAN CHANGES OR REVISIONS.  2. TRUCKS SHALL NOT EXCEED POSTED WEIGHT LIMITS FOR THE ST. CHARLES COUNTY AND MODOT BRIDGES DURING HAUL OPERATIONS.  TOTAL AREA TO BE DISTURBED = 10.37 ACRES.																	
4	GENERAL CONTRACTOR SHALL REFERENCE FINAL GEOTECHNICAL REPORT FOR ADDITIONAL REQUIREMENTS. ALL SITE WORK, PAVING, AND BUILDING PAD PREPARATION IS TO COMPLY WITH GEOTECHNICAL RECOMMENDATIONS AND REQUIREMENTS.																	
3																		
2																		
1																		



5039 S National Avenue | Springfield, MO 65810 | 417.887.6595

**OWNER**  
CITY OF WENTZVILLE  
1001 SCHROEDER CREEK BLVD.  
WENTZVILLE, MO 63385  
636.327.5101

**PROJECT TEAM**  
**CIVIL ENGINEER**  
PREMIER DESIGN GROUP  
100 MIDLAND PARK DRIVE  
WENTZVILLE, MO 63385  
314.925.7444


**MAINTENANCE CONSULTANT**  
HDR ENGINEERING, INC.  
17725 KATY FREEWAY SUITE 102  
HOUSTON, TX 77064  
816.980.2700

**STRUCTURAL ENGINEER**  
METTUSSEY ENGINEERING  
2225 W CHESTERFIELD BLVD., SUITE 300  
SPRINGFIELD, MO 65807  
417.893.8022

**MEP ENGINEER**  
HENDERSON ENGINEERS, INC.  
8345 LENEXA DR., #300  
LENEXA, KS 66214  
913.742.5000

REVISIONS		
-----------	--	--



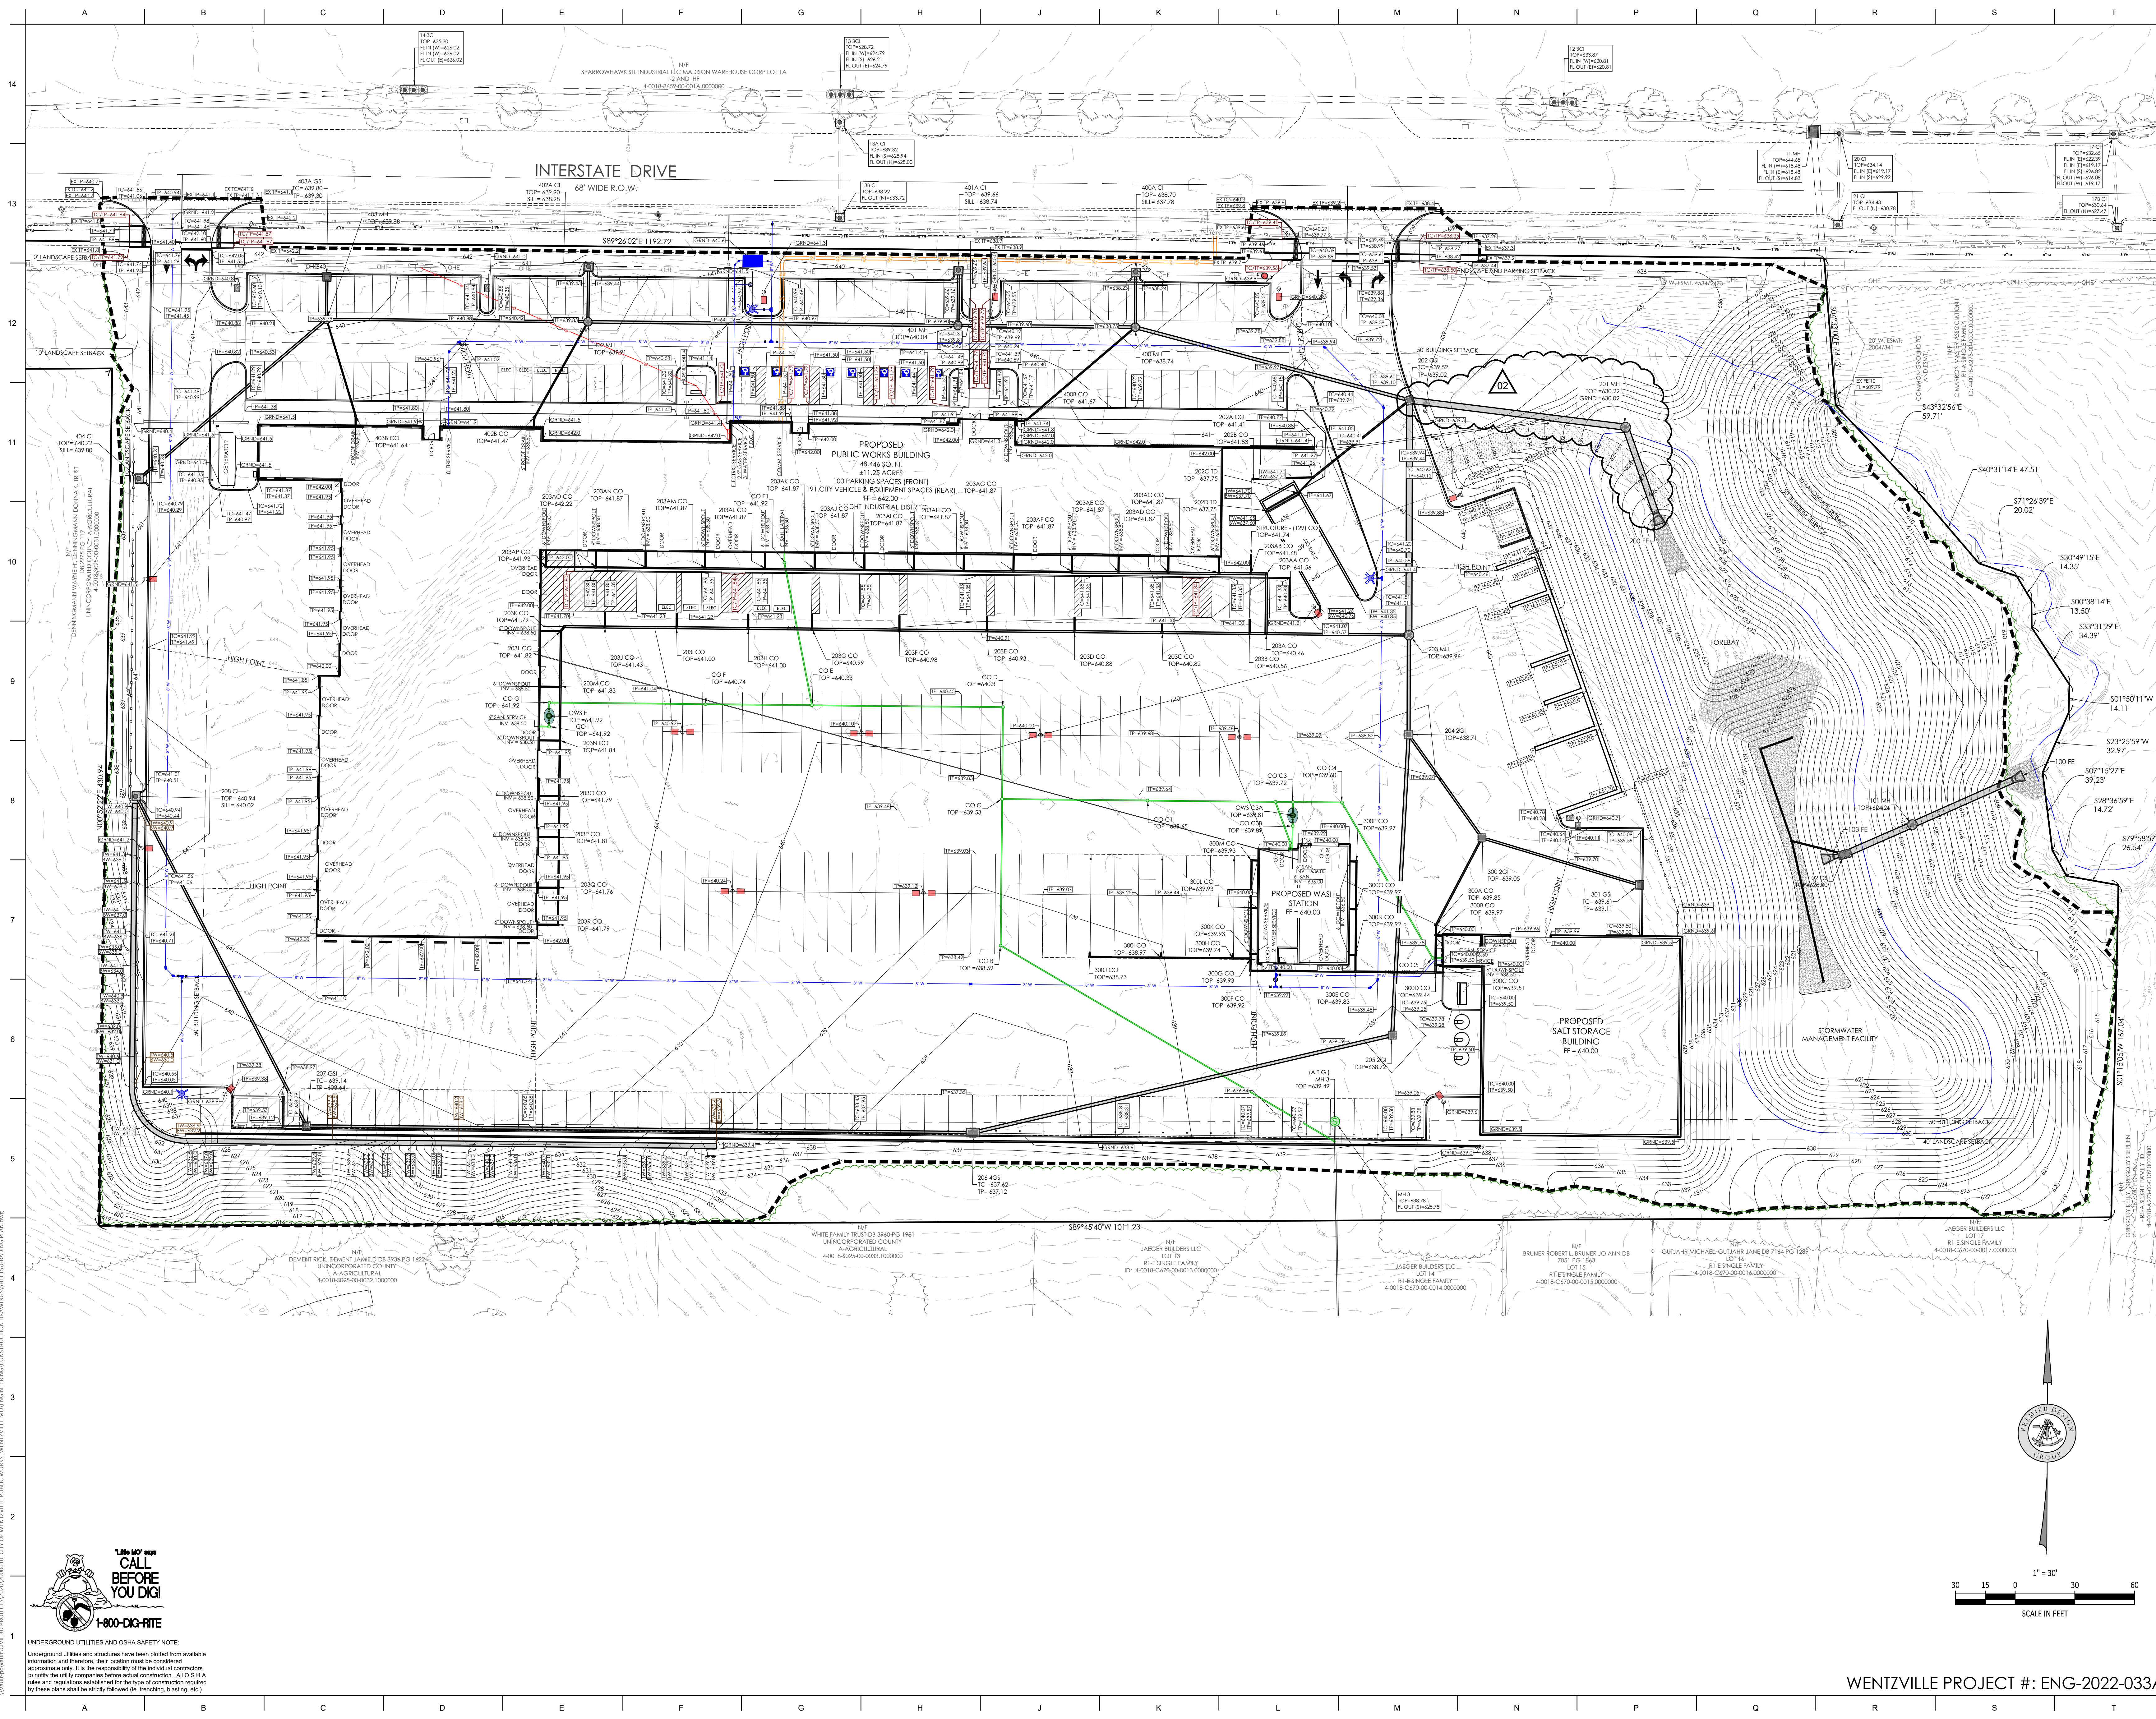

**1-800-DOG-HITE**  
**CALL BEFORE YOU DIG!**

UNDERGROUND UTILITIES AND OSHA SAFETY NOTE:  
Underground utilities and structures have been plotted from available information and therefore, their location must be considered approximate only. It is the responsibility of the individual contractors to verify the utility companies before actual construction. All OSHA rules and regulations established for the type of construction required by these plans shall be strictly followed (e.g. trenching, blasting, etc.)

5039 S National Avenue | Springfield, MO 65810 | 417.887.8595

**OWNER**  
CITY OF WENTVILLE  
1001 SCHROEDER CREEK BLVD.  
WENTVILLE, MO 63385  
636.327.5101

**PROJECT TEAM**  
**CIVIL ENGINEER**  
PREMIER DESIGN GROUP  
100 MIDLAND PARK DRIVE  
WENTVILLE, MO 63385  
314.925.7444  
**MAINTENANCE CONSULTANT**  
HDR ENGINEERING, INC.  
17725 KATY FREEWAY SUITE 102  
HOUSTON, TX 77054  
816.980.2700  
**STRUCTURAL ENGINEER**  
METTMEYER ENGINEERING  
2225 W CHESTERFIELD BLVD., SUITE 300  
SPRINGFIELD, MO 65807  
417.880.8022  
**MEP ENGINEER**  
HENDERSON ENGINEERS, INC.  
8345 LENEXA DR., #300  
LENEXA, KS 66214  
913.742.5000

NO.	DESCRIPTION	DATE
1	ADD 01	1/11/2023
2	ADD 02	1/25/2023

PROJECT NO.: 19-040 DRAWN BY: J.R. & A.J.  
DATE: 12.15.22 REVIEWED BY: M.F.

**PROFESSIONAL SEAL**

ENGINEERS AUTHENTICATION  
The undersigned hereby certifies that the project is the work of the undersigned or under the direct supervision and control of the undersigned, and that the undersigned is duly licensed and qualified to perform the services herein required.  
STEVEN D. MARON, P.E.  
PROFESSIONAL ENGINEER  
PE 0200807195

**PROJECT TITLE**  
CITY OF WENTVILLE, MO PUBLIC WORKS FACILITY

**PROJECT ADDRESS:**  
1295 INTERSTATE DRIVE  
WENTVILLE, MO 63385

**GRADING PLAN**

1

NOT RELEASED FOR CONSTRUCTION



**OWNER**  
CITY OF WENTZVILLE  
1001 SCHROEDER CREEK BLVD.  
WENTZVILLE, MO 63385  
636.327.5101

**PROJECT TEAM**  
**CIVIL ENGINEER**  
PREMIER DESIGN GROUP  
100 MIDLAND PARK DRIVE  
WENTZVILLE, MO 63385  
314.925.7444

**MAINTENANCE CONSULTANT**  
HDR ENGINEERING, INC.  
1725 KATY FREEWAY SUITE 102  
HOUSTON, TX 77004  
816.380.2700

**STRUCTURAL ENGINEER**  
METTEMEYER ENGINEERING  
2225 W CHESTERFIELD BLVD., SUITE 300  
SPRINGFIELD, MO 65807  
417.880.8002

**MEP ENGINEER**  
HENDERSON ENGINEERS, INC.  
8345 LENEXA DR., #300  
LENEXA, KS 66214  
913.742.5000

REVISIONS		
NO.	DESCRIPTION	DATE
1	ADD 01	1/11/2023
2	ADD 02	1/25/2023

PROJECT NO.: 19-040 DRAWN BY: J.R. & A.J.  
DATE: 12.15.22 REVIEWED BY: M.F.

**PROFESSIONAL SEAL**



**ENGINEER'S AUTHENTICATION**  
The undersigned hereby certifies that he/she is a duly licensed professional engineer in the State of Missouri and that he/she is the author of the design shown on this plan. The undersigned also certifies that the design was prepared by him/her or under his/her direct supervision and that he/she is a duly licensed professional engineer in the State of Missouri.


**PROJECT TITLE**  
CITY OF WENTZVILLE, MO PUBLIC  
WORKS FACILITY  
**PROJECT ADDRESS:**  
1295 INTERSTATE DRIVE  
WENTZVILLE, MO 63385

**UTILITY PLAN**

SHEET

C-400




NOT RELEASED FOR CONSTRUCTION

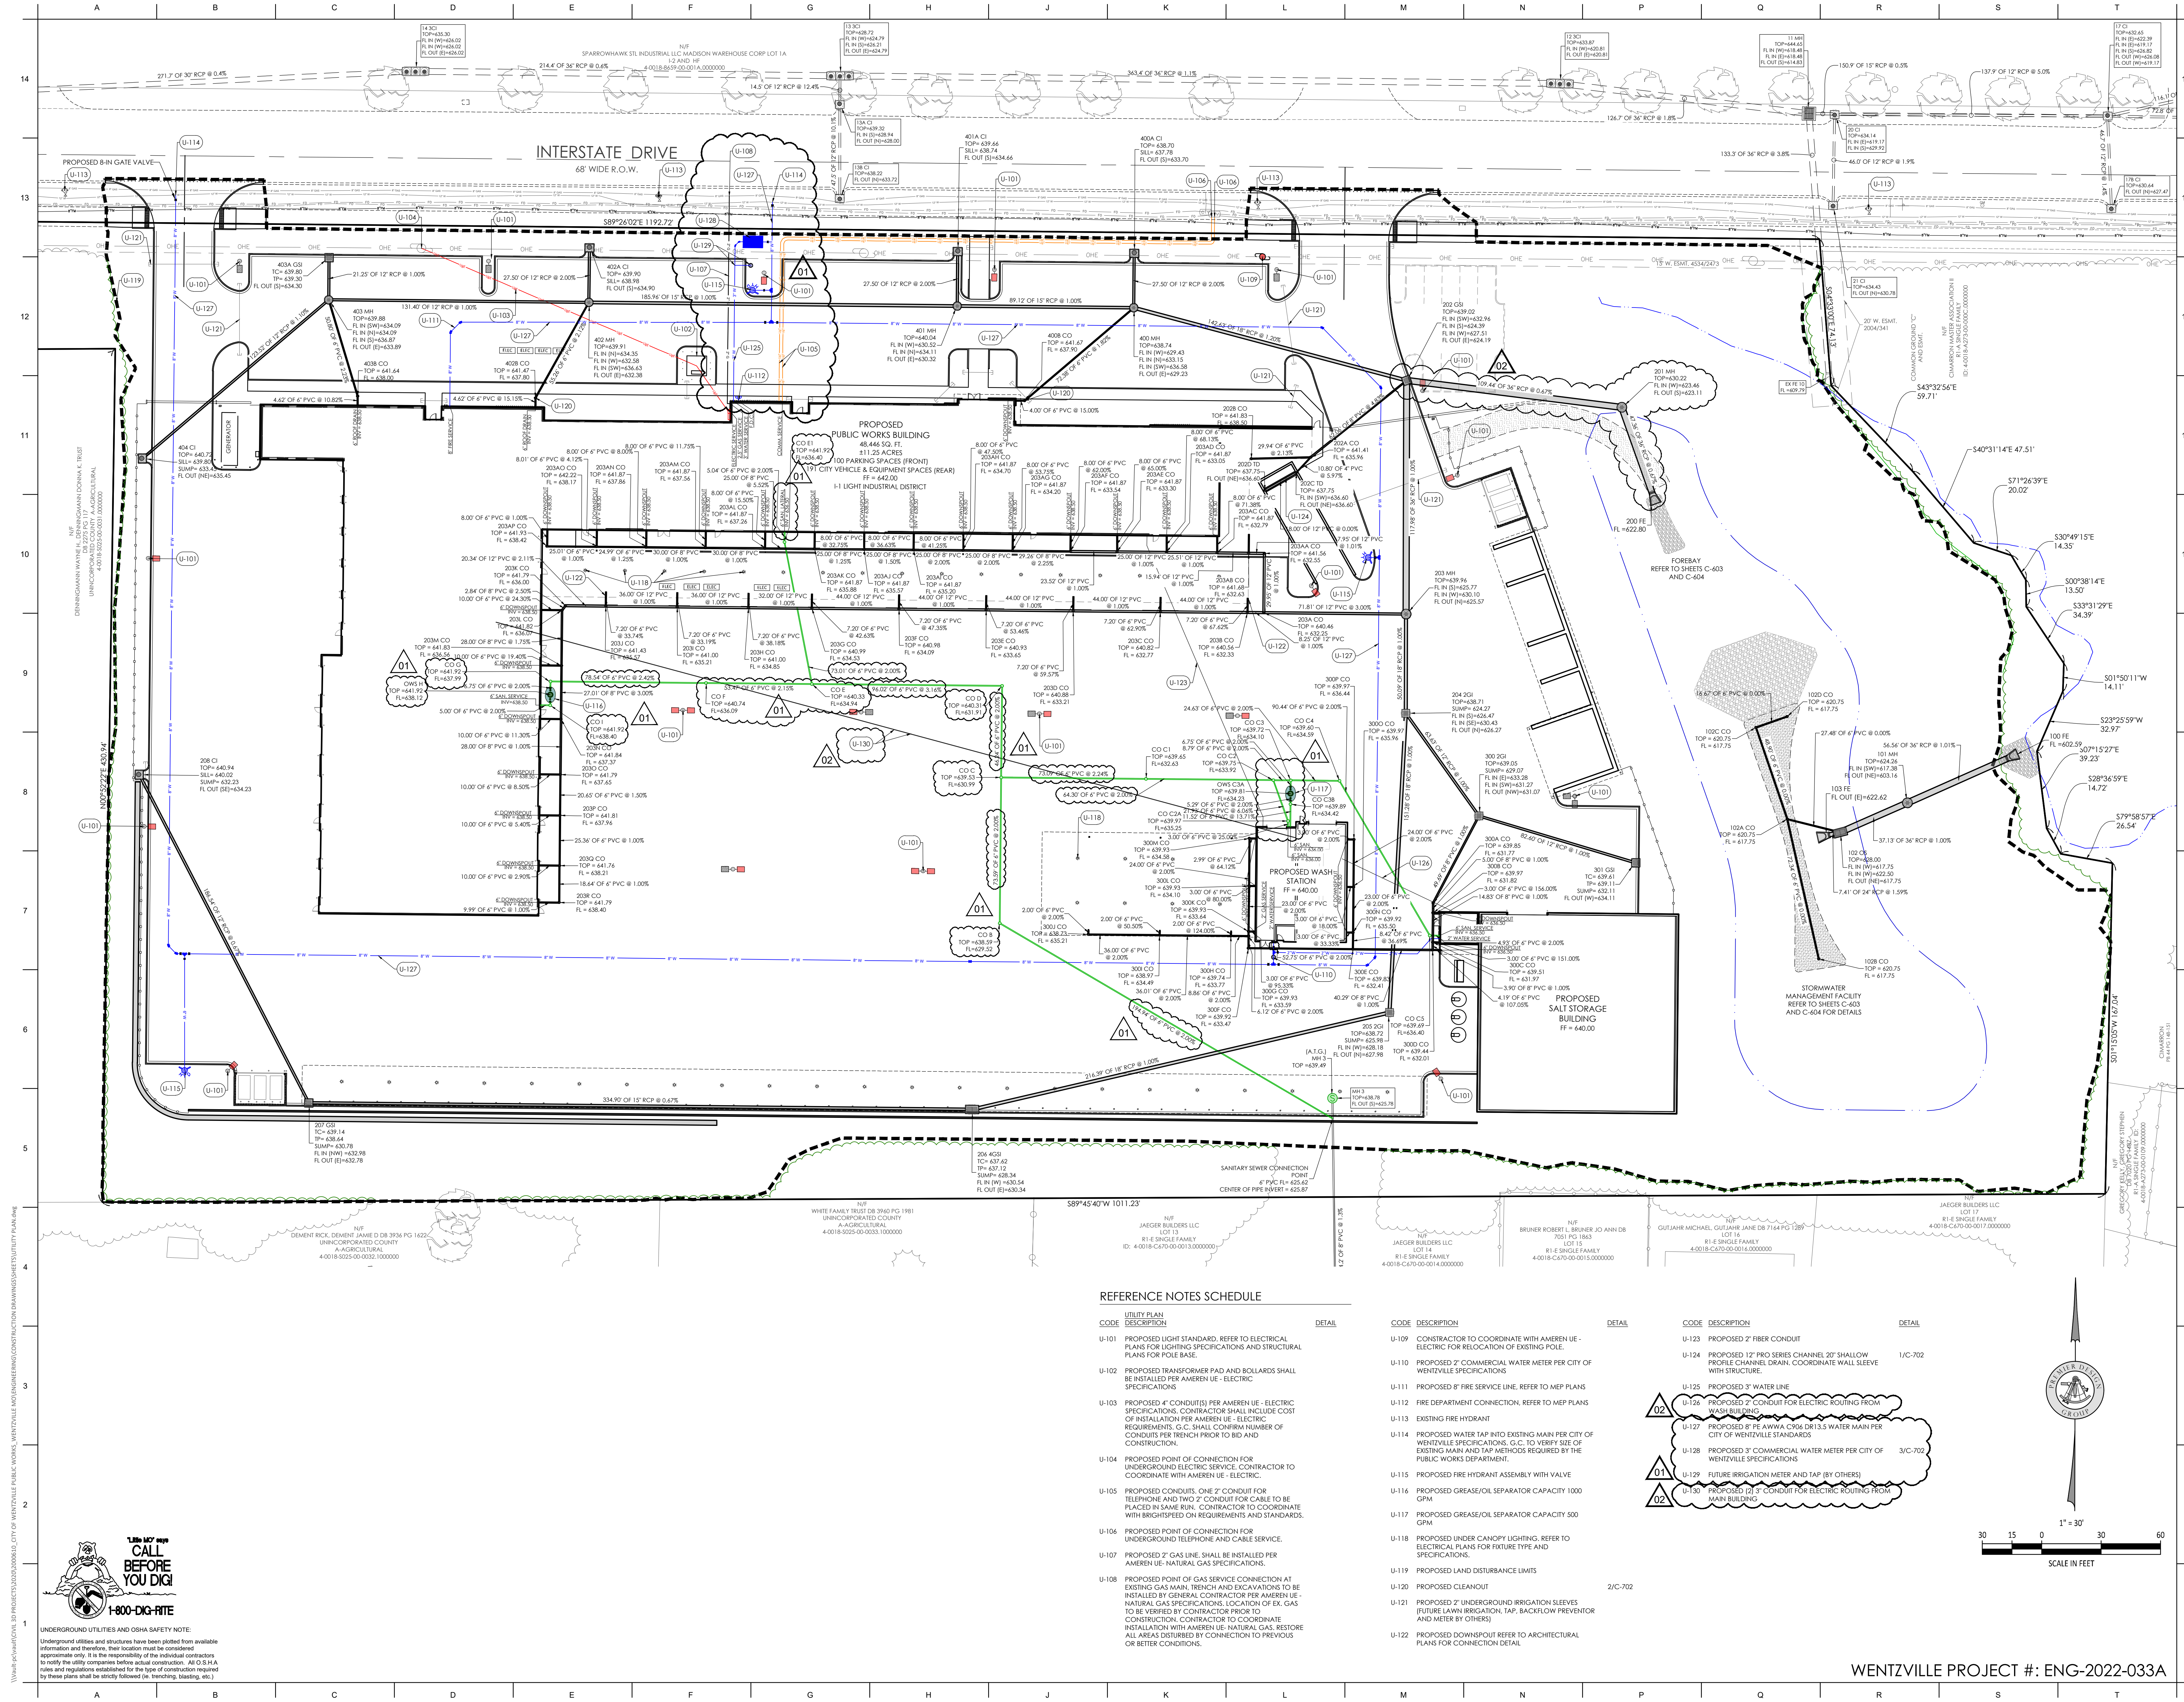

REFERENCE NOTES SCHEDULE

CODE	DESCRIPTION	DETAIL
U-101	PROPOSED LIGHT STANDARD, REFER TO ELECTRICAL PLANS FOR LIGHTING SPECIFICATIONS AND STRUCTURAL PLANS FOR POLE BASE.	
U-102	PROPOSED TRANSFORMER PAD AND BOLLARDS SHALL BE INSTALLED PER AMEREN UE - ELECTRIC SPECIFICATIONS.	
U-103	PROPOSED 4" CONDUITS PER AMEREN UE - ELECTRIC SPECIFICATIONS, CONTRACTOR SHALL INCLUDE COST OF INSTALLATION PER AMEREN UE - ELECTRIC SPECIFICATIONS. SEE SMALL CONDUIT NUMBER OF CONDUITS PER TRENCH PRIOR TO BID AND CONSTRUCTION.	
U-104	PROPOSED POINT OF CONNECTION FOR UNDERGROUND ELECTRIC SERVICE, CONTRACTOR TO COORDINATE WITH AMEREN UE - ELECTRIC.	
U-105	PROPOSED CONDUITS, ONE 2" CONDUIT FOR TELEPHONE AND TWO 2" CONDUIT FOR CABLE TO BE PLACED IN SAME RUN. CONTRACTOR TO COORDINATE WITH BRIGHTSPEED ON REQUIREMENTS AND STANDARDS.	
U-106	PROPOSED POINT OF CONNECTION FOR UNDERGROUND TELEPHONE AND CABLE SERVICE.	
U-107	PROPOSED 2" GAS LINE, SHALL BE INSTALLED PER AMEREN UE - NATURAL GAS SPECIFICATIONS.	
U-108	PROPOSED POINT OF GAS SERVICE CONNECTION AT EXISTING GAS MAIN, TRENCH AND EXCAVATIONS TO BE INSTALLED BY GENERAL CONTRACTOR PER AMEREN UE - NATURAL GAS SPECIFICATIONS. LOCATION OF EX. GAS TO BE VERIFIED BY CONTRACTOR PRIOR TO CONSTRUCTION. CONTRACTOR TO COORDINATE INSTALLATION WITH AMEREN UE - NATURAL GAS. RESTORE ALL AREAS DISTURBED BY CONTRACTOR TO PREVIOUS OR BETTER CONDITIONS.	


CODE	DESCRIPTION	DETAIL
U-109	CONTRACTOR TO COORDINATE WITH AMEREN UE - ELECTRIC FOR RELOCATION OF EXISTING POLE.	
U-110	PROPOSED 2" COMMERCIAL WATER METER PER CITY OF WENTZVILLE SPECIFICATIONS.	
U-111	PROPOSED 8" FIRE SERVICE LINE, REFER TO MEP PLANS.	
U-112	FIRE DEPARTMENT CONNECTION, REFER TO MEP PLANS.	
U-113	EXISTING FIRE HYDRANT	
U-114	PROPOSED WATER TAP INTO EXISTING MAIN PER CITY OF WENTZVILLE SPECIFICATIONS, G.C. TO VERIFY SIZE OF EXISTING MAIN AND TAP METHODS REQUIRED BY THE PUBLIC WORKS DEPARTMENT.	
U-115	PROPOSED FIRE HYDRANT ASSEMBLY WITH VALVE	
U-116	PROPOSED GREASE/OIL SEPARATOR CAPACITY 1000 GPM	
U-117	PROPOSED GREASE/OIL SEPARATOR CAPACITY 500 GPM	
U-118	PROPOSED UNDER CANOPY LIGHTING, REFER TO ELECTRICAL PLANS FOR FIXTURE TYPE AND SPECIFICATIONS.	
U-119	PROPOSED LAND DISTURBANCE LIMITS	
U-120	PROPOSED CLEANOUT	2/C-702
U-121	PROPOSED 2" UNDERGROUND IRRIGATION SLEEVES (FUTURE LAWN IRRIGATION, TAP, BACKFLOW PREVENTOR AND METER BY OTHERS)	
U-122	PROPOSED DOWNPOUT REFER TO ARCHITECTURAL PLANS FOR CONNECTION DETAIL.	

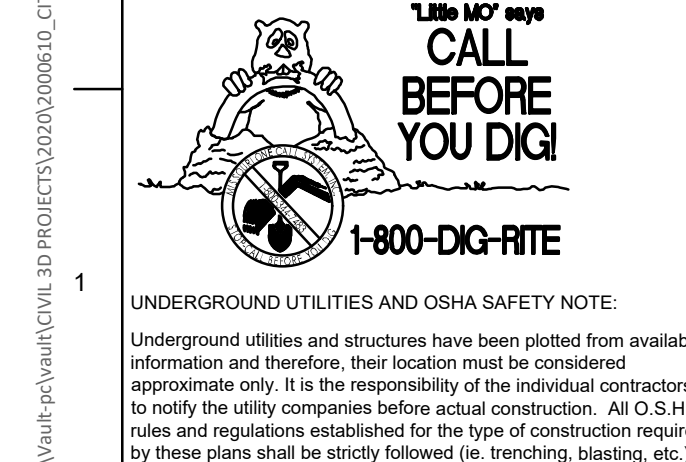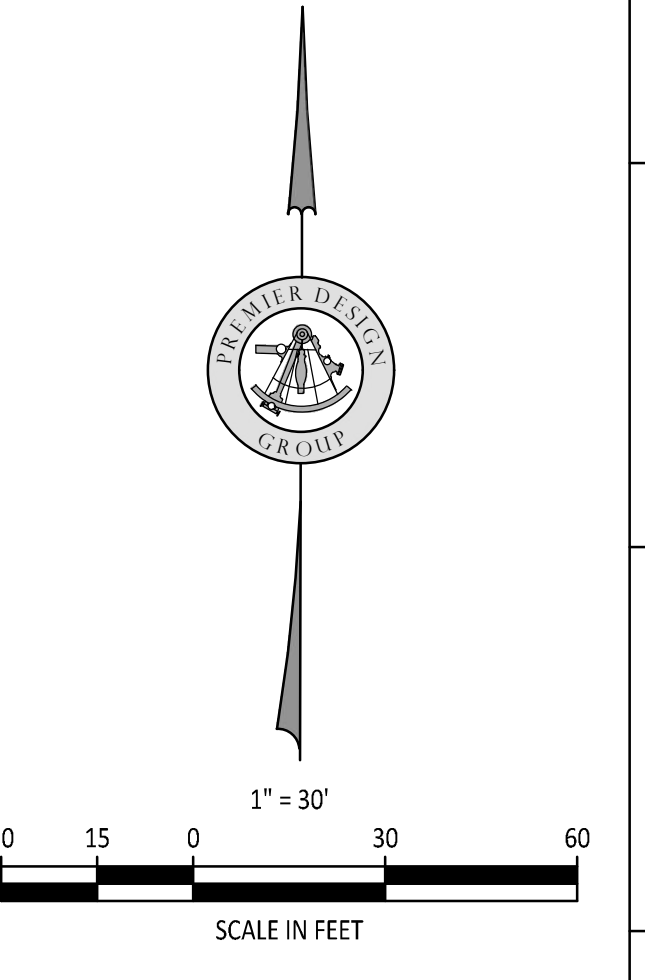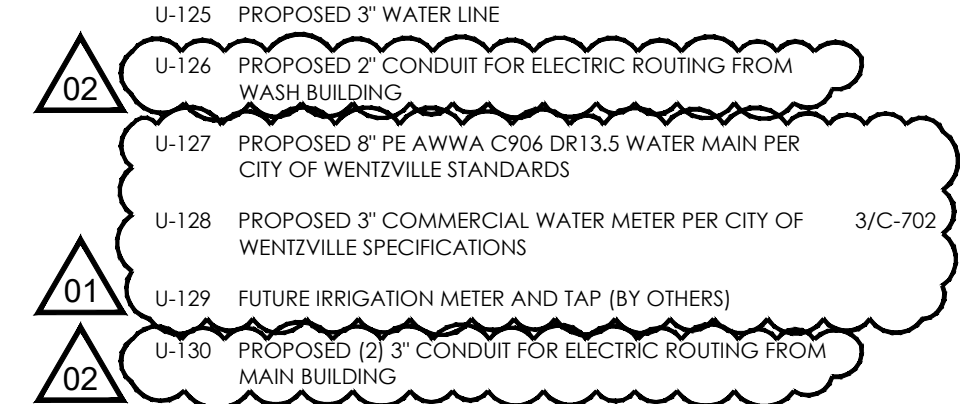

**UNDERGROUND UTILITIES AND OSHA SAFETY NOTE:**  
Underground utilities and structures have been plotted from available information and therefore, their location must be considered approximate only. It is the responsibility of the individual contractors to notify the utility companies before actual construction. All OSHA rules and regulations established for the type of construction required by these plans shall be strictly followed (ie. trenching, blasting, etc.)

WENTZVILLE PROJECT #: ENG-2022-033A



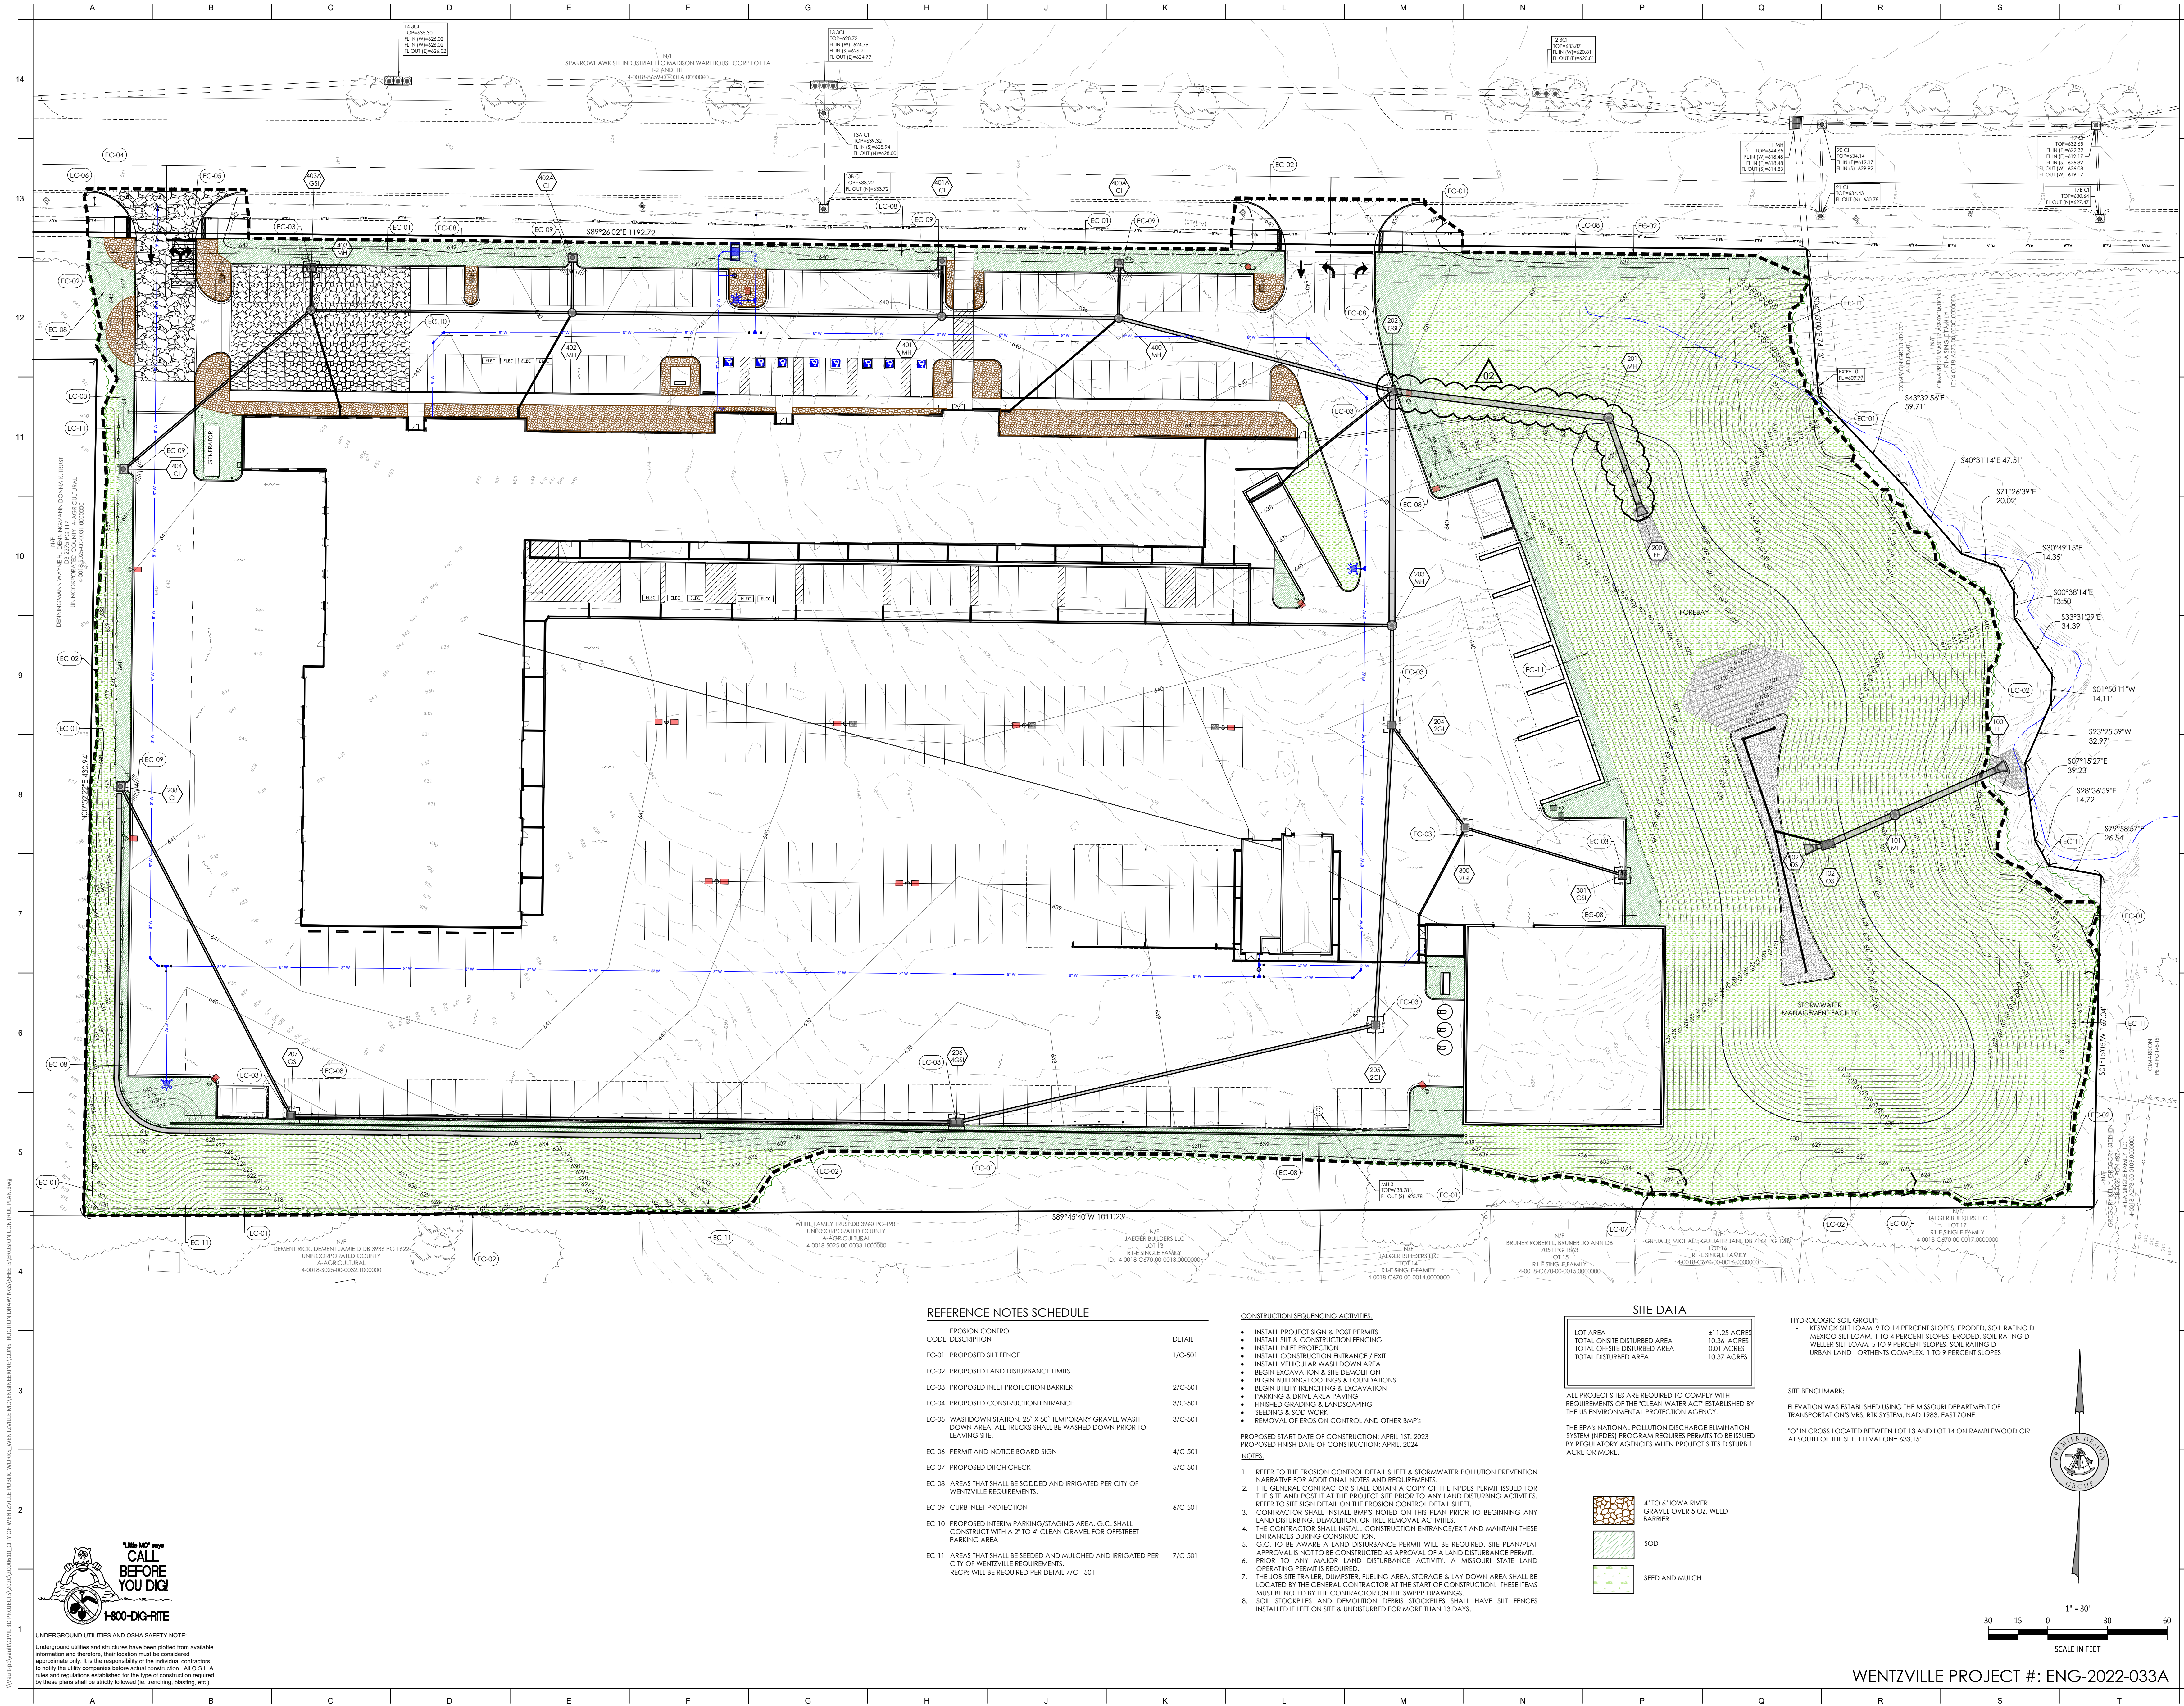

**OWNER**  
CITY OF WENTZVILLE  
1001 SCHROEDER CREEK BLVD.  
WENTZVILLE, MO 63385  
636.327.5101

**PROJECT TEAM**  
CIVIL ENGINEER  
PREMIER DESIGN GROUP  
100 MIDLAND PARK DRIVE  
WENTZVILLE, MO 63385  
314.925.7444

MAINTENANCE CONSULTANT  
HDR ENGINEERING, INC.  
17725 KATY FREEWAY SUITE 102  
HOUSTON, TX 77054  
816.880.2700

STRUCTURAL ENGINEER  
METTEMAYER ENGINEERING  
2225 W CHESTERFIELD BLVD., SUITE 300  
SPRINGFIELD, MO 65807  
417.880.8002

MEP ENGINEER  
HENDERSON ENGINEERS, INC.  
8345 LENEXA DR., #300  
LENEXA, KS 66214  
913.742.5000

REVISIONS		
NO.	DESCRIPTION	DATE
1	ADD 01	1/11/2023
2	ADD 02	1/25/2023

PROJECT NO.: 19-040 DRAWN BY: J.R. & A.J.  
DATE: 12.15.22 REVIEWED BY: M.F.

**PROFESSIONAL SEAL**



ENGINEER'S AUTHENTICATION  
The responsibility for professional engineering liability on this project is hereby assigned to the engineer of record. The engineer of record, and date hereunder attached, shall be held responsible for all other engineering plans created in this project and specifically related to this project.

STEVEN D. MARON, P.E.  
PROFESSIONAL ENGINEER  
PE 0006007195

**PROJECT TITLE**  
CITY OF WENTZVILLE, MO PUBLIC  
WORKS FACILITY  
PROJECT ADDRESS:  
1298 INTERSTATE DRIVE  
WENTZVILLE, MO 63385

**EROSION CONTROL PLAN**

NOT RELEASED FOR CONSTRUCTION

**REFERENCE NOTES SCHEDULE**

CODE	EROSION CONTROL DESCRIPTION	DETAIL
EC-01	PROPOSED Silt Fence	1/C-501
EC-02	PROPOSED Land Disturbance Limits	
EC-03	PROPOSED Inlet Protection Barrier	2/C-501
EC-04	PROPOSED Construction Entrance	3/C-501
EC-05	Washdown Station, 25' x 50' Temporary Gravel Wash Down Area. All Trucks shall be washed down prior to leaving site.	3/C-501
EC-06	Permit and Notice Board Sign	4/C-501
EC-07	Proposed Ditch Check	5/C-501
EC-08	Areas that shall be sodded and irrigated per City of Wentzville requirements.	
EC-09	Curbs Inlet Protection	6/C-501
EC-10	Proposed Interim Parking/Staging Area, G.C. shall construct with a 2" to 4" clean gravel for off-street parking area.	
EC-11	Areas that shall be seeded and mulched and irrigated per City of Wentzville requirements. RCPIs will be required per detail 7/C-501	7/C-501

**CONSTRUCTION SEQUENCING ACTIVITIES:**

- INSTALL PROJECT SIGN & POST PERMITS
  - INSTALL Silt & CONSTRUCTION FENCING
  - INSTALL INLET PROTECTION
  - INSTALL CONSTRUCTION ENTRANCE / EXIT
  - INSTALL VEHICULAR WASH DOWN AREA
  - BEGIN EXCAVATION & SITE DEMOLITION
  - BEGIN BUILDING FOOTINGS & FOUNDATIONS
  - BEGIN UTILITY TRENCHING & EXCAVATION
  - PARKING & DRIVE AREA PAVING
  - FINISHED GRADING & LANDSCAPING
  - SEEDING & SOD WORK
  - REMOVAL OF EROSION CONTROL AND OTHER BMP'S
- PROPOSED START DATE OF CONSTRUCTION: APRIL 15, 2023  
PROPOSED FINISH DATE OF CONSTRUCTION: APRIL 2024
- NOTES:**
- REFER TO THE EROSION CONTROL DETAIL SHEET & STORMWATER POLLUTION PREVENTION NARRATIVE FOR ADDITIONAL NOTES AND REQUIREMENTS.
  - THE GENERAL CONTRACTOR SHALL OBTAIN A COPY OF THE NPDES PERMIT ISSUED FOR THE SITE AND POST IT AT THE PROJECT SITE PRIOR TO ANY LAND DISTURBING ACTIVITIES. REFER TO SITE SIGN DETAIL ON THE EROSION CONTROL DETAIL SHEET.
  - CONTRACTOR SHALL INSTALL BMP'S NOTED ON THIS PLAN PRIOR TO BEGINNING ANY LAND DISTURBING, DEMOLITION, OR TREE REMOVAL ACTIVITIES.
  - THE CONTRACTOR SHALL INSTALL CONSTRUCTION ENTRANCE/EXIT AND MAINTAIN THESE ENTRANCES DURING CONSTRUCTION.
  - G.C. TO BE AWARE A LAND DISTURBANCE PERMIT WILL BE REQUIRED. SITE PLAN/PLAT APPROVAL IS NOT TO BE CONSTRUCTED AS APPROVAL OF A LAND DISTURBANCE PERMIT.
  - PRIOR TO ANY MAJOR LAND DISTURBANCE ACTIVITY, A MISSOURI STATE LAND OPERATING PERMIT IS REQUIRED.
  - THE JOB SITE TRAILER, DUMPSTER, FUELING AREA, STORAGE & LAY-DOWN AREA SHALL BE LOCATED BY THE GENERAL CONTRACTOR AT THE START OF CONSTRUCTION. THESE ITEMS MUST BE NOTED BY THE CONTRACTOR ON THE SWPPP DRAWINGS.
  - SOIL STOCKPILES & DEMOLITION DEBRIS STOCKPILES SHALL HAVE SILT FENCES INSTALLED & LEFT ON SITE & UNDISTURBED FOR MORE THAN 13 DAYS.

**SITE DATA**

LOT AREA	±11.25 ACRES
TOTAL ON-SITE DISTURBED AREA	10.36 ACRES
TOTAL OFF-SITE DISTURBED AREA	0.01 ACRES
TOTAL DISTURBED AREA	10.37 ACRES

ALL PROJECT SITES ARE REQUIRED TO COMPLY WITH REQUIREMENTS OF THE "CLEAN WATER ACT" ESTABLISHED BY THE US ENVIRONMENTAL PROTECTION AGENCY.

THE EPA'S NATIONAL POLLUTION DISCHARGE ELIMINATION SYSTEM (NPDES) PROGRAM REQUIRES PERMITS TO BE ISSUED BY REGULATORY AGENCIES WHEN PROJECT SITES DISTURB 1 ACRE OR MORE.

- 4" TO 6" IOWA RIVER GRAVEL OVER 5 OZ. WEED BARRIER
- SOD
- SEED AND MULCH


**HYDROLOGIC SOIL GROUP:**  
KEYHICK SET LOAM, 9 TO 14 PERCENT SLOPES, ERODED, SOIL RATING D  
- MEXICO SILT LOAM, 1 TO 4 PERCENT SLOPES, ERODED, SOIL RATING D  
- WELLS SILT LOAM, 5 TO 9 PERCENT SLOPES, SOIL RATING D  
- URBAN LAND - CRITHENS COMPLEX, 1 TO 9 PERCENT SLOPES

**SITE BENCHMARK:**  
ELEVATION WAS ESTABLISHED USING THE MISSOURI DEPARTMENT OF TRANSPORTATION'S VRS, RTK SYSTEM, NAD 1983, EAST ZONE.

"0" IN CROSS LOCATED BETWEEN LOT 13 AND LOT 14 ON RAMBLEWOOD CIR AT SOUTH OF THE SITE. ELEVATION = 633.15'





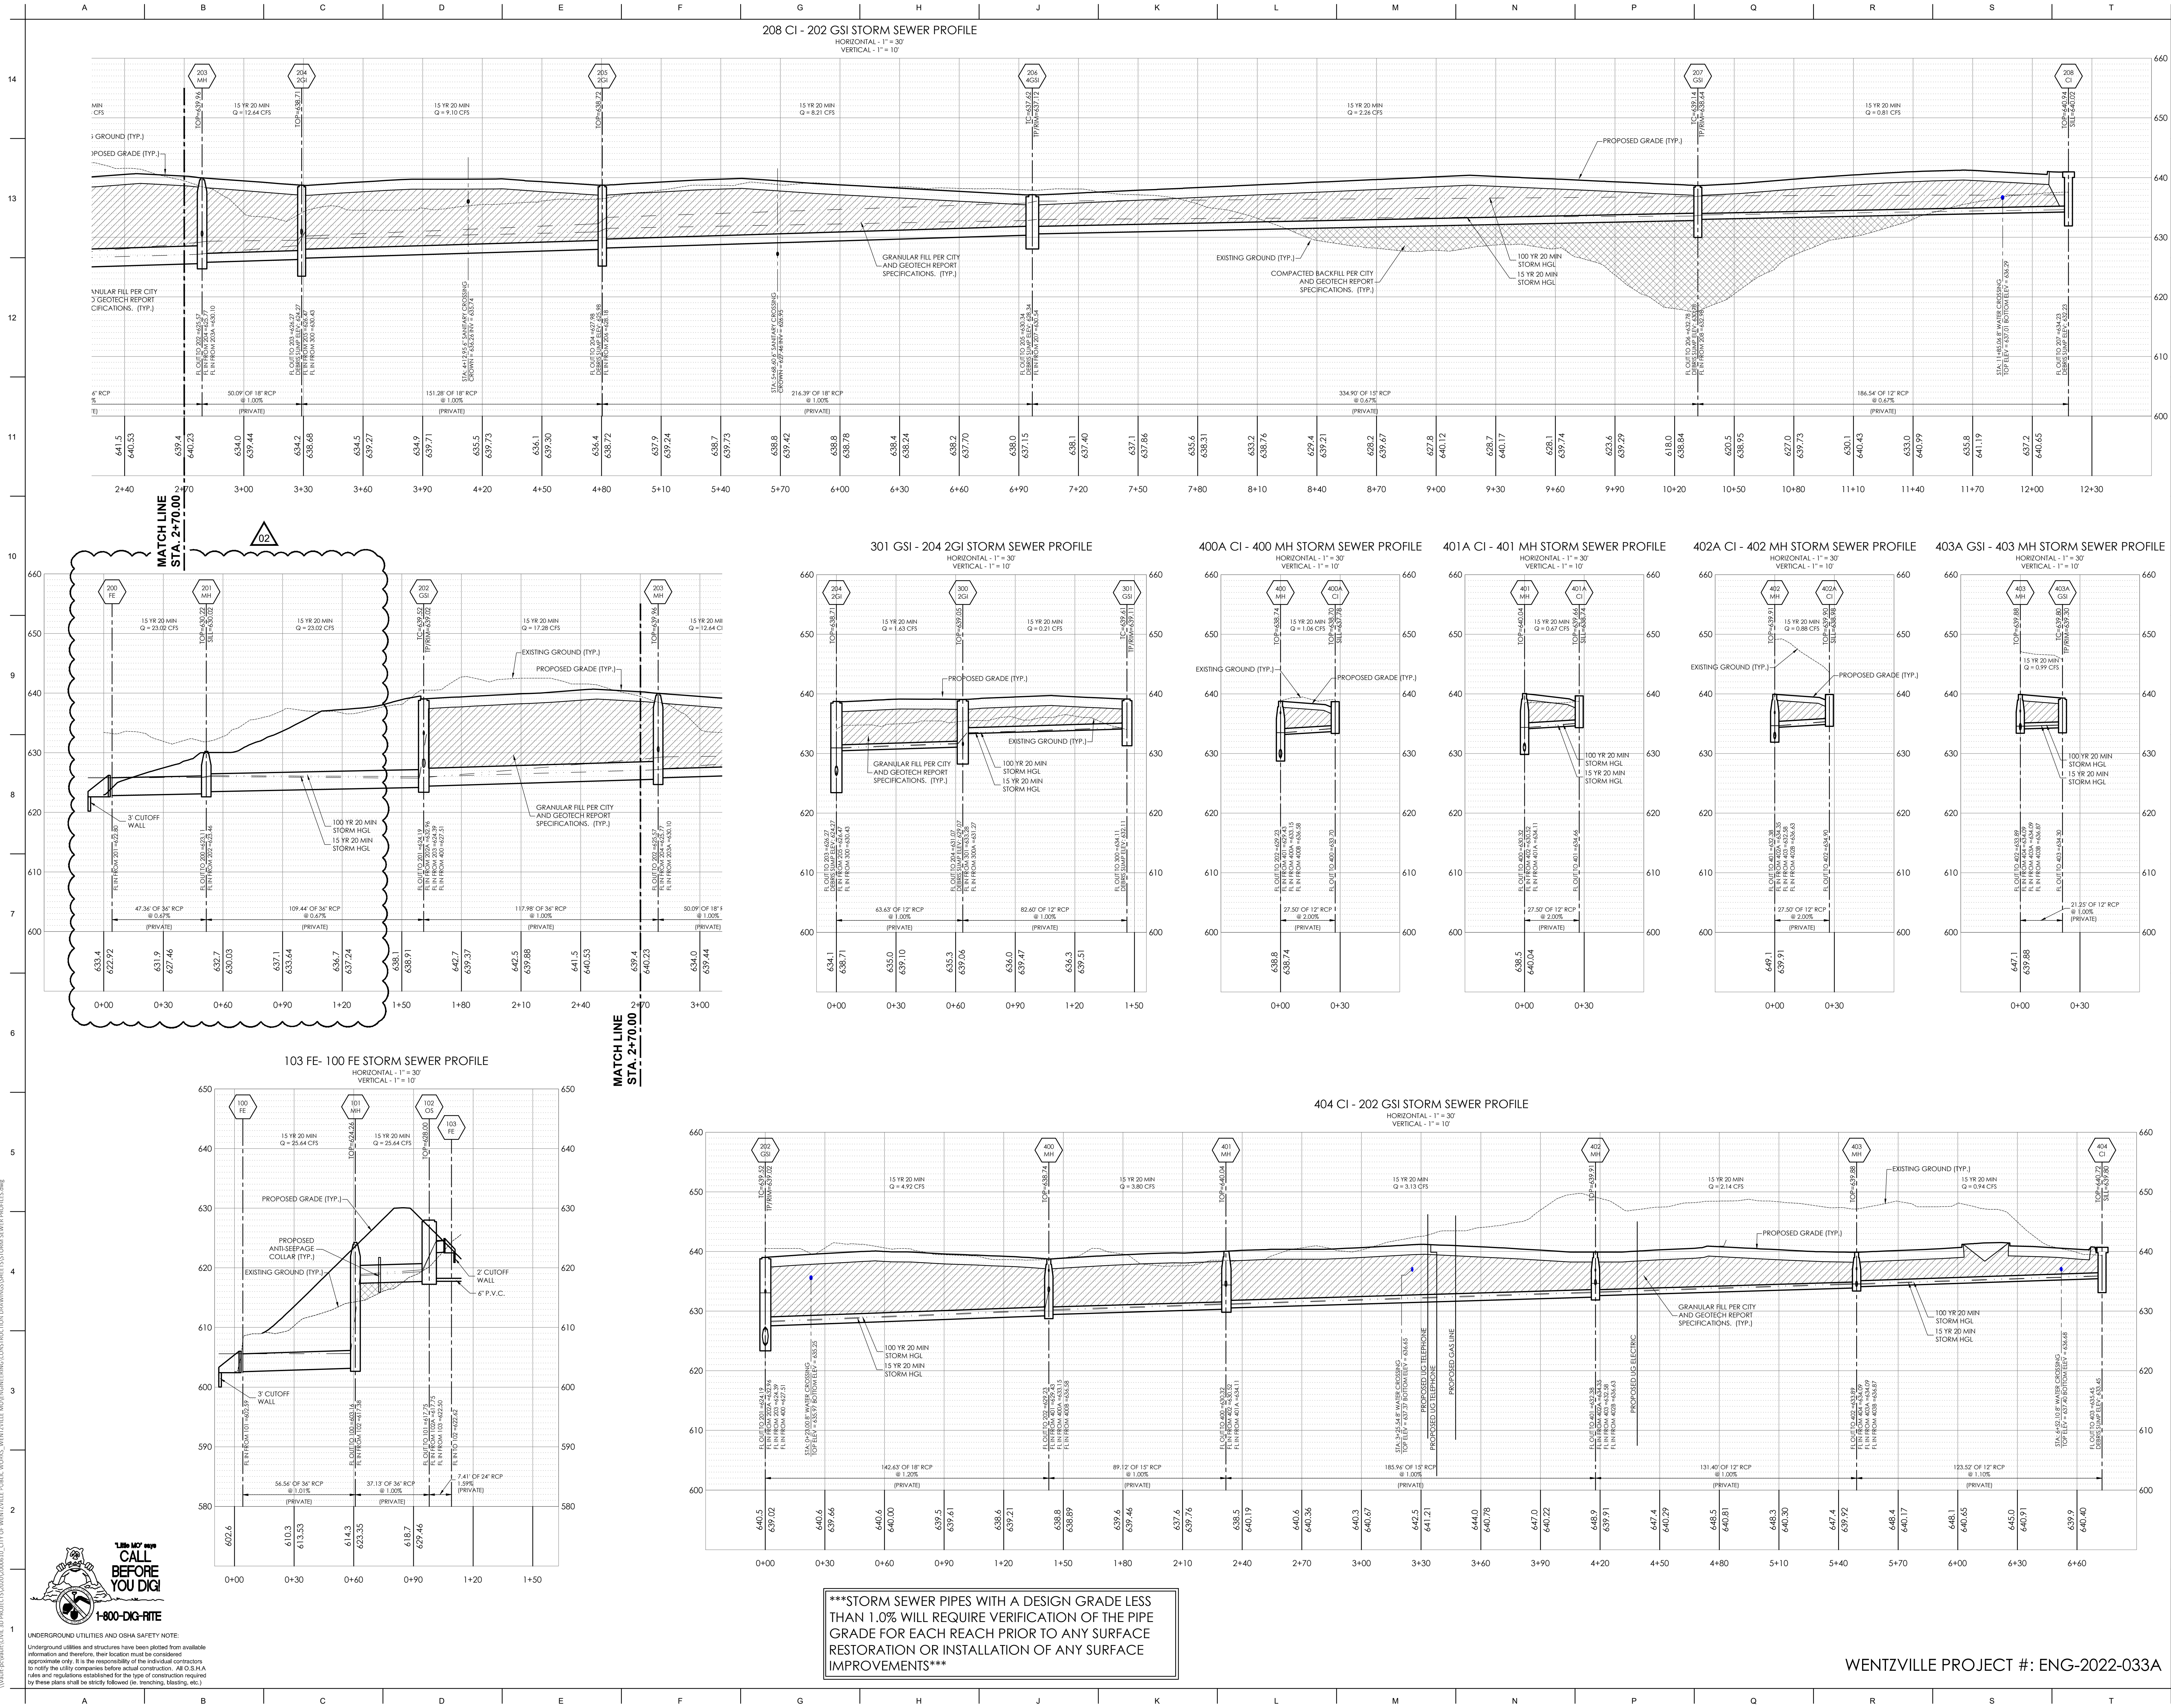

5039 S National Avenue | Springfield, MO 65810 | 417.887.8595

**OWNER**  
CITY OF WENTZVILLE  
1001 SCHROEDER CREEK BLVD.  
WENTZVILLE, MO 63385  
636.327.5101

**PROJECT TEAM**  
**CIVIL ENGINEER**  
PREMIER DESIGN GROUP  
100 MIDLAND PARK DRIVE  
WENTZVILLE, MO 63385  
314.925.7444

**MAINTENANCE CONSULTANT**  
HDR ENGINEERING, INC.  
17725 KATY FREEWAY SUITE 102  
HOUSTON, TX 77064  
815.880.2700

**STRUCTURAL ENGINEER**  
METTMEYER ENGINEERING  
2225 W CHESTERFIELD BLVD., SUITE 300  
SPRINGFIELD, MO 65807  
417.880.8002

**MFP ENGINEER**  
HENDERSON ENGINEERING, INC.  
8345 LENEXA DR., #300  
LENEXA, KS 66214  
913.742.5000

REVISIONS		
NO.	DESCRIPTION	DATE
1	ADD 01	1/11/2023
2	ADD 02	1/25/2023

PROJECT NO.: 19-040 DRAWN BY: J.R. & A.J.  
DATE: 12.15.22 REVIEWED BY: M.F.

**PROFESSIONAL SEAL**



ENGINEERS AUTHENTICATION  
The responsibility for professional engineering liability on this project is hereby limited to the work of plans administered by the seal signatory, and does not extend to any other work performed by the seal signatory or any other person or entity. The seal signatory's responsibility is limited to the work of plans administered by the seal signatory, and does not extend to any other work performed by the seal signatory or any other person or entity. The seal signatory's responsibility is limited to the work of plans administered by the seal signatory, and does not extend to any other work performed by the seal signatory or any other person or entity.

**PROJECT TITLE**  
CITY OF WENTZVILLE, MO PUBLIC WORKS FACILITY  
**PROJECT ADDRESS:**  
1298 INTERSTATE DRIVE  
WENTZVILLE, MO 63385

**STORM SEWER PROFILES**

WENTZVILLE PROJECT #: ENG-2022-033A

C-600

NOT RELEASED FOR CONSTRUCTION



\\p01-2\p01-2\Civil\B-PROJECTS\2022\033A-CITY OF WENTZVILLE PUBLIC WORKS WENTZVILLE MO\ENGINEERING\CONSTRUCTION DRAWINGS\2022\STORM SEWER PROFILES.dwg





\*\*\*STORM SEWER PIPES WITH A DESIGN GRADE LESS THAN 1.0% WILL REQUIRE VERIFICATION OF THE PIPE GRADE FOR EACH REACH PRIOR TO ANY SURFACE RESTORATION OR INSTALLATION OF ANY SURFACE IMPROVEMENTS\*\*\*

UNDERGROUND UTILITIES AND OSHA SAFETY NOTE:  
Underground utilities and structures have been plotted from available information and therefore, their location must be considered approximate only. It is the responsibility of the individual contractors to notify the utility companies before actual construction. All OSHA rules and regulations established for the type of construction required by these plans shall be strictly followed (ie, trenching, blasting, etc.)

15 YEAR 20 MINUTE STORM																																
LineNo.	LineID	InletID	LineLength	n-valuePipe	LineSize	InvertUp	InvertDn	LineSlope	Grnd/RimElev Up	Grnd/RimElev Dn	DepthUp	HGLUp	HGLDn	Rim-Hw	Defl.Angle	VelDn	VelHd Dn	J-LossCoeff	EnergyLoss	MinorLoss	CapacityFull	KnownQ	FlowRate	CrossSlope, Sx	InletEff	QCaptured	QBypass	QCarryover	BypassDepth	BypassSpread	n-valueGutter	GutterSpread
			(ft)		(in)	(ft)	(ft)	(%)	(ft)	(ft)	(ft)	(ft)	(ft)	(ft)	(Deg)	(ft/s)	(ft)		(ft)	(ft)	(cfs)	(cfs)	(cfs)	(ft/ft)	(%)	(cfs)	(cfs)	(cfs)	(ft)	(ft)		(ft)
1	201-200	201	47.36	0.013	36	623.11	622.8	0.65	630.22	624.05	2.73	625.84	625.8	4.22	-109.45	3.26	0.16	0.91	0.053	0.16	53.96	0	23.02	....	....	....	....	....	....	....	....	....
2	202-201	202	109.44	0.013	36	624.19	623.46	0.67	639.02	630.22	1.54**	625.73	626	13.29	-63.43	3.6	0.61	2.56 z	0	1.57	54.47	0.69	23.02	0.02	100	0.69	0	0	n/a	n/a	....	1.07
3	203-202	203	117.978	0.013	18	625.57	624.39	1	640.01	639.02	1.5	629.09	625.89	10.7	-97	9.78	1.49	0.15	3.195	0.22	10.5	4.64	17.28	....	....	....	....	....	....	....	....	....
4	400-202	400	143	0.013	18	629.23	627.51	1.2	638.74	639.02	0.85**	630.08	628.2	8.66	7.4	6.26	0.35	0.97 z	0	n/a	11.52	0.06	4.92	....	....	....	....	....	....	....	....	....
5	401-400	401	89.122	0.013	15	630.32	629.43	1	640.04	638.74	0.79**	631.11	630.12	8.93	-14.345	5.47	0.34	1.00 z	0	0.34	6.45	0	3.8	....	....	....	....	....	....	....	....	....
6	402-401	402	185.962	0.013	15	632.38	630.52	1	639.91	640.04	0.71**	633.09	631.13	6.82	0	5.22	0.29	1.00 z	0	0.29	6.46	0.11	3.13	....	....	....	....	....	....	....	....	....
7	403-402	403	131.399	0.013	12	633.89	632.58	1	639.88	639.91	0.62**	634.51	633.14	5.37	0	4.73	0.27	1.00 z	0	0.27	3.56	0.21	2.14	....	....	....	....	....	....	....	....	....
8	204-203	204	50.092	0.013	24	626.27	625.77	1	638.71	640.01	2	629.47	629.31	8.97	0	4.02	0.25	1.1	0.156	0.28	22.6	1.91	12.64	0.02	100	1.91	0	0	n/a	n/a	....	1.89
9	300-204	300	63.627	0.013	12	631.07	630.43	1.01	639.05	638.71	0.54**	631.61	630.9	7.44	-35.629	4.44	0.22	1.00 z	0	0.22	3.57	1.42	1.63	0.02	100	1.42	0	0	n/a	n/a	....	1.32
10	402A-402	402A	27.503	0.013	12	634.9	634.35	2	639.9	639.91	0.39**	635.29	634.63	4.61	90.04	4.81	0.15	1.00 z	0	0.15	5.04	0.88	0.88	0.02	100	0.88	0	0	n/a	n/a	....	6.81
11	401A-401	401A	27.501	0.013	12	634.66	634.11	2	639.66	640.04	0.34**	635	634.36	4.66	90	4.45	0.12	1.00 z	0	0.12	5.04	0.67	0.67	0.02	100	0.67	0	0	n/a	n/a	....	5.68
12	404-403	404	123.52	0.013	12	635.45	634.09	1.1	640.72	639.88	0.41**	635.86 j	634.51	4.86	-40.99	2.96	0.15	1.00 z	0	n/a	3.74	0.94	0.94	0.02	100	0.94	0	0	n/a	n/a	....	7.12
13	403A-403	403A	21.255	0.013	12	634.3	634.09	0.99	639.3	639.88	0.42**	634.72 j	634.51	4.58	90	3.12	0.16	1.00 z	0	n/a	3.54	0.99	0.99	0.02	100	0.99	0	0	n/a	n/a	....	1.25
14	301-300	301	82.6	0.013	12	634.11	633.28	1	639.11	639.05	0.19**	634.3	633.44	4.81	-37.866	2.48	0.07	1.00 z	0	n/a	3.57	0.21	0.21	0.02	100	0.21	0	0	n/a	n/a	....	0.54
15	400A-400	400A	27.5	0.013	12	633.7	633.15	2	638.7	638.74	0.43**	634.13	633.46	4.57	75.656	5.07	0.16	1.00 z	0	0.16	5.04	1.06	1.06	0.02	100	1.06	0	0	n/a	n/a	....	7.71
16	205-204	205	151.279	0.013	18	627.98	626.47	1	638.72	638.71	1.5	630.88	629.74	7.24	2.954	5.15	0.41	1.45	1.136	0.6	10.49	0.89	9.1	0.02	100	0.89	0	0	n/a	n/a	....	1.42
17	206-205	206	216.392	0.013	18	630.34	628.18	1	637.12	638.72	1.5	632.8	631.48	4.15	73.806	4.65	0.34	0.5	1.323	0.17	10.49	5.95	8.21	0.02	100	5.95	0	0	n/a	n/a	....	6.08
18	207-206	207	334.903	0.013	15	632.78	630.54	0.67	638.64	637.12	0.76	633.54	632.97	4.92	13.651	1.84	0.05	1.36	0.65	0.18	5.28	1.45	2.26	0.02	100	1.45	0	0	n/a	n/a	....	1.4
19	208-207	208	186.539	0.013	12	634.23	632.98	0.67	640.94	638.64	0.38**	634.61 j	633.72	6.33	62.125	1.31	0.14	1.00 z	0	n/a	2.92	0.81	0.81	0.02	100	0.81	0	0	n/a	n/a	....	6.44
20	202A-202	202A	62.06	0.012	8	635.96	632.96	4.83	641.41	639.02	0.16**	636.12	633.06	5.29	-45.8	4.16	0.06	0.17 z	0	0.01	2.88	0.02	0.13	....	....	....	....	....	....	....	....	....
21	202C-202A	202C	10.789	0.012	4	636.6	635.96	5.93	637.75	641.41	0.19**	636.79	636.12	0.96	-8.218	2.56	0.08	0.35 z	0	0.03	0.5	0	0.11	....	....	....	....	....	....	....	....	....
22	202D-202C	202D	18.024	0.012	12	636.6	636.6	0	637.75	637.75	0.21	636.81	636.79	0.92	17.379	1.1	0.02	1	0.02	0.01	0	0.11	0.11	....	....	....	....	....	....	....	....	....
23	101-100	101	56.561	0.013	36	603.16	602.59	1.01	624.26	605	2.45	605.61	605.59	18.61	156.042	3.63	0.2	0.15	0.084	0.04	66.95	0	25.64	....	....	....	....	....	....	....	....	....
24	102-101	102	37.133	0.013	36	617.75	617.38	1	628	624.26	1.63**	619.38	618.67	8.62	0.251	8.8	0.66	0.23 z	0	n/a	66.57	0	25.64	....	....	....	....	....	....	....	....	....
25	103-102	103	11.8	0.013	24	622.5	622.38	1.02	624.83	628	2	624.5	624.38	-0.7	10.949	8.16	1.04	1	0.15	1.04	22.81	25.64	25.64	....	100	25.64	0	0	....	....	....	....
Notes: j-Line contains hyd. jump; s-Supercritical depth; z-Zero Junction Loss																																

100 YEAR 20 MINUTE STORM																																
LineNo.	LineID	InletID	LineLength	n-valuePipe	LineSize	InvertUp	InvertDn	LineSlope	Grnd/RimElev Up	Grnd/RimElev Dn	DepthUp	HGLUp	HGLDn	Rim-Hw	Defl.Angle	VelDn	VelHd Dn	J-LossCoeff	EnergyLoss	MinorLoss	CapacityFull	KnownQ	FlowRate	CrossSlope, Sx	InletEff	QCaptured	QBypass	QCarryover	BypassDepth	BypassSpread	n-valueGutter	GutterSpread
			(ft)		(in)	(ft)	(ft)	(%)	(ft)	(ft)	(ft)	(ft)	(ft)	(ft)	(Deg)	(ft/s)	(ft)		(ft)	(ft)	(cfs)	(cfs)	(cfs)	(ft/ft)	(%)	(cfs)	(cfs)	(cfs)	(ft)	(ft)		(ft)
1	201-200	201	47.36	0.013	36	623.11	622.8	0.65	630.22	624.05	2.76	625.87	625.8	4.06	-109.45	4.39	0.3	0.91	0.096	0.29	53.96	0	31.01	....	....	....	....	....	....	....	....	....
2	202-201	202	109.44	0.013	36	624.19	623.46	0.67	639.02	630.22	1.80**	625.99	626.16	13.03	-63.43	4.62	0.76	2.56 z	0	1.94	54.47	0.93	31.01	0.02	100	0.93	0	0	n/a	n/a	....	1.25
3	203-202	203	117.978	0.013	36	625.57	624.39	1	640.01	639.02	1.55**	627.12 j	625.99	12.89	-97	6.06	0.62	0.15 z	0	n/a	66.7	6.25	23.29	....	....	....	....	....	....	....	....	....
4	400-202	400	143	0.013	18	629.23	627.51	1.2	638.74	639.02	0.99**	630.22	628.33	8.52	7.4	6.74	0.44	0.97 z	0	n/a	11.52	0.09	6.61	....	....	....	....	....	....	....	....	....
5	401-400	401	89.122	0.013	15	630.32	629.43	1	640.04	638.74	0.91**	631.23	630.27	8.81	-14.345	5.83	0.44	1.00 z	0	n/a	6.45	0	5.1	....	....	....	....	....	....	....	....	....
6	402-401	402	185.962	0.013	15	632.38	630.52	1	639.91	640.04	0.83**	633.21	631.25	6.7	0	5.6	0.37	1.00 z	0	0.37	6.46	0.14	4.2	....	....	....	....	....	....	....	....	....
7	403-402	403	131.399	0.013	12	633.89	632.58	1	639.88	639.91	0.73**	634.62	633.26	5.26	0	5.04	0.34	1.00 z	0	n/a	3.56	0.29	2.88	....	....	....	....	....	....	....	....	....
8	204-203	204	50.092	0.013	18	626.27	625.77	1	638.71	640.01	1.5	628.59	627.27	8.53	0	9.64	1.45	1.1	1.319	1.59	10.49	2.58	17.04	0.02	100	2.58	0	0	n/a	n/a	....	3.7
9	300-204	300	63.627	0.013	12	631.07	630.43	1.01	639.05	638.71	0.63**	631.7	631	7.35	-35.629	4.78	0.27	1.00 z	0	n/a	3.57	1.91	2.2	0.02	100	1.91	0	0	n/a	n/a	....	1.47
10	402A-402	402A	27.503	0.013	12	634.9	634.35	2	639.9	639.91	0.46**	635.36	634.68	4.54	90.04	5.23	0.18	1.00 z	0	0.18	5.04	1.18	1.18	0.02	100	1.18	0	0	n/a	n/a	....	8.28
11	401A-401	401A	27.501	0.013	12	634.66	634.11	2	639.66	640.04	0.40**	635.06	634.4	4.6	90	4.85	0.15	1.00 z	0	0.15	5.04	0.9	0.9	0.02	100	0.9	0	0	n/a	n/a	....	6.91
12	404-403	404	123.52	0.013	12	635.45	634.09	1.1	640.72	639.88	0.47**	635.92 j	634.62	4.8	-40.99	3	0.18	1.00 z	0	n/a	3.74	1.26	1.26	0.02	100	1.26	0	0	n/a	n/a	....	8.65
13	403A-403	403A	21.255	0.013	12	634.3	634.09	0.99	639.3	639.88	0.49**	634.79 j	634.62	4.51	90	3.17	0.19	1.00 z	0	n/a	3.54	1.33	1.33	0.02	100	1.33	0	0	n/a	n/a	....	1.33
14	301-300	301	82.6	0.013	12	634.11	633.28	1	639.11	639.05	0.12**	634.33	633.47	4.78	-37.866	2.73	0.08	1.00 z	0	0.08	3.57	0.29	0.29	0.02	100	0.29	0	0	n/a	n/a	....	0.65
15	400A-400	400A	27.5	0.013	12	633.7	633.15	2	638.7	638.74	0.50**	634.2	633.51	4.5	75.656	5.51	0.2	1.00 z	0	n/a	5.04	1.42	1.42	0.02	100	1.42	0	0	n/a	n/a	....	9.37
16	205-204	205	151.279	0.013	18	627.98	626.47	1	638.72	638.71	1.5	632.24	630.18	5.39	2.954	6.94	0.75	1.45	2.062	1.09	10.49	1.19	12.26	0.02	100	1.19	0	0	n/a	n/a	....	1.6
17	206-205	206	216.392	0.013	18	630.34	628.18	1	637.12	638.72	1.5	635.73	633.33	1.08	73.806	6.27	0.61	0.5	2.405	0.31	10.49	8.01	11.07	0.02	100	8.01	0	0	n/a	n/a	....	9.44
18	207-206	207	334.903	0.013	15	632.78	630.54	0.67	638.64	637.12	1.25	636.79	636.04	1.72	13.651	2.49	0.1	1.36	0.752	0.13	5.28	1.96	3.06	0.02	100	1.96	0	0	n/a	n/a	....	1.72
19	208-207	208	186.539	0.013	12	634.23	632.98	0.67	640.94	638.64	1	637.1	636.92	3.81	62.125	1.4	0.03	1	0.178	0.03	2.92	1.1	1.1	0.02	100	1.1	0	0	n/a	n/a	....	7.9
20	101-100	101	56.561	0.013	36	603.16	602.59	1.01	624.26	605	2.48	605.64	605.59	18.55	156.042	4.93	0.38	0.15	0.153	0.07	66.95	0	34.86	....	....	....	....	....	....	....	....	....
21	102-101	102	37.133	0.013	36	617.75	617.38	1	628	624.26	1.92**	619.67	618.92	8.33	0.251	9.52	0.83	0.23 z	0	0.19	66.57	0	34.86	....	....	....	....	....	....	....	....	....
22	103-102	103	11.8	0.013	24	622.5	622.38	1.02	624.83	628	2	624.66	624.38	-1.75	10.949	11.1	1.92	1	0.28	1.91	22.81	34.86	34.86	....	100	34.86	0	0	....	....	....	....
23	202A-202	202A	62.06	0.012	8	635.96	632.96	4.83	641.41	639.02	0.19**	636.15	633.07	5.26	-45.8	4.59	0.07	0.17 z	0	n/a	2.88	0.03	0.18	....	....	....	....	....	....	....	....	....
24	202C-202A	202C	10.789	0.012	4	636.6	635.96	5.93	637.75	641.41	0.22**	636.82	636.15	0.93	-8.218	2.84	0.1	0.35 z	0	0.03	0.5	0	0.15	....	....	....	....	....	....	....	....	....
25	202D-202C	202D	18.024	0.012	12	636.6	636.6	0	637.75	637.75	0.24	636.84	636.82	0.89	17.379	1.19	0.02	1	0.021	0.02	0	0.15	0.15	....	....	....	....	....	....	....	....	....
Notes: j-Line contains hyd. jump; s-Supercritical depth; z-Zero Junction Loss																																



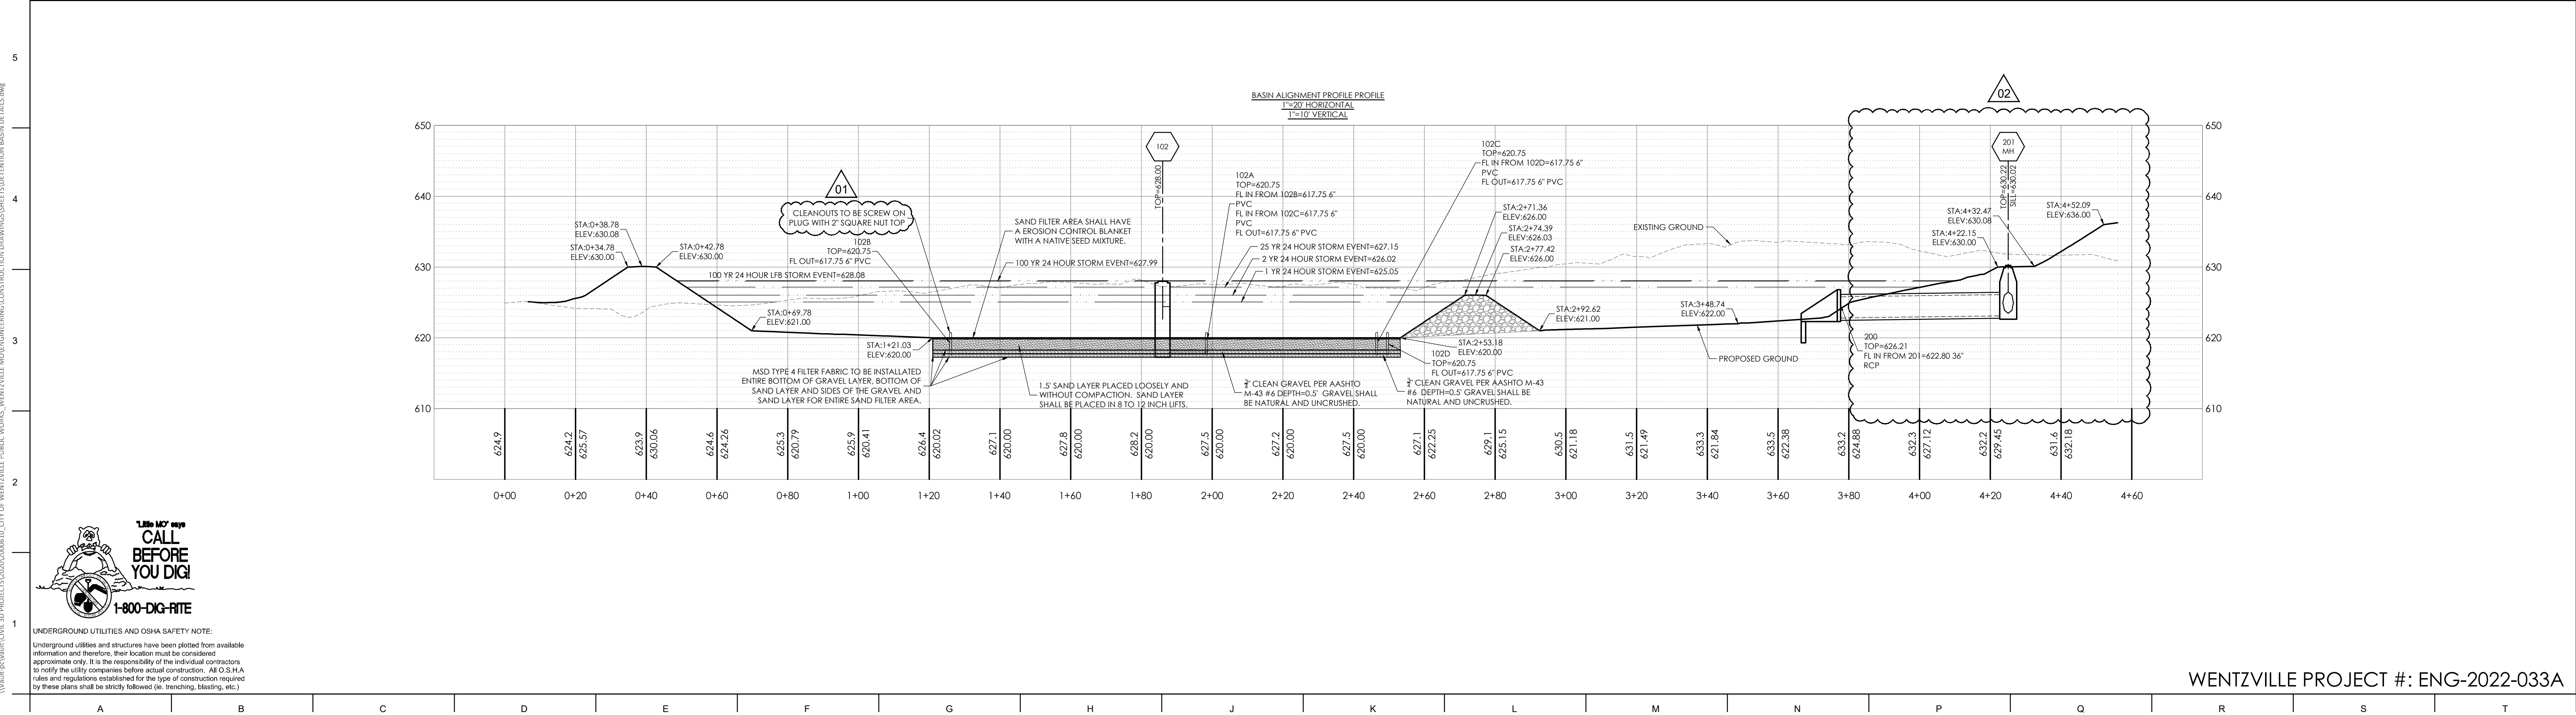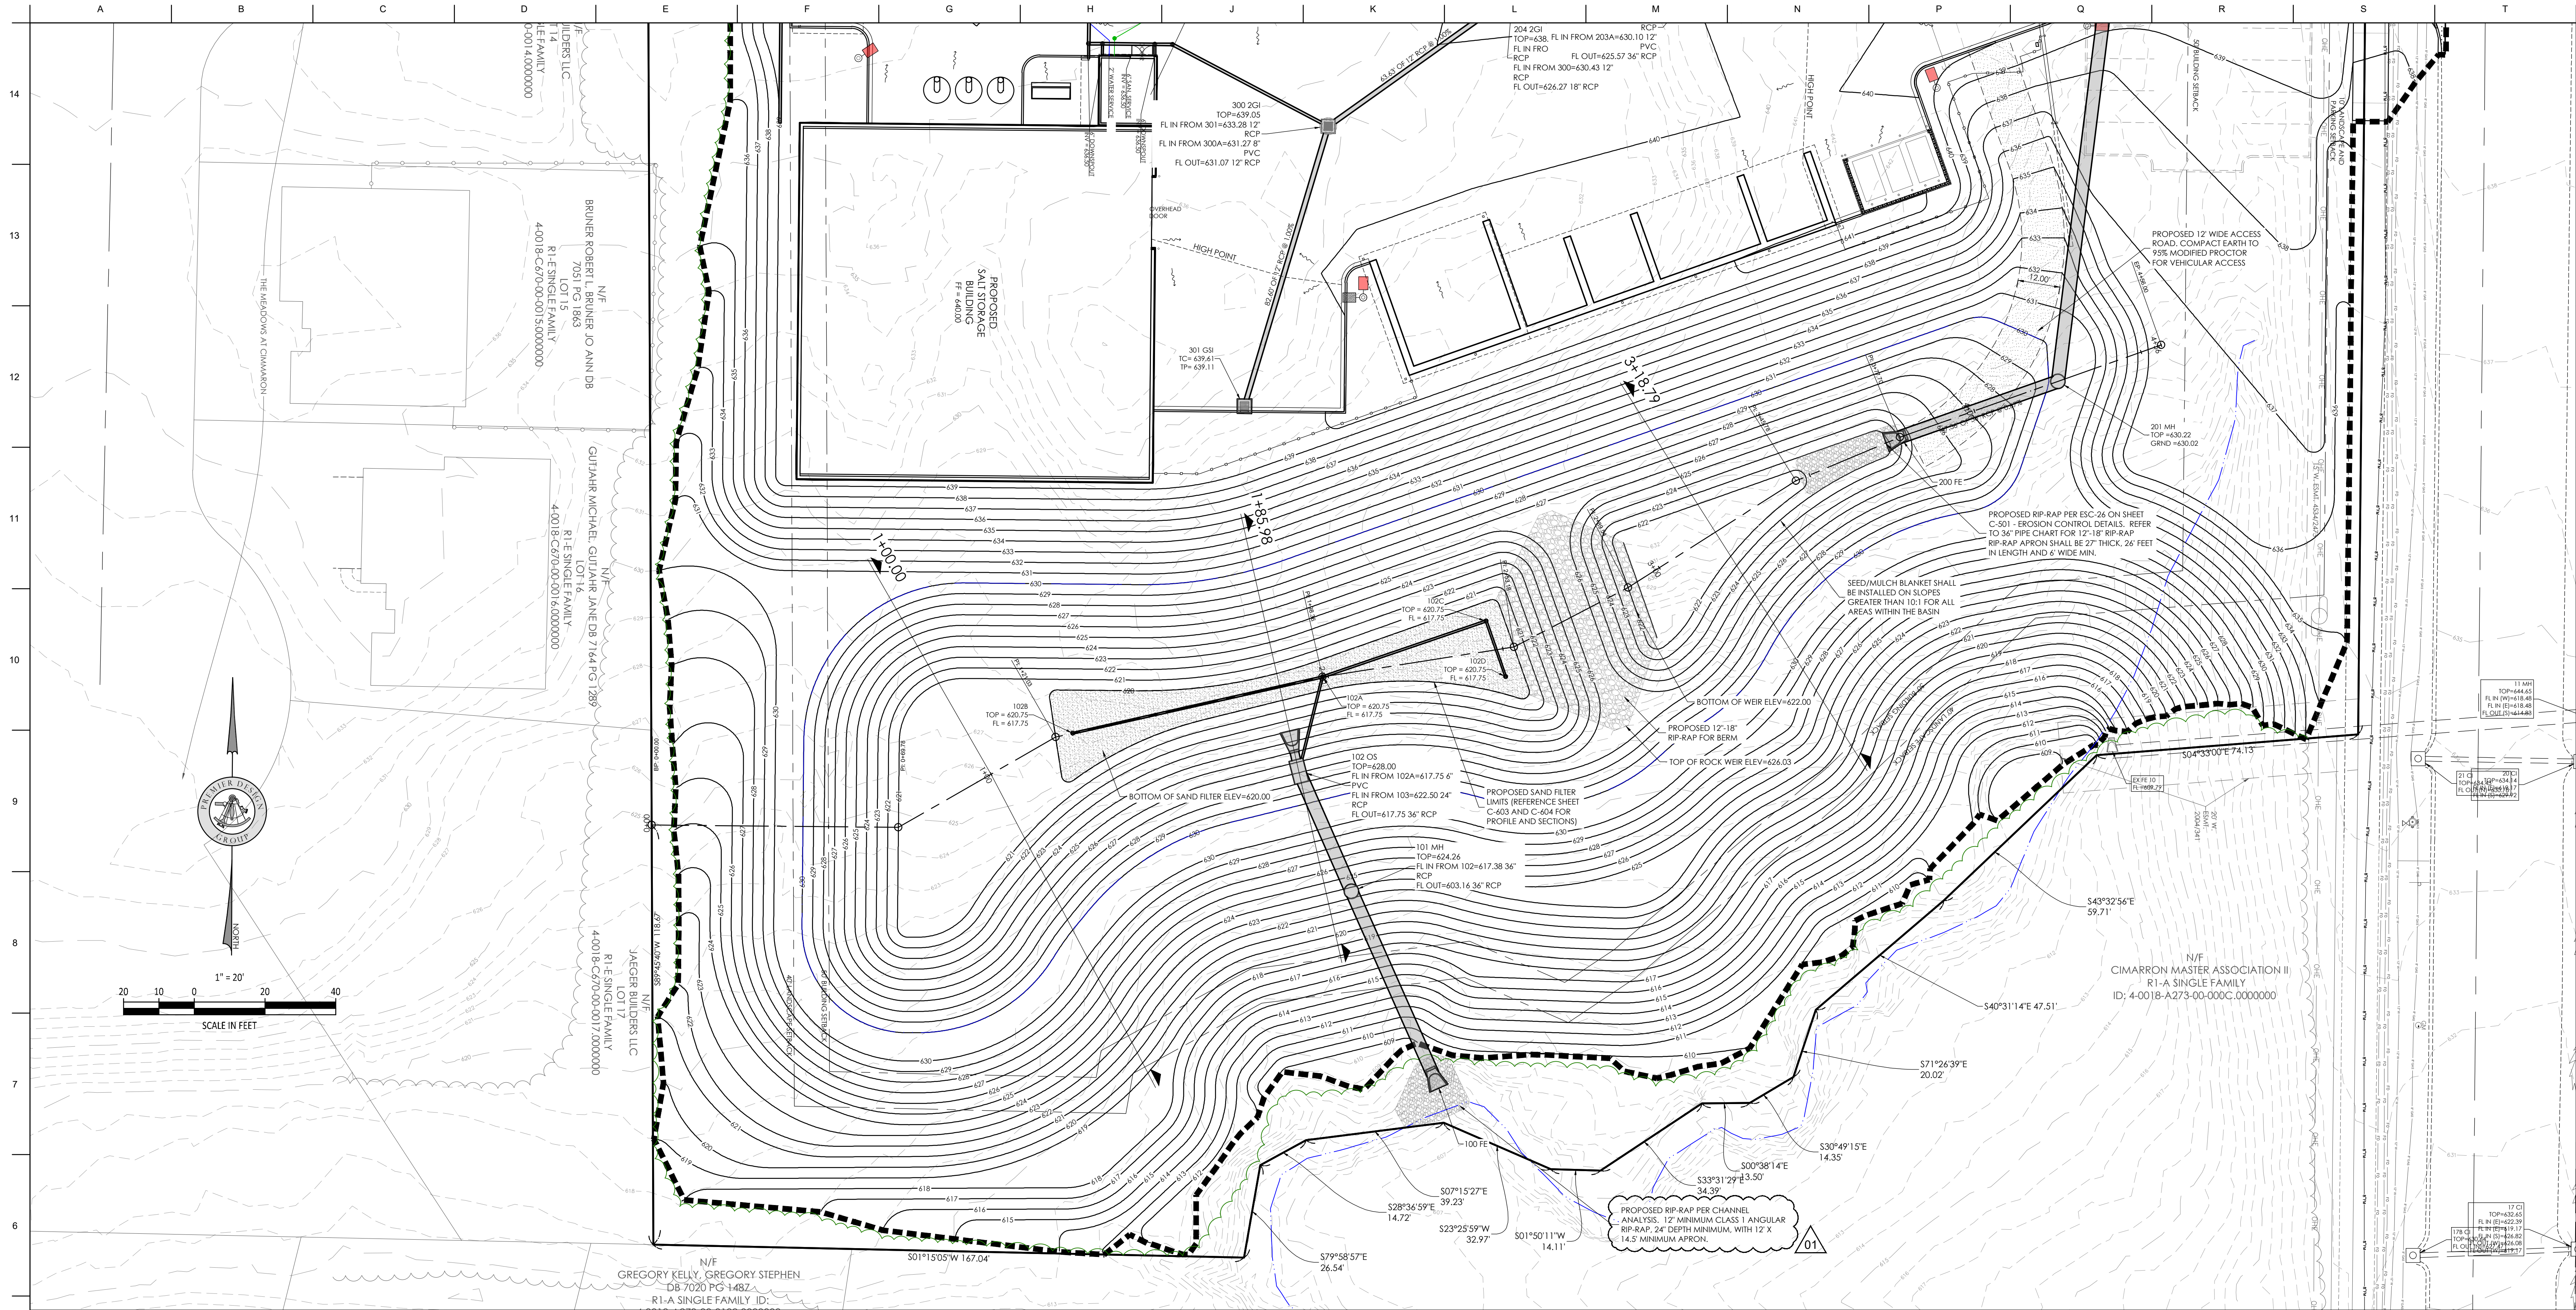

5039 S National Avenue | Springfield, MO 65810 | 417.887.8595

**OWNER**  
CITY OF WENTZVILLE  
1001 SCHROEDER CREEK BLVD.  
WENTZVILLE, MO 63385  
636.327.5101

**PROJECT TEAM**  
**CIVIL ENGINEER**  
PREMIER DESIGN GROUP  
100 MIDLAND PARK DRIVE  
WENTZVILLE, MO 63385  
314.925.7444

**MAINTENANCE CONSULTANT**  
HDR ENGINEERING, INC.  
17725 KATY FREEWAY SUITE 102  
HOUSTON, TX 77064  
816.380.2700

**STRUCTURAL ENGINEER**  
METTEMAYER ENGINEERING  
2225 W CHESTERFIELD BLVD., SUITE 300  
SPRINGFIELD, MO 65807  
417.880.8002

**MEP ENGINEER**  
HENDERSON ENGINEERS, INC.  
8345 LENEXA DR., #300  
LENEXA, KS 66214  
913.742.5000

REVISIONS		
NO.	DESCRIPTION	DATE
1	ADD 01	1/11/2023
2	ADD 02	1/25/2023

PROJECT NO.: 19-040 DRAWN BY: J.R. & A.J.  
DATE: 12.15.22 REVIEWED BY: M.F.

**PROFESSIONAL SEAL**



ENGINEERS AUTHENTICATION  
The responsibility for professional engineering liability on this project is hereby placed in the sole and exclusive hands of the engineer, and the engineer hereby certifies that the design, analysis, and calculations are the work of the engineer and are not the work of any other person or firm.


**PROJECT TITLE**  
CITY OF WENTZVILLE, MO PUBLIC WORKS FACILITY  
**PROJECT ADDRESS:**  
1298 INTERSTATE DRIVE  
WENTZVILLE, MO 63385

**DETENTION BASIN DETAILS**

C-603

NOT RELEASED FOR CONSTRUCTION



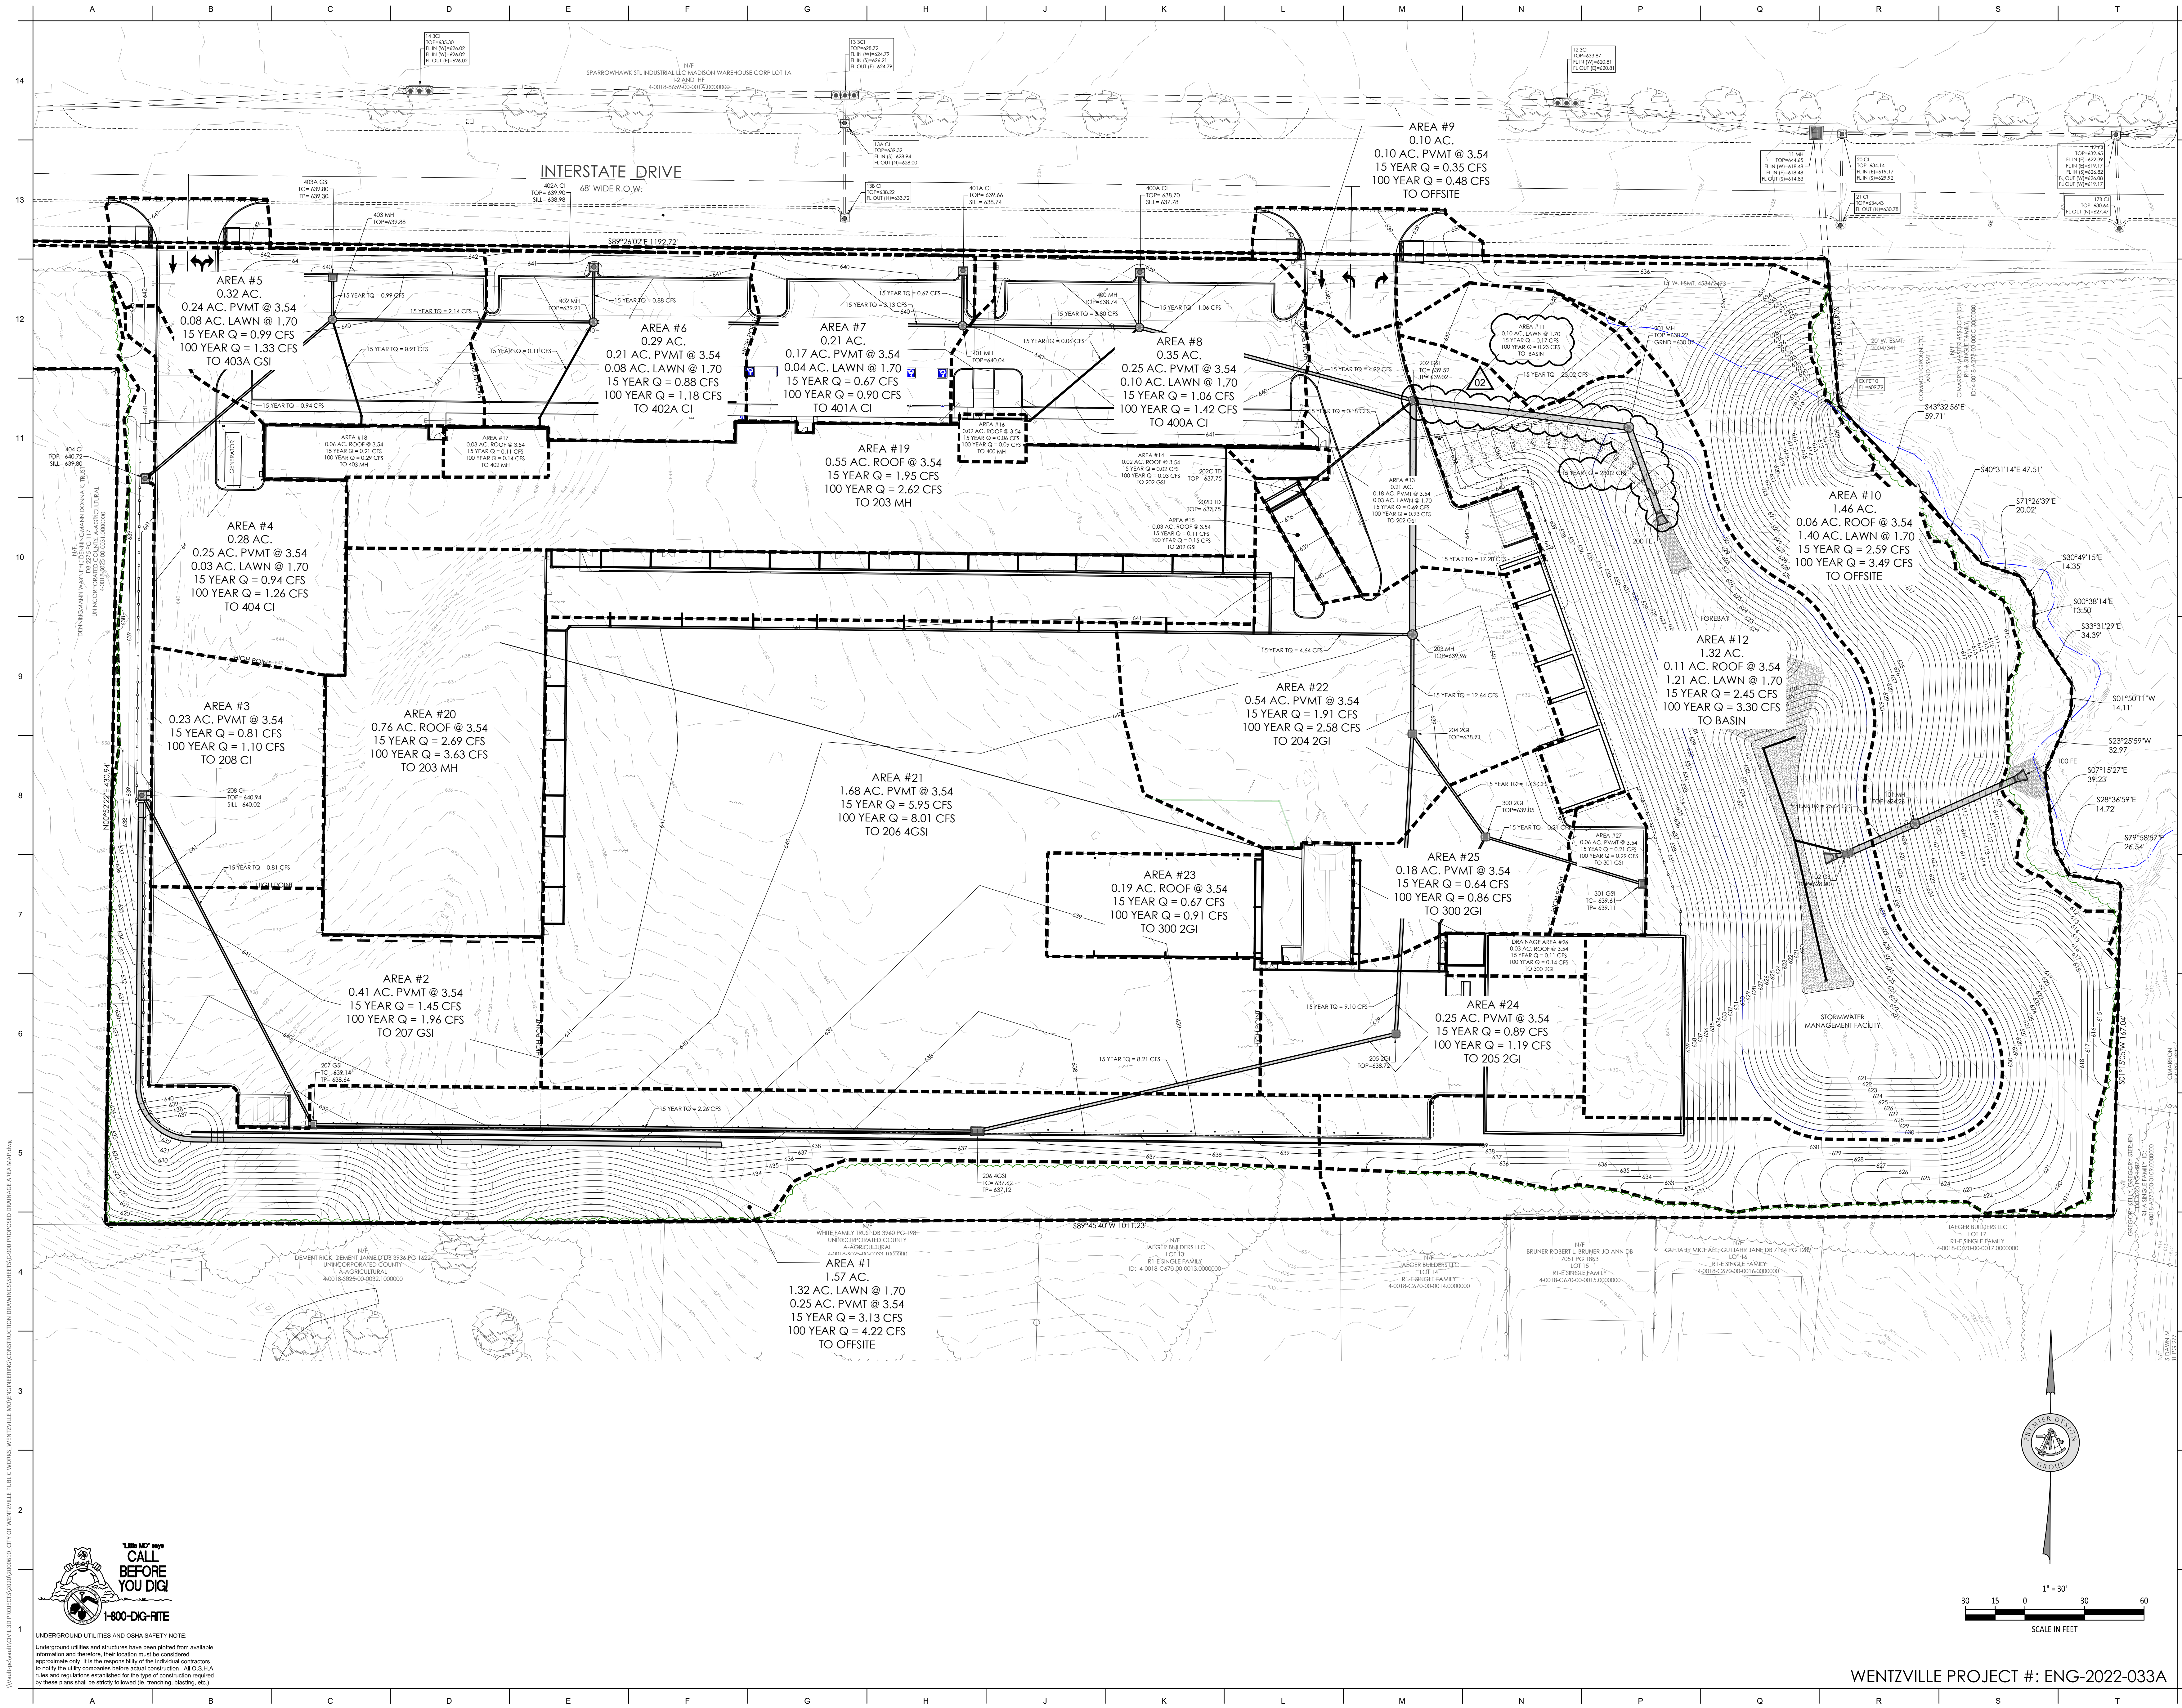

**OWNER**  
CITY OF WENTZVILLE  
1001 SCHROEDER CREEK BLVD.  
WENTZVILLE, MO 63385  
636.327.5101

**PROJECT TEAM**  
**CIVIL ENGINEER**  
PREMIER DESIGN GROUP  
100 MIDLAND PARK DRIVE  
WENTZVILLE, MO 63385  
314.925.7444  
**MAINTENANCE CONSULTANT**  
HDR ENGINEERING, INC.  
17725 KATY FREEWAY SUITE 102  
HOUSTON, TX 77094  
816.380.2700  
**STRUCTURAL ENGINEER**  
METTMAYER ENGINEERING  
2225 W CHESTERFIELD BLVD., SUITE 300  
SPRINGFIELD, MO 65807  
417.880.8002  
**MEP ENGINEER**  
HENDERSON ENGINEERS, INC.  
8345 LENEXA DR., #300  
LENEXA, KS 66214  
913.742.5000

REVISIONS		
NO.	DESCRIPTION	DATE
1	ADD 01	1/11/2023
2	ADD 02	1/25/2023

PROJECT NO.: 19-040 DRAWN BY: J.R. & A.J.  
DATE: 12.15.22 REVIEWED BY: M.F.

**PROFESSIONAL SEAL**



**ENGINEER'S AUTHENTICATION**  
The undersigned hereby certifies that he/she is a duly licensed Professional Engineer in the State of Missouri and that he/she is the author of the design shown on this drawing. The undersigned also certifies that the design was prepared by him/her or under his/her direct supervision and that he/she is a duly licensed Professional Engineer in the State of Missouri and that he/she is the author of the design shown on this drawing. The undersigned also certifies that the design was prepared by him/her or under his/her direct supervision and that he/she is a duly licensed Professional Engineer in the State of Missouri and that he/she is the author of the design shown on this drawing.

**PROJECT TITLE**  
CITY OF WENTZVILLE, MO PUBLIC WORKS FACILITY  
**PROJECT ADDRESS:**  
1295 INTERSTATE DRIVE  
WENTZVILLE, MO 63385

**PROPOSED DRAINAGE AREA MAP**



[illegible]

H designgroup

architecture + design

5039 S National Avenue | Springfield, MO 65810 | 417.887.6559

CITY OF WENTZVILLE, MISSOURI  
1001 SCHROEDER CREEK BLVD  
WENTZVILLE, MO 63385  
636-327-5101

OWNER

CITY OF WENTZVILLE, MISSOURI  
1001 SCHROEDER CREEK BLVD  
WENTZVILLE, MO 63385  
636-327-5101

PROJECT TEAM

CIVIL ENGINEER  
PREMIER DESIGN GROUP  
100 MIDLAND PARK DRIVE  
WENTZVILLE, MO 63385  
314.925.7444  
  
MAINTENANCE CONSULTANT  
HDR ENGINEERING, INC.  
10450 HOLMES RD., STE 600  
SPRINGFIELD, MO 65810  
816.360.2700  
  
STRUCTURAL ENGINEER  
METTEMEYER ENGINEERING  
22225 W CHESTERFIELD BLVD., SUITE 300  
SPRINGFIELD, MO 65807  
417.890.8002  
  
MEP ENGINEER  
ANDERSON ENGINEERING, INC.  
8346 LENEXA DR., #300  
LENEXA, KS 66214  
417.555.5555

REVISIONS

NO.	DESCRIPTION	DATE
01	ADD 01	01/11/23
02	ADD 02	01/25/23

PROJECT NO.:      20-0087      DRAWN BY:      MRH, TNR  
DATE:                12.15.22      REVIEWED BY:      BSW

PROFESSIONAL SEAL

ALAN METTEMEYER, PE  
PROFESSIONAL TITLE: ENGINEER  
MOM E-2000102147

THIS DRAWING AND THE ARCHITECTURAL WORK REPRESENTED ARE OWNED BY H DESIGN GROUP, LLC. COPYRIGHT INCLUDES THIS DRAWING, AS WELL AS ALL COMPONENTS OF THE CONCEPTUAL DESIGN. REPRODUCTION OF ANY KIND IS STRICTLY PROHIBITED WITHOUT THE EXPRESSED WRITTEN CONSENT OF H DESIGN GROUP, LLC.

©2022 H DESIGN GROUP, LLC

CITY OF WENTZVILLE, MO PUBLIC WORKS FACILITY

PROJECT ADDRESS:  
1295 INTERSTATE DRIVE  
WENTZVILLE, MO 63385

GENERAL NOTES

S000

SHEET



14

13

12

BASIS FOR DESIGN:

1. BUILDING CODE: IBC 2015  
RISK CATEGORY = III  
REFER TO CHAPTER 35 FOR REFERENCED STANDARDS

2. DEAD LOADS  
A. ROOF, PRE-ENG. METAL BUILDING  
B. ROOF, MAIN OFFICE BUILDING  
C. ROOF, WASH BUILDING  
D. ROOF, SALT STORAGE BUILDING  
E. MEZZANINE STORAGE

PER MFR. + 5 PSF COLLATERAL  
18 PSF  
16 PSF  
PER MFR. + 5 PSF COLLATERAL  
36 PSF

3. LIVE LOADS  
A. ROOFS, ALL (NO REDUCTION)  
B. MEZZANINE STORAGE  
C. WASH BLDG. PLATFORM

20 PSF  
250 PSF  
60 PSF

4. SNOW LOAD  
A. GROUND SNOW  
B. MINIMUM FLAT ROOF SNOW LOAD  
C. SLOPED ROOF SNOW LOAD  
D. EXPOSURE FACTOR  
E. IMPORTANCE FACTOR  
F. THERMAL FACTOR  
G. RAIN ON SNOW = 5 PSF (FLAT ROOF)

P<sub>g</sub> = 20 PSF  
P<sub>s</sub> = 22 PSF  
P<sub>s</sub> = 16 PSF  
C<sub>e</sub> = 1.0  
I = 1.1  
C<sub>t</sub> = 1.2

5. SEISMIC LOAD  
A. IMPORTANCE FACTOR, I<sub>a</sub> = 1.25  
B. S<sub>s</sub> = 0.293  
C. S<sub>i</sub> = 0.132  
D. SITE CLASS = C  
E. SD<sub>1</sub> = 0.224  
F. SD<sub>1</sub> = 0.147  
G. SEISMIC DESIGN CATEGORY = C  
H. BASIC SEISMIC FORCE RESISTING SYSTEM  
a. STEEL ORDINARY CONCENTRICALLY BRACED FRAMES  
b. STEEL INTERMEDIATE MOMENT FRAMES  
c. INTERMEDIATE REINFORCED MASONRY SHEAR WALLS  
I. DESIGN BASE SHEAR  
a. FLEET PEMB = BY OTHERS  
b. PUBLIC WORKS BRACING = 165.9 KIPS  
c. WASH BUILDING = 43.6 KIPS  
d. SALT STORAGE = 10.2 KIPS  
J. RESPONSE MODIFICATION COEFFICIENT(S), R  
a. STEEL ORDINARY CONCENTRICALLY BRACED FRAMES = 3.25  
b. STEEL INTERMEDIATE MOMENT FRAMES = 4.5  
c. INTERMEDIATE REINFORCED MASONRY SHEAR WALLS = 3.5  
K. SEISMIC RESPONSE COEFFICIENT(S), C<sub>s</sub>  
a. STEEL ORDINARY CONCENTRICALLY BRACED FRAMES = 0.090  
b. STEEL INTERMEDIATE MOMENT FRAMES = 0.085  
c. INTERMEDIATE REINFORCED MASONRY SHEAR WALLS = 0.084  
L. ANALYSIS PROCEDURE = EQUIVALENT LATERAL FORCE PROCEDURE

120 MPH  
93 MPH

6. WIND LOAD  
A. BASIC WIND SPEED (3-SECOND GUST)  
a. ULTIMATE DESIGN WIND SPEED  
b. SERVICE DESIGN WIND SPEED  
C. EXPOSURE = "C"  
D. INTERNAL PRESSURE COEFFICIENT = ±0.18  
E. WIND DESIGN PRESSURES (COMPONENTS & CLADDING) - REFER TO TABLES BELOW.  
F. MEAN ROOF HEIGHTS  
a. 30'-6" @ FLEET PEMB  
b. 15'-0" @ MAIN OFFICE BUILDING  
c. 21'-0" @ WASH BUILDING

120 MPH  
93 MPH

7. PRE-ENGINEERED METAL BUILDING STANDARD DEFLECTION CRITERIA  
VERTICAL:  
A. ROOF PANEL, L = DISTANCE BETWEEN PURLINS:  
a. L/180 (L, S, OR W)  
b. L/150 (D/L)  
B. PURLINS, L = BAY LENGTH  
a. L/150 (L, S, OR W)  
b. L/120 (D/L)  
C. EW RAFTERS, L = DISTANCE BETWEEN COLUMNS  
a. L/180 (L, S, OR W)  
b. L/120 (D/L)  
D. MAIN FRAMES, L = FRAME WIDTH  
a. L/180 (L, S, OR W)  
b. L/120 (D/L)  
  
HORIZONTAL:  
A. WALL PANEL, L = DISTANCE BETWEEN GIRTS  
B. GIRTS, L = BAY LENGTH  
C. EW COLUMNS, H = COLUMN HEIGHT  
D. MAIN FRAMES, H = EAVE HEIGHT

L/80  
L/90  
H/90  
H/90 [H/100 @ CRANE BAYS]

STATEMENT OF SPECIAL INSPECTIONS

1. SPECIAL INSPECTIONS ARE REQUIRED FOR THIS PRIMARY BUILDING FRAME / MAIN FORCE RESISTING SYSTEM PER THE LATEST EDITION OF THE IBC.

2. REFER TO THE IBC FOR ADDITIONAL INFORMATION RELATED TO THESE TABLES.

3. INSPECTIONS AND TESTING SHALL BE PROVIDED BY A QUALIFIED TESTING LABORATORY, RETAINED BY THE OWNER AND APPROVED BY THE ENGINEER OF RECORD.

4. REPORTS SHALL INDICATE THAT WORK INSPECTED OR TESTED WAS OR WAS NOT COMPLETED IN CONFORMANCE TO APPROVED CONSTRUCTION DOCUMENTS. DISCREPANCIES SHALL BE BROUGHT TO THE IMMEDIATE ATTENTION OF THE CONTRACTOR FOR CORRECTION. IF THEY ARE NOT CORRECT, THE DISCREPANCIES SHALL BE BROUGHT TO THE ATTENTION OF THE BUILDING OFFICIAL AND THE ENGINEER OF RECORD PRIOR TO THE COMPLETION OF THAT PHASE OF THE WORK.

5. A LETTER OF SUBSTANTIAL COMPLETION SHALL BE SUBMITTED TO THE BUILDING DEPARTMENT BY THE SPECIAL INSPECTOR PRIOR TO THE FINAL INSPECTION.

SOILS

IBC TABLE 1705.6

TYPE	CONTINUOUS SPECIAL INSPECTION	PERIODIC SPECIAL INSPECTION
1. VERIFY MATERIALS BELOW SHALLOW FOUNDATIONS ARE ADEQUATE TO ACHIEVE THE DESIGN BEARING CAPACITY.	-	X
2. VERIFY EXCAVATIONS ARE EXTENDED TO PROPER DEPTH AND HAVE REACHED PROPER MATERIAL.	-	X
3. PERFORM CLASSIFICATION AND TESTING OF COMPACTED FILL MATERIALS.	-	X
4. VERIFY USE OF PROPER MATERIALS, DENSITIES AND LEFT THICKNESS DURING PLACEMENT AND COMPACTION OF COMPACTED FILL.	X	-
5. PRIOR TO PLACEMENT OF COMPACTED FILL, INSPECT SUBGRADE AND VERIFY THAT SITE HAS BEEN PREPARED PROPERLY.	-	X

CONCRETE CONSTRUCTION

IBC TABLE 1705.3

TYPE	CONTINUOUS SPECIAL INSPECTION	PERIODIC SPECIAL INSPECTION
1. INSPECT REINFORCEMENT AND VERIFY PLACEMENT.	-	X
2. REINFORCING BAR WELDINGS: A. VERIFY WELDABILITY OF REINFORCING BARS OTHER THAN ASTM A706. B. MECHANICAL ANCHORS AND ADHESIVE ANCHORS NOT DEFINED IN 4.A. C. INSPECT ALL OTHER WELDS.	- - X	X - -
3. INSPECT ANCHORS CAST IN CONCRETE.	-	X
4. INSPECT ANCHORS POST-INSTALLED IN HARDENED CONCRETE MEMBERS: A. ADHESIVE ANCHORS INSTALLED IN HORIZONTALLY OR UPWARDLY INCLINED B. MECHANICAL ANCHORS AND ADHESIVE ANCHORS NOT DEFINED IN 4.A.	X - -	- X X
5. VERIFY USE OF REQUIRED DESIGN MIX.	-	X
6. PRIOR TO CONCRETE PLACEMENT, FABRICATE SPECIMENS FOR STRENGTH TESTS, PERFORM SLUMP AND AIR CONTENT TESTS, AND DETERMINE THE TEMPERATURE OF THE CONCRETE.	X	-
7. INSPECT CONCRETE PLACEMENT FOR PROPER APPLICATION TECHNIQUES.	X	-
8. VERIFY MAINTENANCE OF SPECIFIED CURING TEMPERATURE AND TECHNIQUES.	-	X
9. INSPECT FORMWORK FOR SHAPE, LOCATION AND DIMENSIONS OF THE CONCRETE MEMBER BEING FORMED.	-	X

CAST-IN-PLACE DEEP FOUNDATION ELEMENTS

IBC TABLE 1705.8

TYPE	CONTINUOUS SPECIAL INSPECTION	PERIODIC SPECIAL INSPECTION
1. INSPECT DRILLING OPERATIONS AND MAINTAIN COMPLETE AND ACCURATE RECORDS FOR EACH ELEMENT.	X	-
2. VERIFY PLACEMENT LOCATIONS AND PLUMBNESS. CONFIRM ELEMENT DIAMETERS, LENGTHS, EMBEDMENT INTO BEDROCK AND ADEQUATE END-BEARING STRATA CAPACITY. RECORD CONCRETE OR GROUT VOLUMES.	X	-
3. FOR CONCRETE ELEMENTS, PERFORM TESTS AND ADDITIONAL SPECIAL INSPECTIONS IN ACCORDANCE WITH SECTION 1705.3.	-	X

STEEL CONSTRUCTION

IBC TABLE 1705.2

TYPE	CONTINUOUS SPECIAL INSPECTION	PERIODIC SPECIAL INSPECTION
1. MATERIAL VERIFICATION OF COLD-FORMED STEEL DECK: A. IDENTIFICATION MARKINGS TO CONFORM TO ASTM STANDARDS SPECIFIED IN THE APPROVED CONSTRUCTION DOCUMENTS. B. MANUFACTURER'S CERTIFICATE TEST REPORTS.	- - -	X X
2. INSPECTION OF COLD-FORMED STEEL DECK WELDINGS: A. FLOOR DECK WELDS. B. ROOF DECK WELDS.	- - -	X X
3. INSPECTION OF REINFORCING STEEL WELDING: A. VERIFICATION OF WELD ABILITY OF REINFORCING STEEL OTHER THAN A706. B. REINFORCING STEEL RESISTING FLEXURAL AND AXIAL FORCES IN REINFORCING STEEL RESISTING FLEXURAL AND AXIAL FORCES IN OF SPECIAL REINFORCED CONCRETE SHEAR WALLS AND SHEAR REINFORCEMENT. C. SHEAR REINFORCEMENT. D. OTHER REINFORCING STEEL.	- X - - -	X - - X

ROOF GROSS UPLIFT AT OFFICES (PSF)

AREA SUPPORT FT²	ZONE 1'	ZONE 1	ZONE 2	ZONE 3
10	16.0 / -26.4	16.0 / -46.9	16.0 / -60.5	16.0 / -82.4
20	16.0 / -26.4	16.0 / -42.8	16.0 / -56.6	16.0 / -74.7
50	16.0 / -26.4	16.0 / -37.5	16.0 / -51.4	16.0 / -64.4
100	16.0 / -26.4	16.0 / -35.8	16.0 / -47.8	16.0 / -56.6

WALL AND PARAPET PRESSURES AT OFFICES (PSF)

AREA SUPPORT FT²	WALLS		PARAPETS	
	ZONE 4	ZONE 5	ZONE 4	ZONE 5
10	28.8 / -31.2	28.8 / -38.6	66.0 / -38.3	87.9 / -46.1
20	27.5 / -29.9	27.5 / -36.9	62.1 / -36.9	80.1 / -43.3
50	25.8 / -28.2	25.8 / -32.6	78.0 / -55.6	90.9 / -59.6
100	24.4 / -26.9	24.4 / -29.9	73.3 / -54.0	82.4 / -57.2

ROOF GROSS UPLIFT AT FLEET BUILDING (PSF)

AREA SUPPORT FT²	ZONE 1'	ZONE 1	ZONE 2	ZONE 3
10	16.0 / -30.6	16.0 / -53.3	16.0 / -70.3	16.0 / -95.7
20	16.0 / -30.6	16.0 / -49.7	16.0 / -65.8	16.0 / -86.7
50	16.0 / -30.6	16.0 / -43.6	16.0 / -59.7	16.0 / -74.8
100	16.0 / -30.6	16.0 / -41.6	16.0 / -55.2	16.0 / -65.8

WALL AND PARAPET PRESSURES AT FLEET BUILDING (PSF)

AREA SUPPORT FT²	WALLS		PARAPETS	
	ZONE 4	ZONE 5	ZONE 4	ZONE 5
10	33.4 / -36.3	33.4 / -44.8	N/A	N/A
20	31.9 / -34.7	31.9 / -41.7	N/A	N/A
50	29.9 / -32.7	29.9 / -37.8	N/A	N/A
100	28.4 / -31.2	28.4 / -34.7	N/A	N/A

ROOF GROSS UPLIFT AT WASH BUILDING (PSF)

AREA SUPPORT FT²	ZONE 1'	ZONE 1	ZONE 2	ZONE 3
10	16.0 / -28.5	16.0 / -48.6	16.0 / -65.4	16.0 / -89.1
20	16.0 / -28.5	16.0 / -46.3	16.0 / -61.2	16.0 / -80.7
50	16.0 / -28.5	16.0 / -40.6	16.0 / -55.6	16.0 / -69.6
100	16.0 / -28.5	16.0 / -38.7	16.0 / -51.4	16.0 / -61.2

WALL AND PARAPET PRESSURES WASH BUILDING (PSF)

AREA SUPPORT FT²	WALLS		PARAPETS	
	ZONE 4	ZONE 5	ZONE 4	ZONE 5
10	31.1 / -33.8	31.1 / -41.7	N/A	N/A
20	29.7 / -32.3	29.7 / -38.9	N/A	N/A
50	27.9 / -30.5	27.9 / -35.2	N/A	N/A
100	26.4 / -29.0	26.4 / -32.3	N/A	N/A

ROOF GROSS UPLIFT AT SALT STORAGE BUILDING (PSF)

AREA SUPPORT FT²	ZONE 1'	ZONE 1	ZONE 2	ZONE 3
10	16.0 / -32.0	16.0 / -55.6	16.0 / -73.3	16.0 / -99.8
20	16.0 / -32.0	16.0 / -51.9	16.0 / -68.6	16.0 / -90.5
50	16.0 / -32.0	16.0 / -45.5	16.0 / -62.3	16.0 / -78.0
100	16.0 / -32.0	16.0 / -43.4	16.0 / -57.6	16.0 / -68.6

WALL AND PARAPET PRESSURES SALT STORAGE BUILDING (PSF)

AREA SUPPORT FT²	WALLS		PARAPETS	
	ZONE 4	ZONE 5	ZONE 4	ZONE 5
10	34.9 / -37.8	34.9 / -46.8	N/A	N/A
20	33.3 / -36.2	33.3 / -43.5	N/A	N/A
50	31.2 / -34.2	31.2 / -39.4	N/A	N/A
100	29.6 / -32.6	29.6 / -36.2	N/A	N/A

TYPICAL GROSS UPLIFT NOTES

1. ALL UPLIFT VALUES ARE EXPRESSED IN PSF.

2. NEGATIVE VALUE DENOTES PRESSURE AWAY FROM SURFACE.

3. POSITIVE VALUE DENOTES PRESSURE AWAY FROM SURFACE.

4. EFFECTIVE DEAD LOAD TO RESIST UPLIFT = 18 PSF U.N.O. FOR WOOD FRAMING.

5. EFFECTIVE DEAD LOAD TO RESIST UPLIFT = 24 PSF U.N.O. FOR STEEL FRAMING.

A

B

C

D

E

F

G

H

J

K

L

M

N

P

Q

R

S

T



5039 S National Avenue | Springfield, MO 65810 | 417.887.659

**OWNER**  
**CITY OF WENTZVILLE, MISSOURI**  
1001 SCHROEDER CREEK BLVD  
WENTZVILLE, MO 63385  
636.327.5101

## PROJECT TEAM

CIVIL ENGINEER  
PREMIER DESIGN GROUP  
100 MIDLAND PARK DRIVE  
WENTZVILLE, MO 63385  
314.925.7444

MAINTENANCE CONSULTANT  
HDR ENGINEERING, INC.  
10450 HOLMES RD., STE 600  
SPRINGFIELD, MO 65810  
816.360.2700

STRUCTURAL ENGINEER  
METTEMMEYER ENGINEERING  
2225 W CHESTERFIELD BLVD., SUITE 300  
SPRINGFIELD, MO 65807  
417.890.8002

MEP ENGINEER  
HENDERSON ENGINEERING, INC.  
8345 LENEXA DR., #300  
LENEXA, KS 66214  
417.555.5555

## STATEMENT OF SPECIAL INSPECTIONS

---

1. SPECIAL INSPECTIONS ARE REQUIRED FOR THIS PRIMARY BUILDING FRAME / MAIN FORCE RESISTING SYSTEM PER THE LATEST EDITION OF THE IBC.
2. REFER TO THE IBC FOR ADDITIONAL INFORMATION RELATED TO THESE TABLES.
3. INSPECTIONS AND TESTING SHALL BE PROVIDED BY A QUALIFIED TESTING LABORATORY, RETAINED BY THE OWNER AND APPROVED BY THE ENGINEER OF RECORD.
4. REPORTS SHALL INDICATE THAT WORK INSPECTED OR TESTED WAS OR WAS NOT COMPLETED IN CONFORMANCE TO APPROVED CONSTRUCTION DOCUMENTS. DISCREPANCIES SHALL BE BROUGHT TO THE IMMEDIATE ATTENTION OF CONTRACTOR FOR CORRECTION. IF THEY ARE NOT CORRECT, THE DISCREPANCIES SHALL BE BROUGHT TO THE ATTENTION OF THE BUILDING OFFICIAL AND THE ENGINEER OF RECORD PRIOR TO THE COMPLETION OF THAT PHASE OF THE WORK.
5. A LETTER OF SUBSTANTIAL COMPLETION SHALL BE SUBMITTED TO THE BUILDING DEPARTMENT BY THE SPECIAL INSPECTOR PRIOR TO THE FINAL INSPECTION.

SOILS		
IBC TABLE 1705.6		
TYPE	CONTINUOUS SPECIAL INSPECTION	PERIODIC SPECIAL INSPECTION
1. VERIFY MATERIALS BELOW SHALLOW FOUNDATIONS ARE ADEQUATE TO ACHIEVE THE DESIGN BEARING CAPACITY.	-	X
2. VERIFY EXCAVATIONS ARE EXTENDED TO PROPER DEPTH AND HAVE REACHED PROPER MATERIAL.	-	X
3. PERFORM CLASSIFICATION AND TESTING OF COMPACTED FILL MATERIALS.	-	X
4. VERIFY USE OF PROPER MATERIALS, DENSITIES AND LIFT THICKNESS DURING PLACEMENT AND COMPACTION OF COMPACTED FILL.	X	-
5. PRIOR TO PLACEMENT OF COMPACTED FILL, INSPECT SUBGRADE AND VERIFY THAT SITE HAS BEEN PREPARED PROPERLY.	-	X

CONCRETE CONSTRUCTION		
IBC TABLE 1705.3		
TYPE	CONTINUOUS SPECIAL INSPECTION	PERIODIC SPECIAL INSPECTION
1. INSPECT REINFORCEMENT AND VERIFY PLACEMENT.	-	X
2. REINFORCING BAR WELDING:		
A. VERIFY WELDABILITY OF REINFORCING BARS OTHER THAN ASTM A706.	-	X
B. INSPECT SINGLE-PASS FIELD WELDS, MAXIMUM 5/16".	-	X
C. INSPECT ALL OTHER WELDS.	X	-
3. INSPECT ANCHORS CAST IN CONCRETE.	-	X
4. INSPECT ANCHORS POST-INSTALLED IN HARDENED CONCRETE MEMBERS:		
A. ADHESIVE ANCHORS INSTALLED IN HORIZONTALLY OR UPWARDLY INCLINED	X	-
B. MECHANICAL ANCHORS AND ADHESIVE ANCHORS NOT DEFINED IN 4.A.	-	X
5. VERIFY USE OF REQUIRED DESIGN MIX.	-	X
6. PRIOR TO CONCRETE PLACEMENT, FABRICATE SPECIMENS FOR STRENGTH TESTS, PERFORM SLUMP AND AIR CONTENT TESTS, AND DETERMINE THE TEMPERATURE OF THE CONCRETE.	X	-
7. INSPECT CONCRETE PLACEMENT FOR PROPER APPLICATION TECHNIQUES.	X	-
8. VERIFY MAINTENANCE OF SPECIFIED CURING TEMPERATURE AND TECHNIQUES.	-	X
9. INSPECT FORMWORK FOR SHAPE, LOCATION AND DIMENSIONS OF THE CONCRETE MEMBER BEFORE FORMED.	-	X

CAST-IN-PLACE DEEP FOUNDATION ELEMENTS		
IBC TABLE 1705.8		
TYPE	CONTINUOUS SPECIAL INSPECTION	PERIODIC SPECIAL INSPECTION
1. INSPECT DRILLING OPERATIONS AND MAINTAIN COMPLETE AND ACCURATE RECORDS FOR EACH ELEMENT.	X	-
2. VERIFY PLACEMENT LOCATIONS AND PLUMBNESS. CONFIRM ELEMENT DIAMETERS, LENGTHS, EMBEDMENT INTO BEDROCK AND ADEQUATE END-BEARING STRATA CAPACITY. RECORD CONCRETE OR GROUT VOLUMES.	X	-
3. FOR CONCRETE ELEMENTS, PERFORM TESTS AND ADDITIONAL SPECIAL INSPECTIONS IN ACCORDANCE WITH SECTION 1705.3.	-	X

STEEL CONSTRUCTION			
IBC TABLE 1705.2			
TYPE	CONTINUOUS SPECIAL INSPECTION	PERIODIC SPECIAL INSPECTION	
1. MATERIAL VERIFICATION OF COLD-FORMED STEEL DECK:			
A. IDENTIFICATION MARKINGS TO CONFORM TO ASTM SPECIFICATIONS SPECIFIED IN THE APPROVED CONSTRUCTION DOCUMENTS.	-	X	
B. MANUFACTURER'S CERTIFICATE TEST REPORTS.	-	X	
2. INSPECTION OF COLD-FORMED STEEL DECK WELDING:			
A. FLOOR DECK WELDS.	-	X	
B. ROOF DECK WELDS.	-	X	
3. INSPECTION OF REINFORCING STEEL WELDING:			
A. VERIFICATION OF WELD ABILITY OF REINFORCING STEEL OTHER THAN A706.	-	X	
B. REINFORCING STEEL RESISTING FLEXURAL AND AXIAL FORCES IN REINFORCING STEEL RESISTING FLEXURAL AND AXIAL FORCES IN OF SPECIAL REINFORCED CONCRETE SHEAR WALLS AND SHEAR REINFORCEMENT.	X	-	
C. SHEAR REINFORCEMENT.	X	-	
D. OTHER REINFORCING STEEL.	-	X	

MASONRY CONSTRUCTION			
TMS 402 AND TMS 602 LEVEL "B" QUALITY ASSURANCE		CONTINUOUS SPECIAL INSPECTION	PERIODIC SPECIAL INSPECTION
TYPE			
1. MATERIAL TESTING:			
A. VERIFICATION OF SLUMP FLOW AND VISUAL STABILITY INDEX (VSI) AS DELIVERED TO THE PROJECT SITE IN ACCORDANCE WITH ARTICLE 1.5 B 1.b.3 FOR SELF-CONSOLIDATING GROUT.		-	X
B. VERIFICATION OF fm IN ACCORDANCE WITH ARTICLE 1.4 B PRIOR TO CONSTRUCTION, EXCEPT WHERE SPECIFICALLY EXEMPTED BY THE CODE.		-	X
2. VERIFY COMPLIANCE WITH THE APPROVED SUBMITTALS.		-	X
3. AS MASONRY CONSTRUCTION BEGINS, VERIFY THAT THE FOLLOWING ARE IN COMPLIANCE:			
A. PROPORTIONS OF SITE-PREPARED MORTAR.		-	X
B. CONSTRUCTION OF MORTAR JOINTS.		-	X
C. LOCATION OF REINFORCEMENT AND CONNECTORS.		-	X
4. PRIOR TO GROUTING, VERIFY THAT THE FOLLOWING ARE IN COMPLIANCE:			
A. GROUT SPACING.		-	X
B. GRADE, TYPE, AND SIZE OF REINFORCEMENT AND ANCHOR BOLTS, AND PRESTRESSING TENDONS AND ANCHORAGE.		-	X
C. PLACEMENT OF REINFORCEMENT AND CONNECTORS.		-	X
D. PROPORTIONS OF SITE-PREPARED GROUT.		-	X
E. CONSTRUCTION OF MORTAR JOINTS.		-	X
5. VERIFY DURING CONSTRUCTION:			
A. SIZE AND LOCATION OF STRUCTURAL ELEMENTS.		-	X
B. TYPE, SIZE, AND LOCATION OF ANCHORS, INCLUDING OTHER DETAILS OF ANCHORAGE OF MASONRY TO STRUCTURAL MEMBERS, FRAMES, OR OTHER CONSTRUCTION.		-	X
C. WELDING OF REINFORCEMENT.		X	-
D. PREPARATION, CONSTRUCTION, AND PROTECTION OF MASONRY DURING COLD WEATHER OR HOT WEATHER.		-	X
E. PLACEMENT OF GROUT.		X	-
6. OBSERVATION PREPARATION OF GROUT SPECIMENS, MORTAR SPECIMENS, AND/OR PRIMIS.		-	X

STRUCTURAL STEEL			
AISC 360			
TYPE	CONTINUOUS SPECIAL INSPECTION	PERIODIC SPECIAL INSPECTION	
1. MATERIAL VERIFICATION OF HIGH-STRENGTH BOLTS, NUTS, AND WASHERS:			
A. IDENTIFICATION MARKINGS TO CONFORM TO ASTM STANDARDS SPECIFIED IN THE APPROVED CONSTRUCTION DOCUMENTS.	-	X	
B. MANUFACTURER'S CERTIFICATE OF COMPLIANCE REQUIRED.	-	X	
2. INSPECT OF HIGH-STRENGTH BOLTING:			
A. BEARING-TYPE CONNECTIONS.	-	X	
B. SLIP-CRITICAL CONNECTIONS.	X	-	
3. MATERIAL VERIFICATION OF STRUCTURAL STEEL:			
A. IDENTIFICATION MARKINGS TO CONFORM TO ASTM STANDARDS SPECIFIED IN THE APPROVED CONSTRUCTION DOCUMENTS.	-	X	
B. MANUFACTURER'S CERTIFIED MILL TEST REPORTS.	-	X	
4. MATERIAL VERIFICATION OF WELD FILLER MATERIALS:			
A. IDENTIFICATION MARKINGS TO CONFORM TO AWS SPECIFICATION IN THE APPROVED CONSTRUCTION DOCUMENTS.	-	X	
B. MANUFACTURER'S CERTIFIED OF COMPLIANCE REQUIRED.	-	X	
5. INSPECTION OF STRUCTURAL STEEL WELDING:			
A. COMPLETE AND PARTIAL PENETRATION GROOVE WELDS.	X	-	
B. MULTI-PASS FILLET WELDS.	X	-	
C. SINGLE-PASS FILLET WELDS > 5/16".	X	-	
D. SINGLE-PASS FILLET WELDS ≤ 5/16".	-	X	
6. INSPECTION OF STEEL FRAME JOINT DETAILS FOR COMPLIANCE WITH APPROVED CONSTRUCTION DOCUMENTS:			
A. DETAILS SUCH AS BRACING AND STIFFENING.	-	X	
B. MEMBER LOCATIONS.	-	X	
C. APPLICATION OF JOINT DETAILS AT EACH CONNECTION.	-	X	

WALL AND PARAPET PRESSURES AT OFFICES (PSF)				
AREA SUPPORT FT²	WALLS		PARAPETS	
	ZONE 4	ZONE 5	ZONE 4	ZONE 5
10	28.8 / -31.2	28.8 / -38.6	66.0 / -38.3	87.9 / -46.1
20	27.5 / -29.9	27.5 / -35.9	62.1 / -36.9	80.1 / -43.3
50	25.8 / -28.2	25.8 / -32.6	78.0 / -55.6	90.9 / -59.6
100	24.4 / -26.9	24.4 / -29.9	73.3 / -54.0	82.4 / -57.2

WALL AND PARAPET PRESSURES AT FLEET BUILDING (PSF)				
AREA SUPPORT FT²	WALLS		PARAPETS	
	ZONE 4	ZONE 5	ZONE 4	ZONE 5
10	33.4 / -36.3	33.4 / -44.8	N/A	N/A
20	31.9 / -34.7	31.9 / -41.7	N/A	N/A
50	29.9 / -32.7	29.9 / -37.8	N/A	N/A
100	28.4 / -31.2	28.4 / -34.2	N/A	N/A

WALL AND PARAPET PRESSURES WASH BUILDING (PSF)				
AREA SUPPORT FT <sup>2</sup>	WALLS		PARAPETS	
	ZONE 4	ZONE 5	ZONE 4	ZONE 5
10	31.1 / -33.8	31.1 / -41.7	N/A	N/A
20	29.7 / -32.3	29.7 / -38.9	N/A	N/A
50	27.9 / -30.5	27.9 / -35.2	N/A	N/A
100	26.4 / -29.0	26.4 / -32.3	N/A	N/A

WALL AND PARAPET PRESSURES SALT STORAGE BUILDING (PSF)					
AREA SUPPORT FT <sup>2</sup>	WALLS		PARAPETS		
	ZONE 4	ZONE 5	ZONE 4	ZONE 5	
10	34.9 / -37.8	34.9 / -46.8	N/A	N/A	
20	33.3 / -36.2	33.3 / -43.5	N/A	N/A	
50	31.2 / -34.2	31.2 / -39.4	N/A	N/A	
100	29.6 / -32.6	29.6 / -36.2	N/A	N/A	


TYPICAL GROSS UPLIFT NOTES	
1.	ALL UPLIFT VALUES ARE EXPRESSED IN PSF.
2.	NEGATIVE VALUE DENOTES PRESSURE AWAY FROM SURFACE.
3.	POSITIVE VALUE DENOTES PRESSURE AROUND SURFACE.
4.	EFFECTIVE DEAD LOAD TO RESIST UPLIFT = 18 PSF U.N.O. FOR WOOD FRAMING.
5.	EFFECTIVE DEAD LOAD TO RESIST UPLIFT = 24 PSF U.N.O. FOR STEEL FRAMING.

ROOF GROSS UPLIFT AT OFFICES (PSF)				
AREA SUPPORT FT²	ZONE 1'	ZONE 1	ZONE 2	ZONE 3
10	16.0 / -26.4	16.0 / -45.9	16.0 / -60.5	16.0 / -82.4
20	16.0 / -26.4	16.0 / -42.8	16.0 / -56.6	16.0 / -74.7
50	16.0 / -26.4	16.0 / -37.5	16.0 / -51.4	16.0 / -64.4
100	16.0 / -26.4	16.0 / -35.8	16.0 / -47.6	16.0 / -56.6

ROOF GROSS UPLIFT AT FLEET BUILDING (PSF)				
AREA SUPPORT FT²	ZONE 1'	ZONE 1	ZONE 2	ZONE 3
10	16.0 / -30.6	16.0 / -53.3	16.0 / -70.3	16.0 / -95.7
20	16.0 / -30.6	16.0 / -49.7	16.0 / -85.8	16.0 / -86.7
50	16.0 / -30.6	16.0 / -43.6	16.0 / -59.7	16.0 / -74.8
100	16.0 / -30.6	16.0 / -41.6	16.0 / -55.2	16.0 / -65.8

ROOF GROSS UPLIFT AT WASH BUILDING (PSF)				
AREA SUPPORT FT²	ZONE 1'	ZONE 1	ZONE 2	ZONE 3
10	16.0 / -28.5	16.0 / -49.6	16.0 / -65.4	16.0 / -89.1
20	16.0 / -28.5	16.0 / -46.3	16.0 / -61.2	16.0 / -80.7
50	16.0 / -28.5	16.0 / -40.6	16.0 / -55.6	16.0 / -69.6
100	16.0 / -28.5	16.0 / -38.7	16.0 / -51.4	16.0 / -61.2

ROOF GROSS UPLIFT AT SALT STORAGE BUILDING (PSF)				
AREA SUPPORT FT²	ZONE 1'	ZONE 1	ZONE 2	ZONE 3
10	16.0 / -32.0	16.0 / -55.6	16.0 / -73.3	16.0 / -99.8
20	16.0 / -32.0	16.0 / -51.9	16.0 / -68.6	16.0 / -90.5
50	16.0 / -32.0	16.0 / -45.5	16.0 / -62.3	16.0 / -78.0
100	16.0 / -32.0	16.0 / -43.4	16.0 / -57.6	16.0 / -68.6

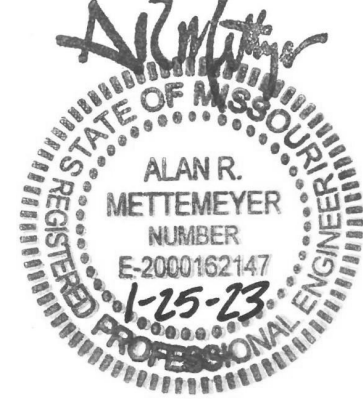



	A	B		C		D		E		F							
	STRAIGHT DOWEL DEVELOPMENT LENGTHS (INCHES)																
	Fy = 60,000 PSI																
14	BAR SIZE	TENSION												COMPRESSION			
		OTHER BARS						TOP BARS									
		3000 PSI CONCRETE	4000 PSI CONCRETE	5000 PSI CONCRETE	6000 PSI CONCRETE	7000 PSI CONCRETE	8000 PSI CONCRETE	3000 PSI CONCRETE	4000 PSI CONCRETE	5000 PSI CONCRETE	6000 PSI CONCRETE	7000 PSI CONCRETE	8000 PSI CONCRETE	3000 PSI CONCRETE	4000 PSI CONCRETE	5000 PSI-10,000 PSI CONCRETE	
	#3	17	15	13	12	12	12	22	19	17	16	14	14	9	8	8	
	#4	22	19	17	16	15	14	29	25	23	21	19	18	11	10	9	
	#5	28	24	22	20	18	17	36	31	28	26	24	22	14	12	12	
	#6	33	29	26	24	22	21	43	37	34	31	28	27	17	15	14	
	#7	48	42	38	34	32	30	63	54	49	45	41	39	20	17	16	
	#8	55	48	43	39	36	34	72	62	56	51	47	44	22	19	18	
	#9	62	54	48	44	41	38	81	70	63	57	53	50	25	22	21	
	#10	70	61	54	50	46	43	91	79	71	64	60	56	28	25	23	
	#11	78	67	60	55	51	48	101	87	78	71	66	62	31	27	26	
	#14	93	81	72	66	61	57	121	105	94	86	79	74	38	33	31	
	#18	124	108	96	88	81	76	161	140	125	114	106	99	50	43	41	
13	NOTES:																
	1. TOP BARS ARE HORIZONTAL REINFORCEMENT PLACED SO THAT MORE THAN 12" OF FRESH CONCRETE IS CAST IN THE MEMBER BELOW THE REINFORCEMENT.																
	2. DEVELOPMENT LENGTHS IN TENSION ARE BASED ON THE FOLLOWING. NOTIFY ENGINEER IF ONE OF THE FOLLOWING CRITERIA IS NOT MET: A. CLEAR SPACING OF BARS BEING DEVELOPED OR SPICED IS NOT LESS THAN THE BAR DIAMETER; CLEAR COVER NOT LESS THAN THE BAR DIAMETER, AND STIRRUPS OR TIES THROUGHOUT THE DEVELOPMENT LENGTH NOT LESS THAN THE CODE MINIMUM. OR																
12	B. CLEAR SPACING OF BARS BEING DEVELOPED OR SPICED NOT LESS THAN 2 TIMES THE BAR DIAMETER AND CLEAR COVER NOT LESS THAN THE BAR DIAMETER.																


		LAP SPlice LENGTHS (INCHES) Fy = 60,000 PSI															
BAR SIZE		TENSION (CLASS B SPlice)														COMPRESSION	
		OTHER BARS						TOP BARS									
		3000 PSI CONCRETE	4000 PSI CONCRETE	5000 PSI CONCRETE	5000 PSI CONCRETE	7000 PSI CONCRETE	8000 PSI CONCRETE	3000 PSI CONCRETE	4000 PSI CONCRETE	5000 PSI CONCRETE	5000 PSI CONCRETE	7000 PSI CONCRETE	8000 PSI CONCRETE	3000 PSI-10,000 PSI CONCRETE			
11	#3	23	20	17	16	15	15	29	25	23	21	19	19	19	12		
	#4	29	25	23	21	20	19	38	33	30	28	25	24	15			
	#5	37	32	29	26	24	23	47	41	37	34	32	29	19			
	#6	43	38	34	32	29	28	56	49	45	41	37	36	23			
	#7	63	55	50	45	42	39	82	71	64	59	54	51	27			
	#8	72	63	56	51	47	45	94	81	73	67	62	58	30			
10	#9	81	71	63	58	54	50	106	91	82	75	69	65	34			
	#10	91	80	71	65	60	56	119	103	93	84	78	73	39			
	#11	102	88	78	72	67	63	132	114	102	93	86	81	43			
	#14	N/A	N/A	N/A	N/A	N/A	N/A	N/A	N/A	N/A	N/A	N/A	N/A	N/A	51		
	#16	N/A	N/A	N/A	N/A	N/A	N/A	N/A	N/A	N/A	N/A	N/A	N/A	N/A	68		
	NOTES:																
1.	TOP BARS ARE HORIZONTAL REINFORCEMENT PLACED SO THAT MORE THAN 12" OF FRESH CONCRETE IS CAST IN THE MEMBER BELOW THE REINFORCEMENT.																
2.	DEVELOPMENT LENGTHS IN TENSION ARE BASED ON THE FOLLOWING: NOTIFY ENGINEER IF ONE OF THE FOLLOWING CRITERIA IS NOT MET: A. CLEAR SPACING OF BARS BEING DEVELOPED OR SPICED IS NOT LESS THAN THE BAR DIAMETER, CLEAR COVER NOT LESS THAN THE BAR DIAMETER, AND STIRRUPS OR TIES THROUGHOUT THE DEVELOPMENT LENGTH NOT LESS THAN THE CODE MINIMUM, OR B. CLEAR SPACING OF BARS BEING DEVELOPED OR SPICED NOT LESS THAN 2 TIMES THE BAR DIAMETER AND CLEAR COVER NOT LESS THAN THE BAR DIAMETER.																


HOOKED DOWEL DEVELOPMENT LENGTHS IN TENSION (INCHES)										
Fy = 60,000 PSI										
BAR SIZE	EMBEDMENT						EXTENSION		MINIMUM BEND DIAMETER (IN.)	
	3000 PSI CONCRETE	4000 PSI CONCRETE	5000 PSI CONCRETE	6000 PSI CONCRETE	7000 PSI CONCRETE	8000 PSI CONCRETE	90° HOOK	180° HOOK		
#3	6	6	6	6	6	6	5	3		3
#4	8	7	6	6	6	6	6	3		4
#5	10	8	7	7	6	6	8	3		5
#6	12	10	9	8	8	7	9	3		6
#7	13	12	10	9	9	8	11	4		7
#8	15	13	12	11	10	9	12	4		8
#9	17	15	13	12	11	11	14	5		12
#10	19	17	15	14	13	12	16	6		13
#11	22	19	17	15	14	13	17	6		15

INTERIOR LIGHT GAGE WALL STUD SIZES			
MAX WALL HEIGHT	STUD SIZE	SPACING	REQUIRED BLOCKING/BRIDGING
14'-8"	362S137-33	16"	MANUFACTURER'S STANDARD @ 4'-0" O.C.
15'-4"	362S162-33	16"	MANUFACTURER'S STANDARD @ 4'-0" O.C.
21'-8"	600S137-33	16"	MANUFACTURER'S STANDARD @ 4'-0" O.C.
22'-9"	600S162-33	16"	MANUFACTURER'S STANDARD @ 4'-0" O.C.

EXTERIOR LIGHT GAGE HEADER SCHEDULE			
SPAN	REDHEADER TYPE	HEADER CLIP	JAMB STUD
6'-0" - 9'-0"	587HS300-54	14GA W/ 4/6 SCREW PATTERN	600S300-54
9'-0" - 15'-6"	587HS350-97	14GA W/ 4/6 SCREW PATTERN	600S300-97

CONCRETE PEDESTAL SCHEDULE					
PEDESTAL LOCATION	PEDESTAL SIZE (INCHES)	B/PEDESTAL	T/PEDESTAL	REBAR DOWELS	REBAR TIES
D-23	24" x 24"	EL+98'-0"	EL+99'-4"	(6) #6	#3 @ 9" O.C., TOP (3) IN TOP 5' OF PED.
D-23.5	24" x 24"	EL+98'-0"	EL+99'-4"	(6) #6	#3 @ 9" O.C., TOP (3) IN TOP 5' OF PED.
D-24	36" x 36"	EL+98'-0"	EL+99'-4"	(12) #6	#3 @ 9" O.C., TOP (3) IN TOP 5' OF PED.
E-1,23.5	24" x 24"	EL+94'-0"	EL+98'-0"	(6) #6	#3 @ 9" O.C., TOP (3) IN TOP 5' OF PED.
E-1,24	36" x 36"	EL+94'-0"	EL+98'-0"	(12) #6	#3 @ 9" O.C., TOP (3) IN TOP 5' OF PED.

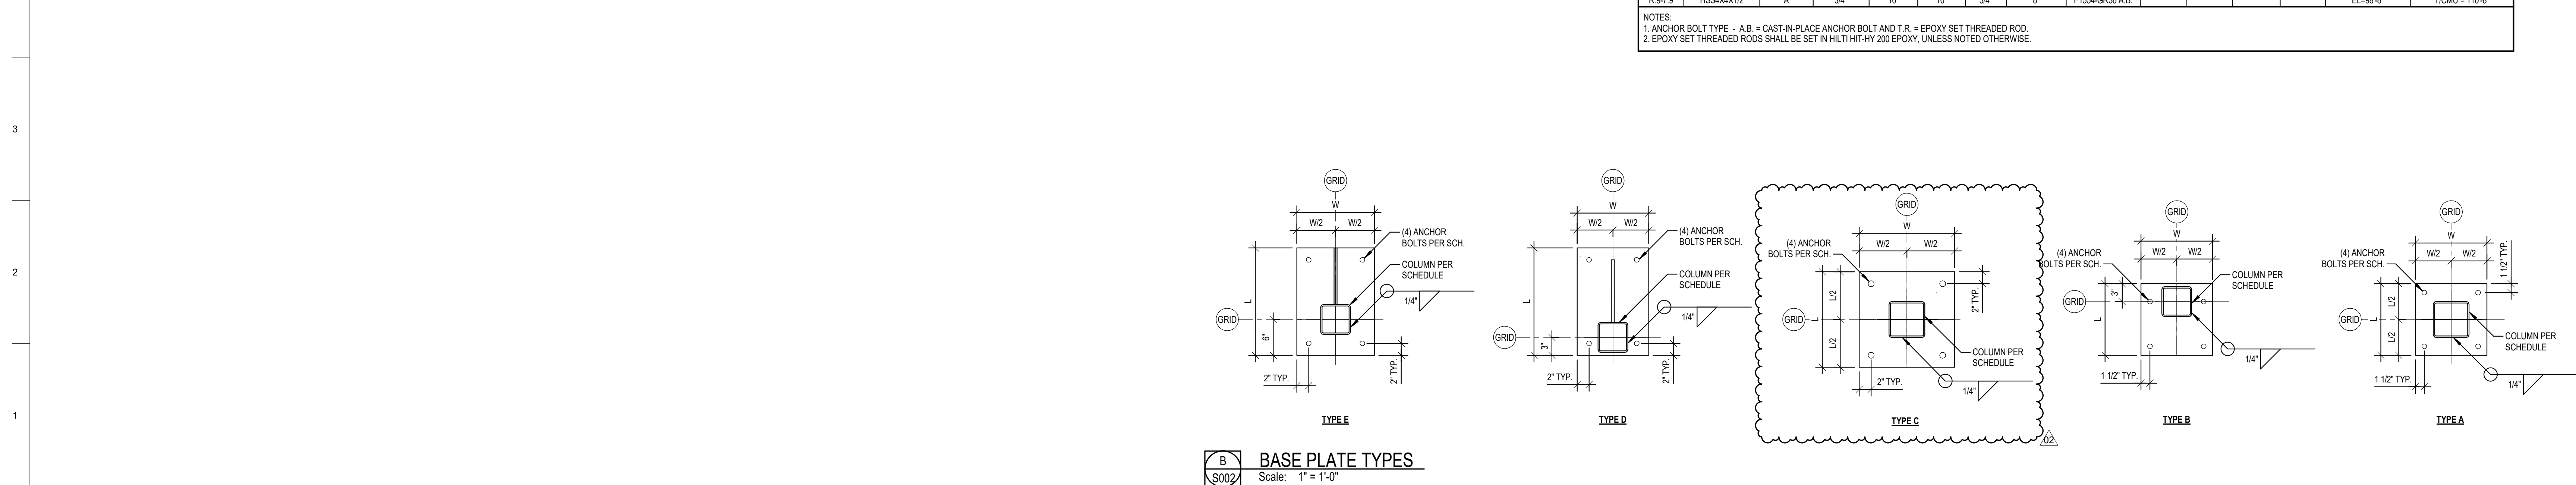

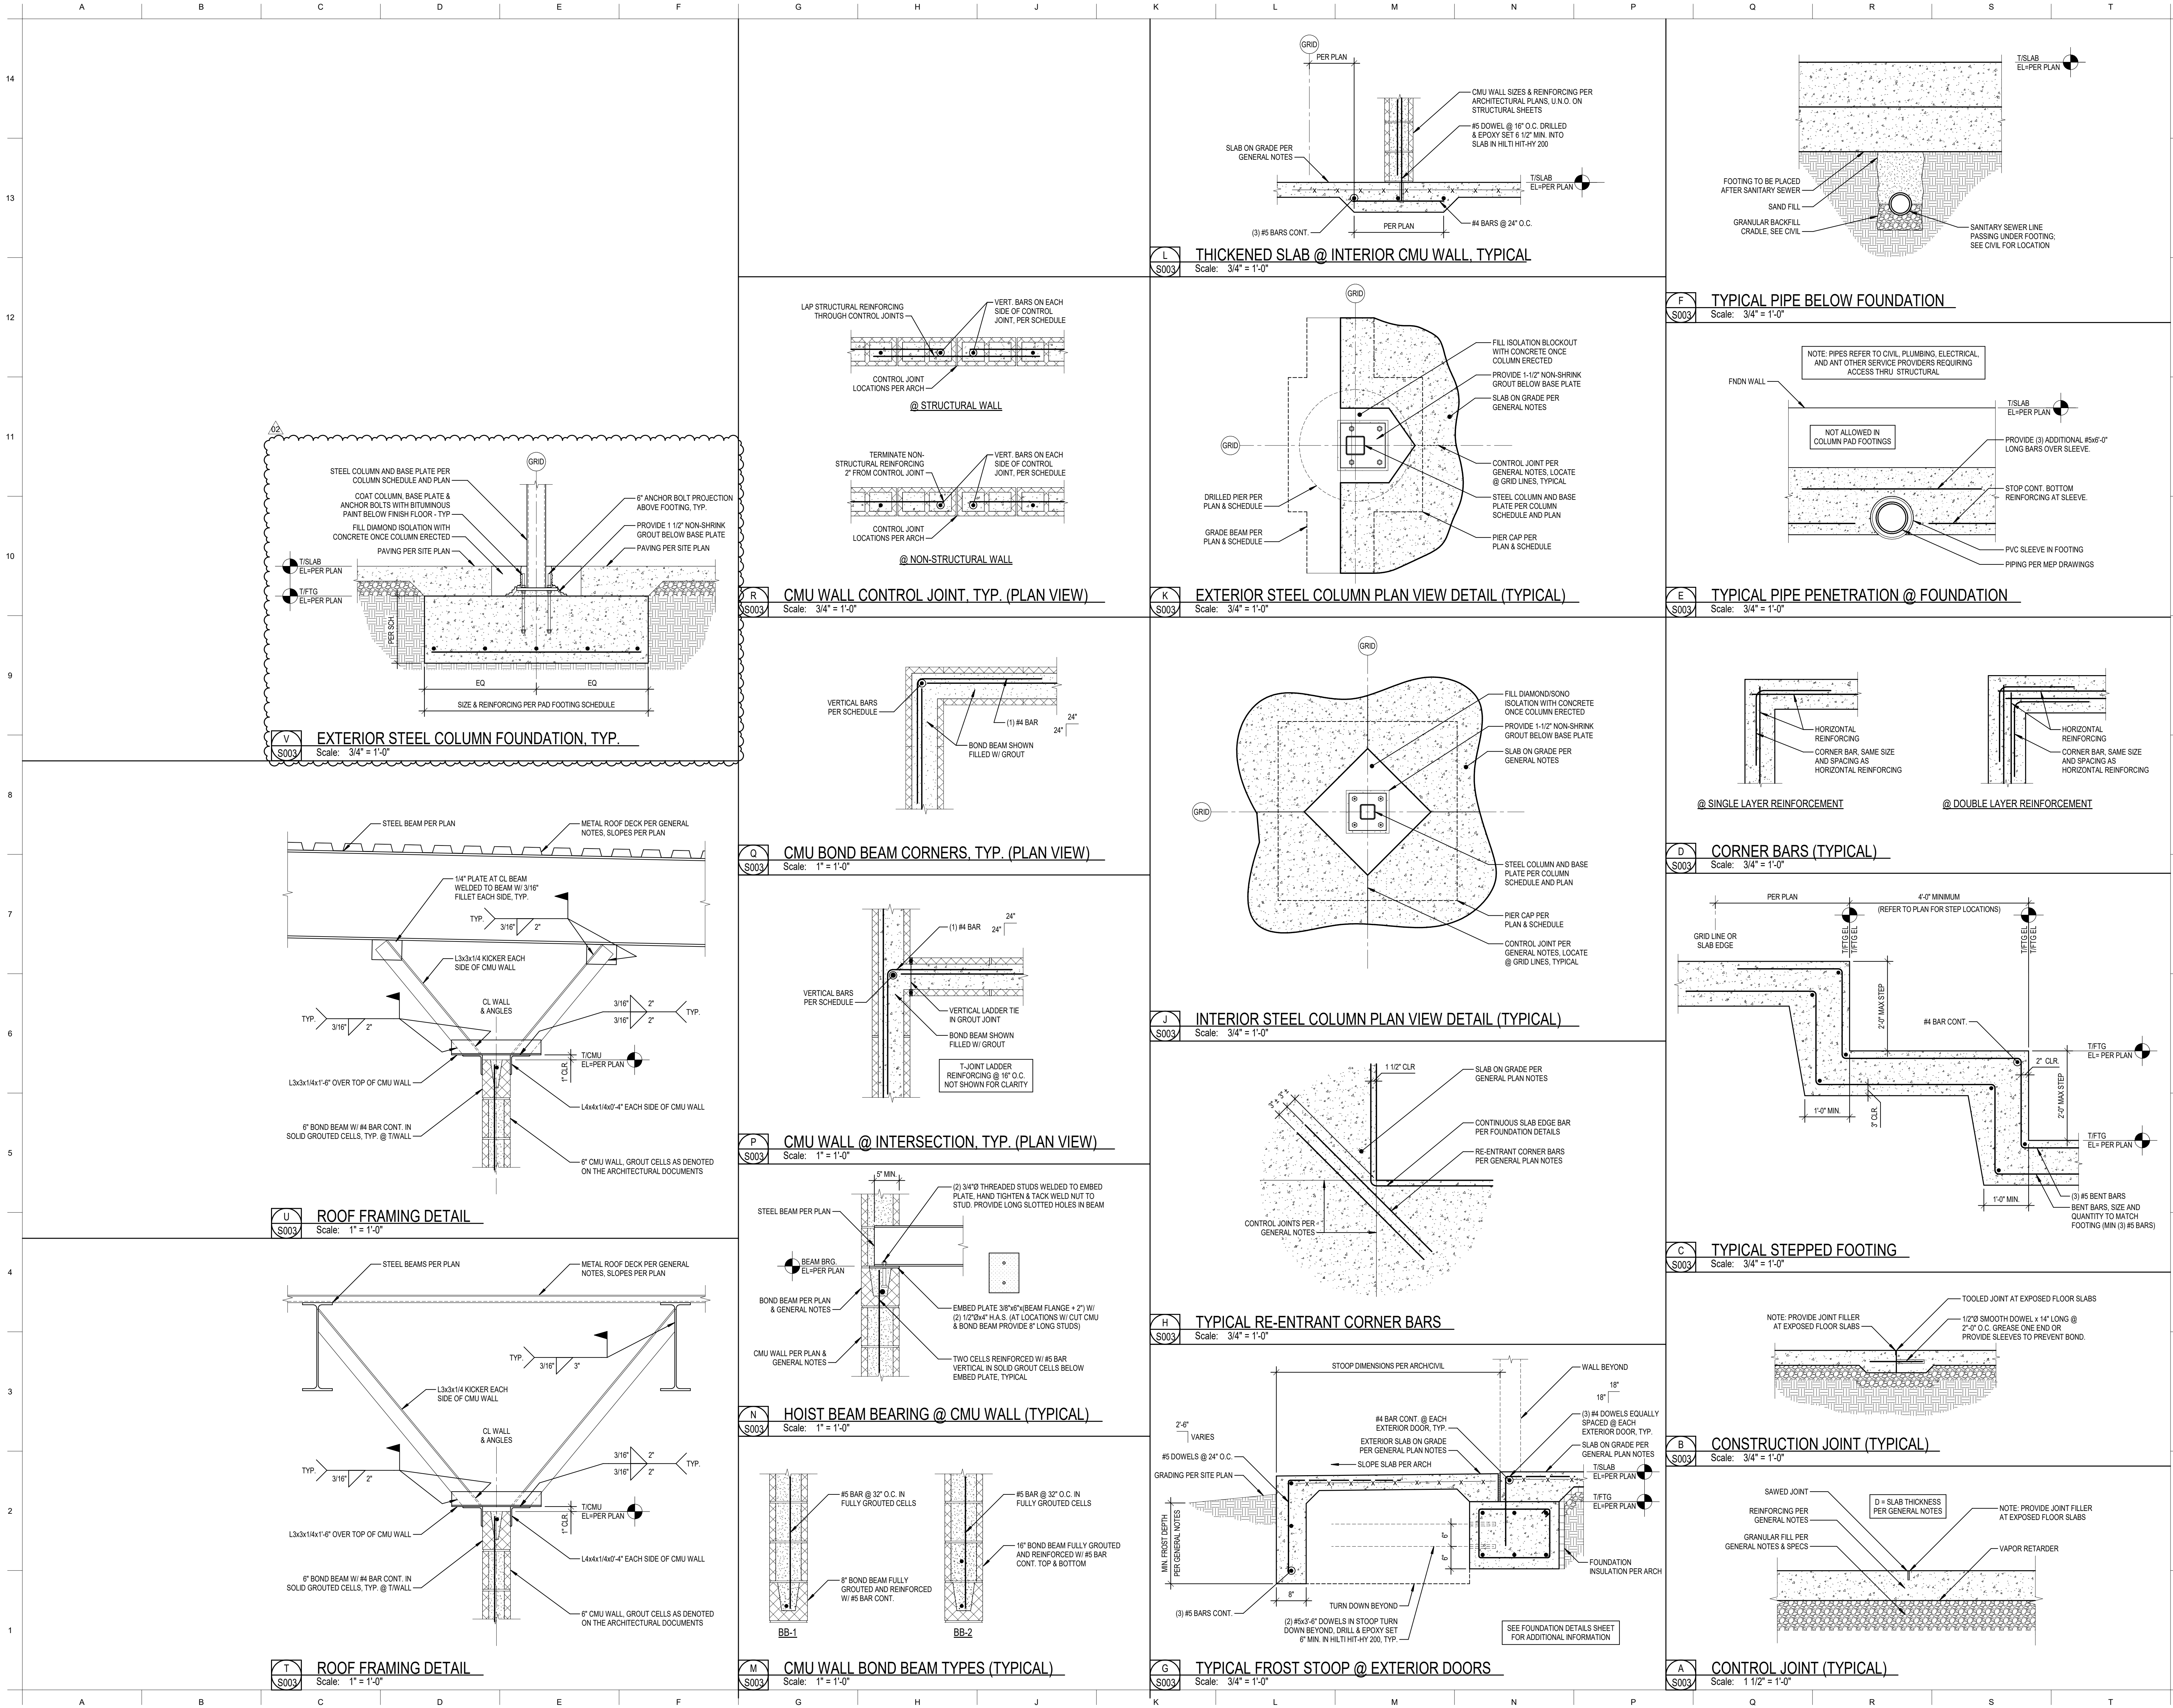

**OWNER**  
**CITY OF WENTZVILLE, MISSOURI**  
1001 SCHROEDER CREEK BLVD  
WENTZVILLE, MO 63385  
636.327.5101

**PROJECT TEAM**  
**CIVIL ENGINEER**  
PREMIER DESIGN GROUP  
100 MIDLAND PARK DRIVE  
WENTZVILLE, MO 63385  
314.925.7444

**MAINTENANCE CONSULTANT**  
HDR ENGINEERING, INC.  
10450 HOLMES RD., STE. 600  
SPRINGFIELD, MO 65810  
816.360.2700


**STRUCTURAL ENGINEER**  
METTEMAYER ENGINEERING  
2225 W CHESTERFIELD BLVD., SUITE 300  
SPRINGFIELD, MO 65807  
417.890.8002

**MEP ENGINEER**  
HENDERSON ENGINEERING, INC.  
8345 LENEXA DR., #300  
LENEXA, KS 66214  
417.555.5555

REVISIONS		
NO.	DESCRIPTION	DATE
01	ADD 01	01/11/23
02	ADD 02	01/25/23

PROJECT NO.: 20-0067 DRAWN BY: MRH, TNB  
DATE: 12.15.22 REVIEWED BY: BSW

**PROFESSIONAL SEAL**  
**ALAN R. METTEMAYER, PE**  
PROFESSIONAL TITLE: ENGINEER  
MO# E-2000162147

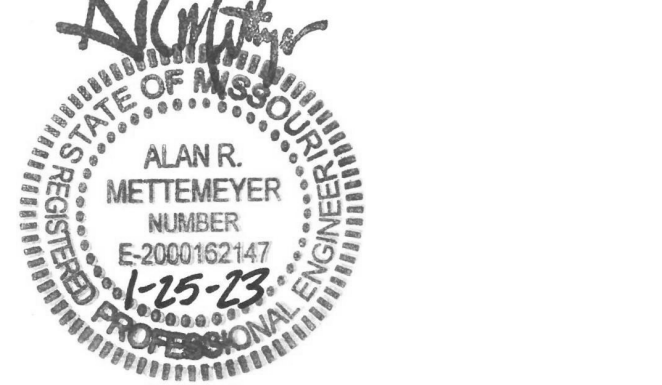


© 2021 H DESIGN GROUP, LLC.  
THIS DRAWING AND THE ARCHITECTURAL WORK REPRESENTED ARE OWNED BY H DESIGN GROUP, LLC. COPYRIGHT INCLUDES THE DRAWING, AS WELL AS ALL COMPONENTS OF THE CONCEPTUAL DESIGN. REPRODUCTION OF ANY KIND IS STRICTLY PROHIBITED WITHOUT THE EXPRESSED WRITTEN CONSENT OF H DESIGN GROUP, LLC.

**PROJECT TITLE**  
**CITY OF WENTZVILLE, MO PUBLIC WORKS FACILITY**

**PROJECT ADDRESS:**  
1295 INTERSTATE DRIVE  
WENTZVILLE, MO 63385

**TYPICAL DETAILS**



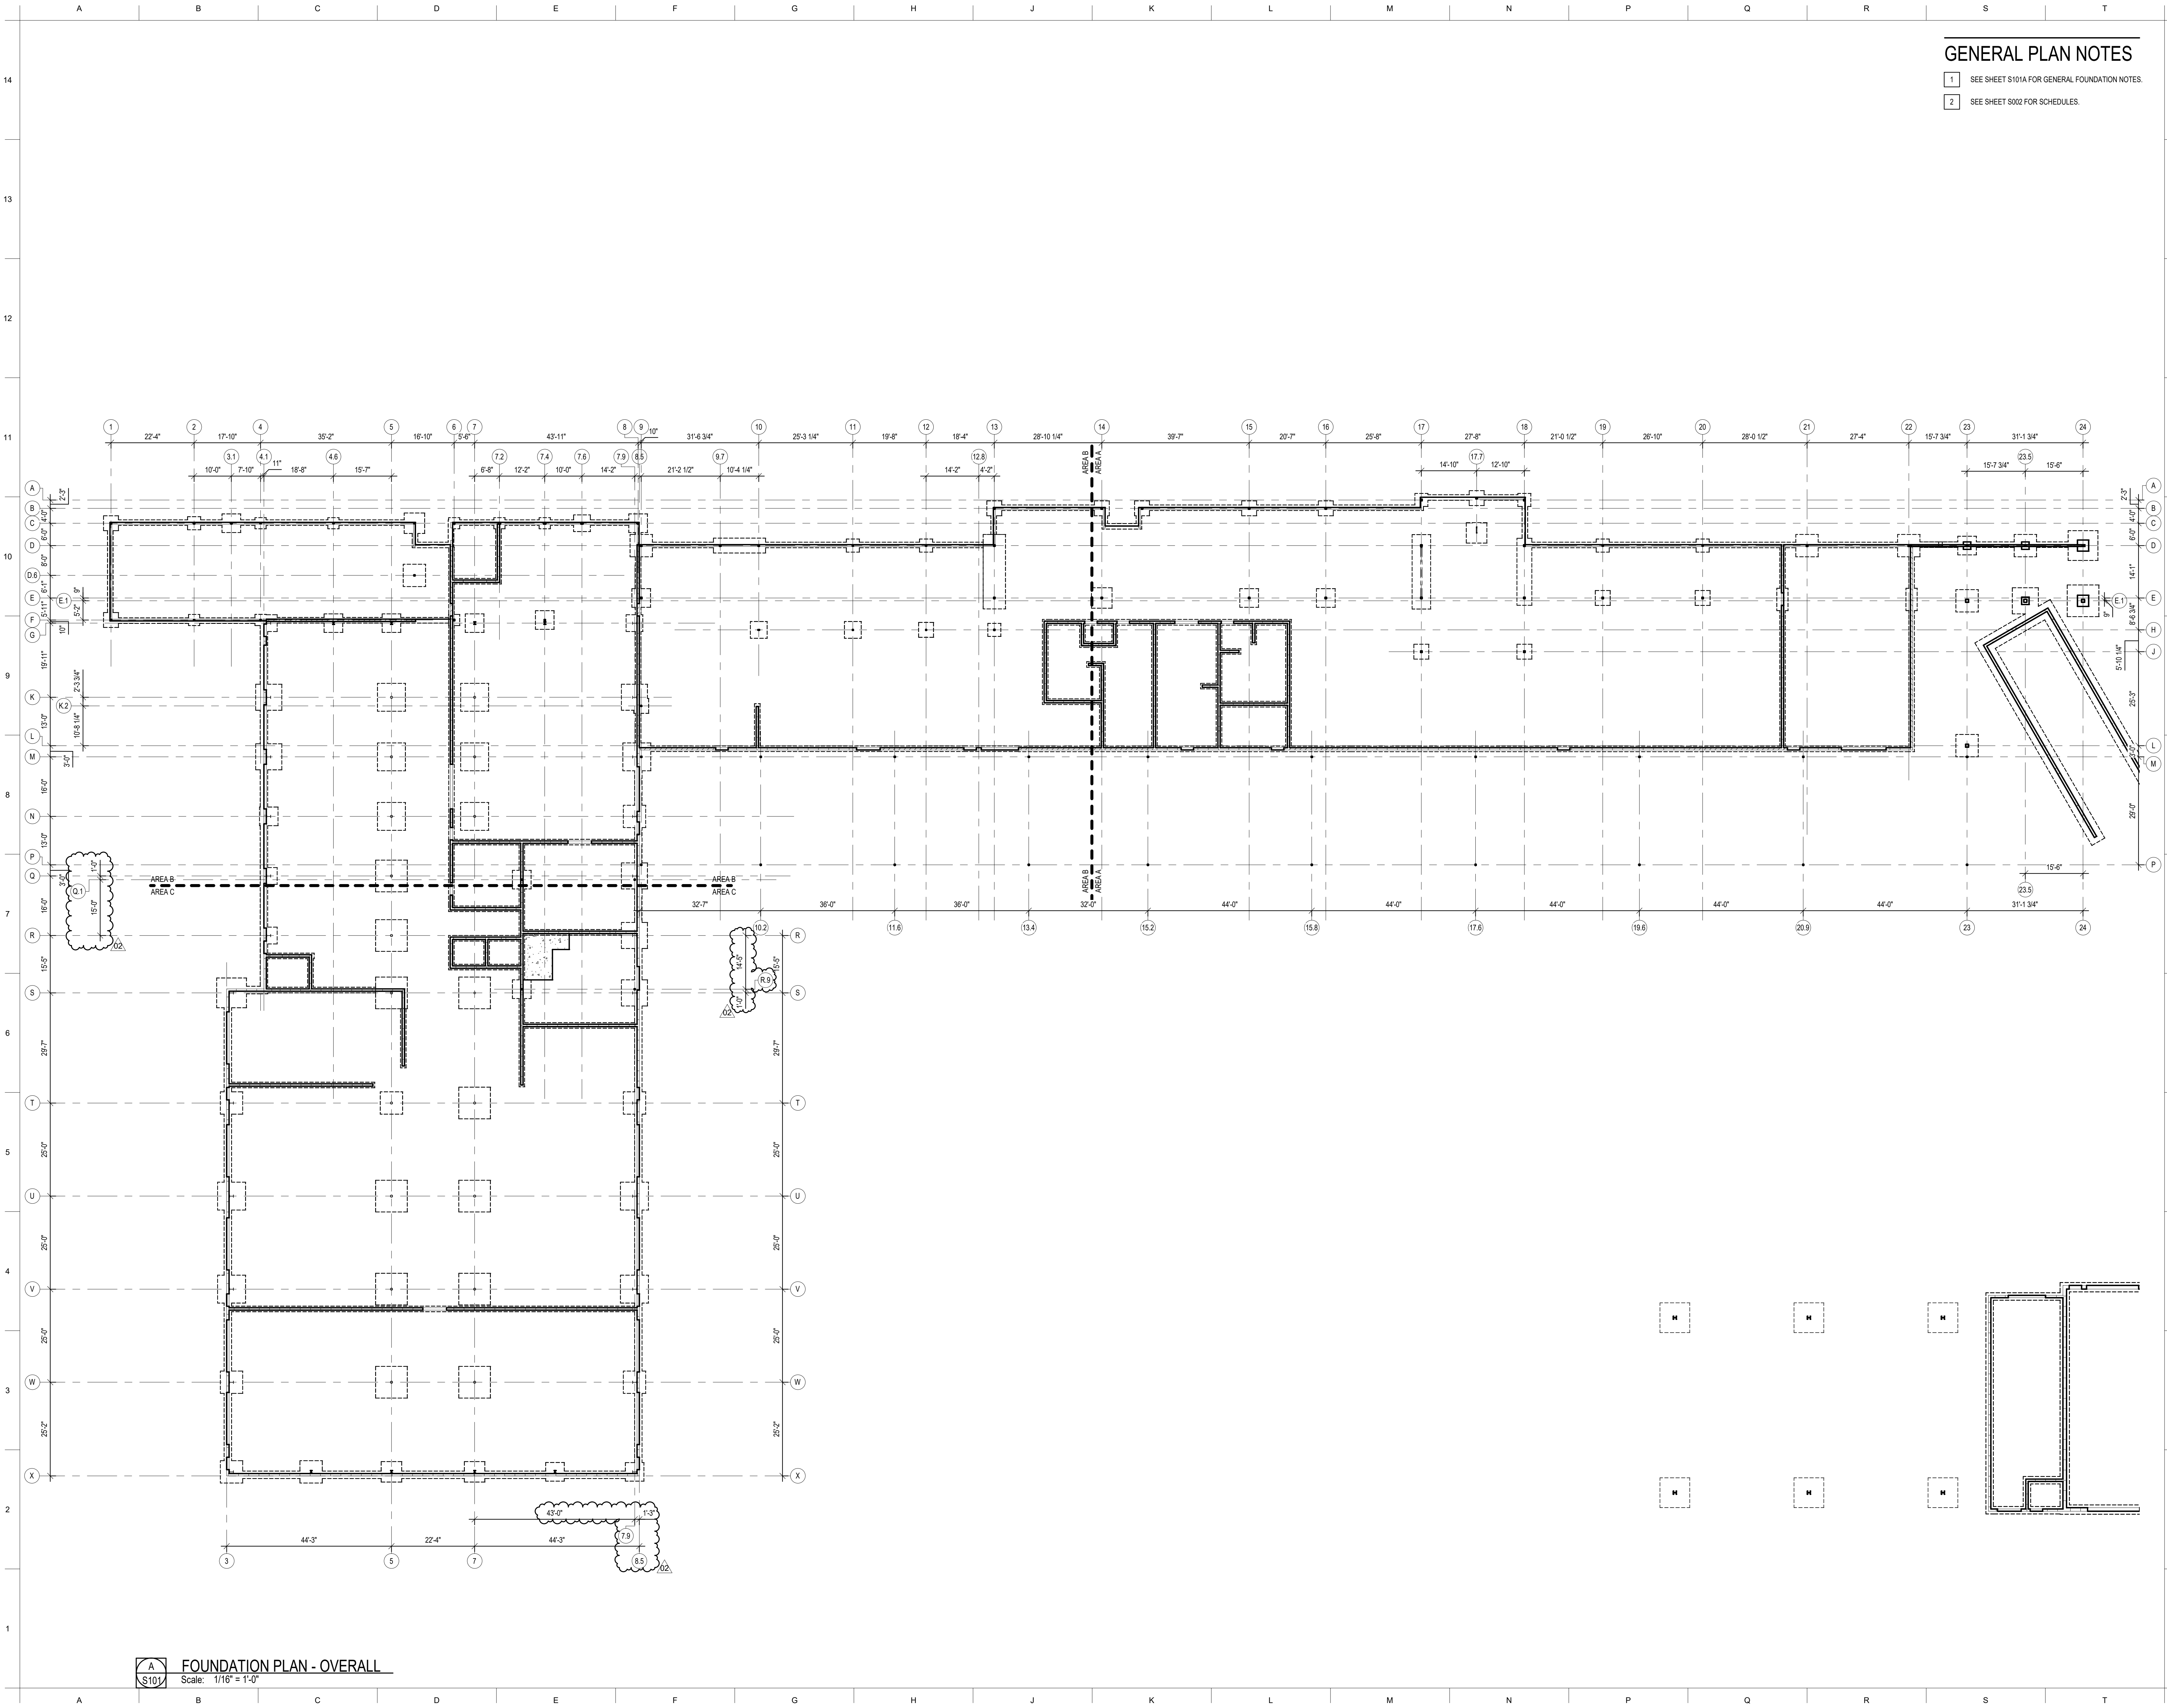

GENERAL PLAN NOTES

- 1 SEE SHEET S101A FOR GENERAL FOUNDATION NOTES.  
2 SEE SHEET S002 FOR SCHEDULES.



5039 S National Avenue | Springfield, MO 65810 | 417.887.6595


OWNER  
CITY OF WENTZVILLE, MISSOURI  
1001 SCHROEDER CREEK BLVD  
WENTZVILLE, MO 63385  
636.327.5101

PROJECT TEAM  
CIVIL ENGINEER  
PREMIER DESIGN GROUP  
100 MIDLAND PARK DRIVE  
WENTZVILLE, MO 63385  
314.925.7444  
MAINTENANCE CONSULTANT  
HDR ENGINEERING, INC.  
10450 HOLMES RD., STE 600  
SPRINGFIELD, MO 65810  
816.360.2700  
STRUCTURAL ENGINEER  
METTEMMEYER ENGINEERING  
2225 W CHESTERFIELD BLVD., SUITE 300  
SPRINGFIELD, MO 65807  
417.890.8002  
MEP ENGINEER  
HENDERSON ENGINEERING, INC.  
8345 LENEXA DR., #300  
LENEXA, KS 66214  
417.555.5555

REVISIONS		
NO.	DESCRIPTION	DATE
01	ADD 01	01/11/23
02	ADD 02	01/25/23

PROJECT NO.: 20-0067 DRAWN BY: MRH, TNB  
DATE: 12.15.22 REVIEWED BY: BSW

PROFESSIONAL SEAL  
ALAN R. METTEMMEYER, PE  
PROFESSIONAL TITLE: ENGINEER  
MO# E-2000162147

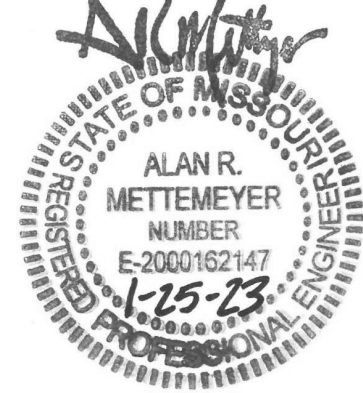

© 2021 H DESIGN GROUP, LLC.  
THIS DRAWING AND THE ARCHITECTURAL WORK REPRESENTED ARE OWNED  
BY H DESIGN GROUP, LLC. COPYRIGHT INCLUDES THE DRAWING, AS WELL  
AS ALL COMPONENTS OF THE CONCEPTUAL DESIGN. REPRODUCTION OF ANY  
KIND IS STRICTLY PROHIBITED WITHOUT THE EXPRESSED WRITTEN CONSENT  
OF H DESIGN GROUP, LLC.


PROJECT TITLE  
CITY OF WENTZVILLE, MO PUBLIC  
WORKS FACILITY

PROJECT ADDRESS  
1296 INTERSTATE DRIVE  
WENTZVILLE, MO 63385

FOUNDATION PLAN - OVERALL

A FOUNDATION PLAN - OVERALL  
Scale: 1/16" = 1'-0"

SHEET  
S101

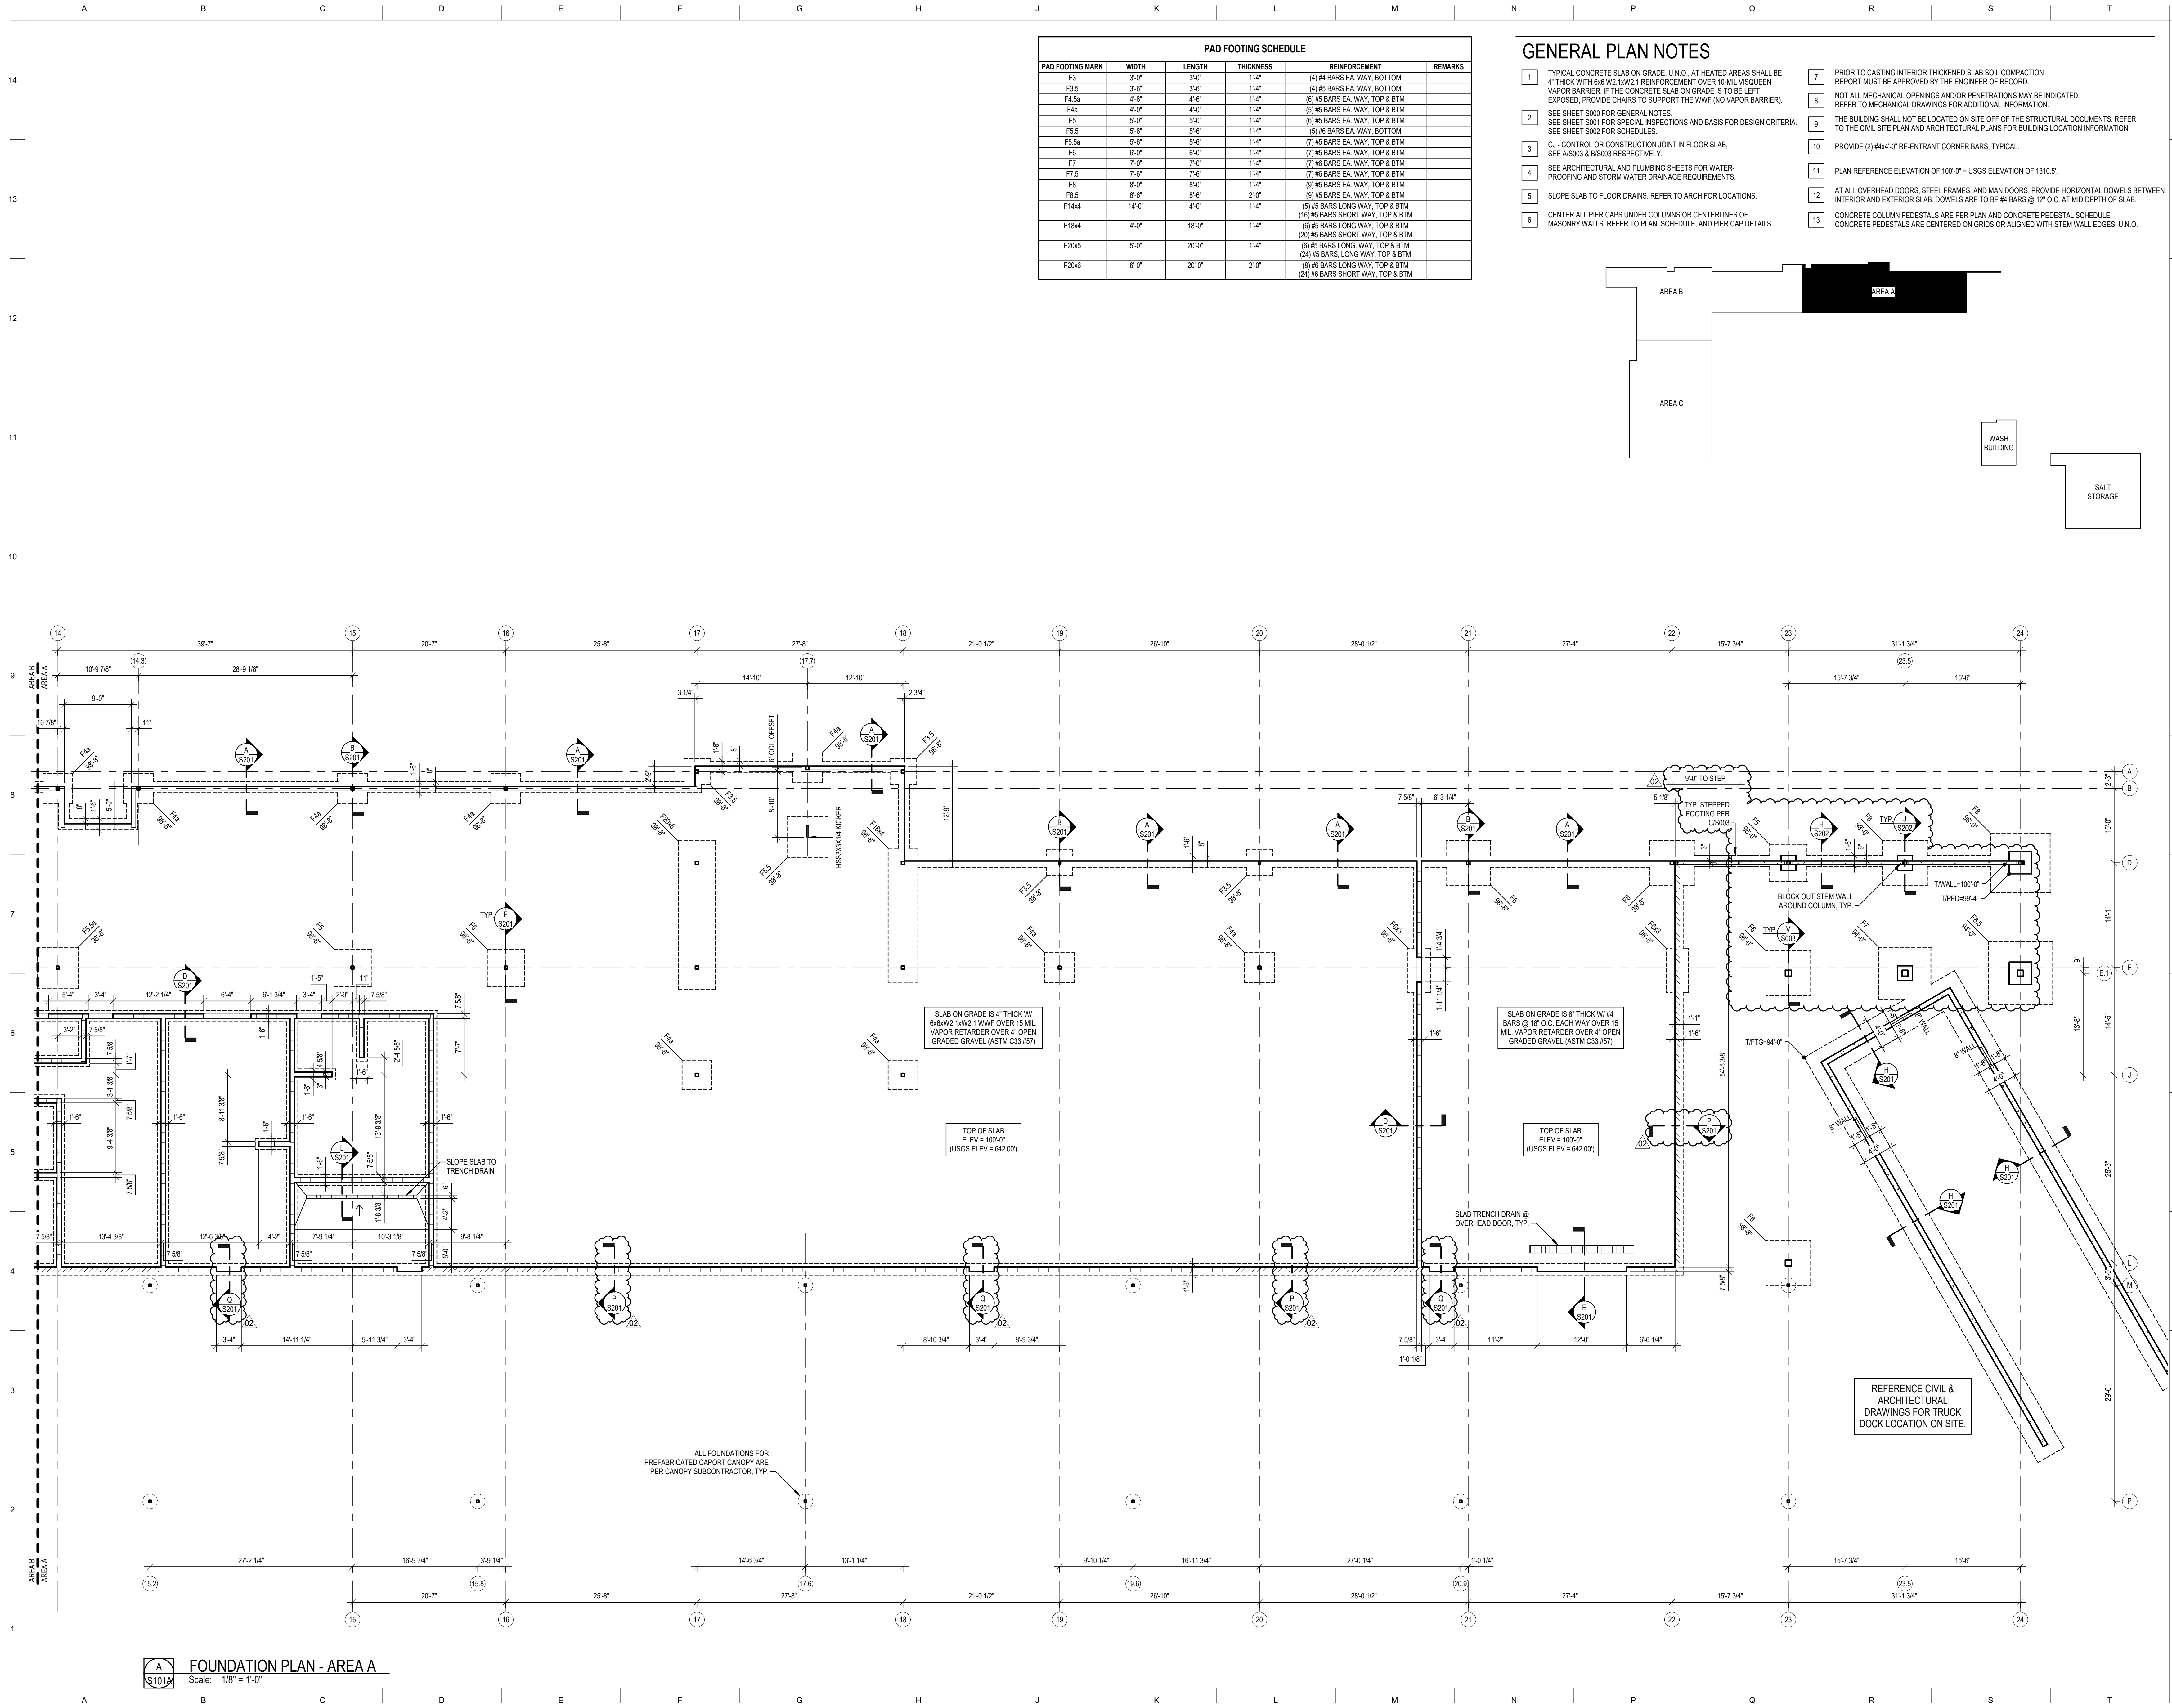

PAD FOOTING SCHEDULE					
PAD FOOTING MARK	WIDTH	LENGTH	THICKNESS	REINFORCEMENT	REMARKS
F3	3'-0"	3'-0"	1'-4"	(4) #4 BARS EA. WAY, BOTTOM	
F3.5	3'-6"	3'-6"	1'-4"	(4) #5 BARS EA. WAY, BOTTOM	
F4.5a	4'-6"	4'-6"	1'-4"	(6) #5 BARS EA. WAY, TOP & BTM	
F4b	4'-0"	4'-0"	1'-4"	(3) #6 BARS EA. WAY, TOP & BTM	
F5	5'-0"	5'-0"	1'-4"	(6) #5 BARS EA. WAY, TOP & BTM	
F5.5	5'-6"	5'-6"	1'-4"	(5) #6 BARS EA. WAY, BOTTOM	
F5.5a	5'-6"	5'-6"	1'-4"	(7) #5 BARS EA. WAY, TOP & BTM	
F6	6'-0"	6'-0"	1'-4"	(7) #5 BARS EA. WAY, TOP & BTM	
F7	7'-0"	7'-0"	1'-4"	(7) #6 BARS EA. WAY, TOP & BTM	
F7.5	7'-6"	7'-6"	1'-4"	(7) #6 BARS EA. WAY, TOP & BTM	
F8	8'-0"	8'-0"	1'-4"	(9) #5 BARS EA. WAY, TOP & BTM	
F8.5	8'-6"	8'-6"	2'-0"	(9) #5 BARS EA. WAY, TOP & BTM	
F14a	14'-0"	4'-0"	1'-4"	(5) #5 BARS LONG WAY, TOP & BTM (16) #5 BARS SHORT WAY, TOP & BTM	
F14b4	4'-0"	18'-0"	1'-4"	(6) #5 BARS LONG WAY, TOP & BTM (20) #5 BARS SHORT WAY, TOP & BTM	
F20a5	5'-0"	20'-0"	1'-4"	(6) #5 BARS LONG WAY, TOP & BTM (24) #5 BARS LONG WAY, TOP & BTM	
F20b6	6'-0"	20'-0"	2'-0"	(8) #6 BARS LONG WAY, TOP & BTM (24) #6 BARS SHORT WAY, TOP & BTM	

GENERAL PLAN NOTES

- 1

TYPICAL CONCRETE SLAB ON GRADE, U.N.O., AT HEATED AREAS SHALL BE 4" THICK WITH 6# W2 HWF 1 REINFORCEMENT OVER 10 MIL VISCQUEEN VAPOR BARRIER. IF THE CONCRETE SLAB ON GRADE IS TO BE LEFT EXPOSED, PROVIDE CHAIRS TO SUPPORT THE WWF (NO VAPOR BARRIER).
- 2

SEE SHEET S000 FOR GENERAL NOTES.  
SEE SHEET S001 FOR SPECIAL INSPECTIONS AND BASIS FOR DESIGN CRITERIA.  
SEE SHEET S002 FOR SCHEDULES.
- 3

C.J. - CONTROL OR CONSTRUCTION JOINT IN FLOOR SLAB, SEE A/S003 & B/S003 RESPECTIVELY.
- 4

SEE ARCHITECTURAL AND PLUMBING SHEETS FOR WATER-PROOFING AND STORM WATER DRAINAGE REQUIREMENTS.
- 5

SLOPE SLAB TO FLOOR DRAINS. REFER TO ARCH FOR LOCATIONS.
- 6

CENTER ALL PIER CAPS UNDER COLUMNS OR CENTERLINES OF MASONRY WALLS. REFER TO PLAN, SCHEDULE, AND PIER CAP DETAILS.
- 7

PRIOR TO CASTING INTERIOR THICKENED SLAB SOIL COMPACTION REPORT MUST BE APPROVED BY THE ENGINEER OF RECORD.
- 8

NOT ALL MECHANICAL OPENINGS AND/OR PENETRATIONS MAY BE INDICATED. REFER TO MECHANICAL DRAWINGS FOR ADDITIONAL INFORMATION.
- 9

THE BUILDING SHALL NOT BE LOCATED ON SITE OFF OF THE STRUCTURAL DOCUMENTS. REFER TO THE CIVIL SITE PLAN AND ARCHITECTURAL PLANS FOR BUILDING LOCATION INFORMATION.
- 10

PROVIDE (2) #4x4'-0" RE-ENTRANT CORNER BARS, TYPICAL.
- 11

PLAN REFERENCE ELEVATION OF 100'-0" = USGS ELEVATION OF 1310.5'.
- 12

AT ALL OVERHEAD DOORS, STEEL FRAMES, AND MAN DOORS, PROVIDE HORIZONTAL DOWELS BETWEEN INTERIOR AND EXTERIOR SLAB. DOWELS ARE TO BE #4 BARS @ 12" O.C. AT MID DEPTH OF SLAB.
- 13

CONCRETE COLUMN PEDESTALS ARE PER PLAN AND CONCRETE PEDESTAL SCHEDULE. CONCRETE PEDESTALS ARE CENTERED ON GRIDS OR ALIGNED WITH STEM WALL EDGES, U.N.O.

hdesigngroup  
architecture + design

5039 S National Avenue | Springfield, MO 65810 | 417.887.6595

OWNER

**CITY OF WENTZVILLE, MISSOURI**  
1001 SCHROEDER CREEK BLVD  
WENTZVILLE, MO 63385  
636.327.5101

PROJECT TEAM

CIVIL ENGINEER  
PREMIER DESIGN GROUP  
100 MIDLAND PARK DRIVE  
WENTZVILLE, MO 63385  
314.925.7444

MAINTENANCE CONSULTANT  
HDR ENGINEERING, INC.  
10450 HOLMES RD., STE 600  
SPRINGFIELD, MO 65810  
816.360.2700

STRUCTURAL ENGINEER  
METTEMMEYER ENGINEERING  
2225 W CHESTERFIELD BLVD., SUITE 300  
SPRINGFIELD, MO 65807  
417.890.8002

MEP ENGINEER  
HENDERSON ENGINEERING, INC.  
8345 LENEXA DR., #300  
LENEXA, KS 66214  
417.555.5555

REVISIONS		
NO.	DESCRIPTION	DATE
02	ADD 02	01/25/23

PROJECT NO.: 20-0067 DRAWN BY: MRH, TNB  
DATE: 12.15.22 REVIEWED BY: BSW

PROFESSIONAL SEAL

ALAN METTEMMEYER, PE  
PROFESSIONAL TITLE: ENGINEER  
MOW E-2000162147

PROJECT TITLE

**CITY OF WENTZVILLE, MO PUBLIC WORKS FACILITY**


PROJECT ADDRESS

















1296 INTERSTATE DRIVE  
WENTZVILLE, MO 63385



**FOUNDATION PLAN - AREA B**  
Scale: 1/8" = 1'-0"



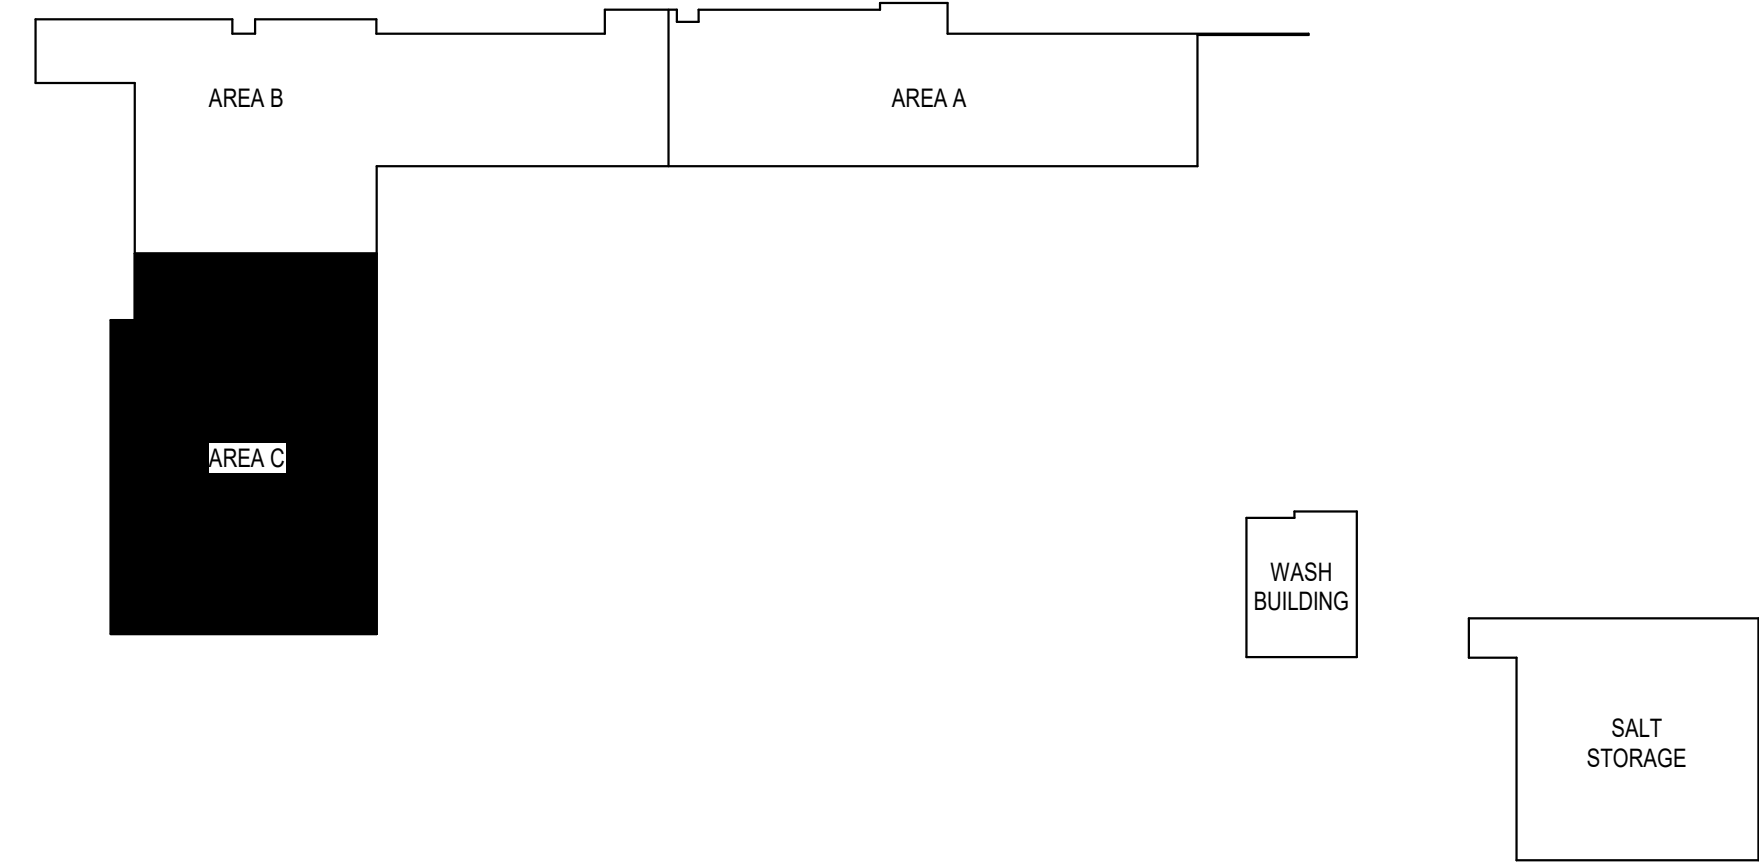


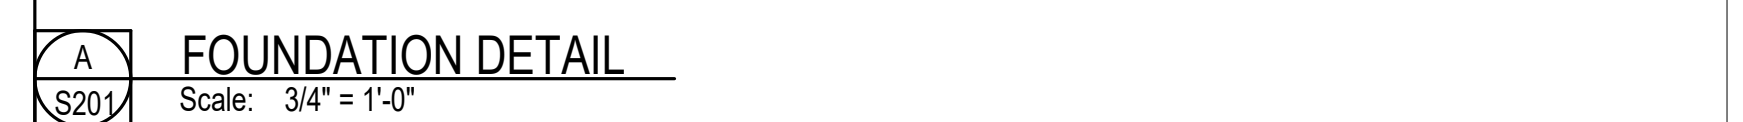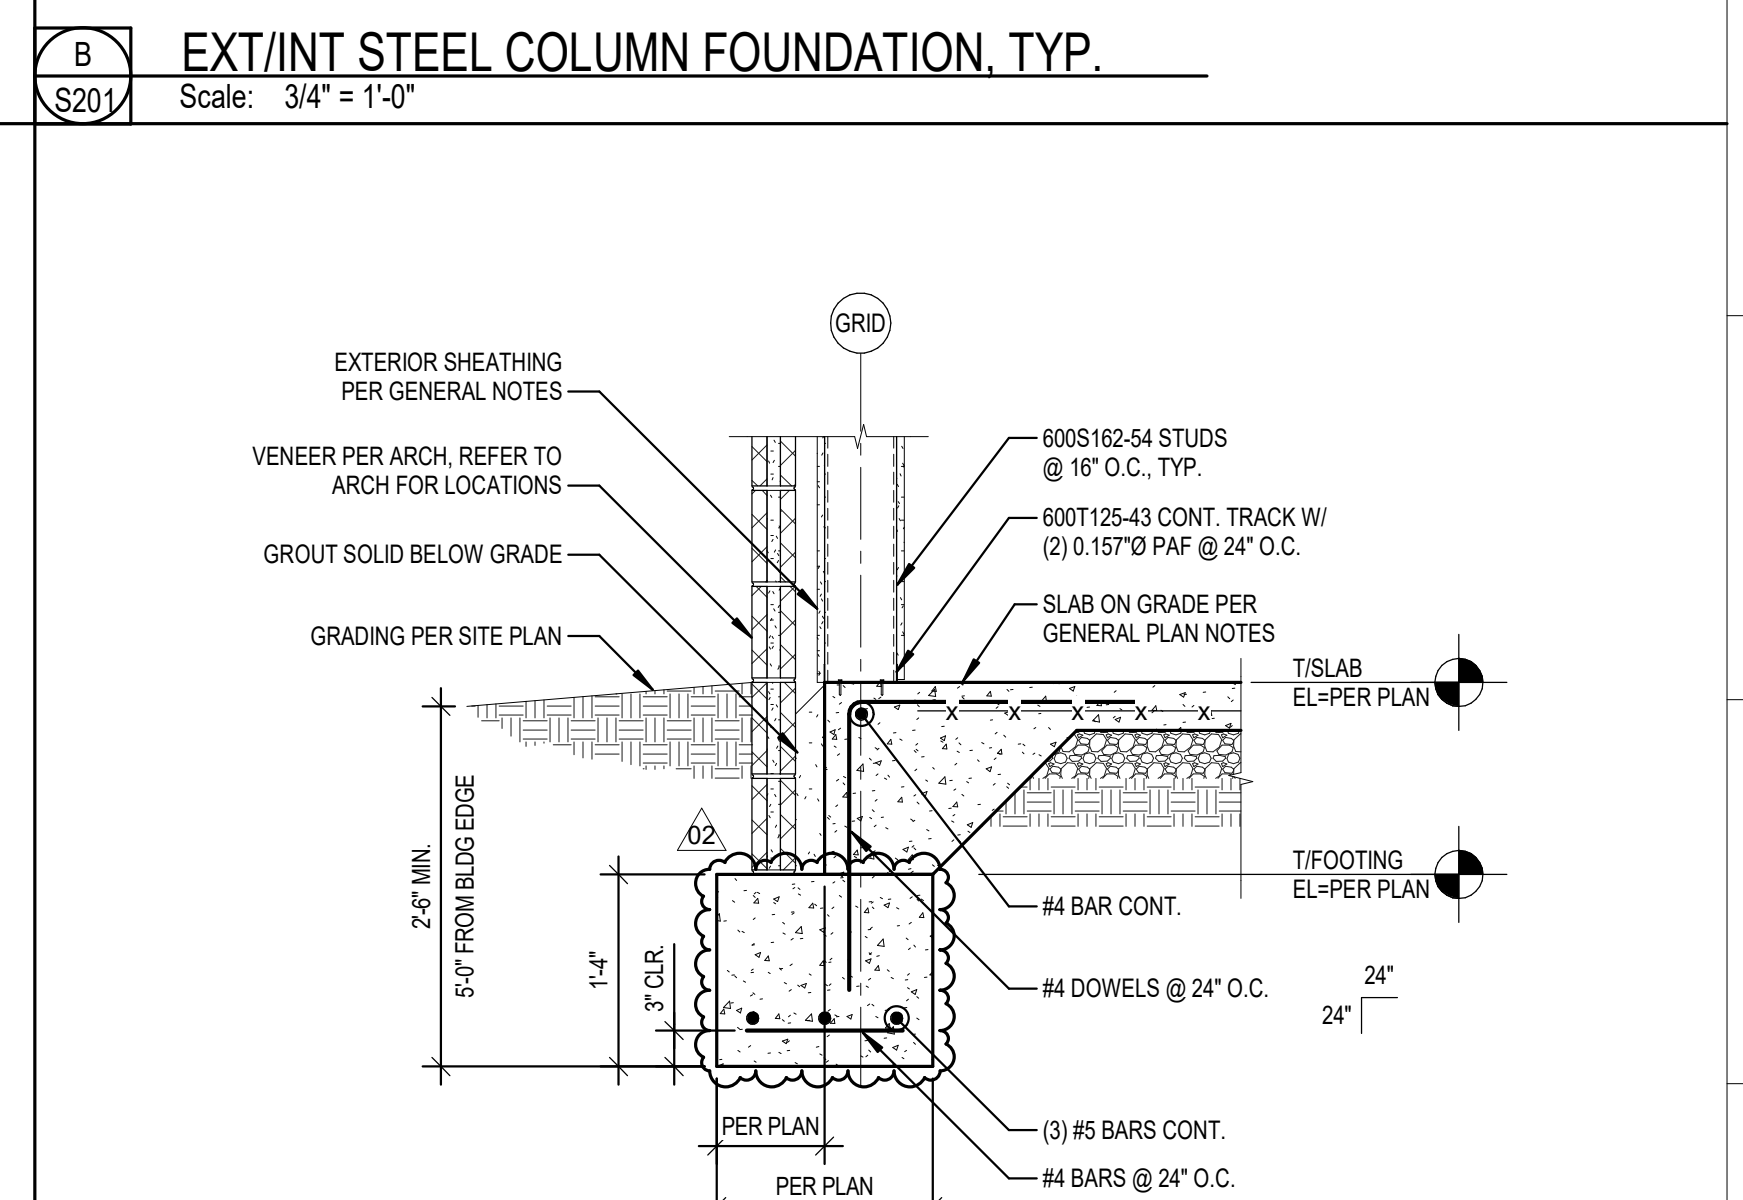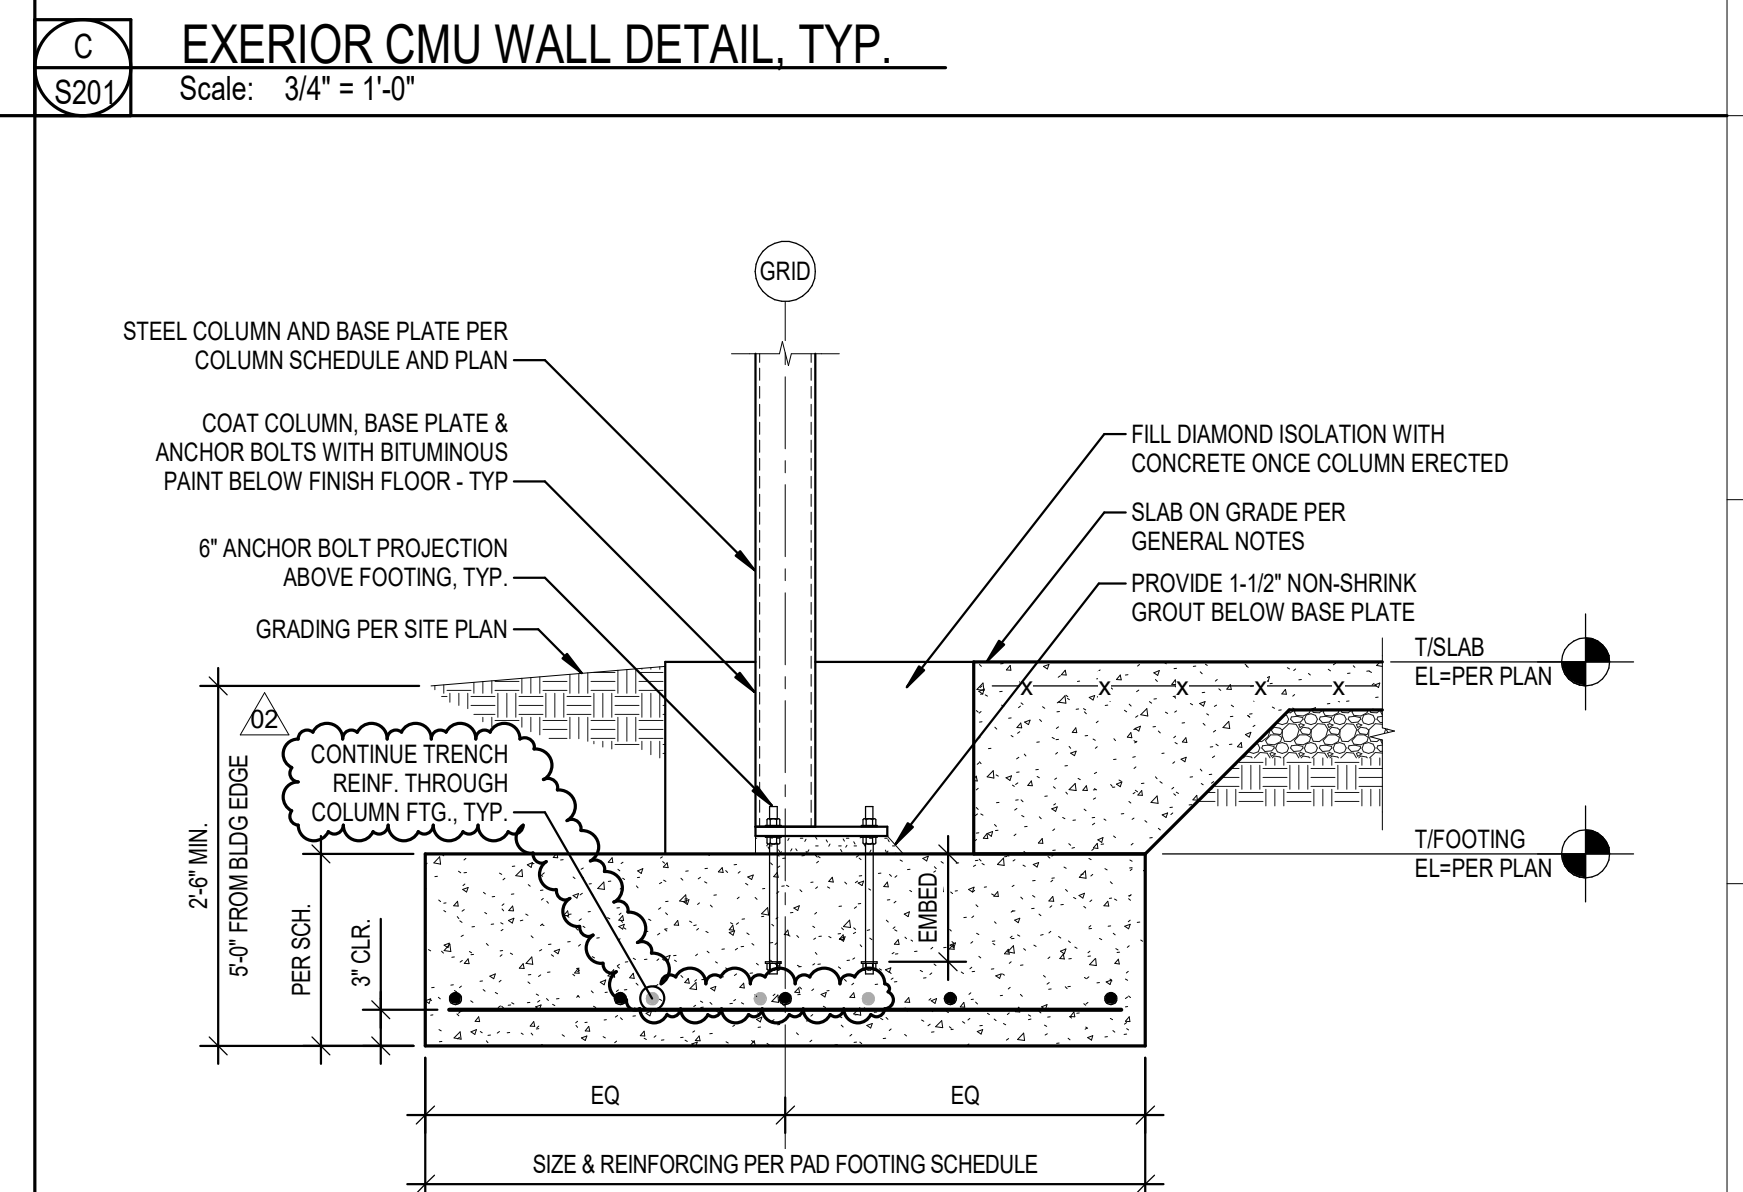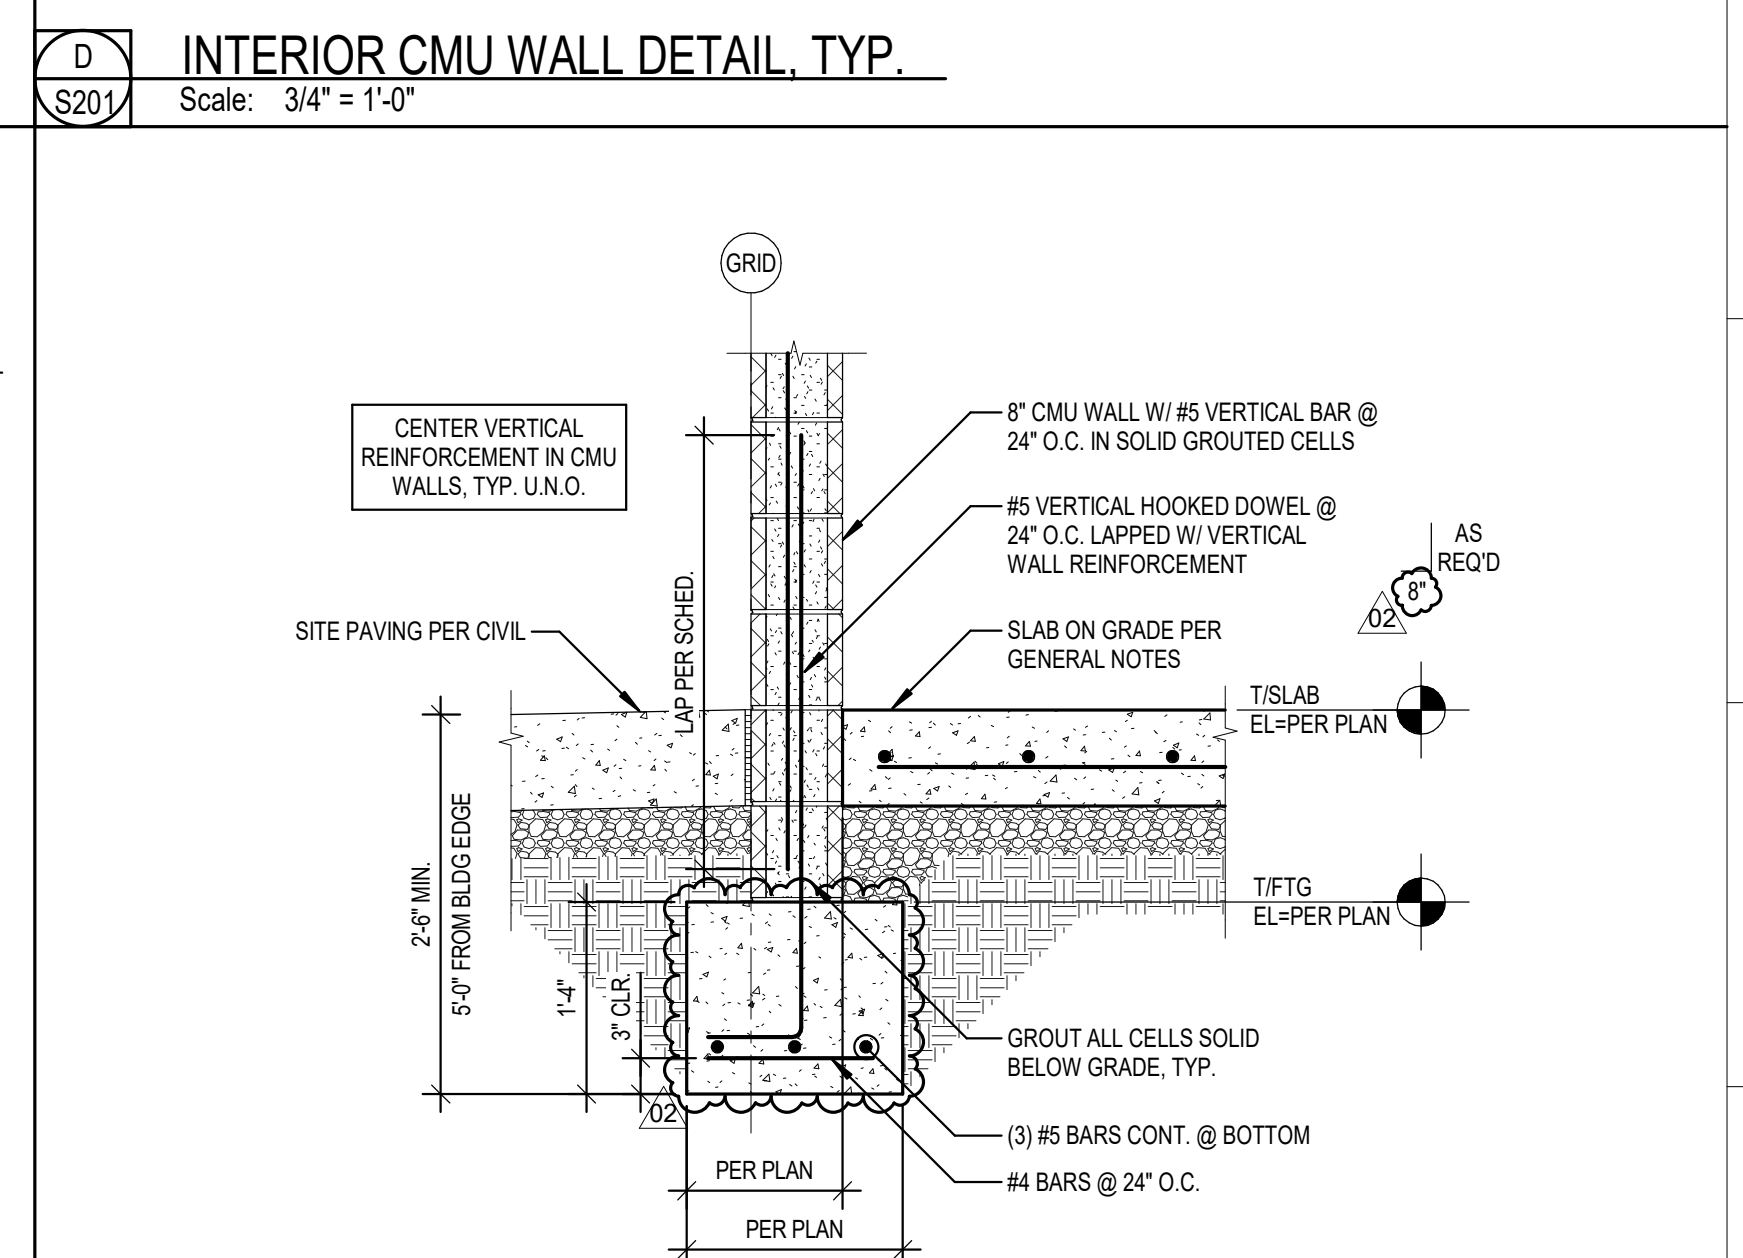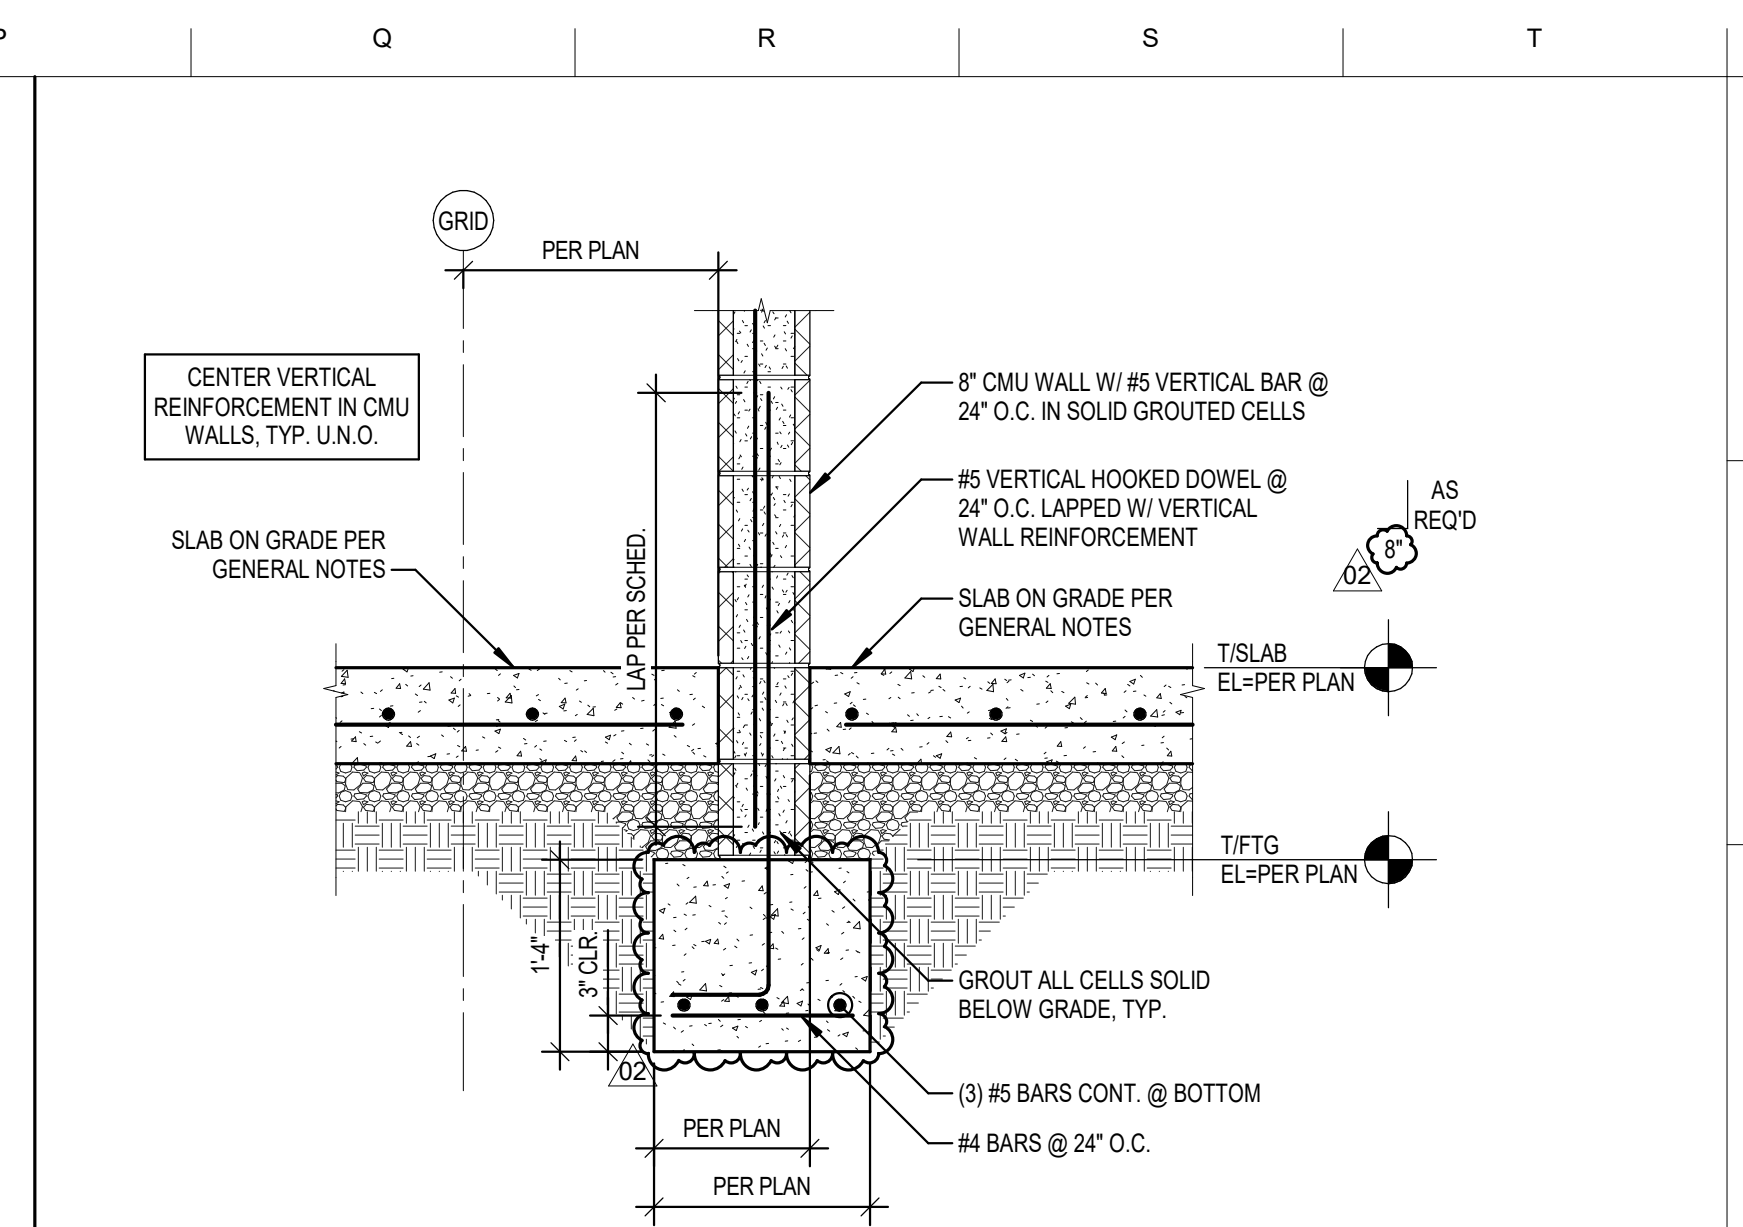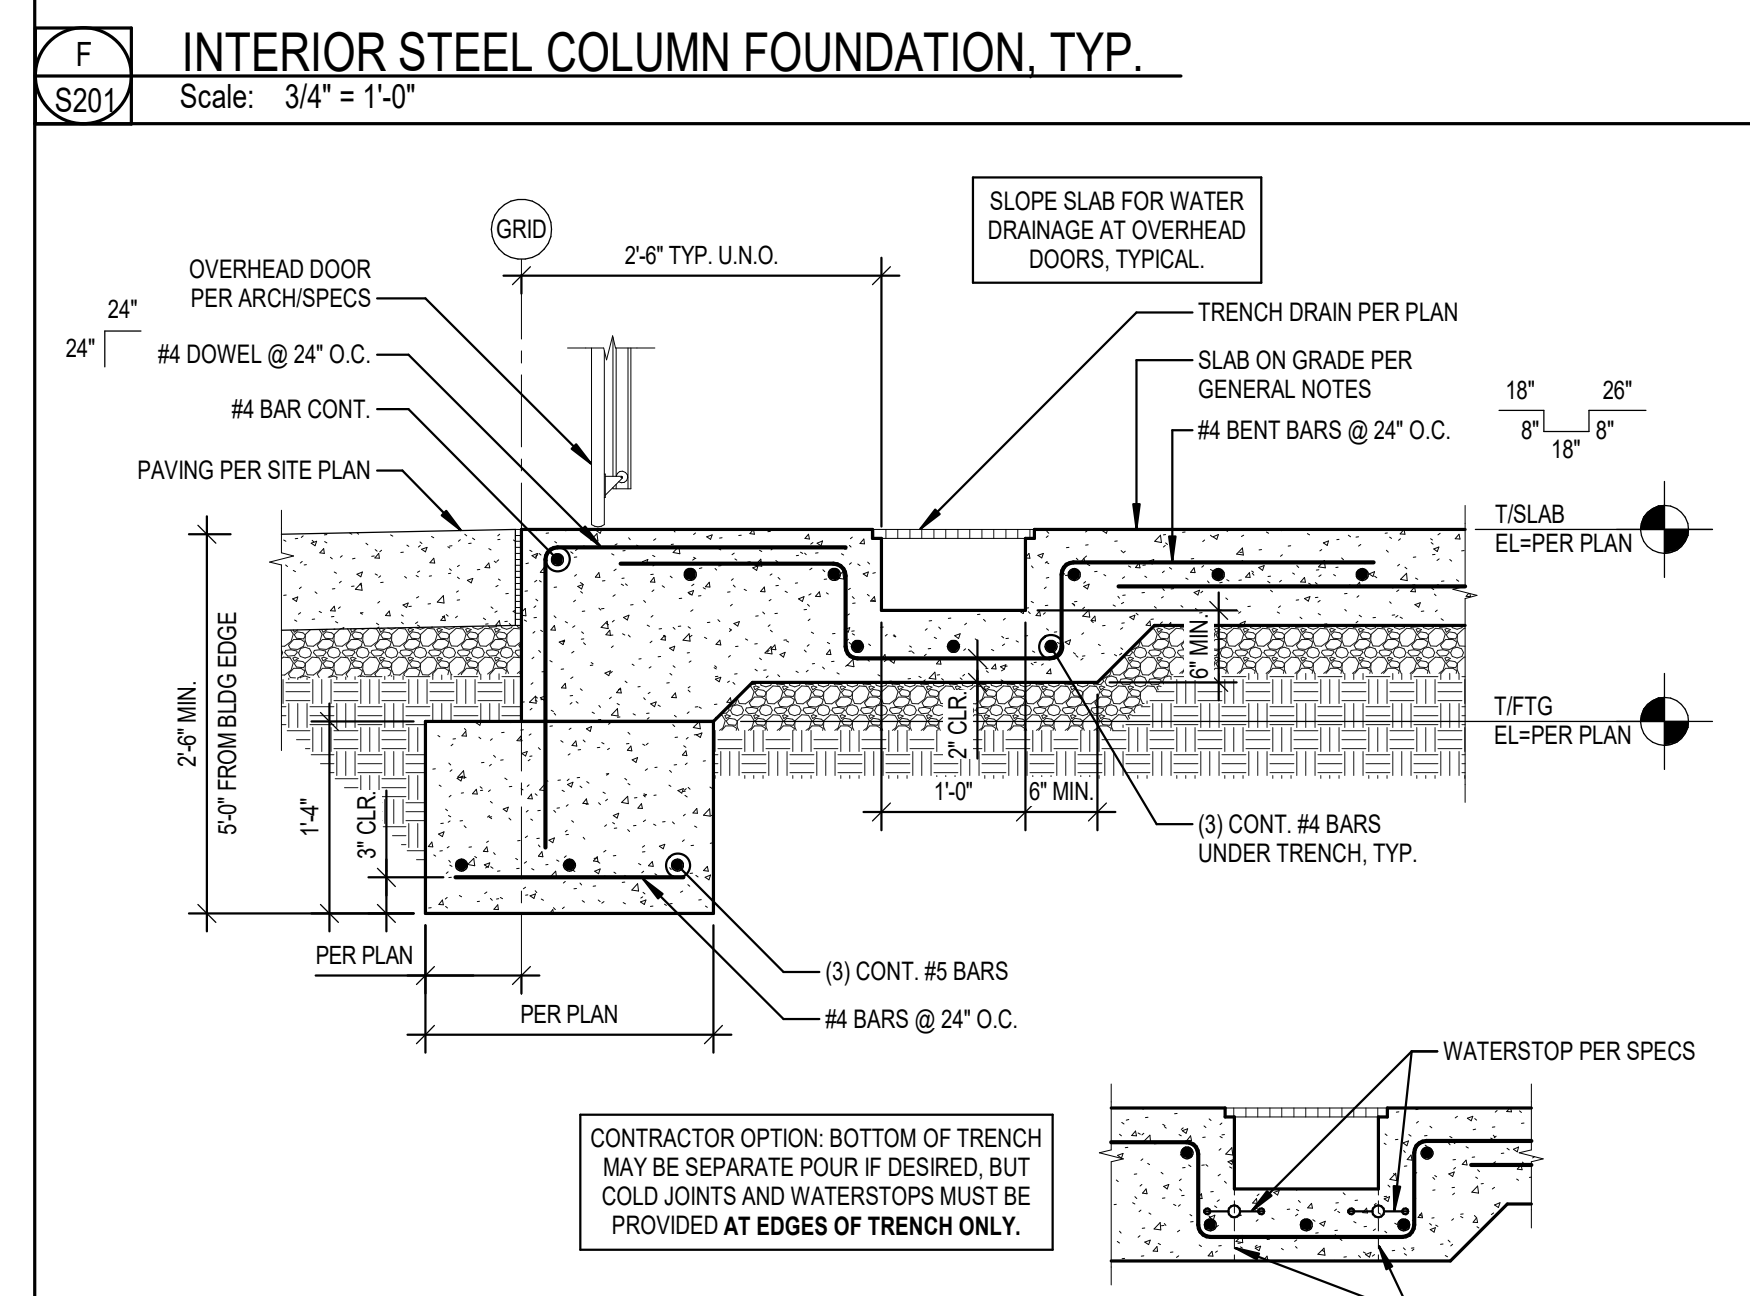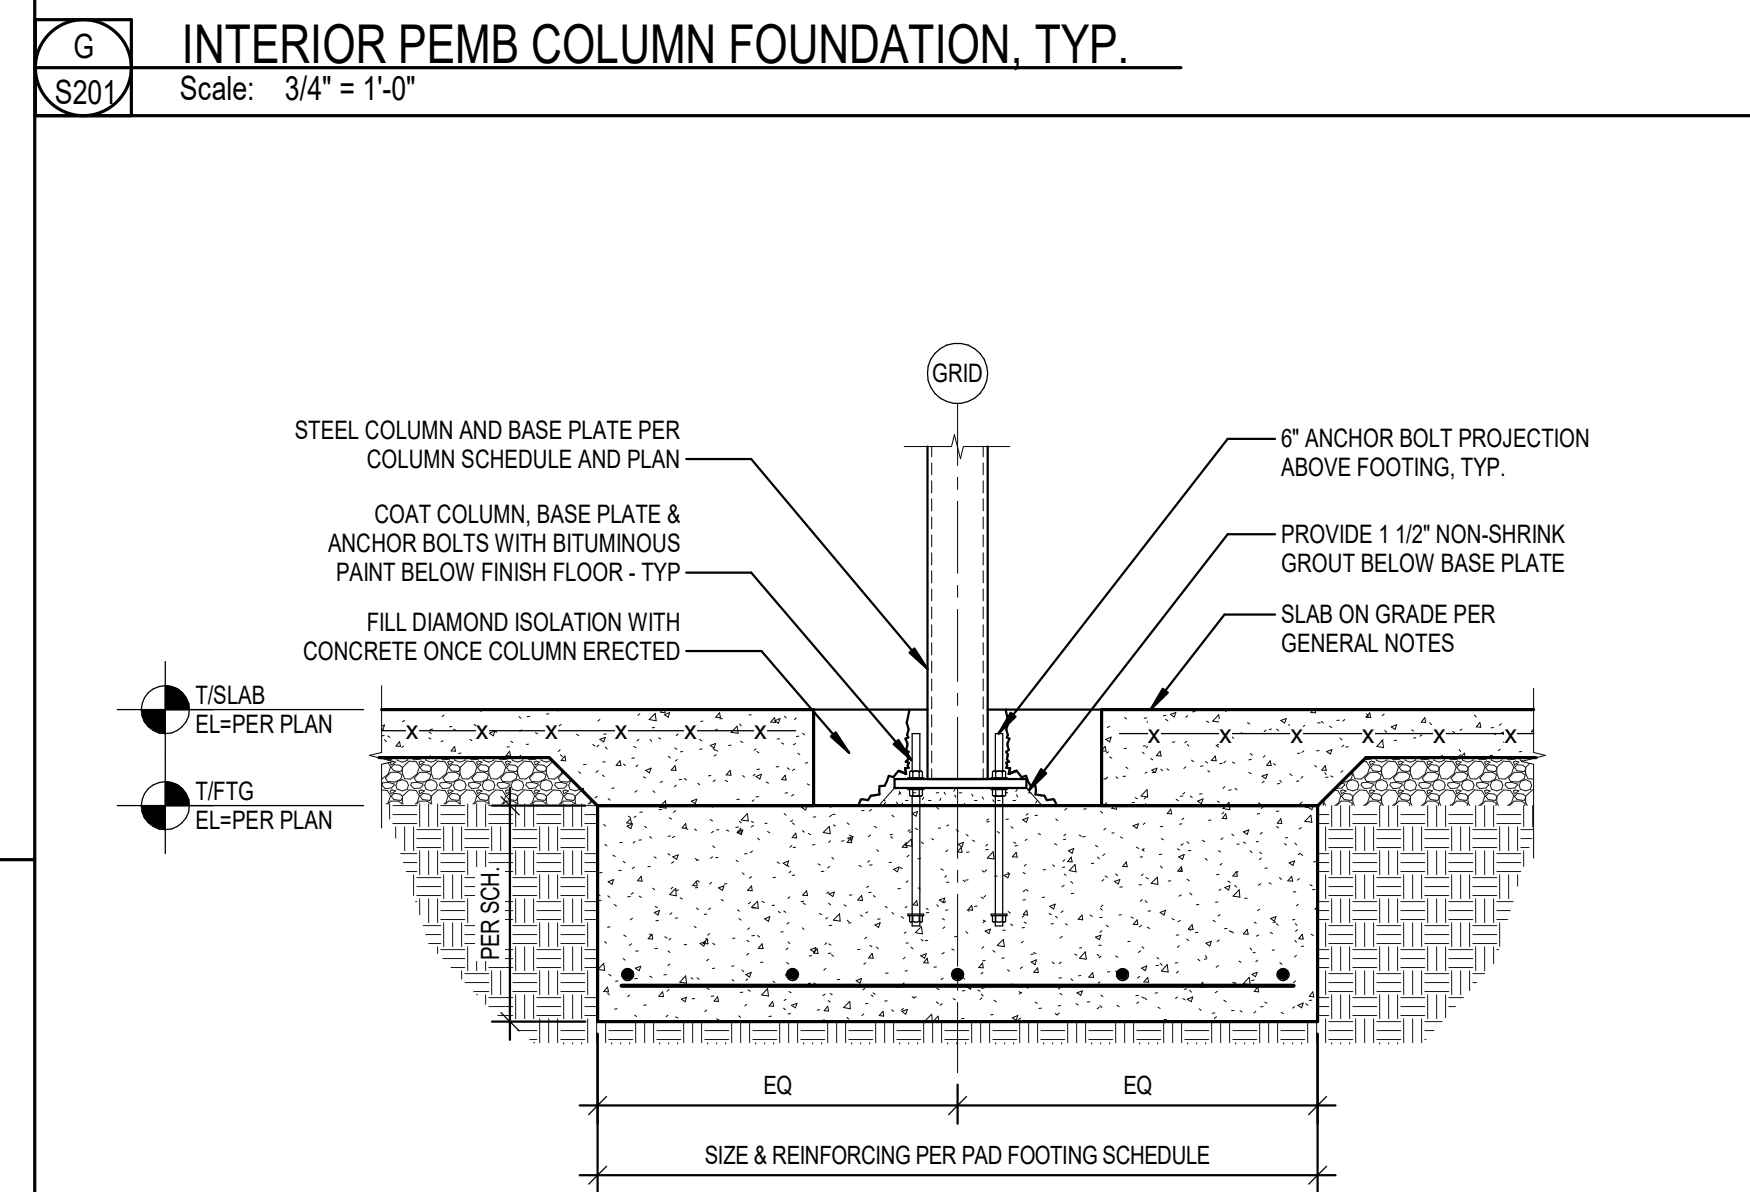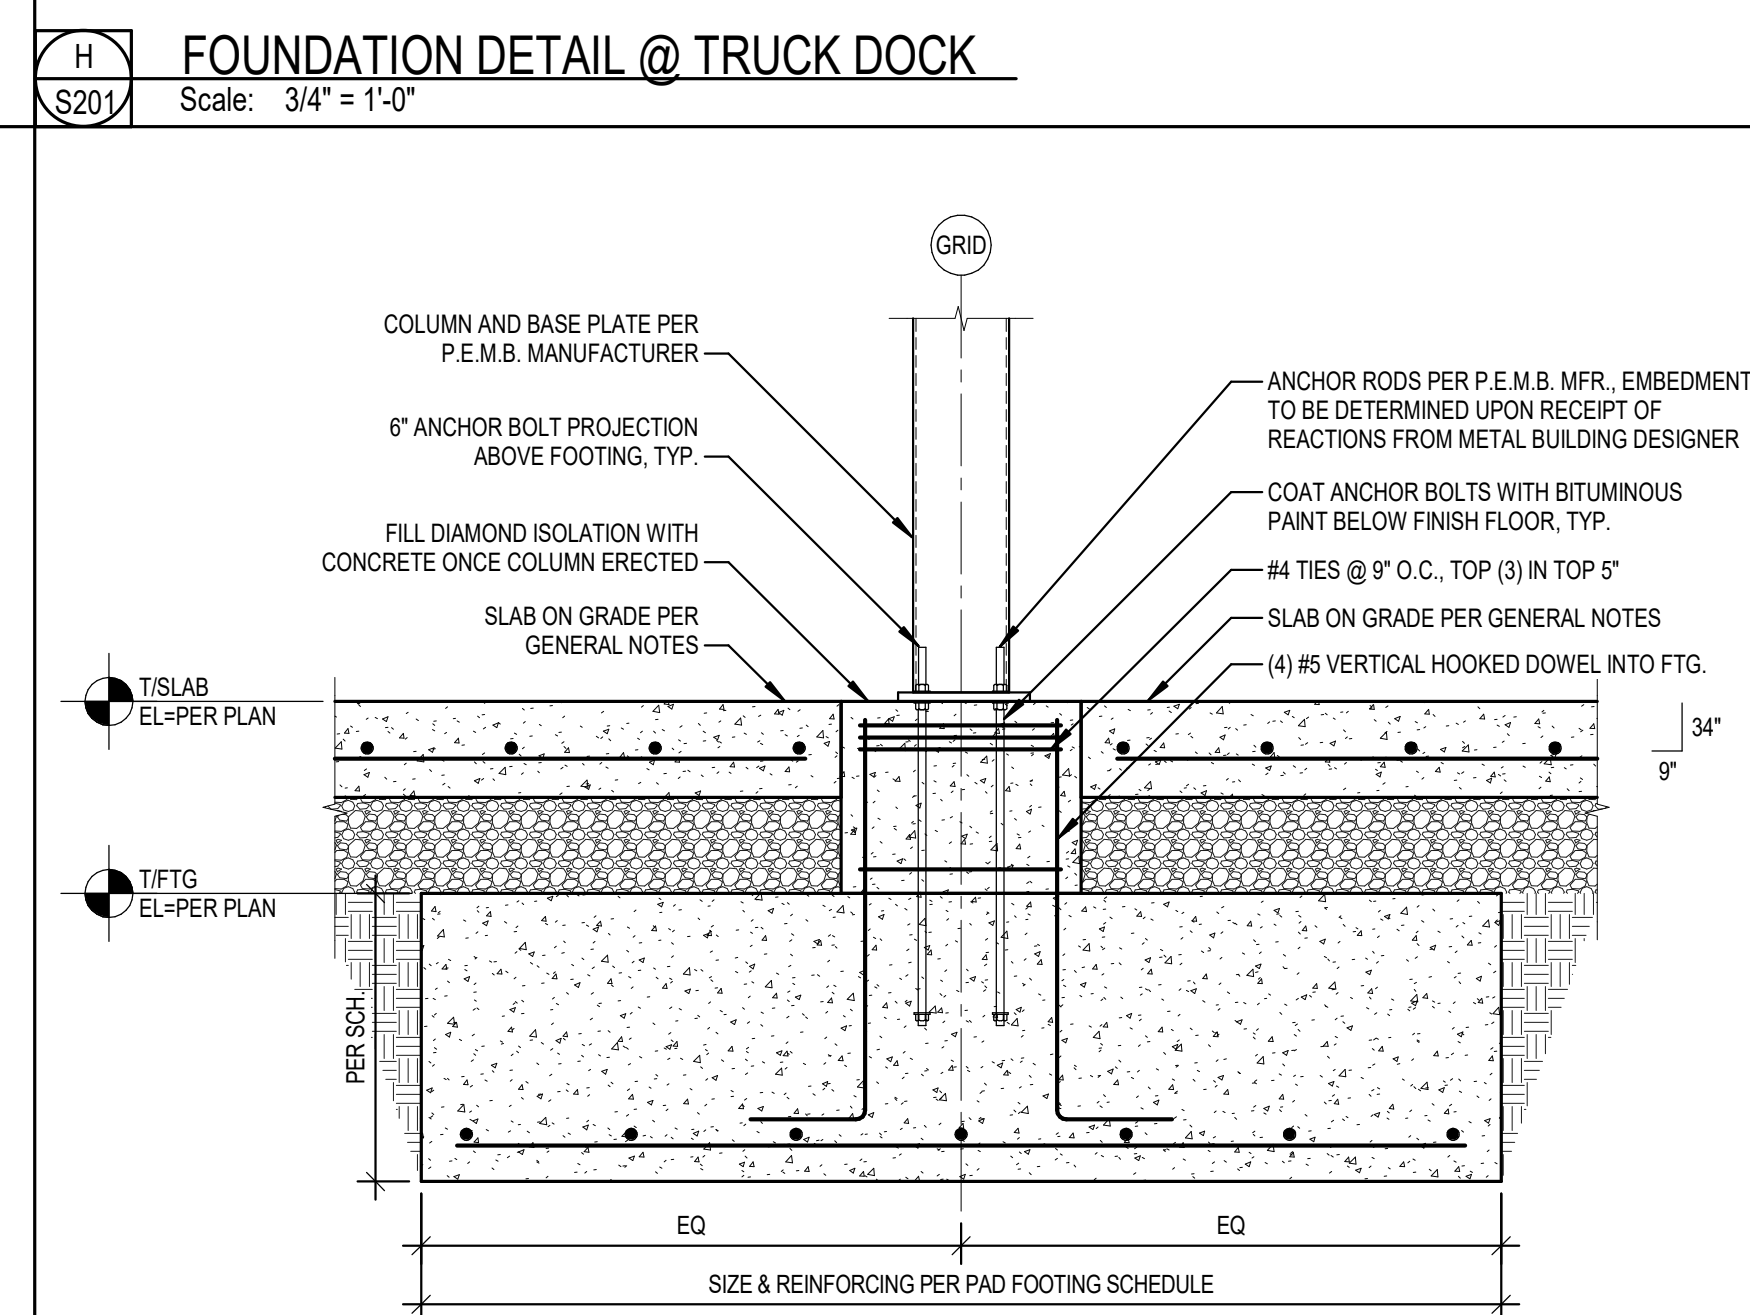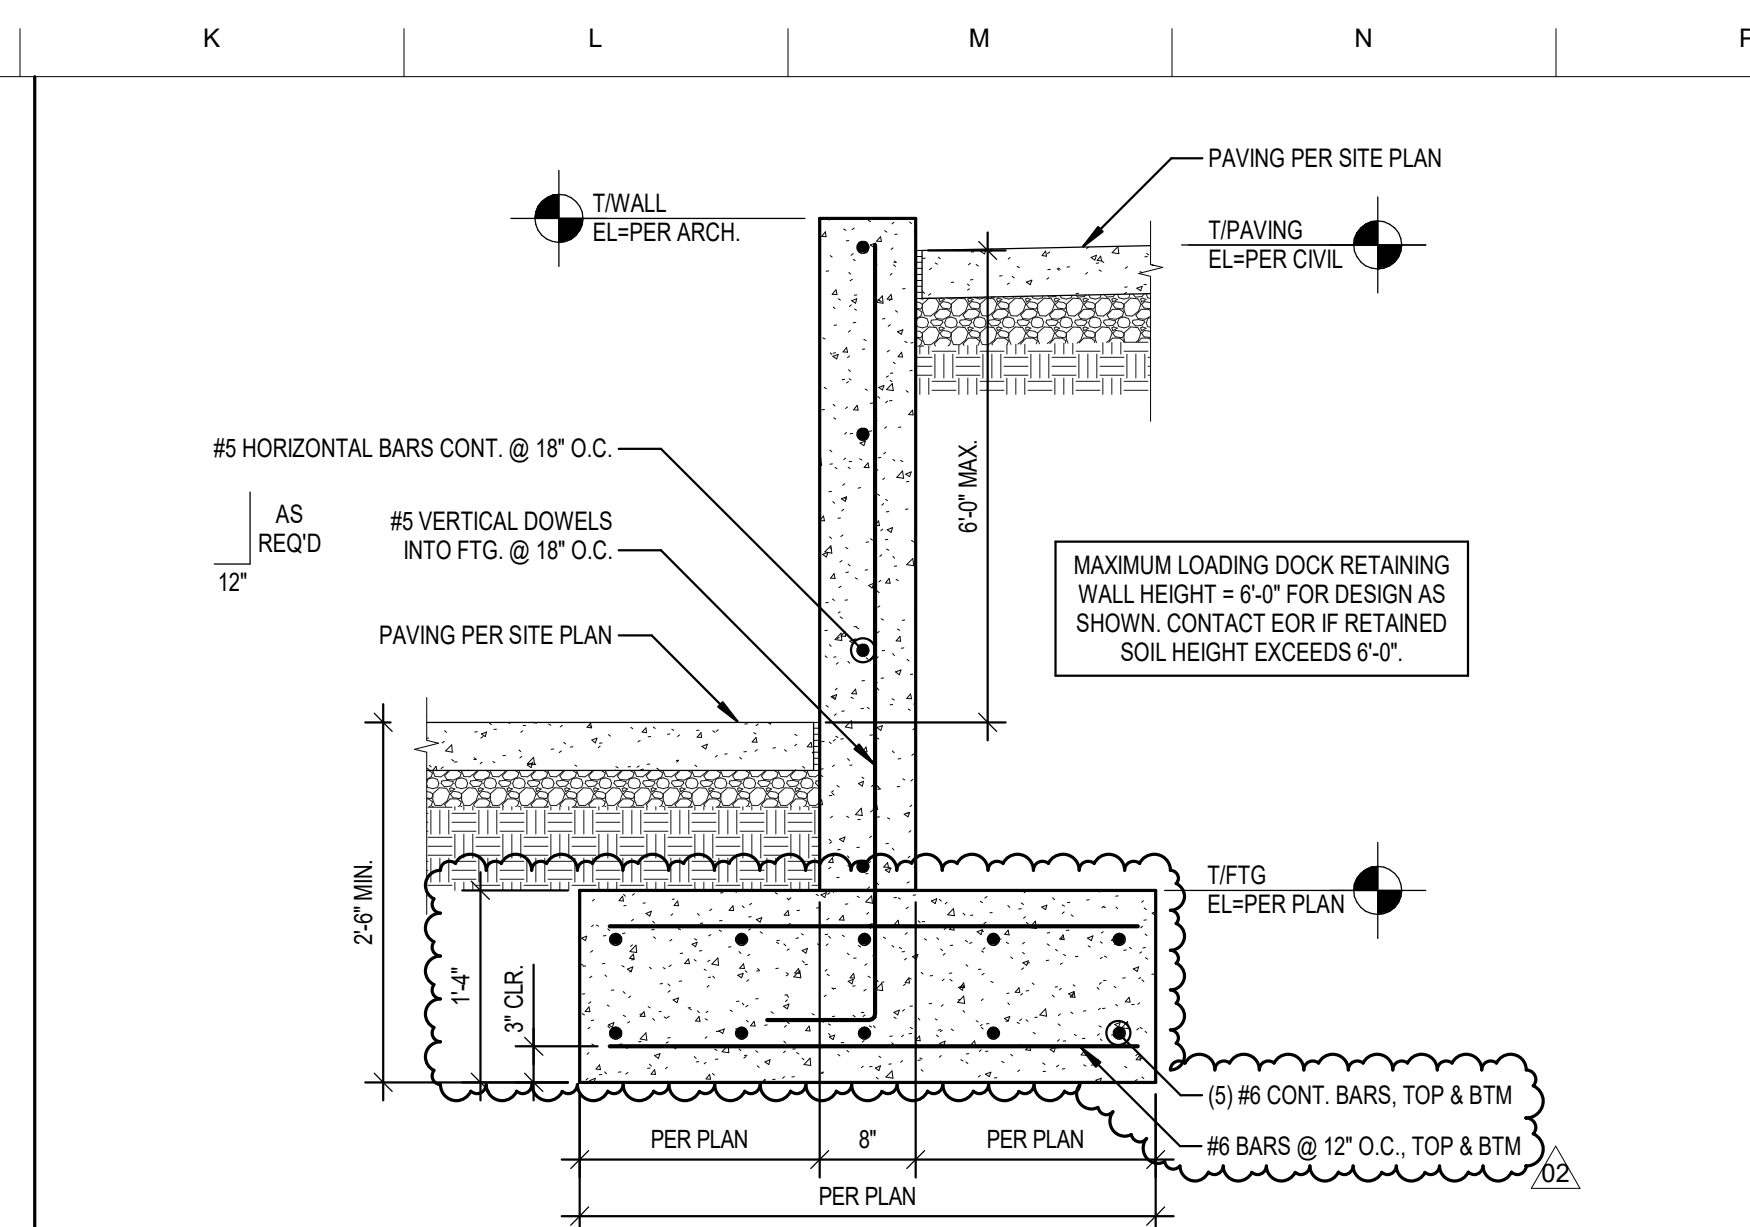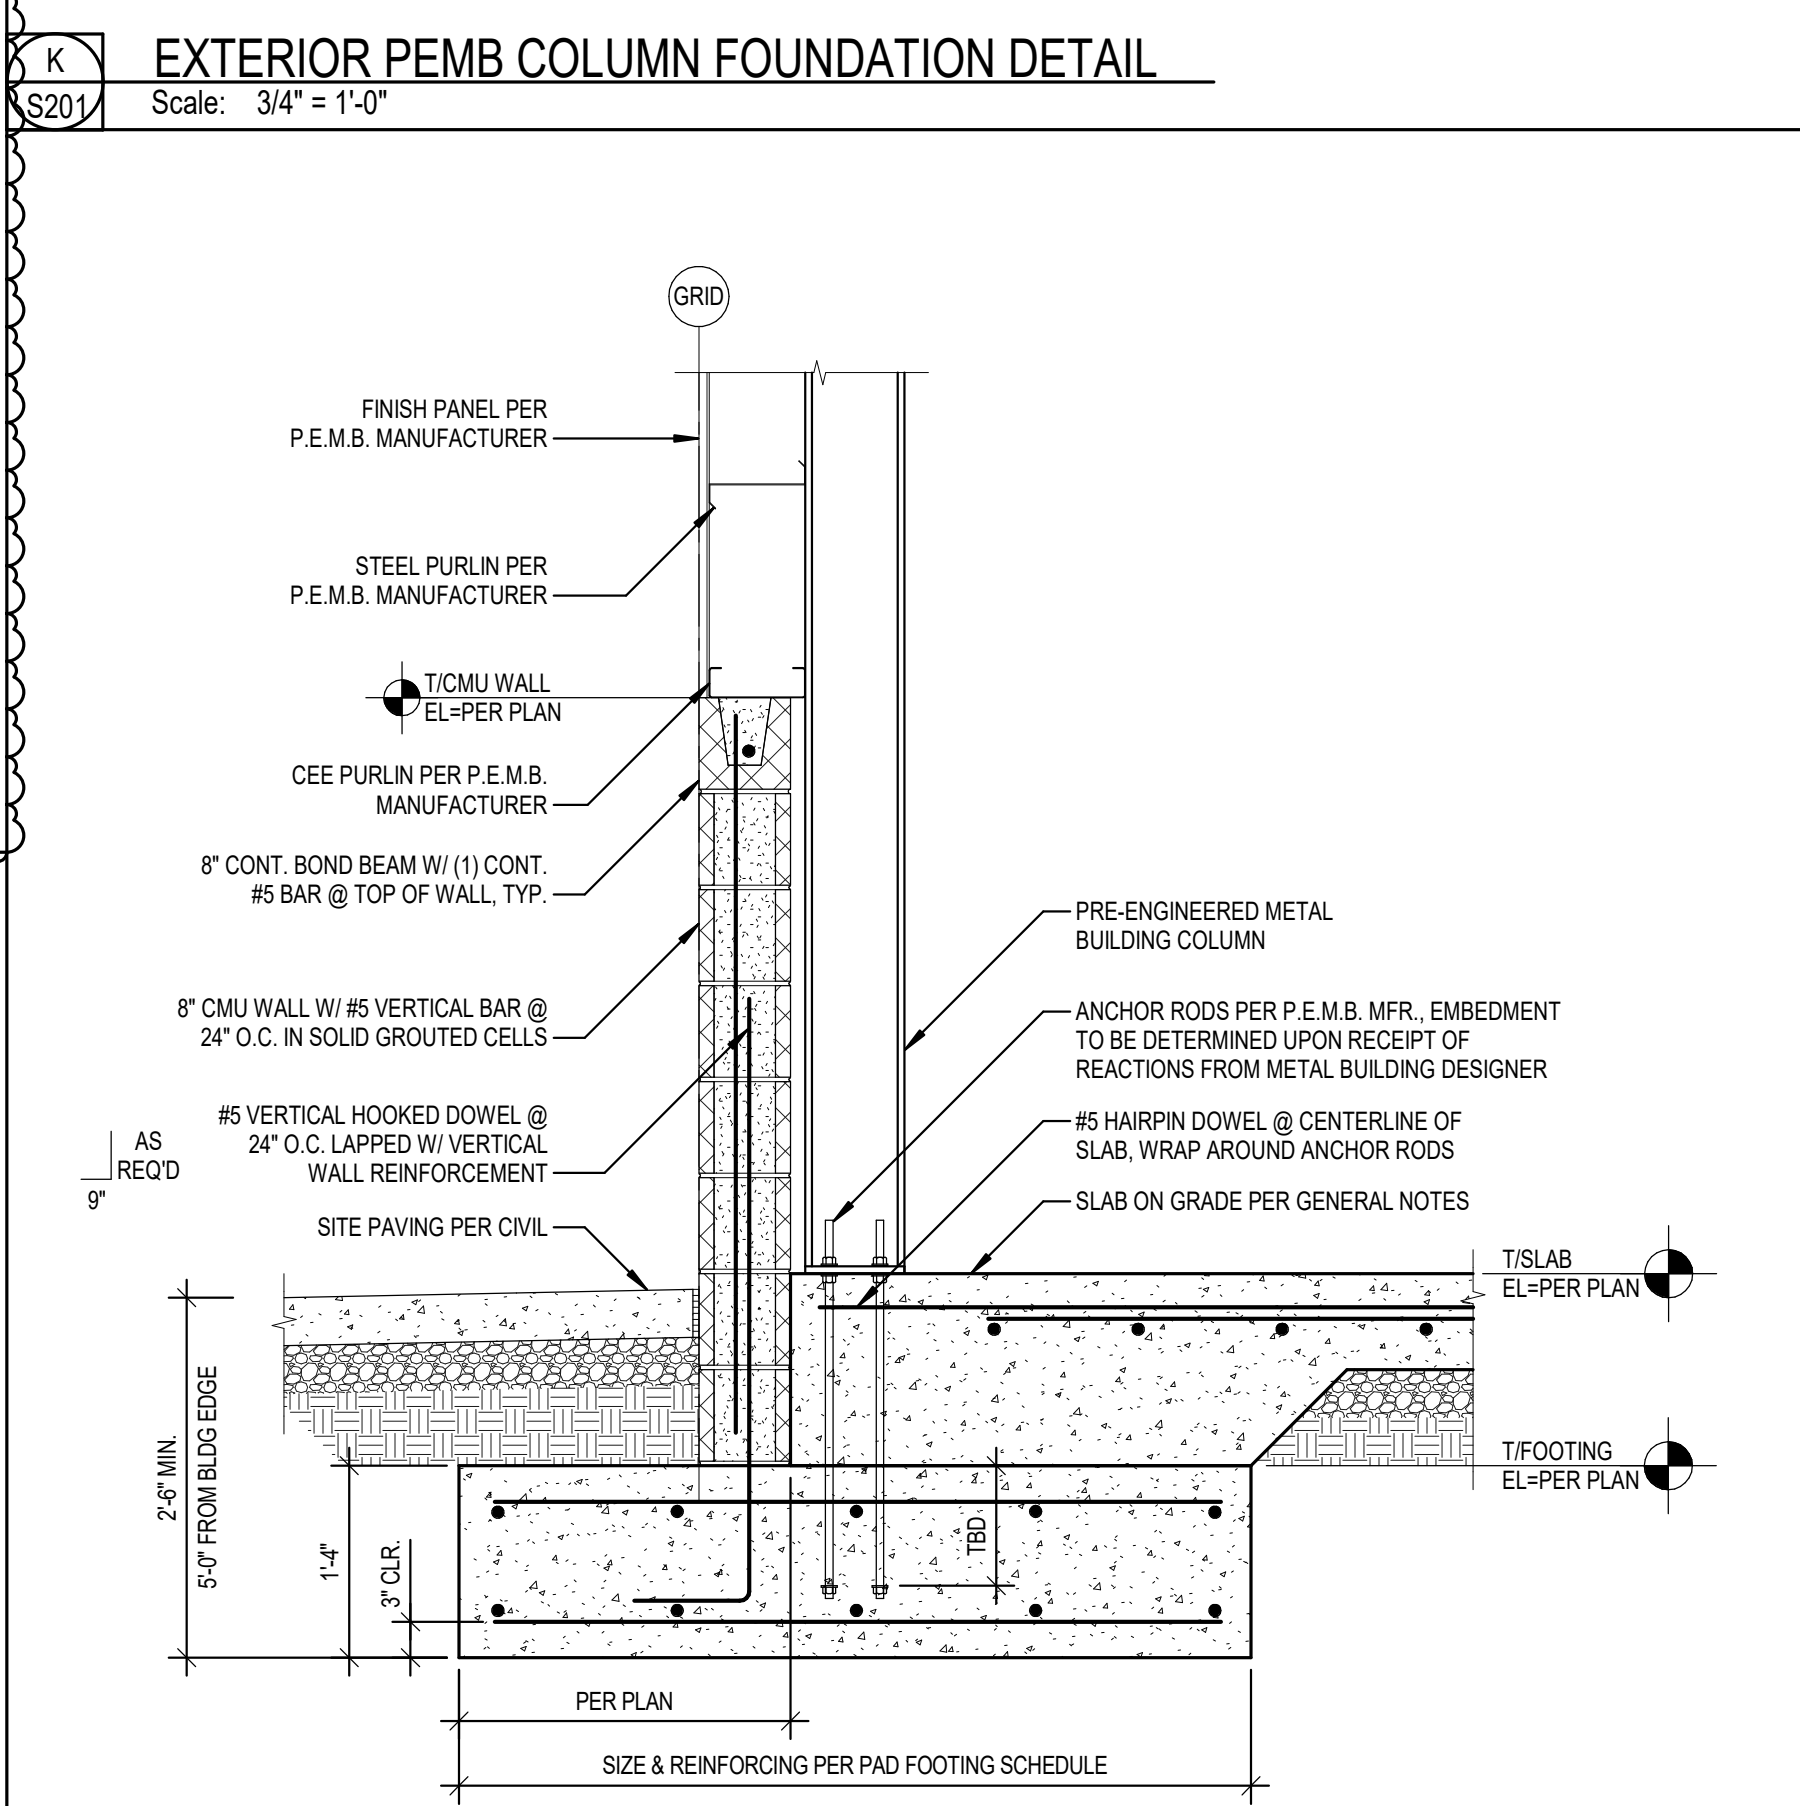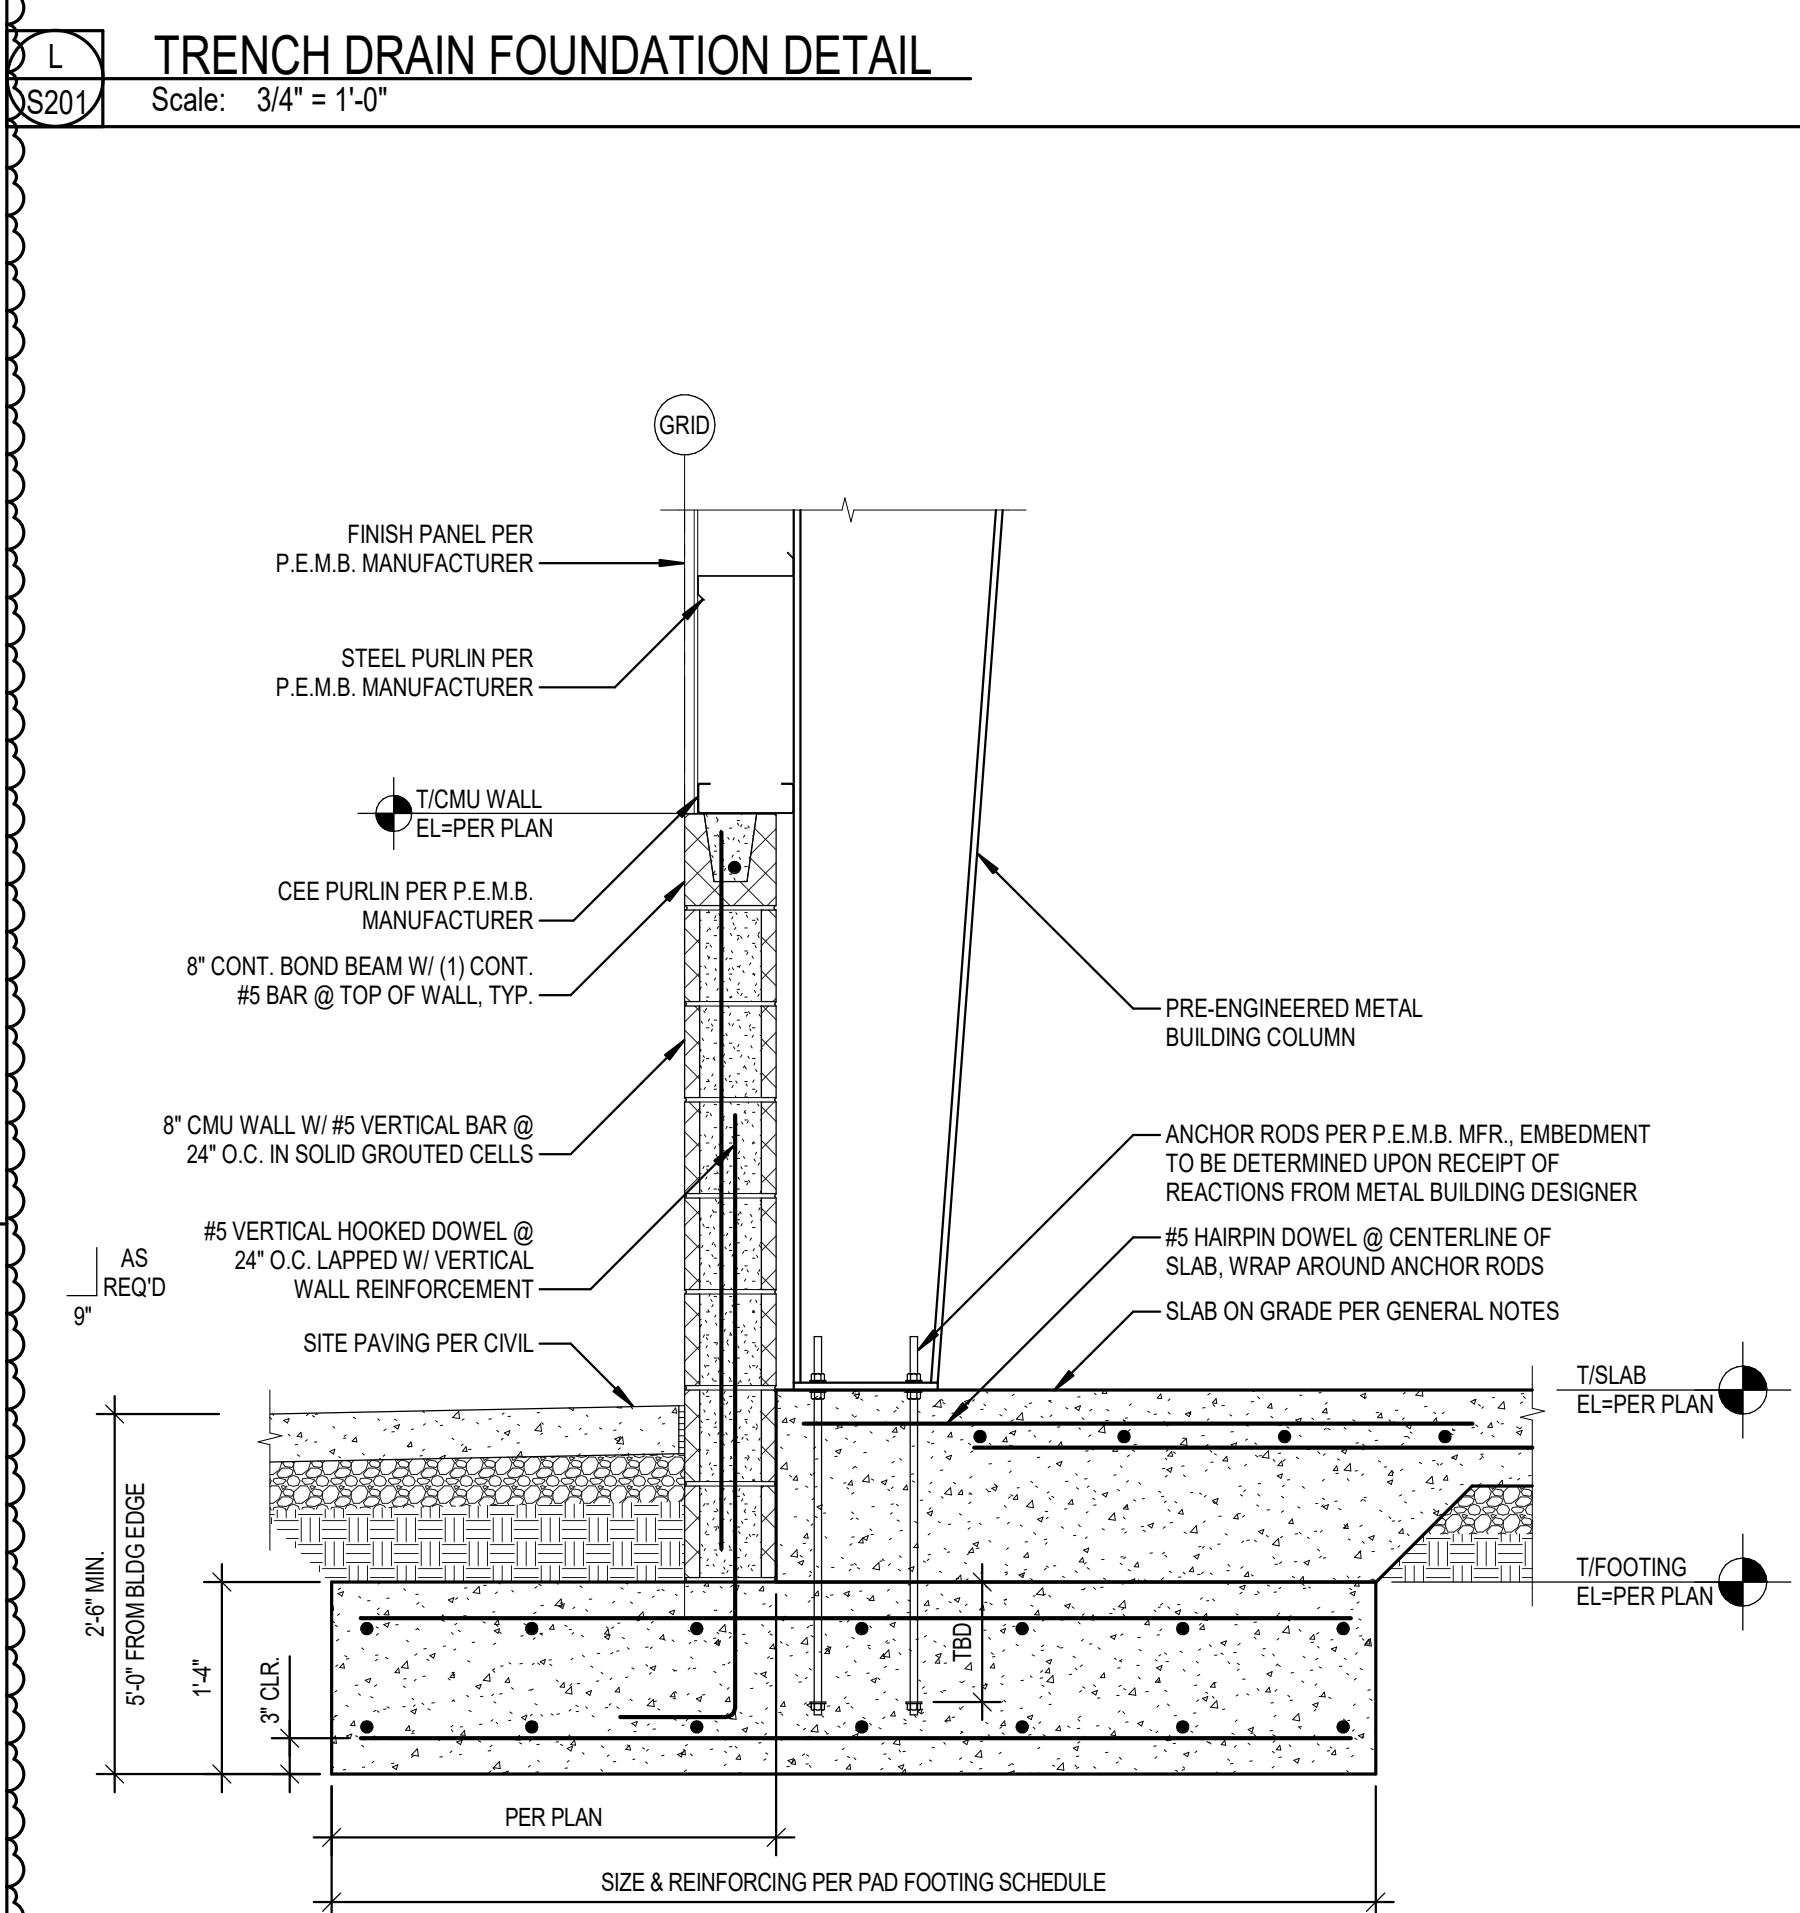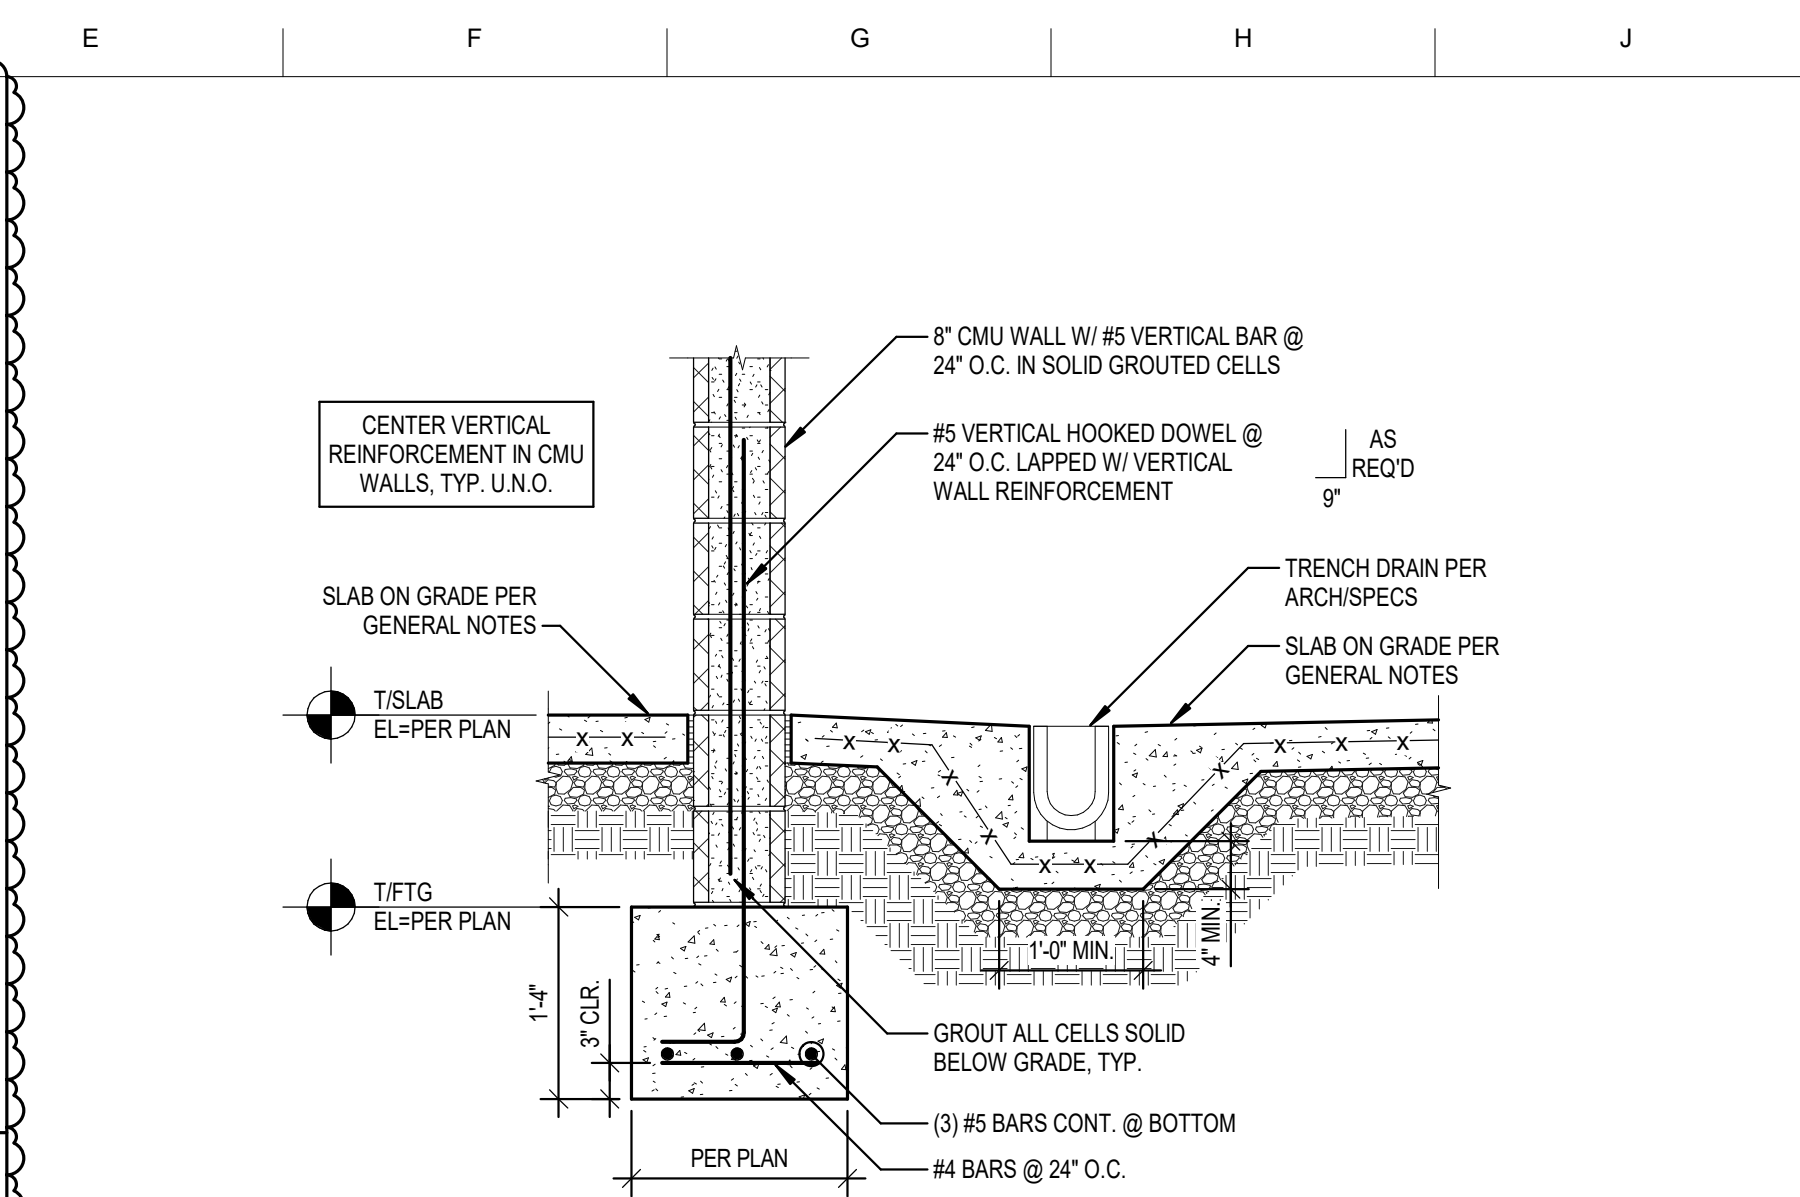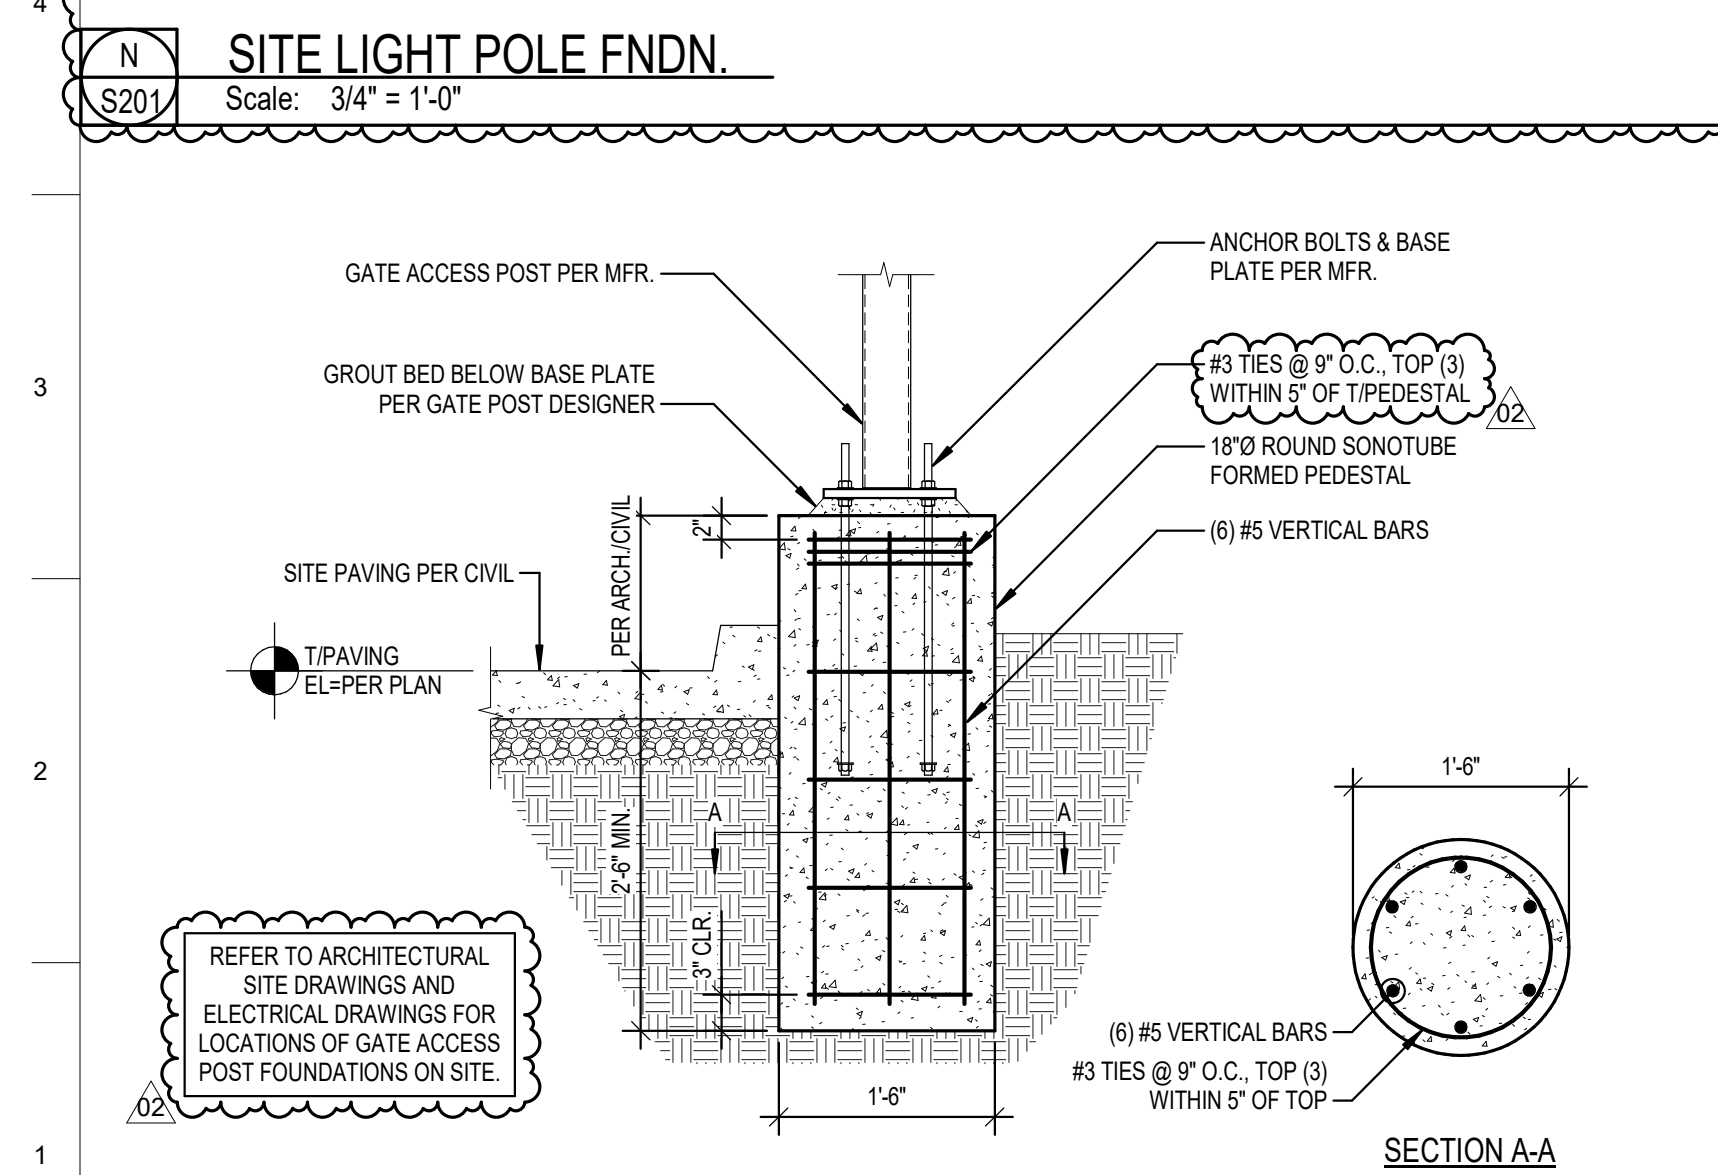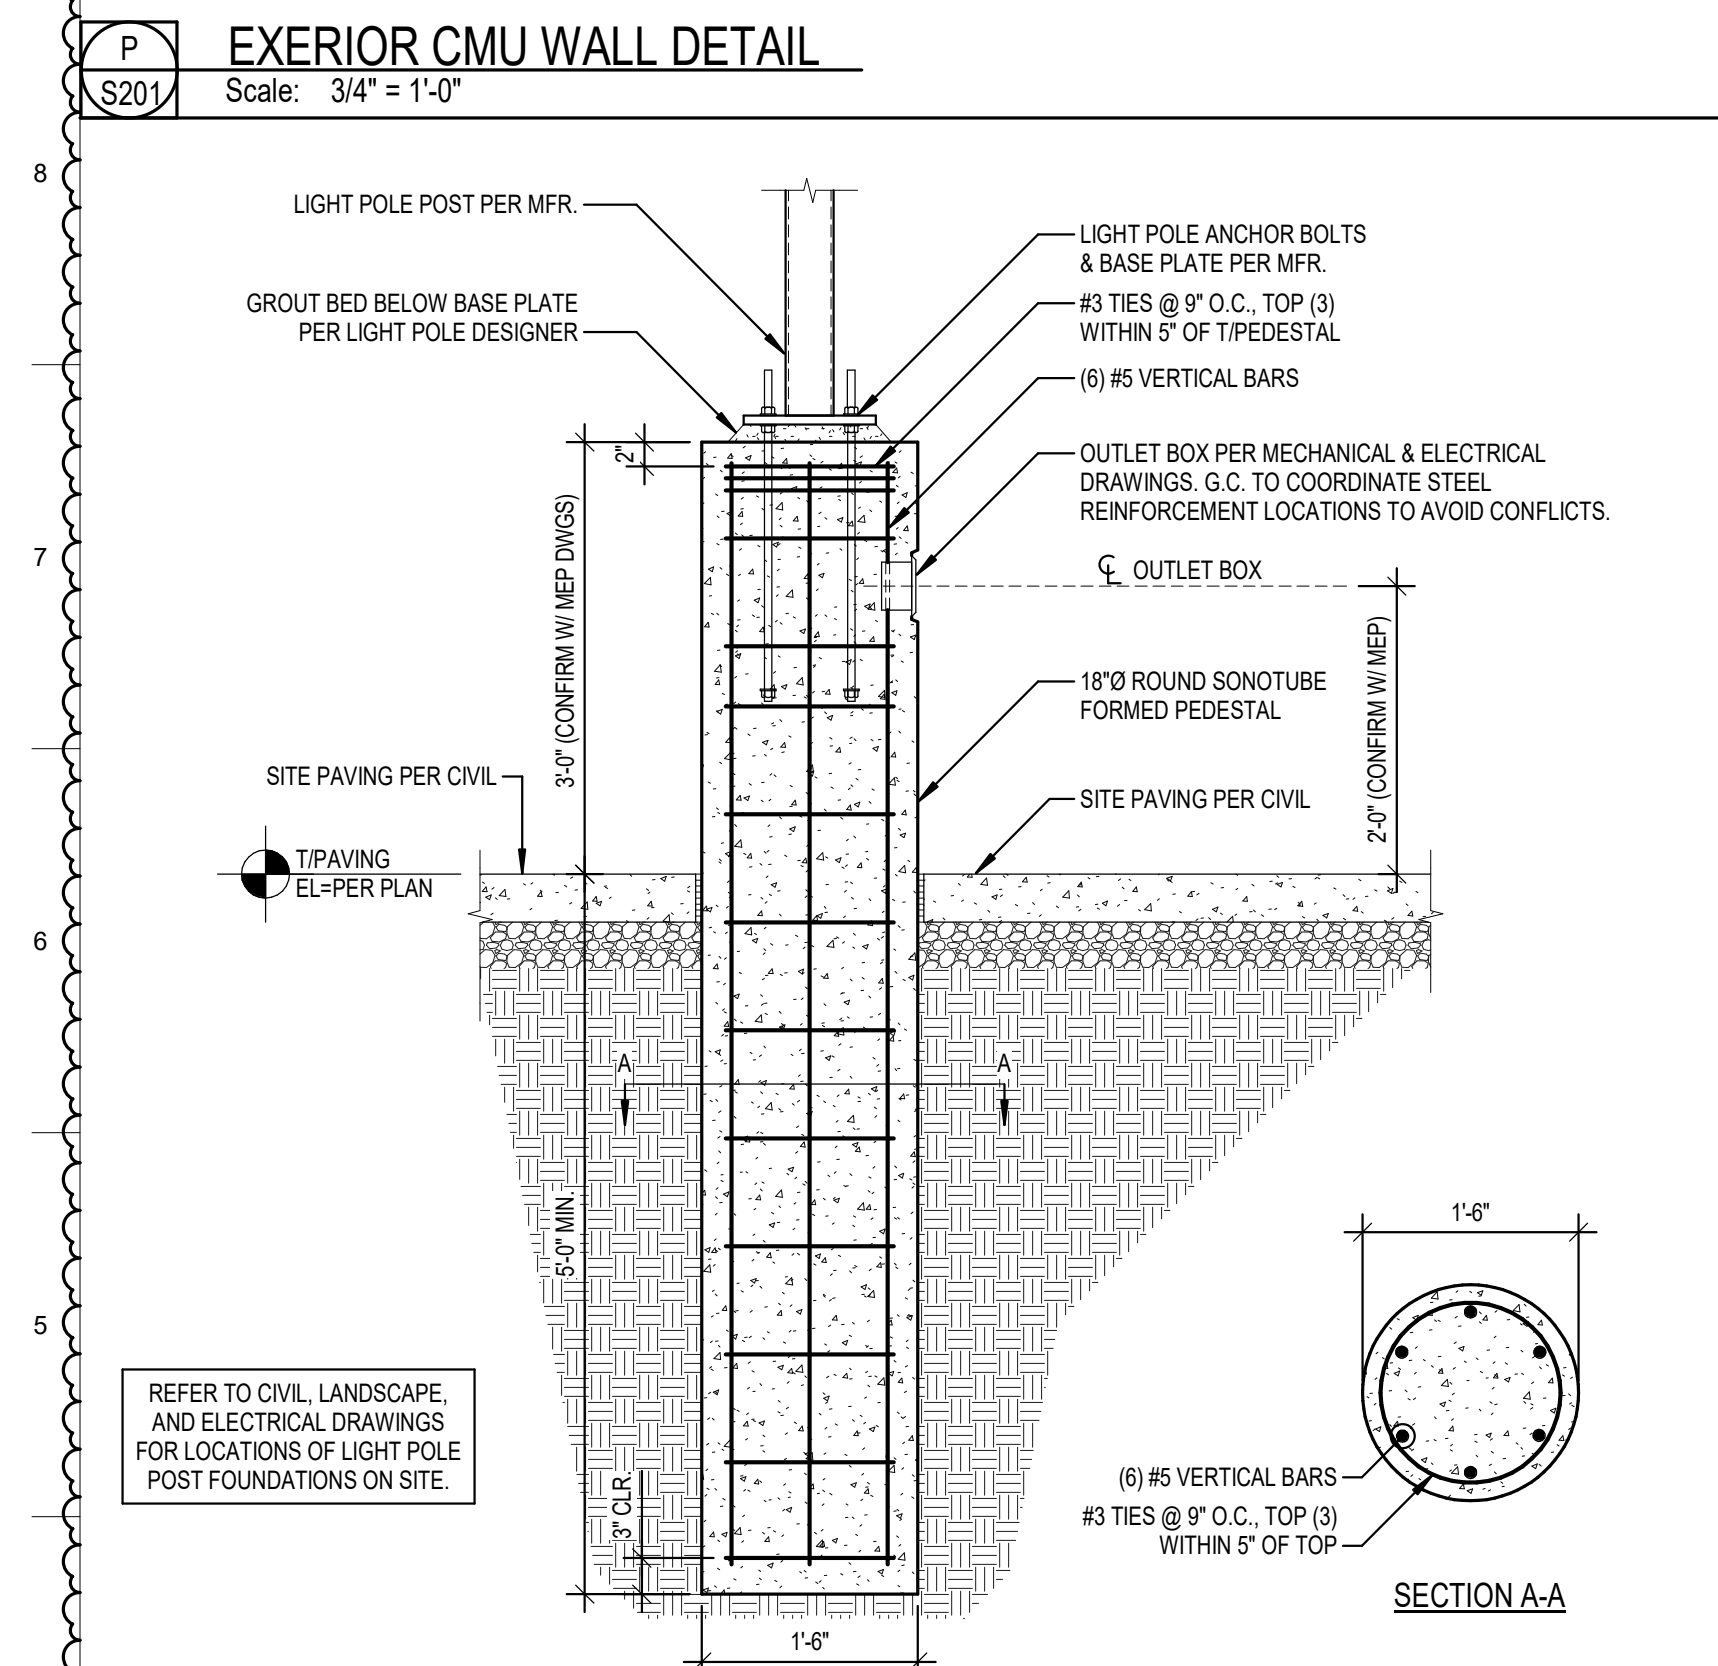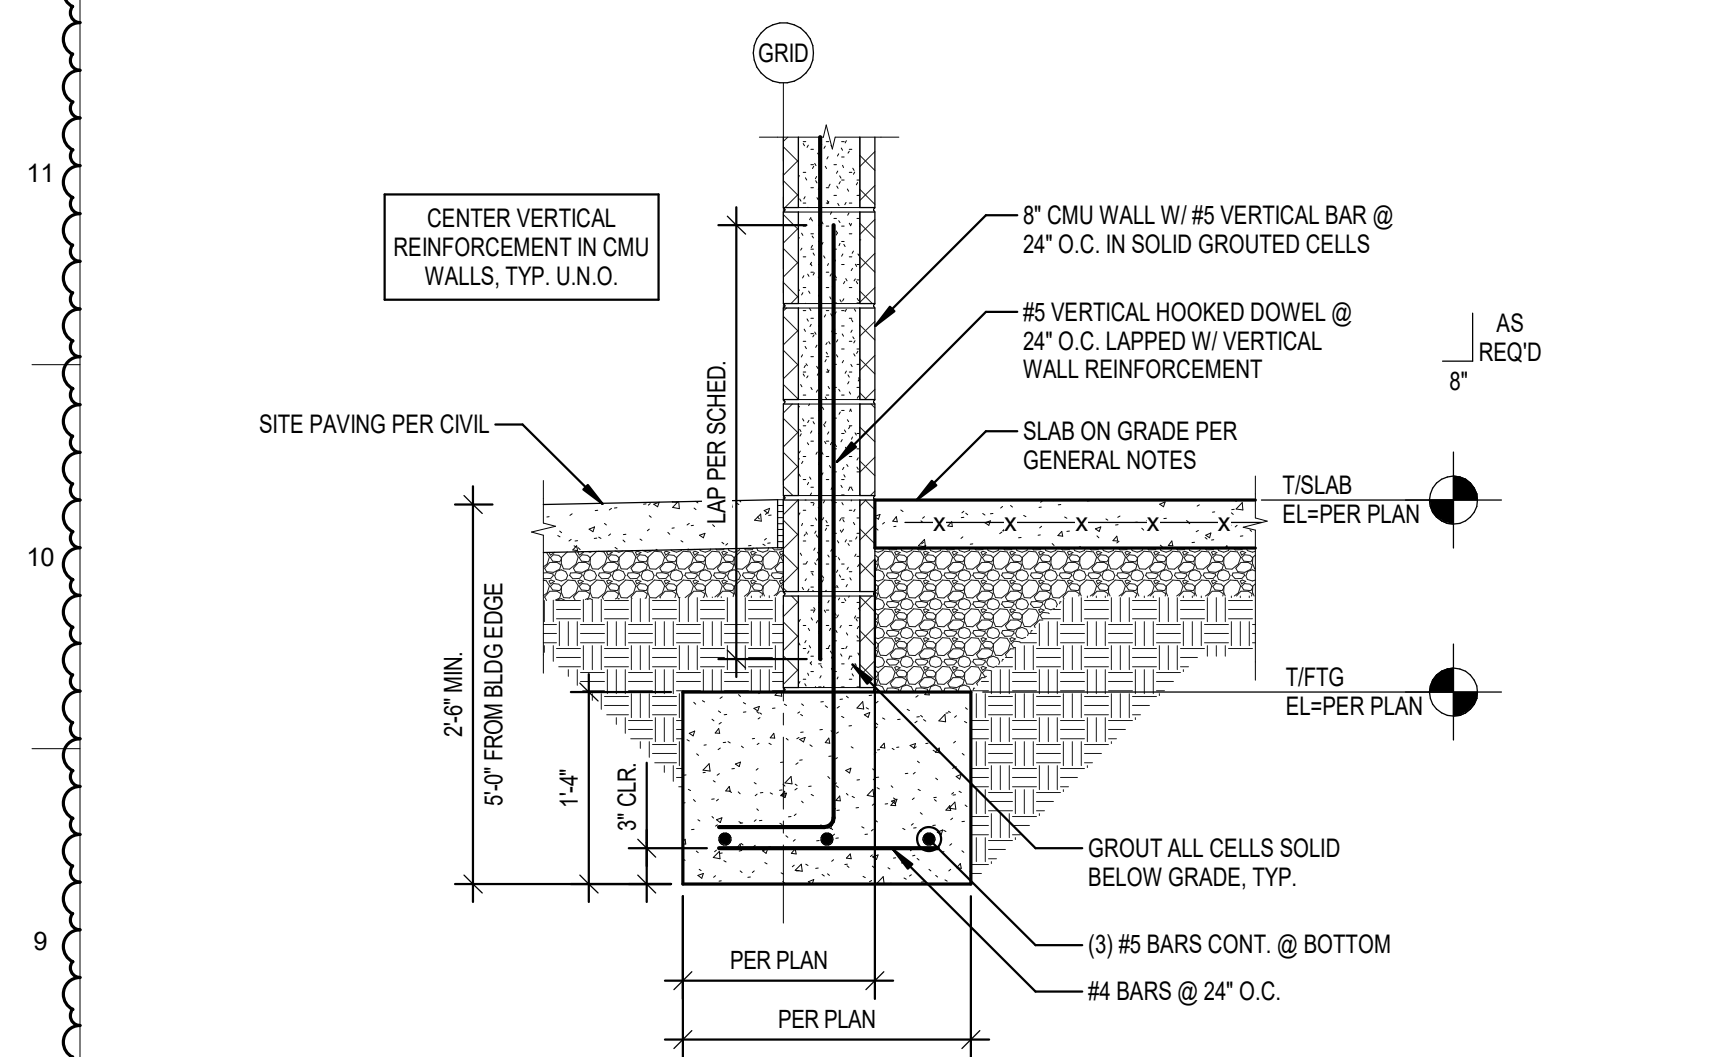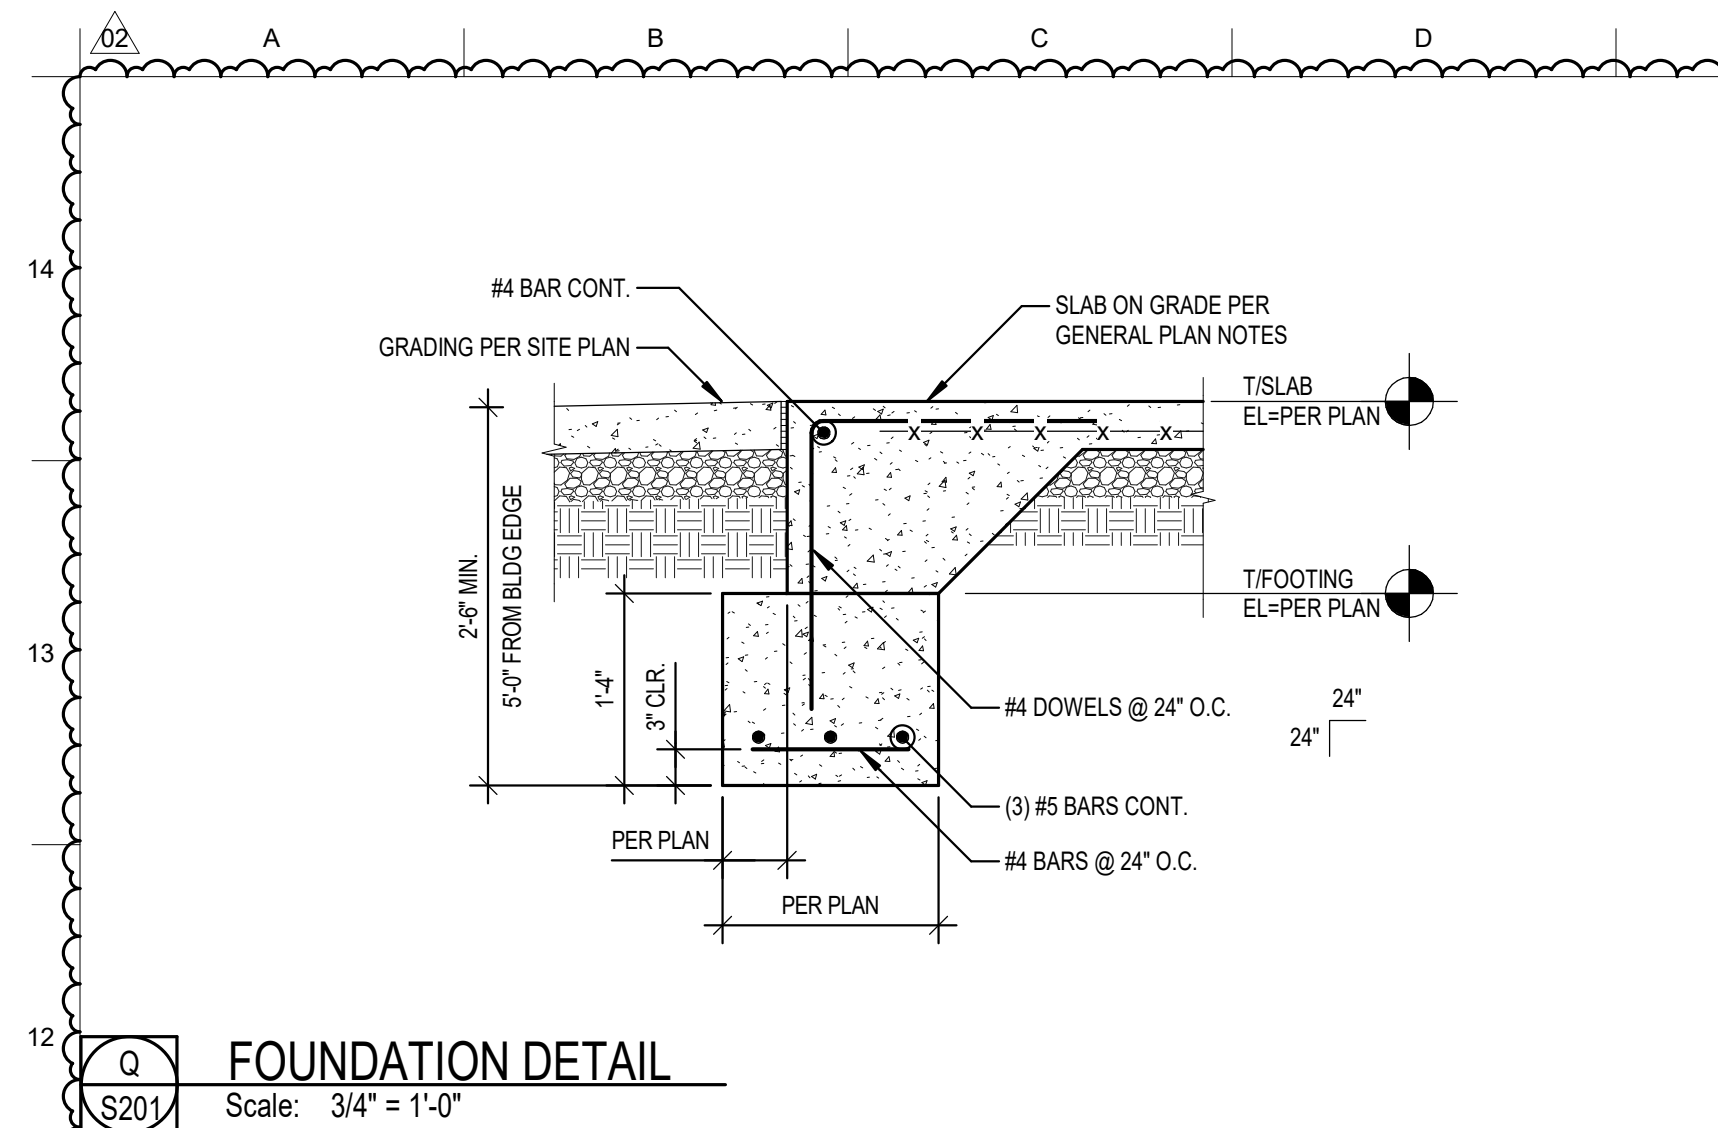[illegible]







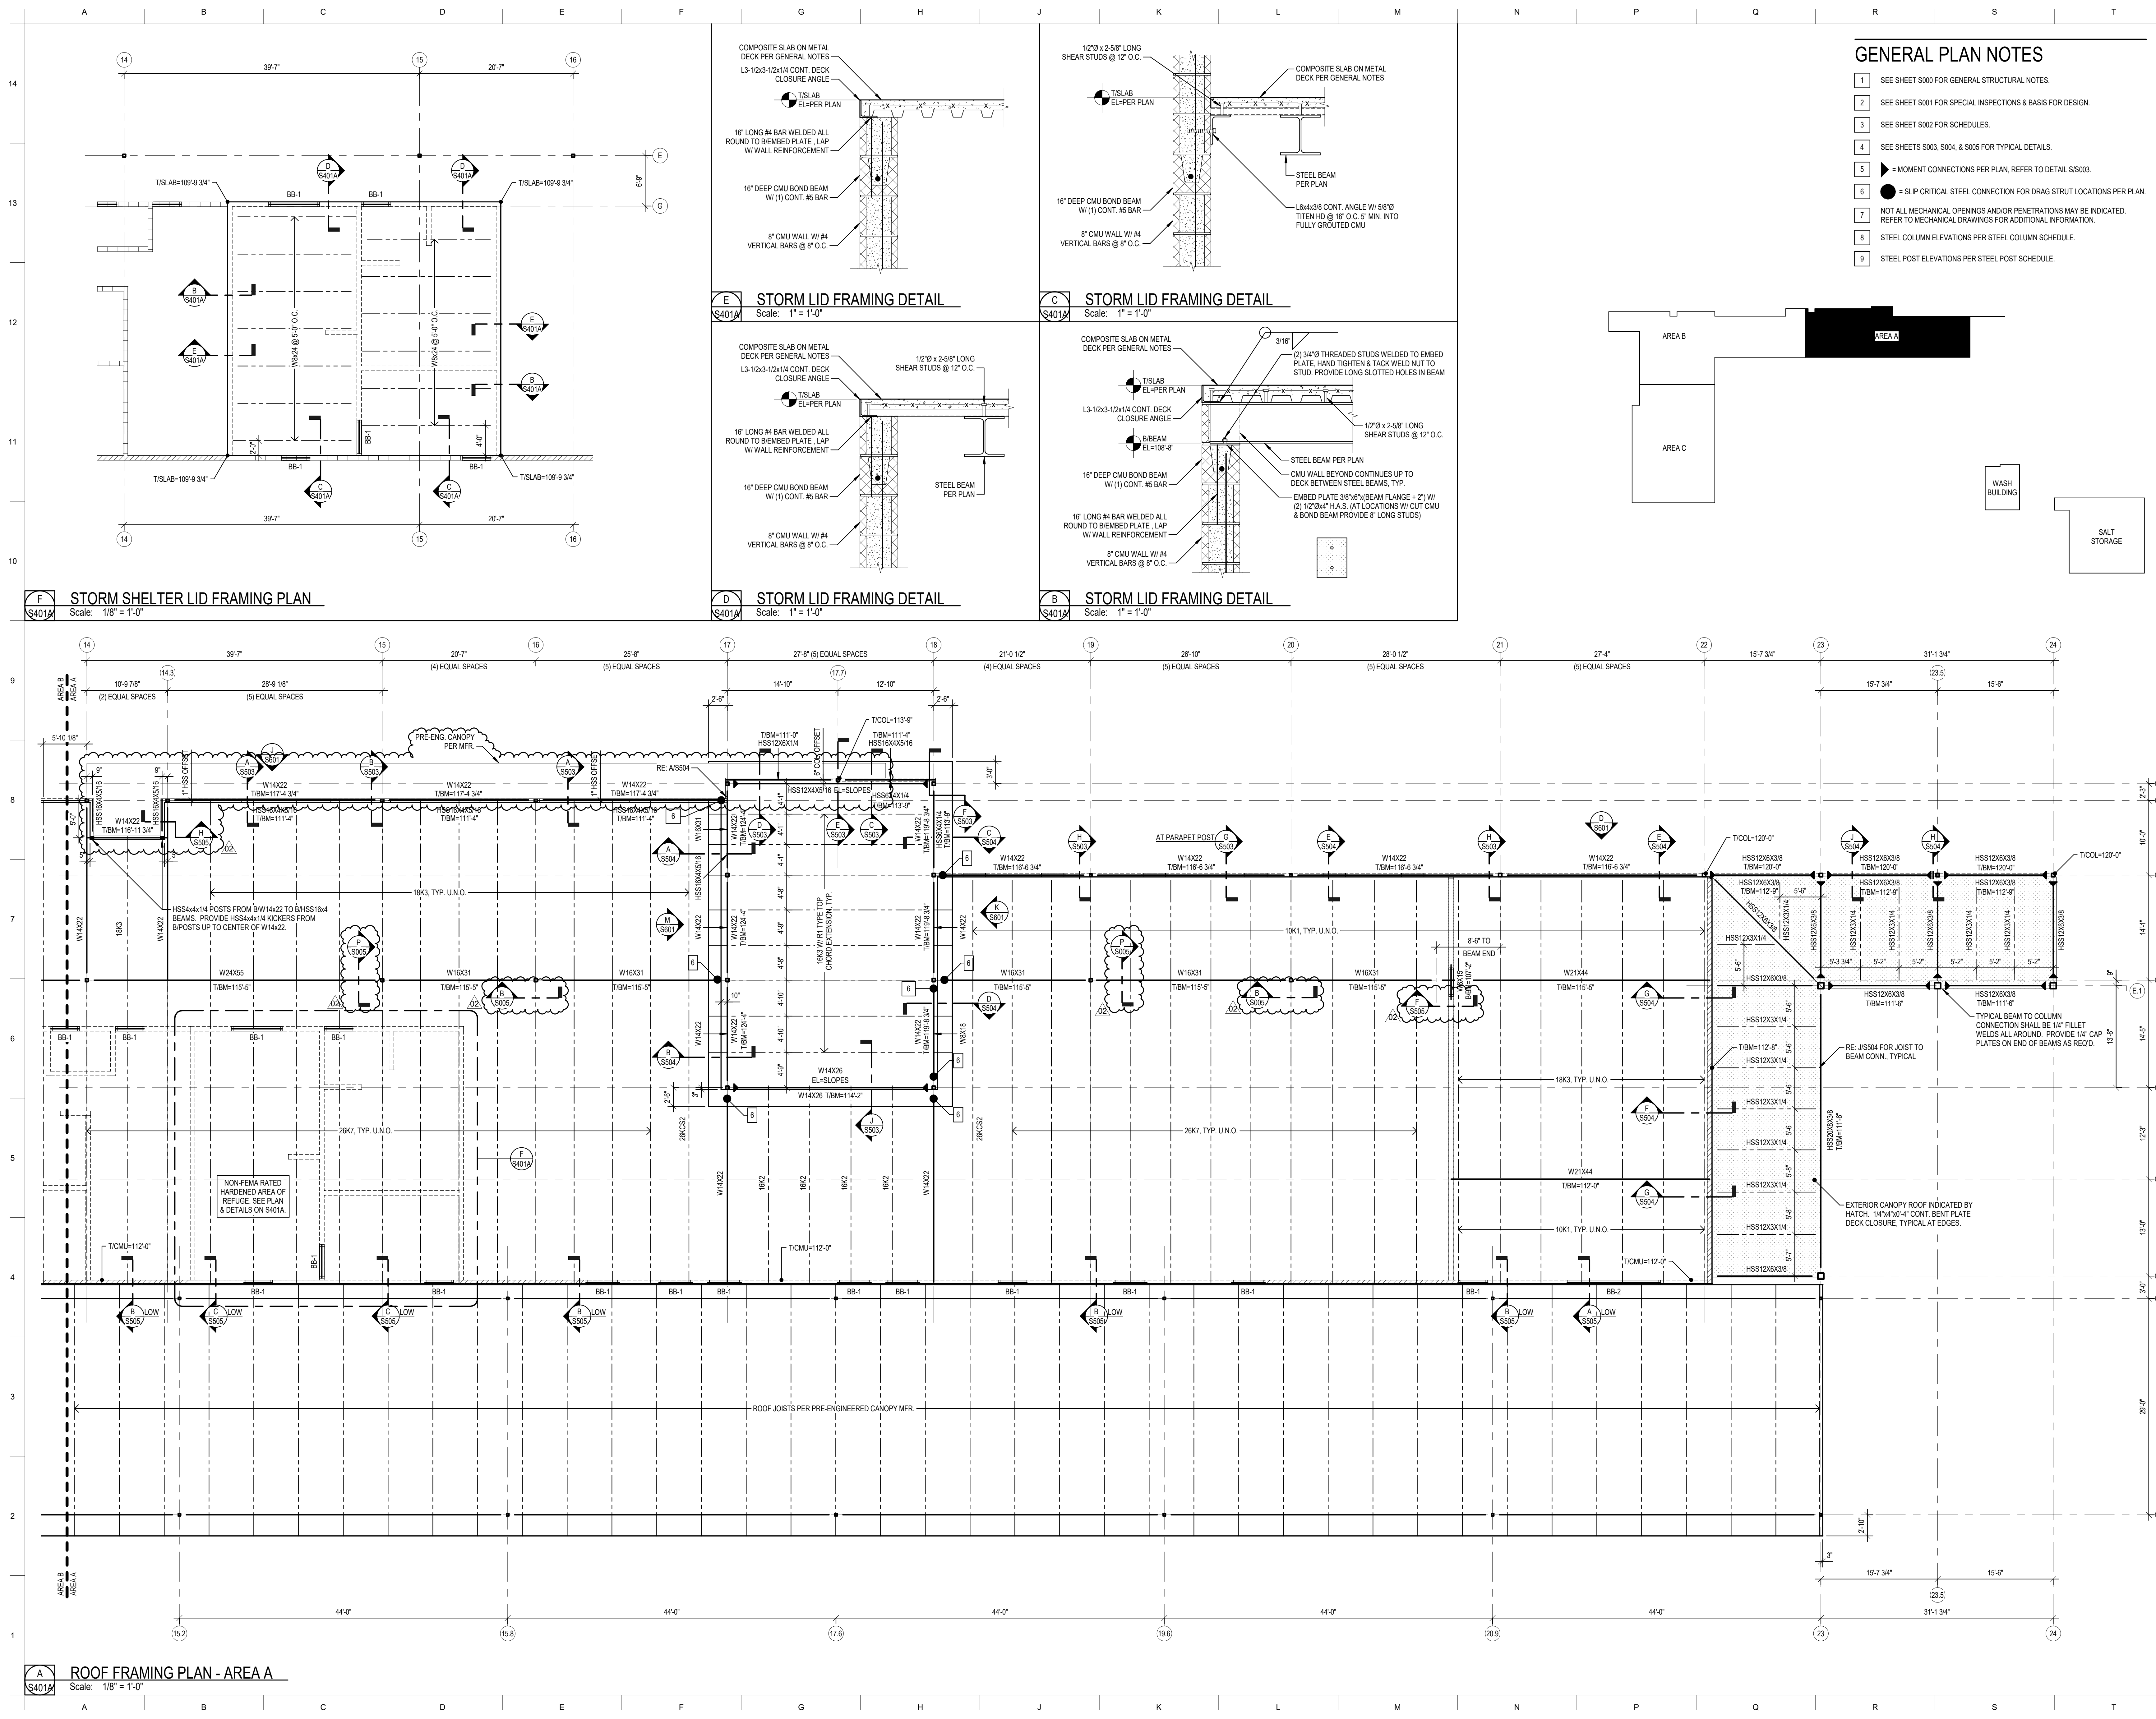

### GENERAL PLAN NOTES

- SEE SHEET S000 FOR GENERAL STRUCTURAL NOTES.
- SEE SHEET S001 FOR SPECIAL INSPECTIONS & BASIS FOR DESIGN.
- SEE SHEET S002 FOR SCHEDULES.
- SEE SHEETS S003, S004, & S005 FOR TYPICAL DETAILS.
- ▶ = MOMENT CONNECTIONS PER PLAN, REFER TO DETAIL S003.
- = SLIP CRITICAL STEEL CONNECTION FOR DRAG STRUT LOCATIONS PER PLAN.
- NOT ALL MECHANICAL OPENINGS AND/OR PENETRATIONS MAY BE INDICATED. REFER TO MECHANICAL DRAWINGS FOR ADDITIONAL INFORMATION.
- STEEL COLUMN ELEVATIONS PER STEEL COLUMN SCHEDULE.
- STEEL POST ELEVATIONS PER STEEL POST SCHEDULE.

### STORM LID FRAMING DETAIL

Scale: 1" = 1'-0"

### STORM LID FRAMING DETAIL

Scale: 1" = 1'-0"

### STORM LID FRAMING DETAIL

Scale: 1" = 1'-0"

### STORM LID FRAMING DETAIL

Scale: 1" = 1'-0"

### STORM SHELTER LID FRAMING PLAN

Scale: 1/8" = 1'-0"

**OWNER**  
**CITY OF WENTZVILLE, MISSOURI**  
1001 SCHROEDER CREEK BLVD  
WENTZVILLE, MO 63385  
636.327.5101

### PROJECT TEAM

**CIVIL ENGINEER**  
PREMIER DESIGN GROUP  
100 MIDLAND PARK DRIVE  
WENTZVILLE, MO 63385  
314.925.7444

**MAINTENANCE CONSULTANT**  
HDR ENGINEERING, INC.  
10450 HOLMES RD., STE 600  
SPRINGFIELD, MO 65810  
816.360.2700

**STRUCTURAL ENGINEER**  
METTEMAYER ENGINEERING  
2225 W CHESTERFIELD BLVD., SUITE 300  
SPRINGFIELD, MO 65807  
417.890.8002

**MEP ENGINEER**  
HENDERSON ENGINEERING, INC.  
8345 LEXEXA DR., #300  
LEXEXA, KS 66214  
417.555.5555


### REVISIONS

NO.	DESCRIPTION	DATE
02	ADD 02	01/25/23

PROJECT NO.: 20-0067 DRAWN BY: MRH, TNB  
DATE: 12.15.22 REVIEWED BY: BSW

### PROFESSIONAL SEAL

ALAN METTEMAYER, PE  
PROFESSIONAL TITLE: ENGINEER  
MO# E-2000152147

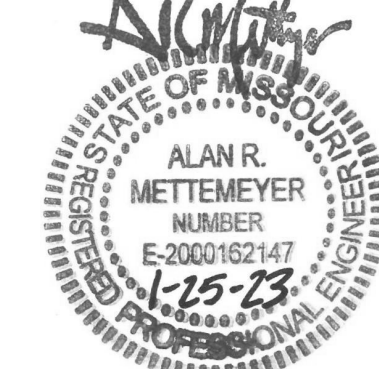


© 2021 H DESIGN GROUP, LLC.  
THIS DRAWING AND THE ARCHITECTURAL WORK REPRESENTED ARE OWNED BY H DESIGN GROUP, LLC. COPYRIGHT INCLUDES THE DRAWING AS WELL AS ALL COMPONENTS OF THE CONCEPTUAL DESIGN. REPRODUCTION OF ANY KIND IS STRICTLY PROHIBITED WITHOUT THE EXPRESSED WRITTEN CONSENT OF H DESIGN GROUP, LLC.

**PROJECT TITLE**  
**CITY OF WENTZVILLE, MO PUBLIC WORKS FACILITY**

**PROJECT ADDRESS**  
1286 INTERSTATE DRIVE  
WENTZVILLE, MO 63385


ROOF FRAMING PLAN - AREA A

SHEET  
**S401A**

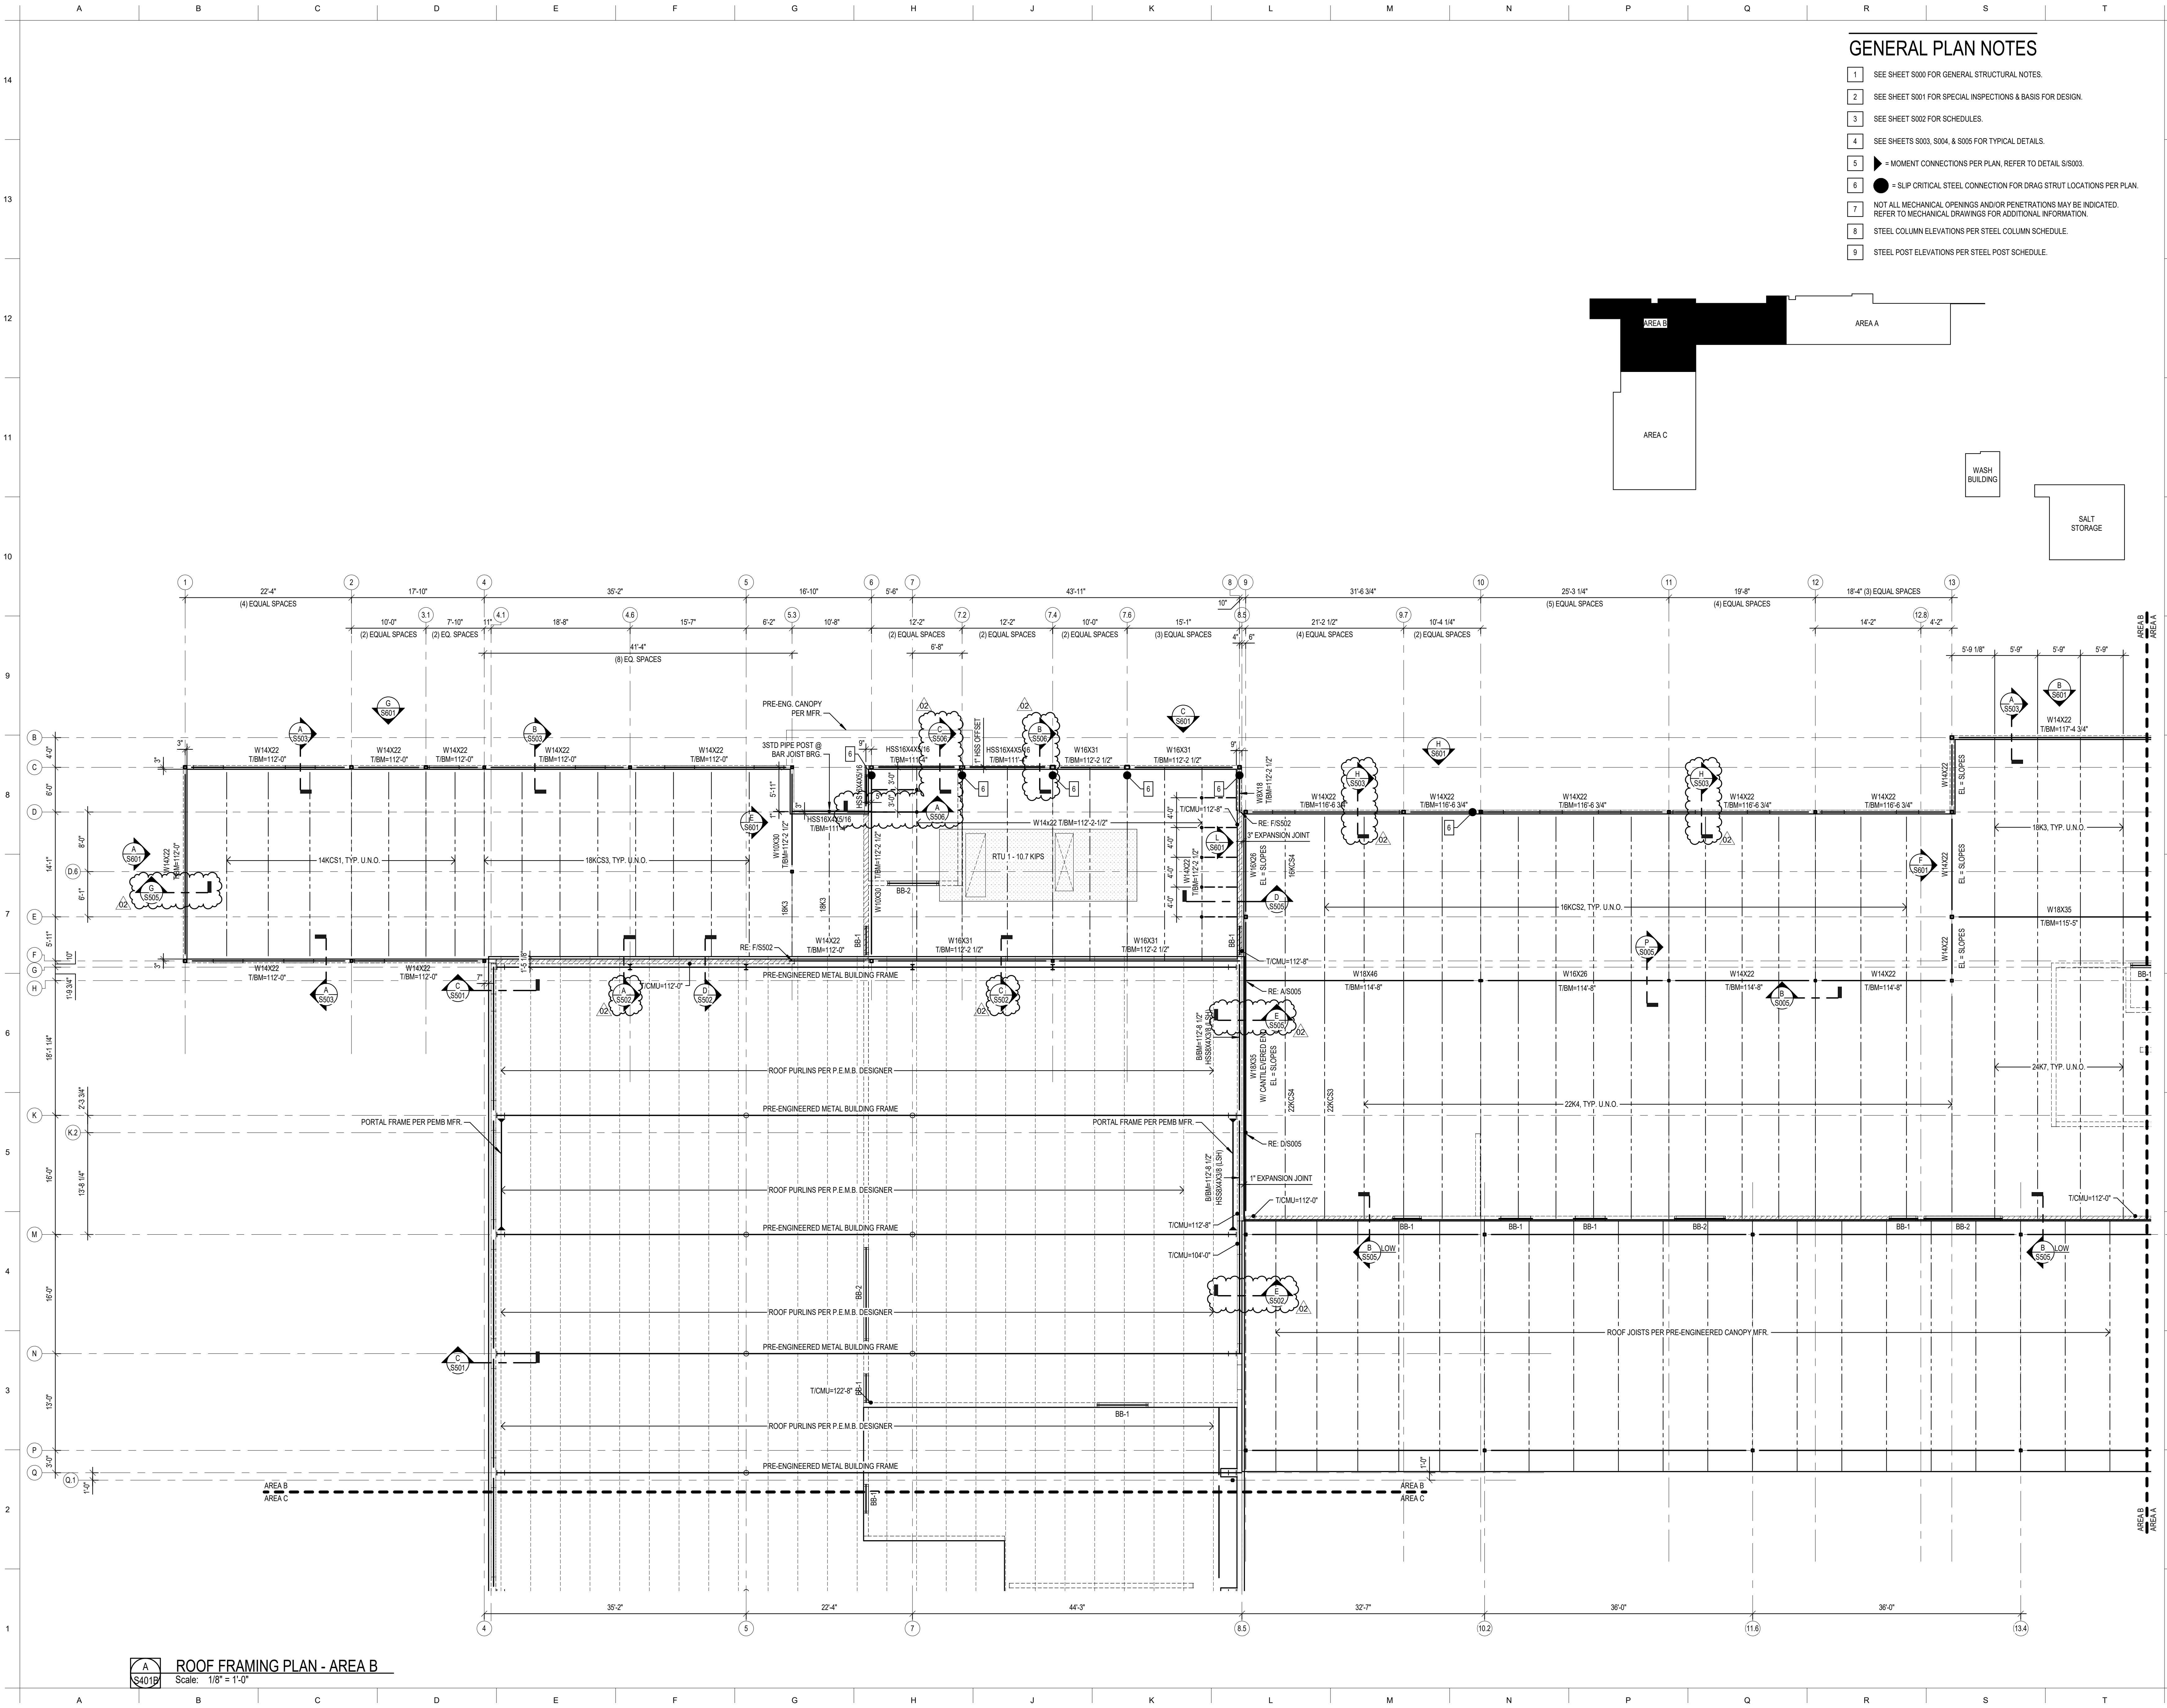

GENERAL PLAN NOTES

- 1 SEE SHEET S000 FOR GENERAL STRUCTURAL NOTES.
- 2 SEE SHEET S001 FOR SPECIAL INSPECTIONS & BASIS FOR DESIGN.
- 3 SEE SHEET S002 FOR SCHEDULES.
- 4 SEE SHEETS S003, S004, & S005 FOR TYPICAL DETAILS.
- 5 = MOMENT CONNECTIONS PER PLAN, REFER TO DETAIL S/S003.
- 6 = SLIP CRITICAL STEEL CONNECTION FOR DRAG STRUT LOCATIONS PER PLAN.
- 7 NOT ALL MECHANICAL OPENINGS AND/OR PENETRATIONS MAY BE INDICATED. REFER TO MECHANICAL DRAWINGS FOR ADDITIONAL INFORMATION.
- 8 STEEL COLUMN ELEVATIONS PER STEEL COLUMN SCHEDULE.
- 9 STEEL POST ELEVATIONS PER STEEL POST SCHEDULE.

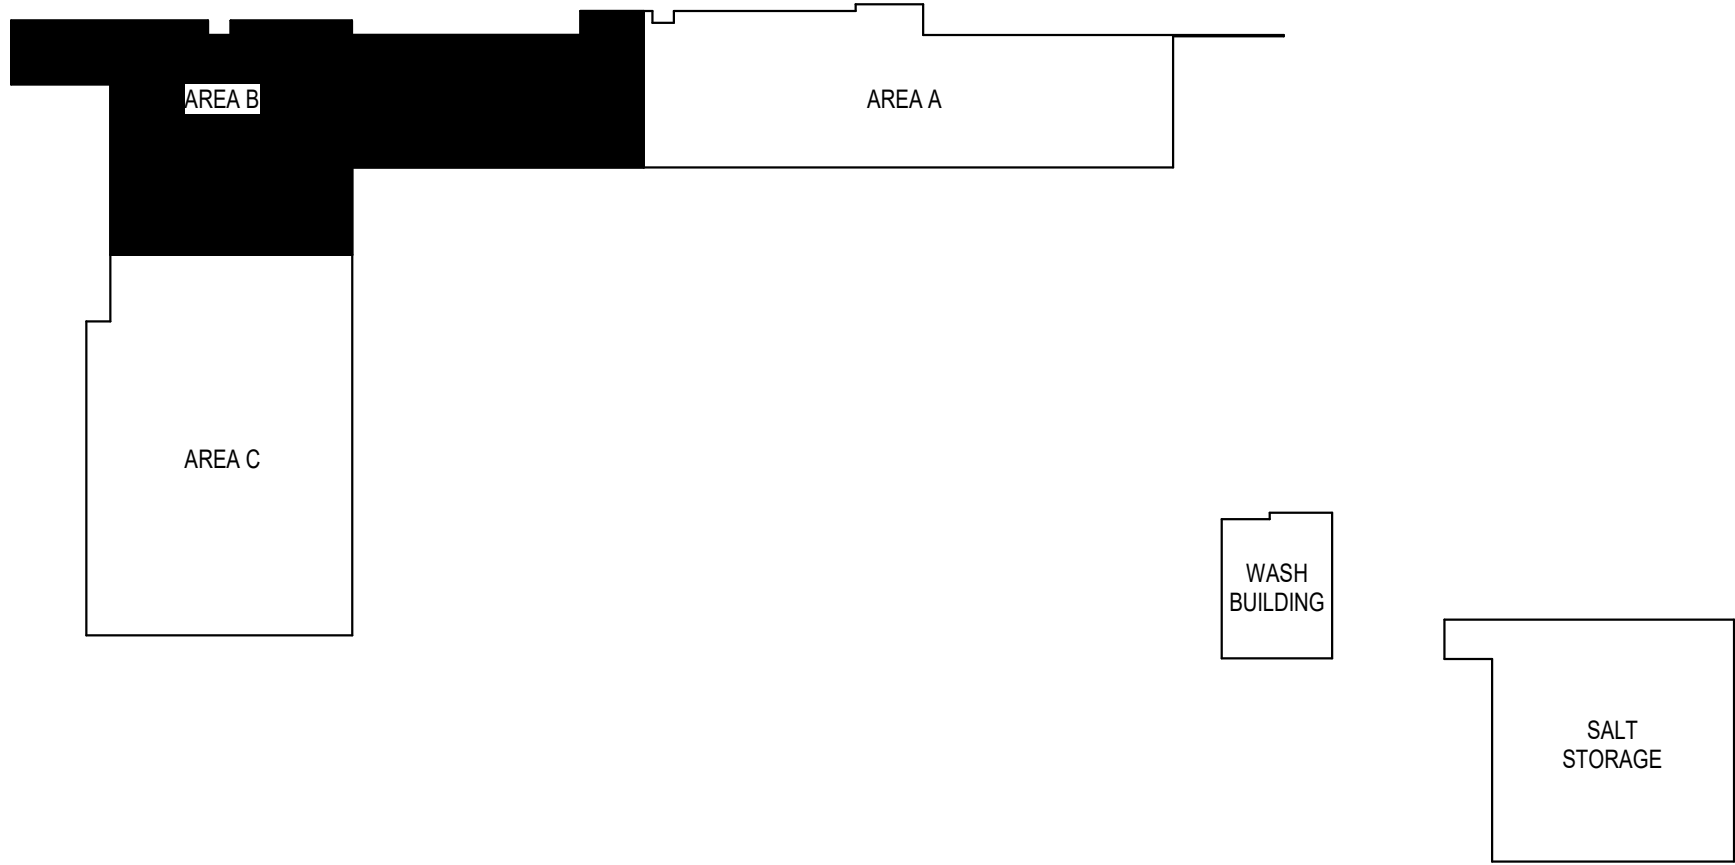

hdesigngroup  
architecture + design

5039 S National Avenue | Springfield, MO 65810 | 417.867.6595

**OWNER**  
**CITY OF WENTZVILLE, MISSOURI**  
1001 SCHROEDER CREEK BLVD  
WENTZVILLE, MO 63385  
636.327.5101

**PROJECT TEAM**  
**CIVIL ENGINEER**  
PREMIER DESIGN GROUP  
100 MIDLAND PARK DRIVE  
WENTZVILLE, MO 63385  
314.925.7444  
**MAINTENANCE CONSULTANT**  
HDR ENGINEERING, INC.  
10450 HOLMES RD., STE 600  
SPRINGFIELD, MO 65810  
816.360.2700  
**STRUCTURAL ENGINEER**  
METTEMAYER ENGINEERING  
2225 W CHESTERFIELD BLVD., SUITE 300  
SPRINGFIELD, MO 65807  
417.890.8002  
**MEP ENGINEER**  
HENDERSON ENGINEERING, INC.  
8345 LENEKA DR., #300  
LENEKA, KS 66214  
417.555.5555


REVISIONS		
NO.	DESCRIPTION	DATE
01	ADD 01	01/11/23
02	ADD 02	01/25/23

PROJECT NO.: 20-0067 DRAWN BY: MRH, TNB  
DATE: 12.15.22 REVIEWED BY: BSW


**PROFESSIONAL SEAL**  
ALAN R. METTEMAYER, PE  
PROFESSIONAL TITLE: ENGINEER  
MO# E-2000162147

**PROJECT TITLE**  
**CITY OF WENTZVILLE, MO PUBLIC WORKS FACILITY**  
**PROJECT ADDRESS**  
1296 INTERSTATE DRIVE  
WENTZVILLE, MO 63385

ROOF FRAMING PLAN - AREA B

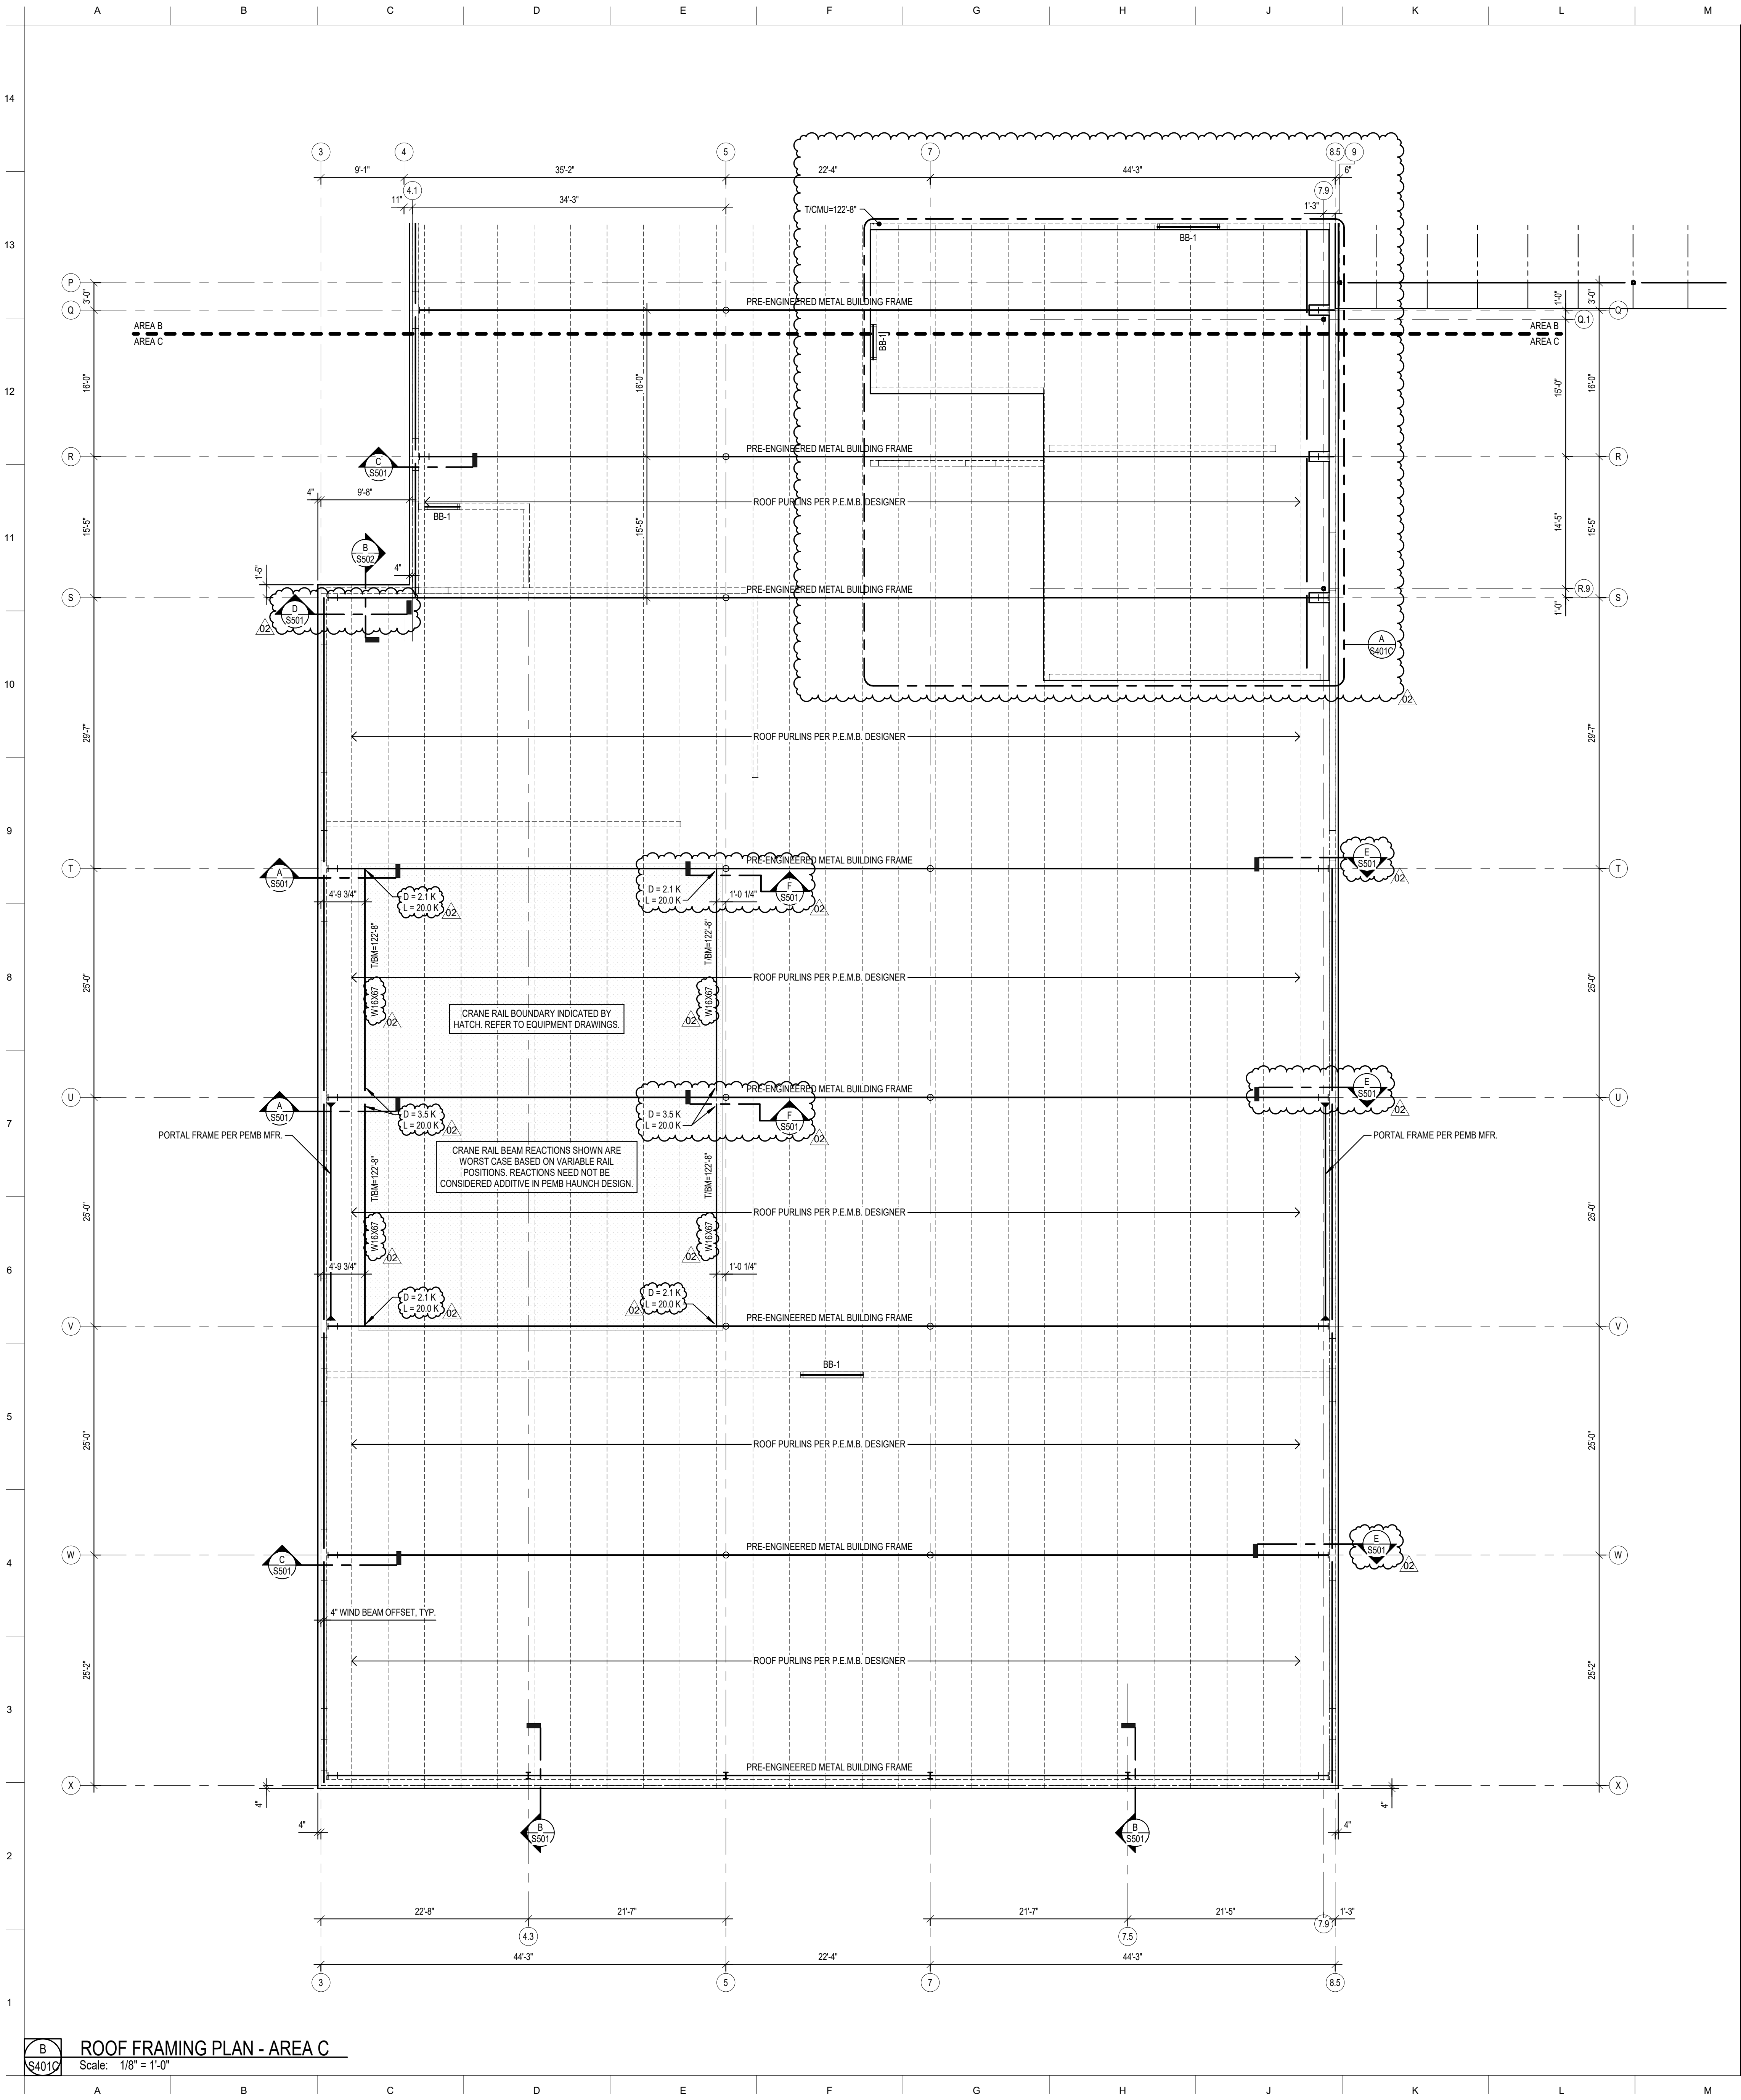


**B** ROOF FRAMING PLAN - AREA C  
**S401C** Scale: 1/8" = 1'-0"

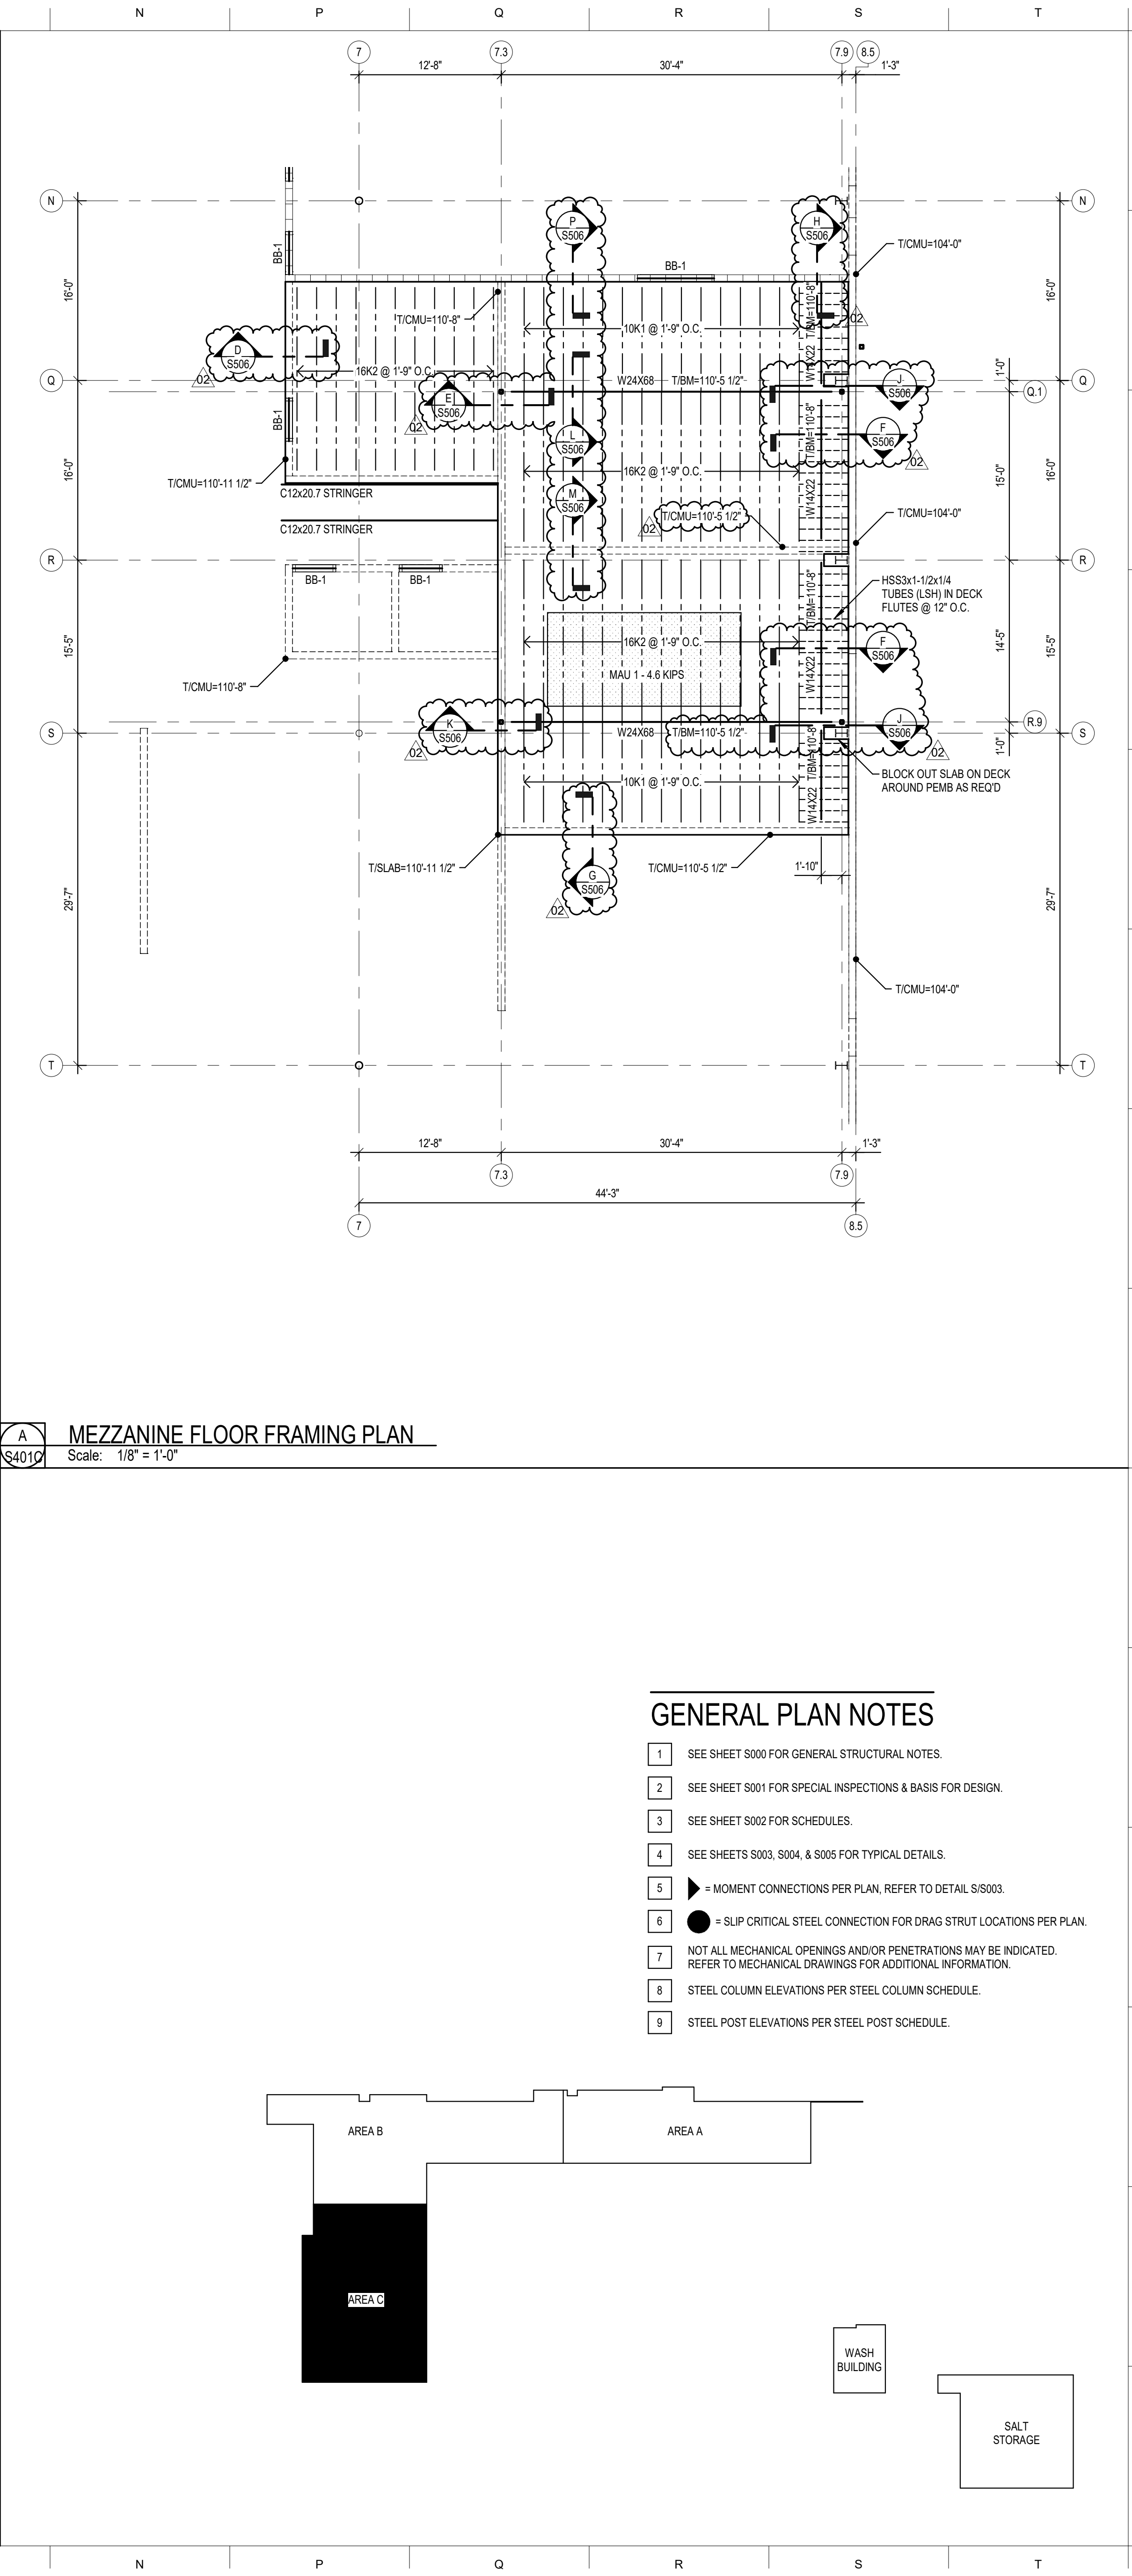

**A** MEZZANINE FLOOR FRAMING PLAN  
**S401D** Scale: 1/8" = 1'-0"

**GENERAL PLAN NOTES**

- SEE SHEET S000 FOR GENERAL STRUCTURAL NOTES.
- SEE SHEET S001 FOR SPECIAL INSPECTIONS & BASIS FOR DESIGN.
- SEE SHEET S002 FOR SCHEDULES.
- SEE SHEETS S003, S004, & S005 FOR TYPICAL DETAILS.
- ▶ = MOMENT CONNECTIONS PER PLAN, REFER TO DETAIL S1003.
- = SLIP CRITICAL STEEL CONNECTION FOR DRAG STRUT LOCATIONS PER PLAN.
- NOT ALL MECHANICAL OPENINGS AND/OR PENETRATIONS MAY BE INDICATED. REFER TO MECHANICAL DRAWINGS FOR ADDITIONAL INFORMATION.
- STEEL COLUMN ELEVATIONS PER STEEL COLUMN SCHEDULE.
- STEEL POST ELEVATIONS PER STEEL POST SCHEDULE.

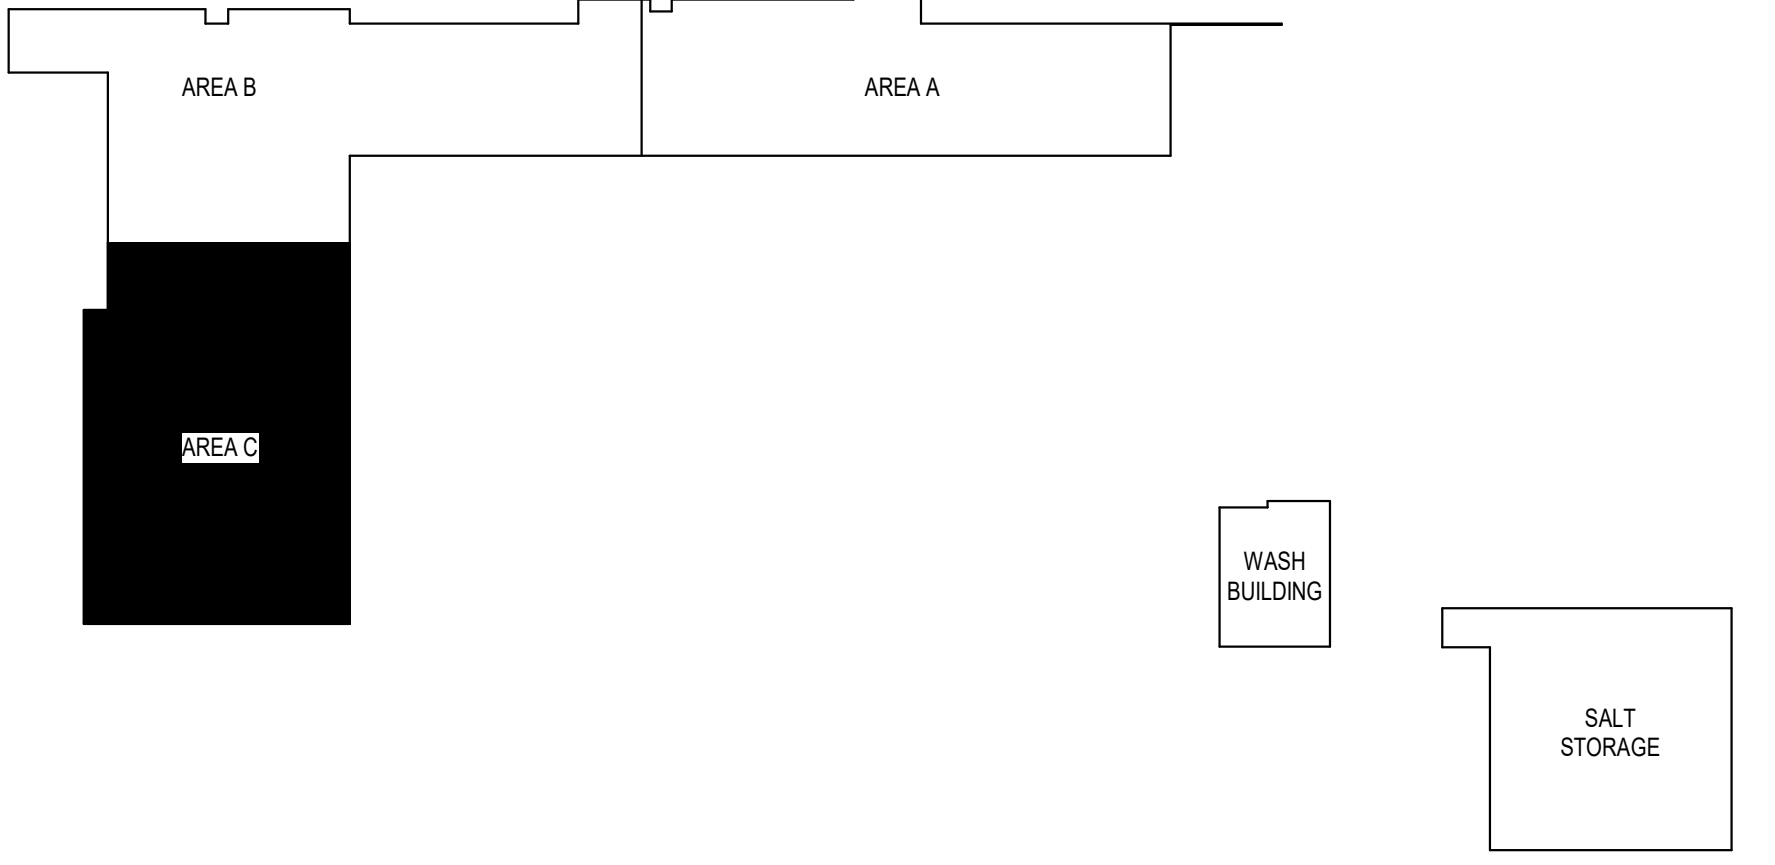

architecture + design

5039 S National Avenue | Springfield, MO 65810 | 417.867.6595

**OWNER**  
**CITY OF WENTZVILLE, MISSOURI**  
1001 SCHROEDER CREEK BLVD  
WENTZVILLE, MO 63385  
636.327.5101

**PROJECT TEAM**  
**CIVIL ENGINEER**  
PREMIER DESIGN GROUP  
100 MIDLAND PARK DRIVE  
WENTZVILLE, MO 63385  
314.925.7444  
**MAINTENANCE CONSULTANT**  
HDR ENGINEERING, INC.  
10450 HOLMES RD., STE 600  
SPRINGFIELD, MO 65810  
816.360.2700  
**STRUCTURAL ENGINEER**  
METTEMMEYER ENGINEERING  
2225 W CHESTERFIELD BLVD., SUITE 300  
SPRINGFIELD, MO 65807  
417.890.8002  
**MEP ENGINEER**  
HENDERSON ENGINEERING, INC.  
8345 LENEXA DR., #300  
LENEXA, KS 66214  
417.555.5555

NO.	DESCRIPTION	DATE
01	ADD 01	01/11/23
02	ADD 02	01/25/23

PROJECT NO.: 20-0067 DRAWN BY: MRH, TNB  
DATE: 12.15.22 REVIEWED BY: BSW

**PROFESSIONAL SEAL**  
**ALAN R. METTEMMEYER, PE**  
PROFESSIONAL TITLE: ENGINEER  
MO# E-2000162147

© 2021 H DESIGN GROUP, LLC.  
THIS DRAWING AND THE ARCHITECTURAL WORK REPRESENTED ARE OWNED BY H DESIGN GROUP, LLC. COPYRIGHT INCLUDES THIS DRAWING, AS WELL AS ALL COMPONENTS OF THE CONCEPTUAL DESIGN. REPRODUCTION OF ANY KIND IS STRICTLY PROHIBITED WITHOUT THE EXPRESSED WRITTEN CONSENT OF H DESIGN GROUP, LLC.


**PROJECT TITLE**  
**CITY OF WENTZVILLE, MO PUBLIC WORKS FACILITY**

**PROJECT ADDRESS**  
1295 INTERSTATE DRIVE  
WENTZVILLE, MO 63385


**ROOF FRAMING PLAN - AREA C**

**S401C** SHEET




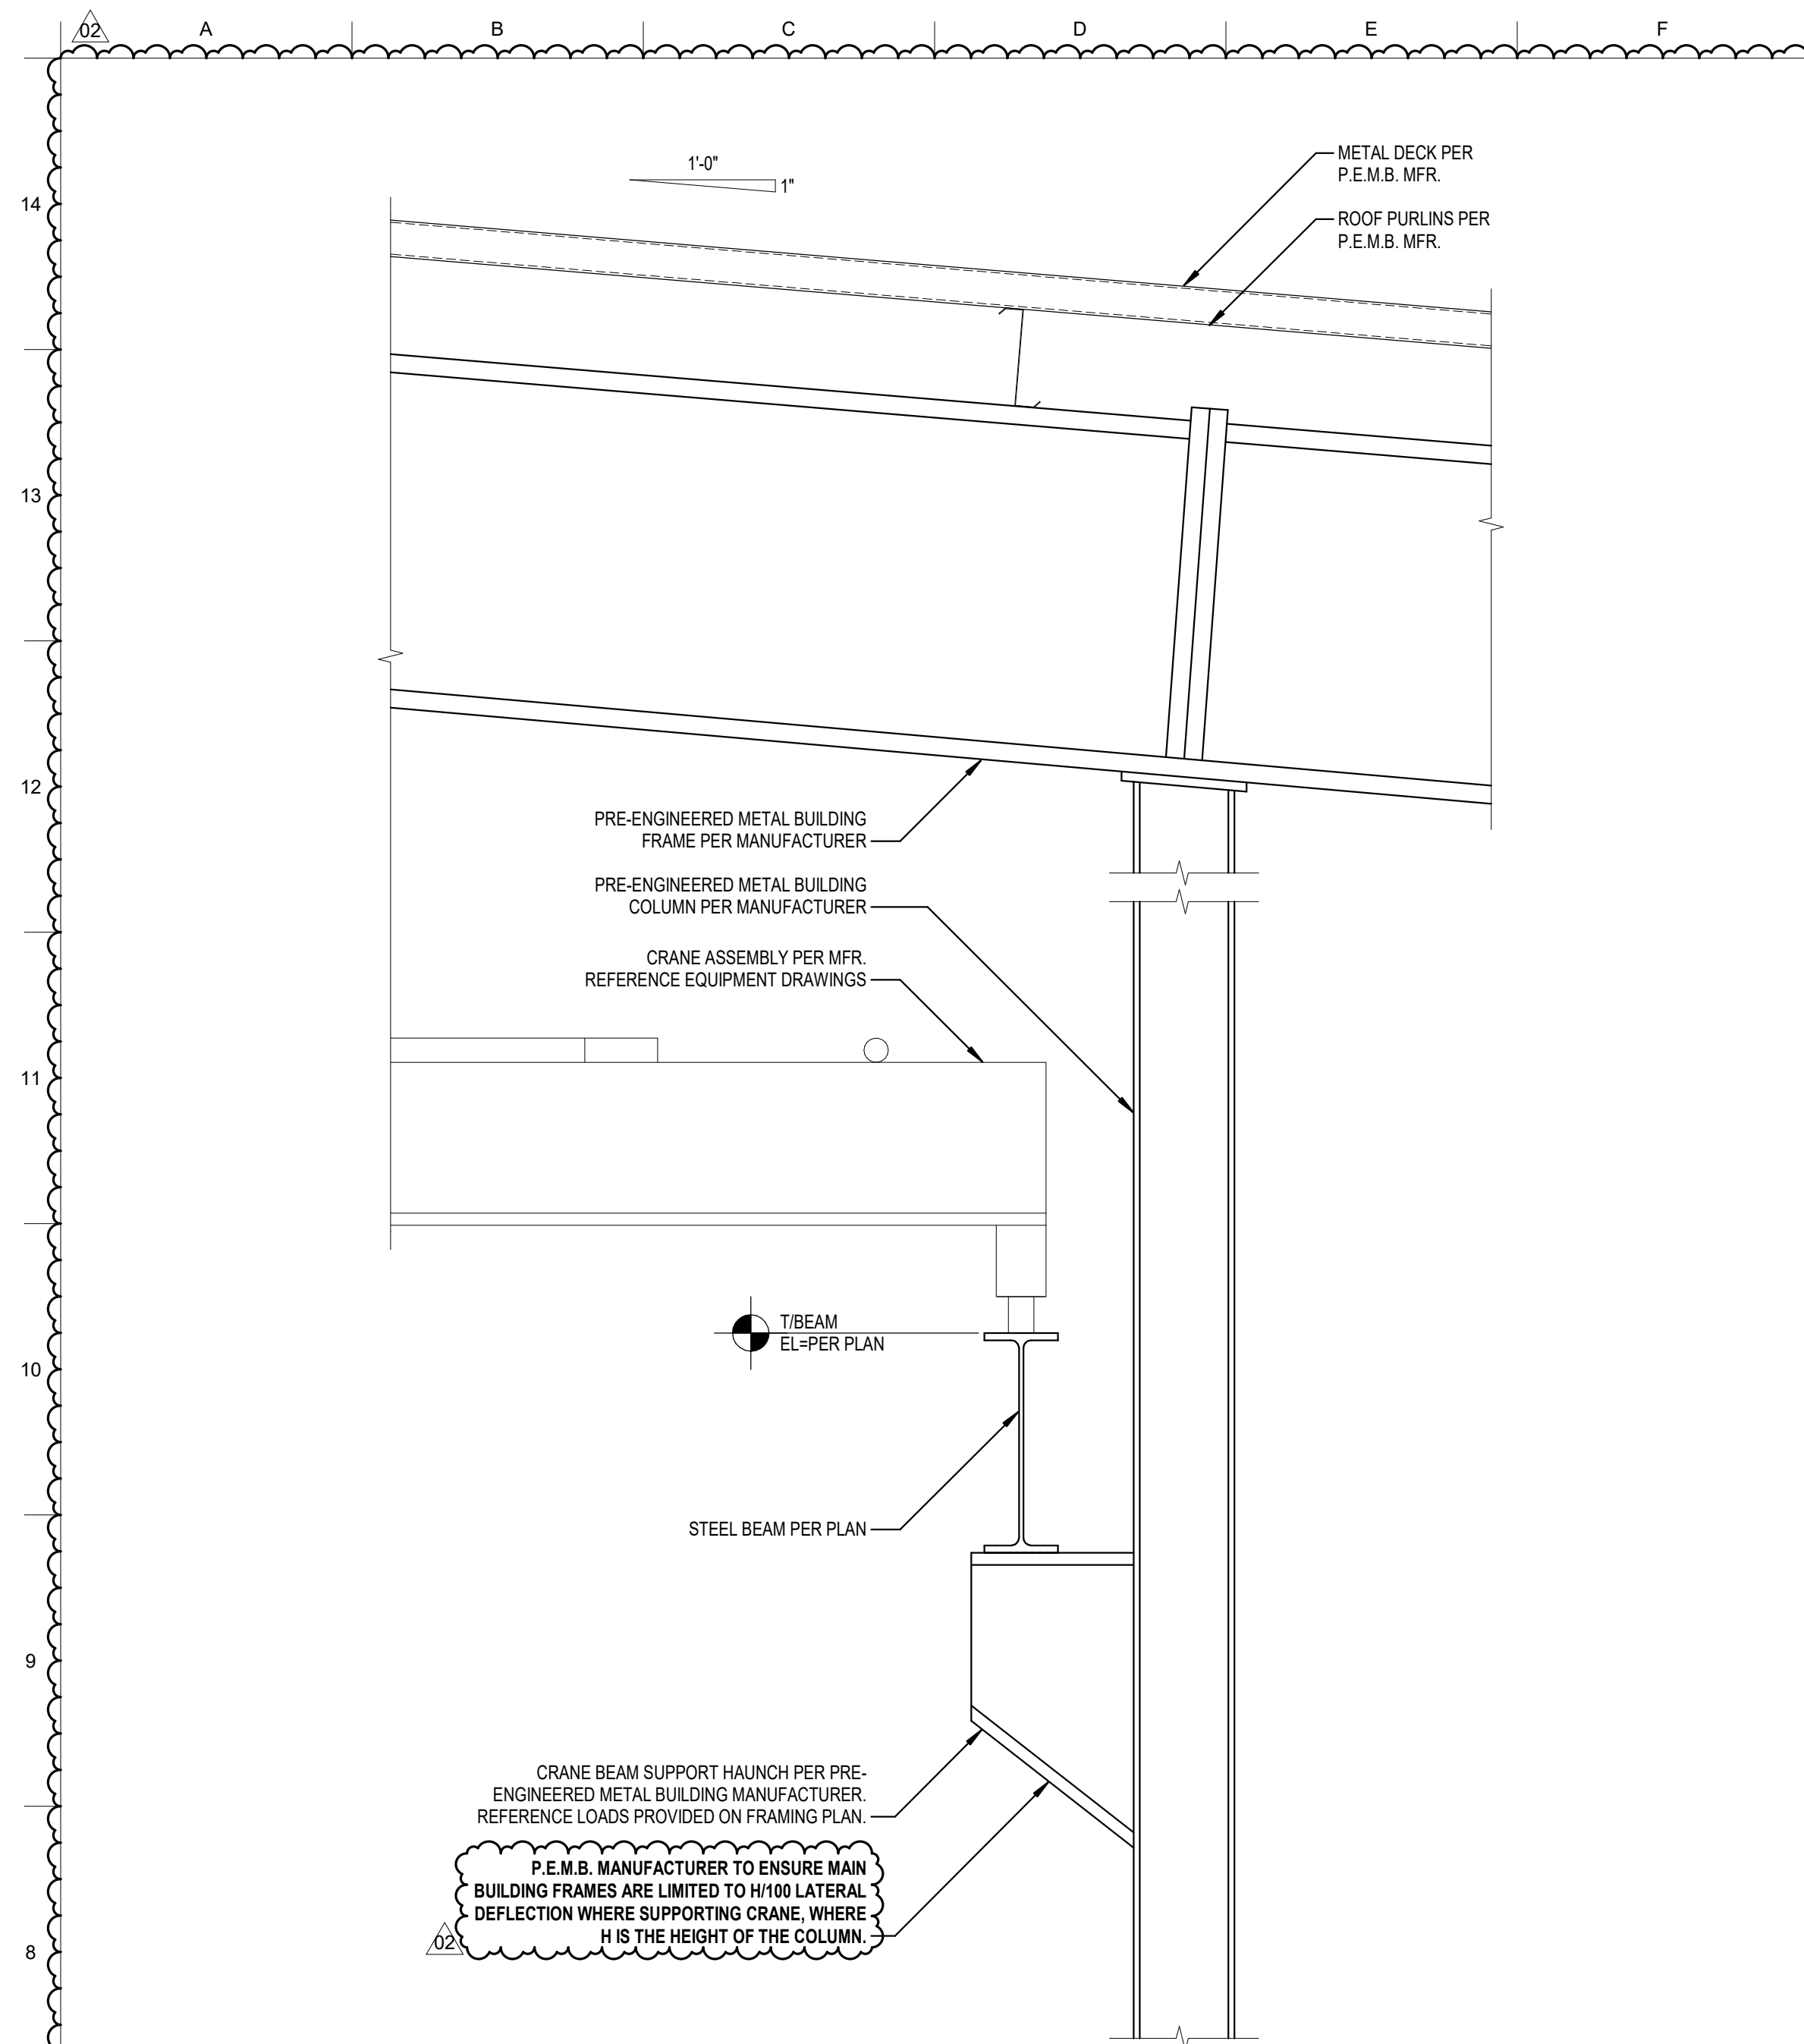


**F** ROOF FRAMING DETAIL  
Scale: 1" = 1'-0"

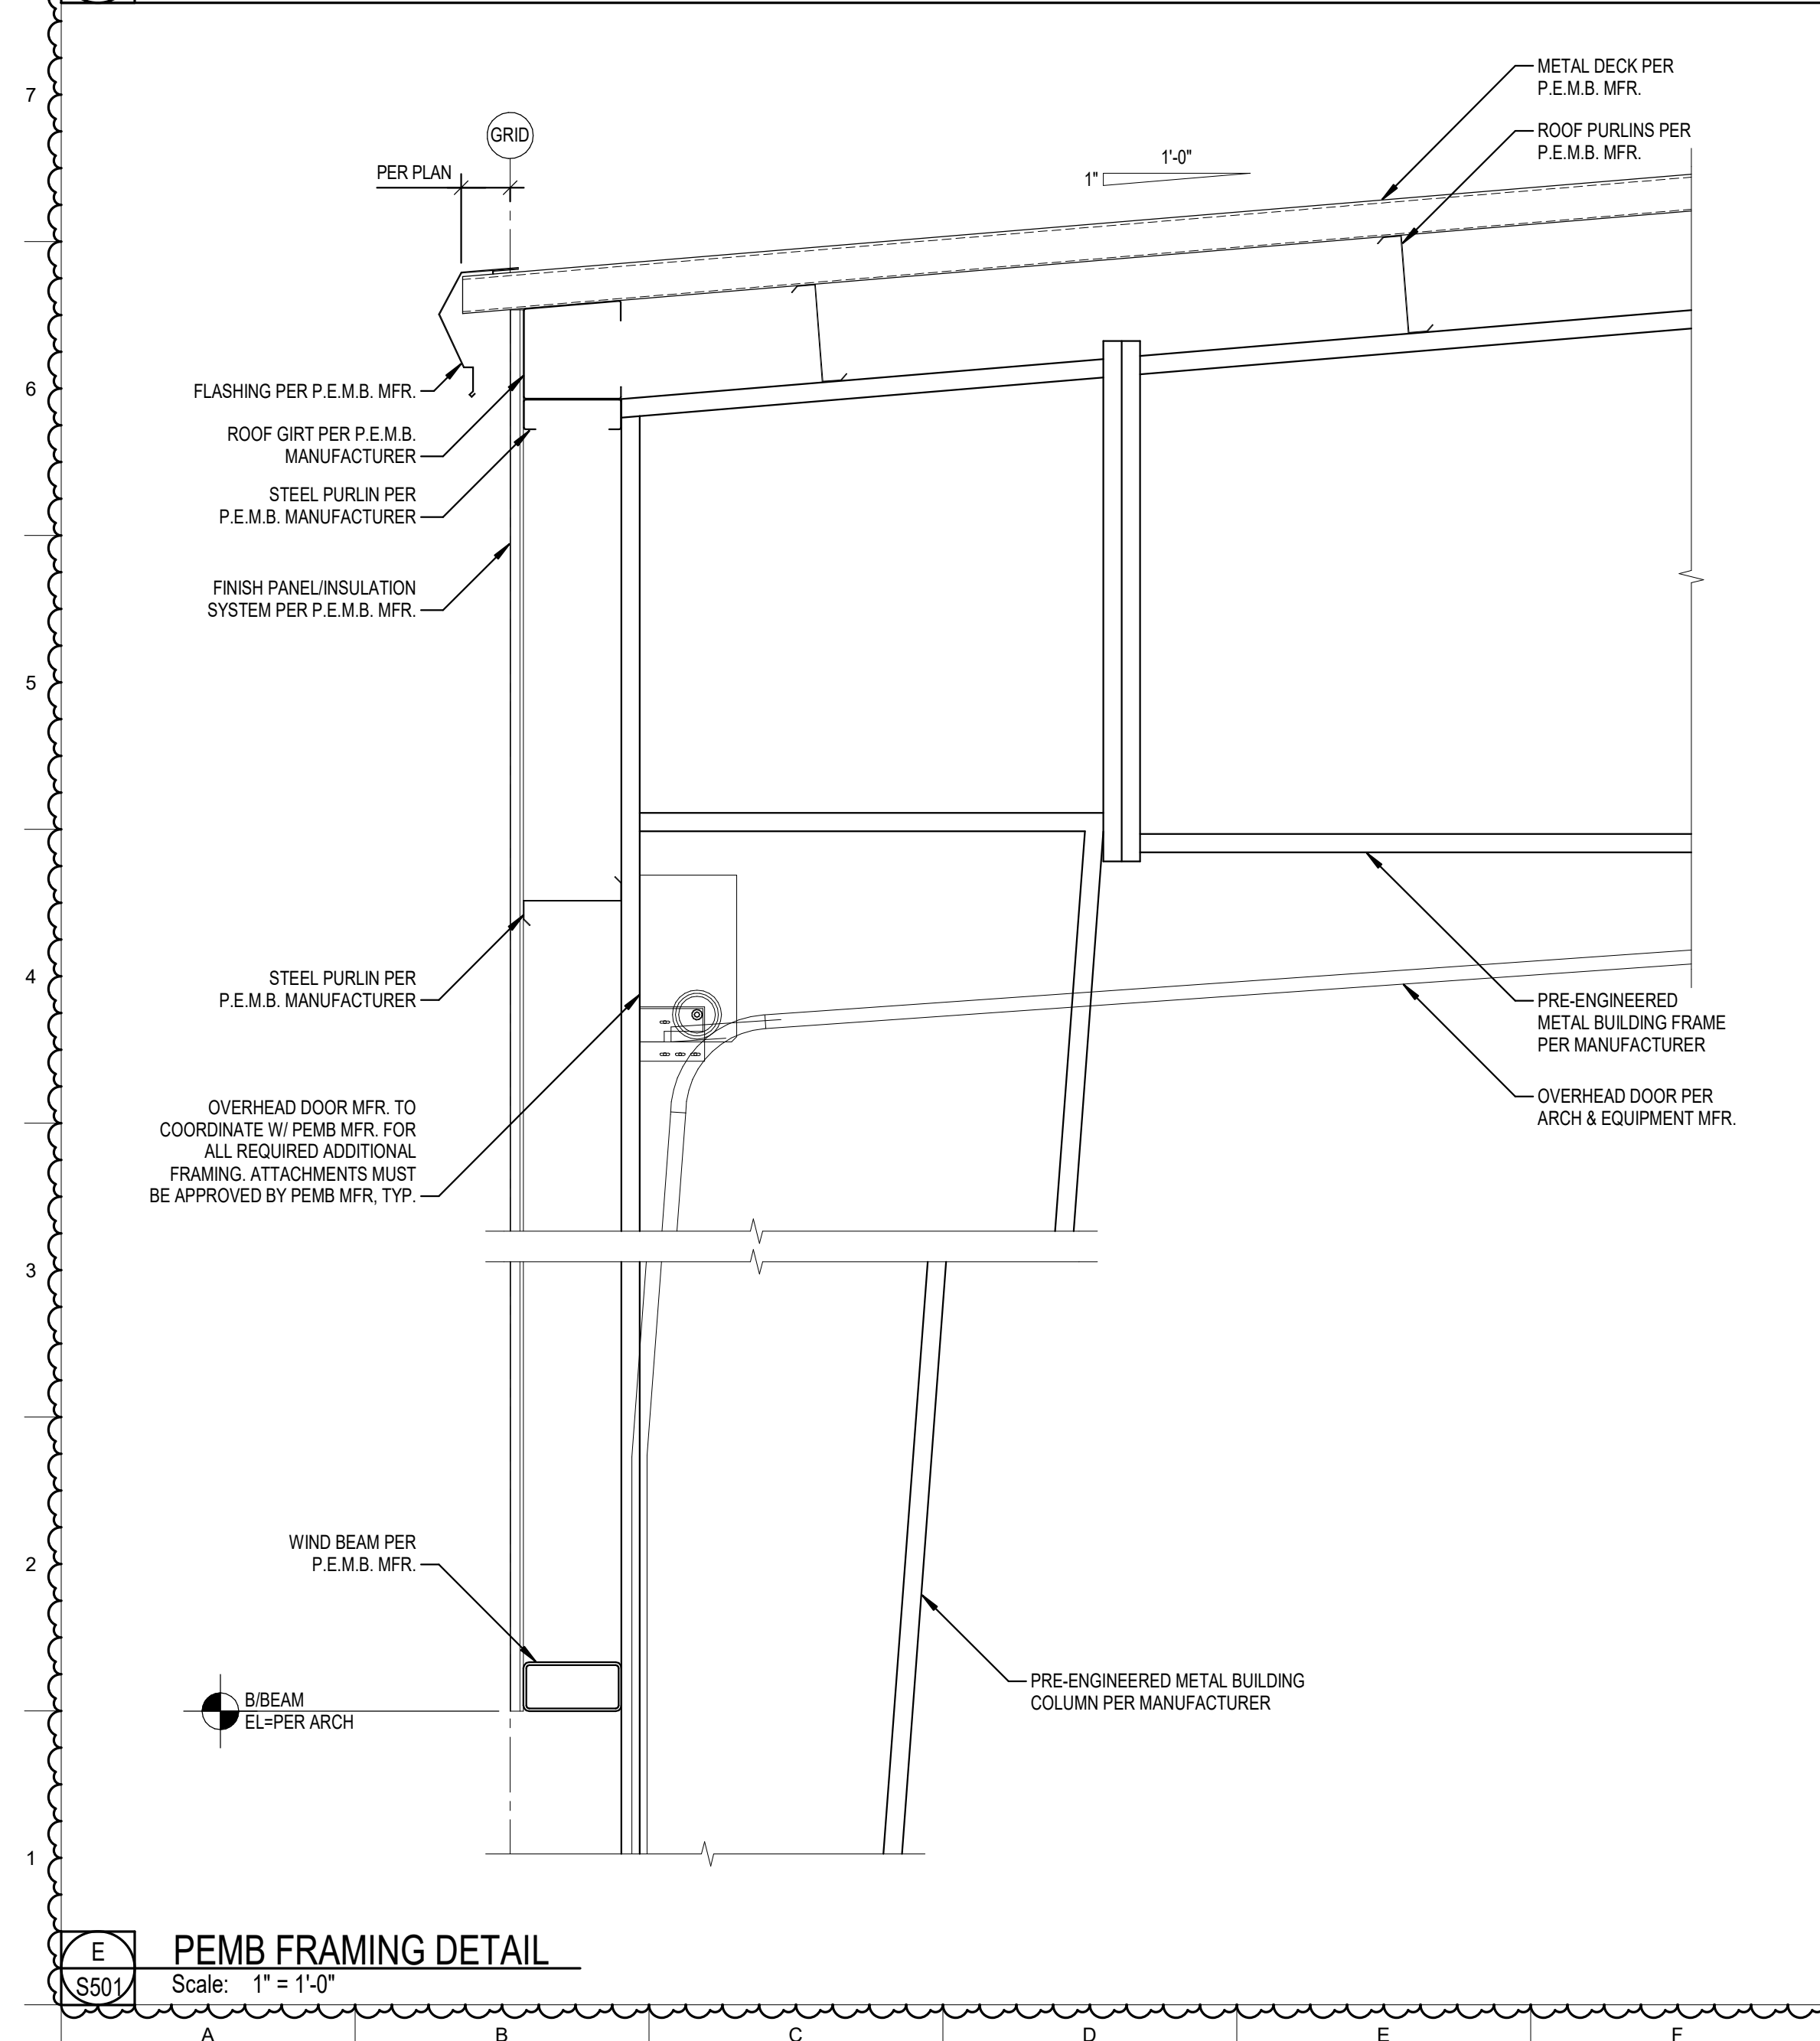


**E** PEMB FRAMING DETAIL  
Scale: 1" = 1'-0"

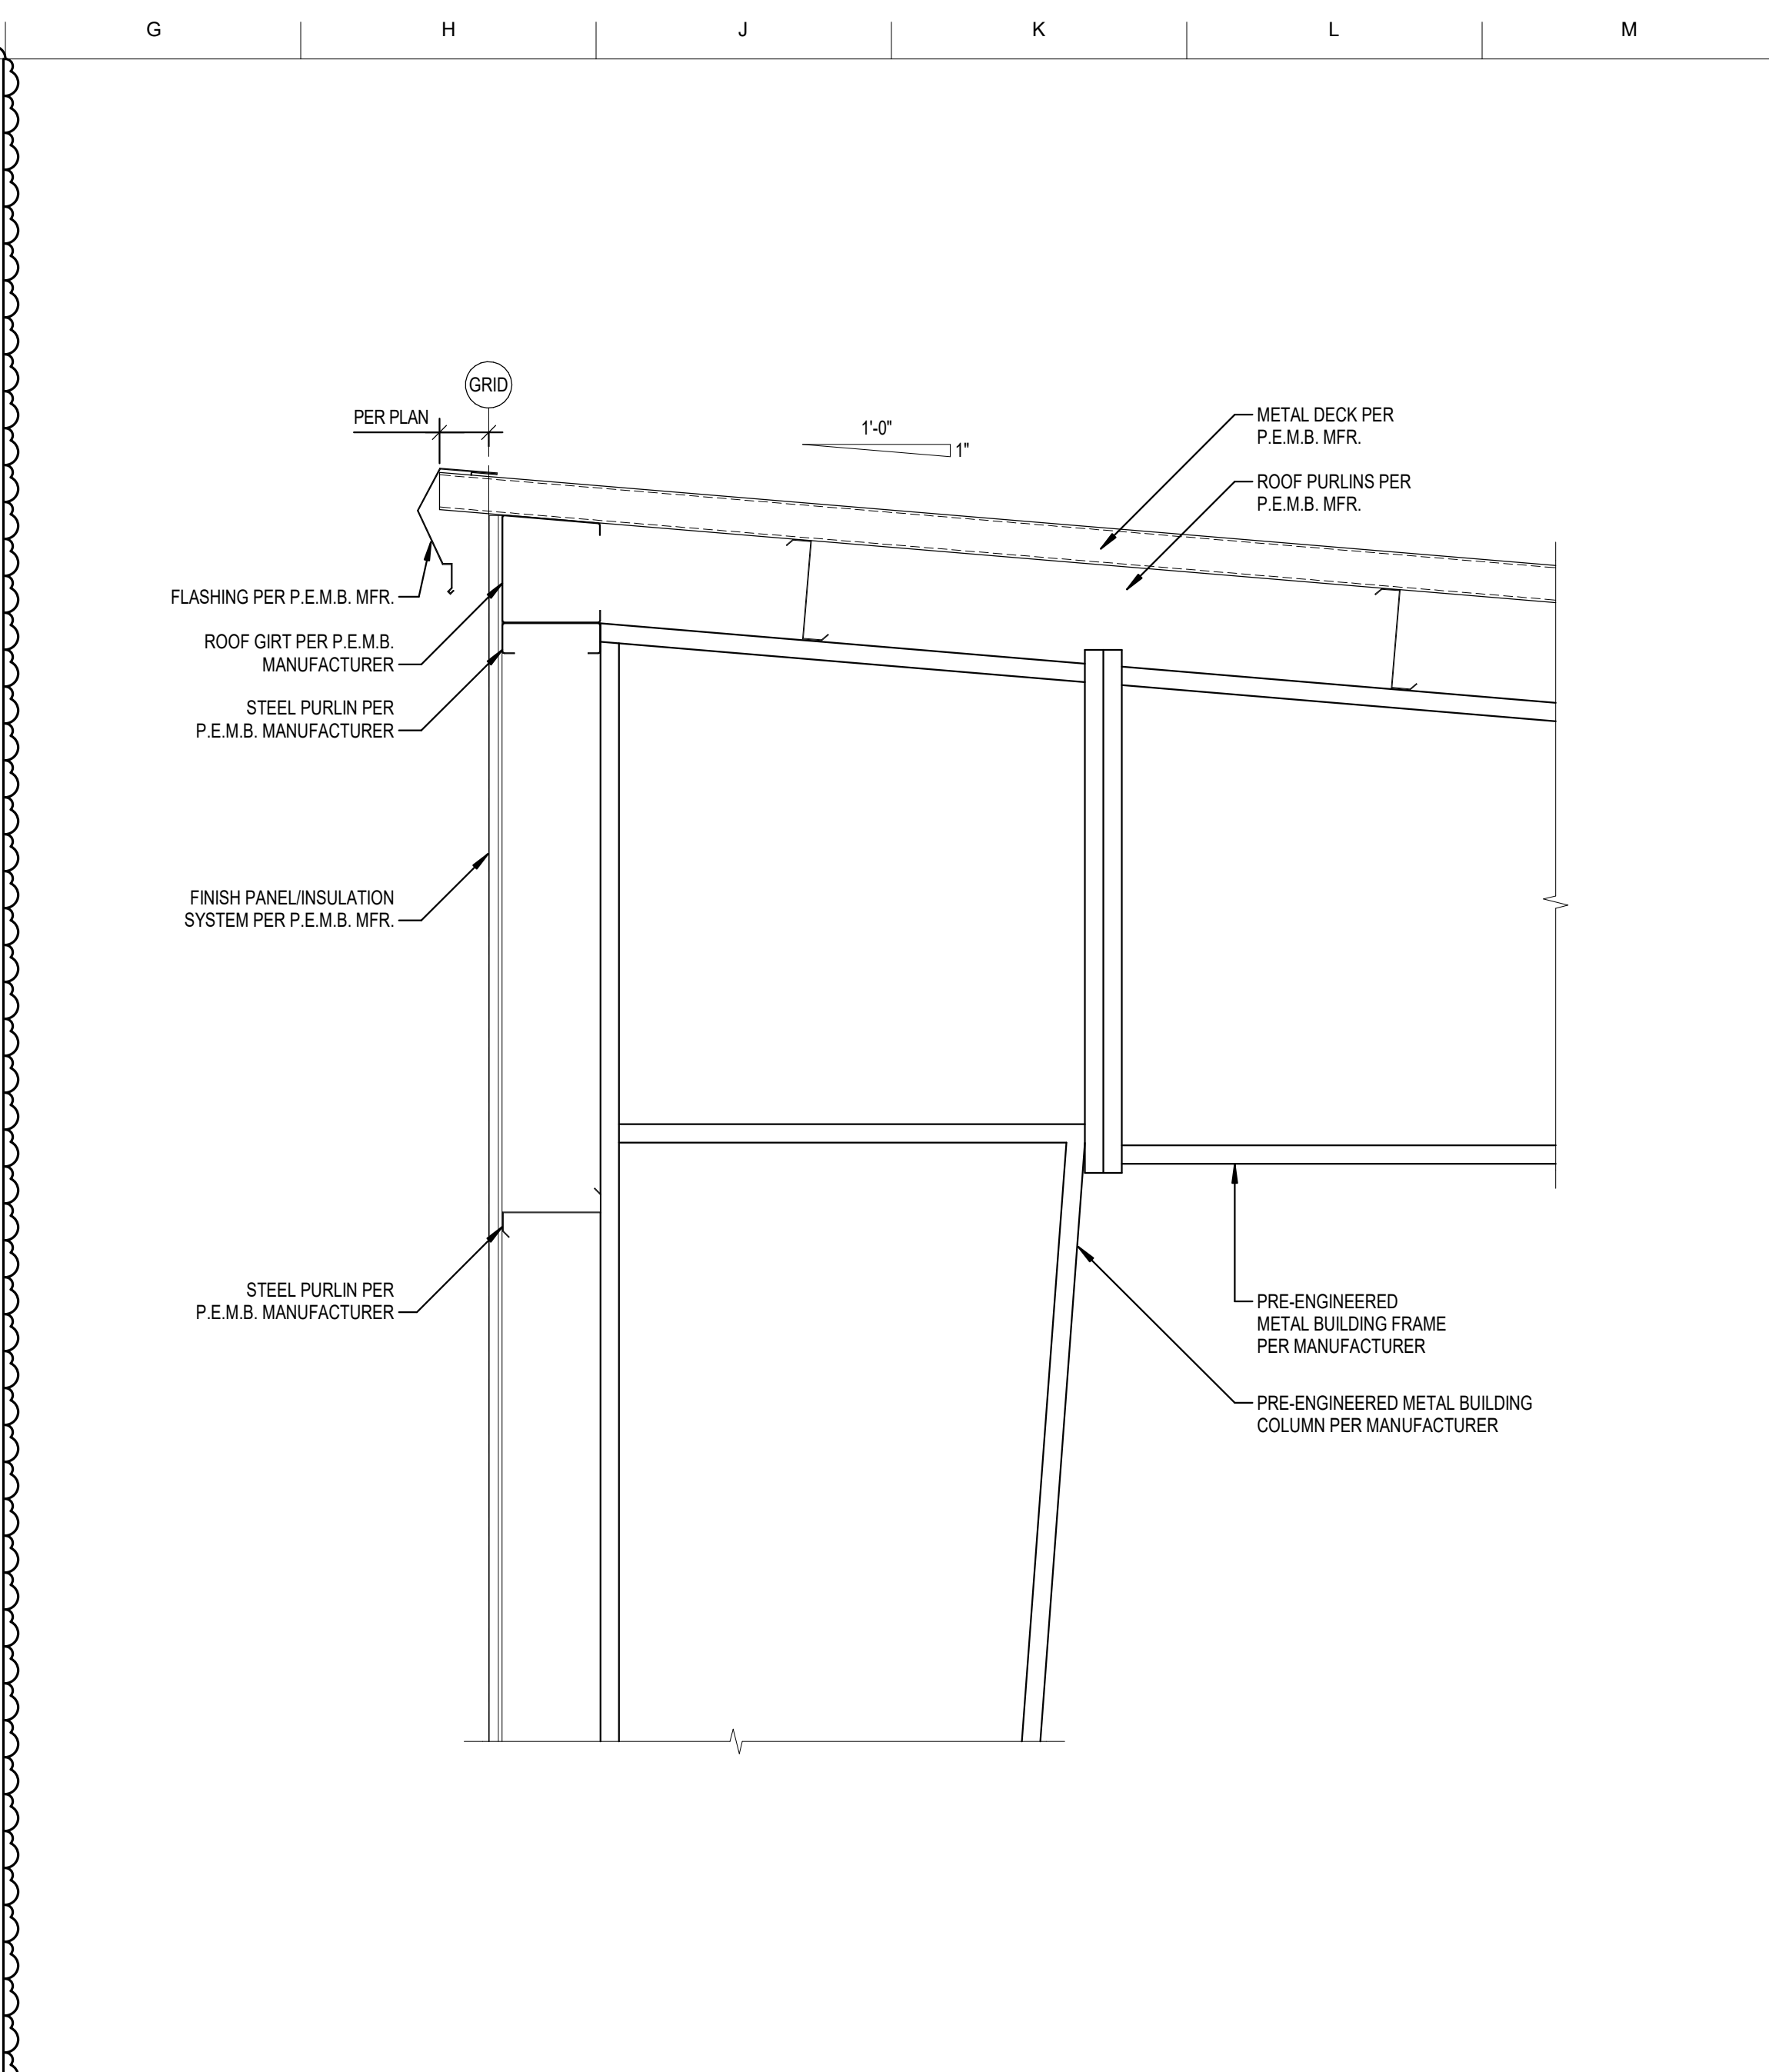


**D** PEMB FRAMING DETAIL  
Scale: 1" = 1'-0"

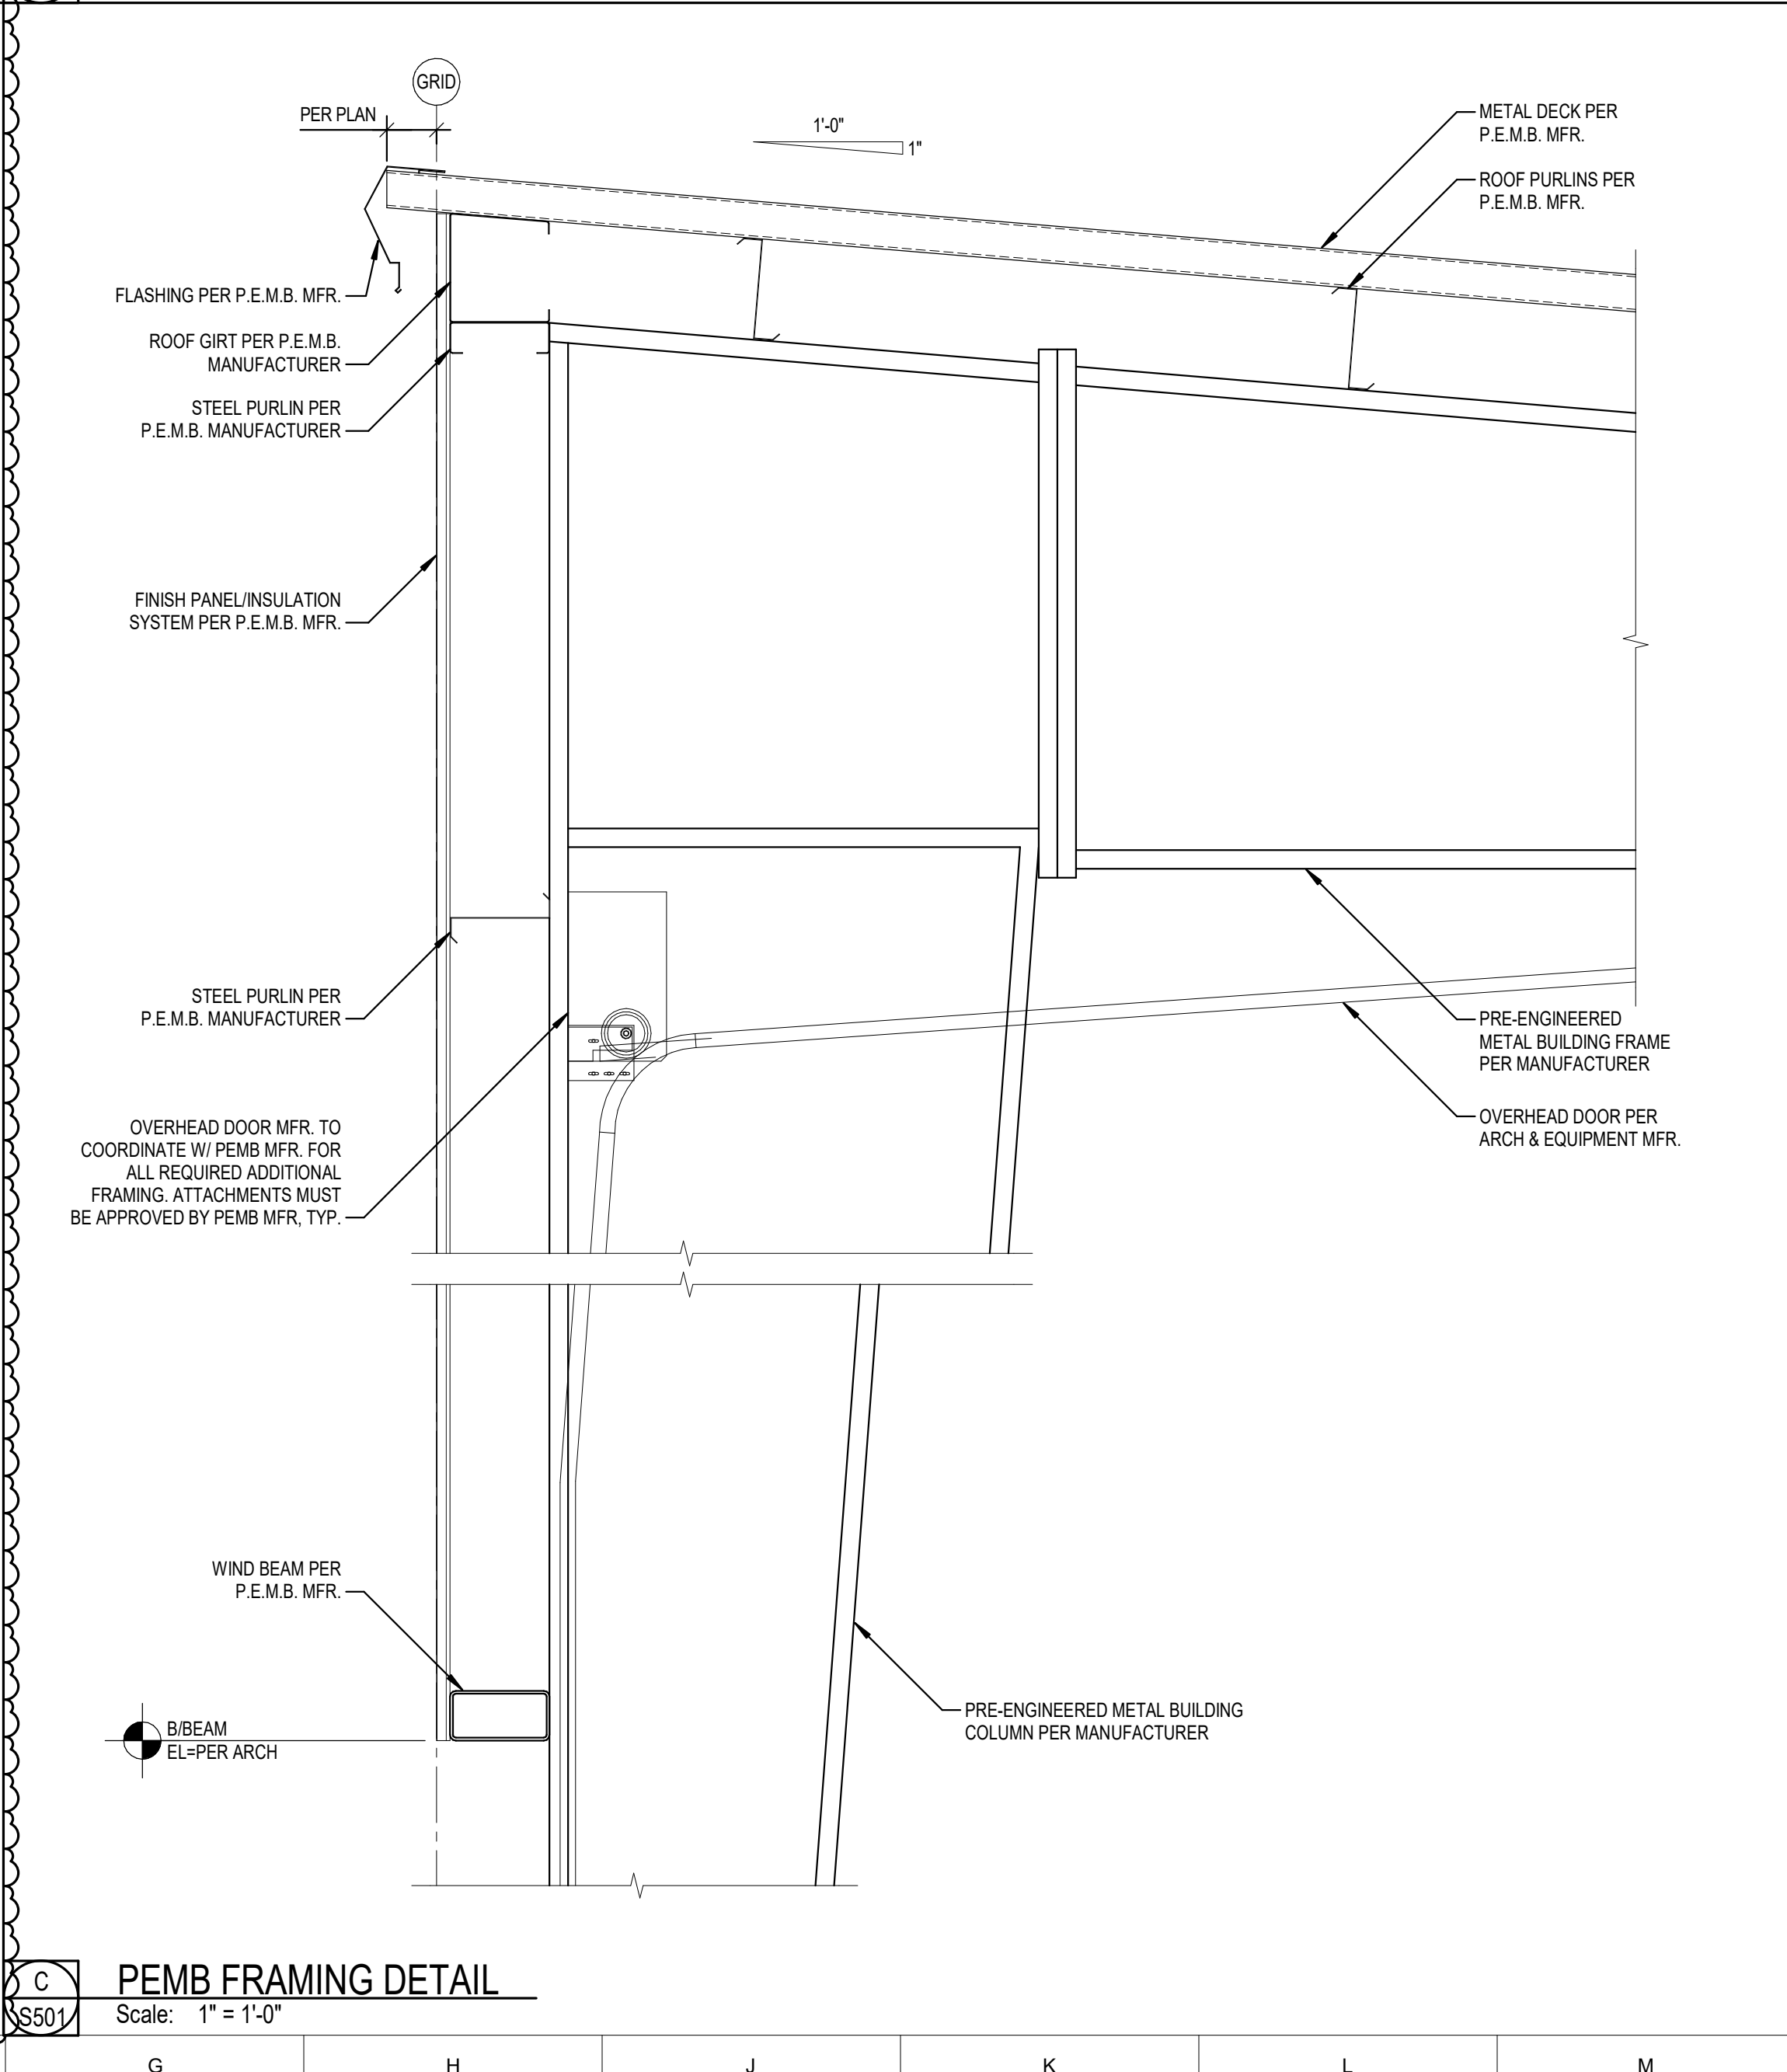

**C** PEMB FRAMING DETAIL  
Scale: 1" = 1'-0"

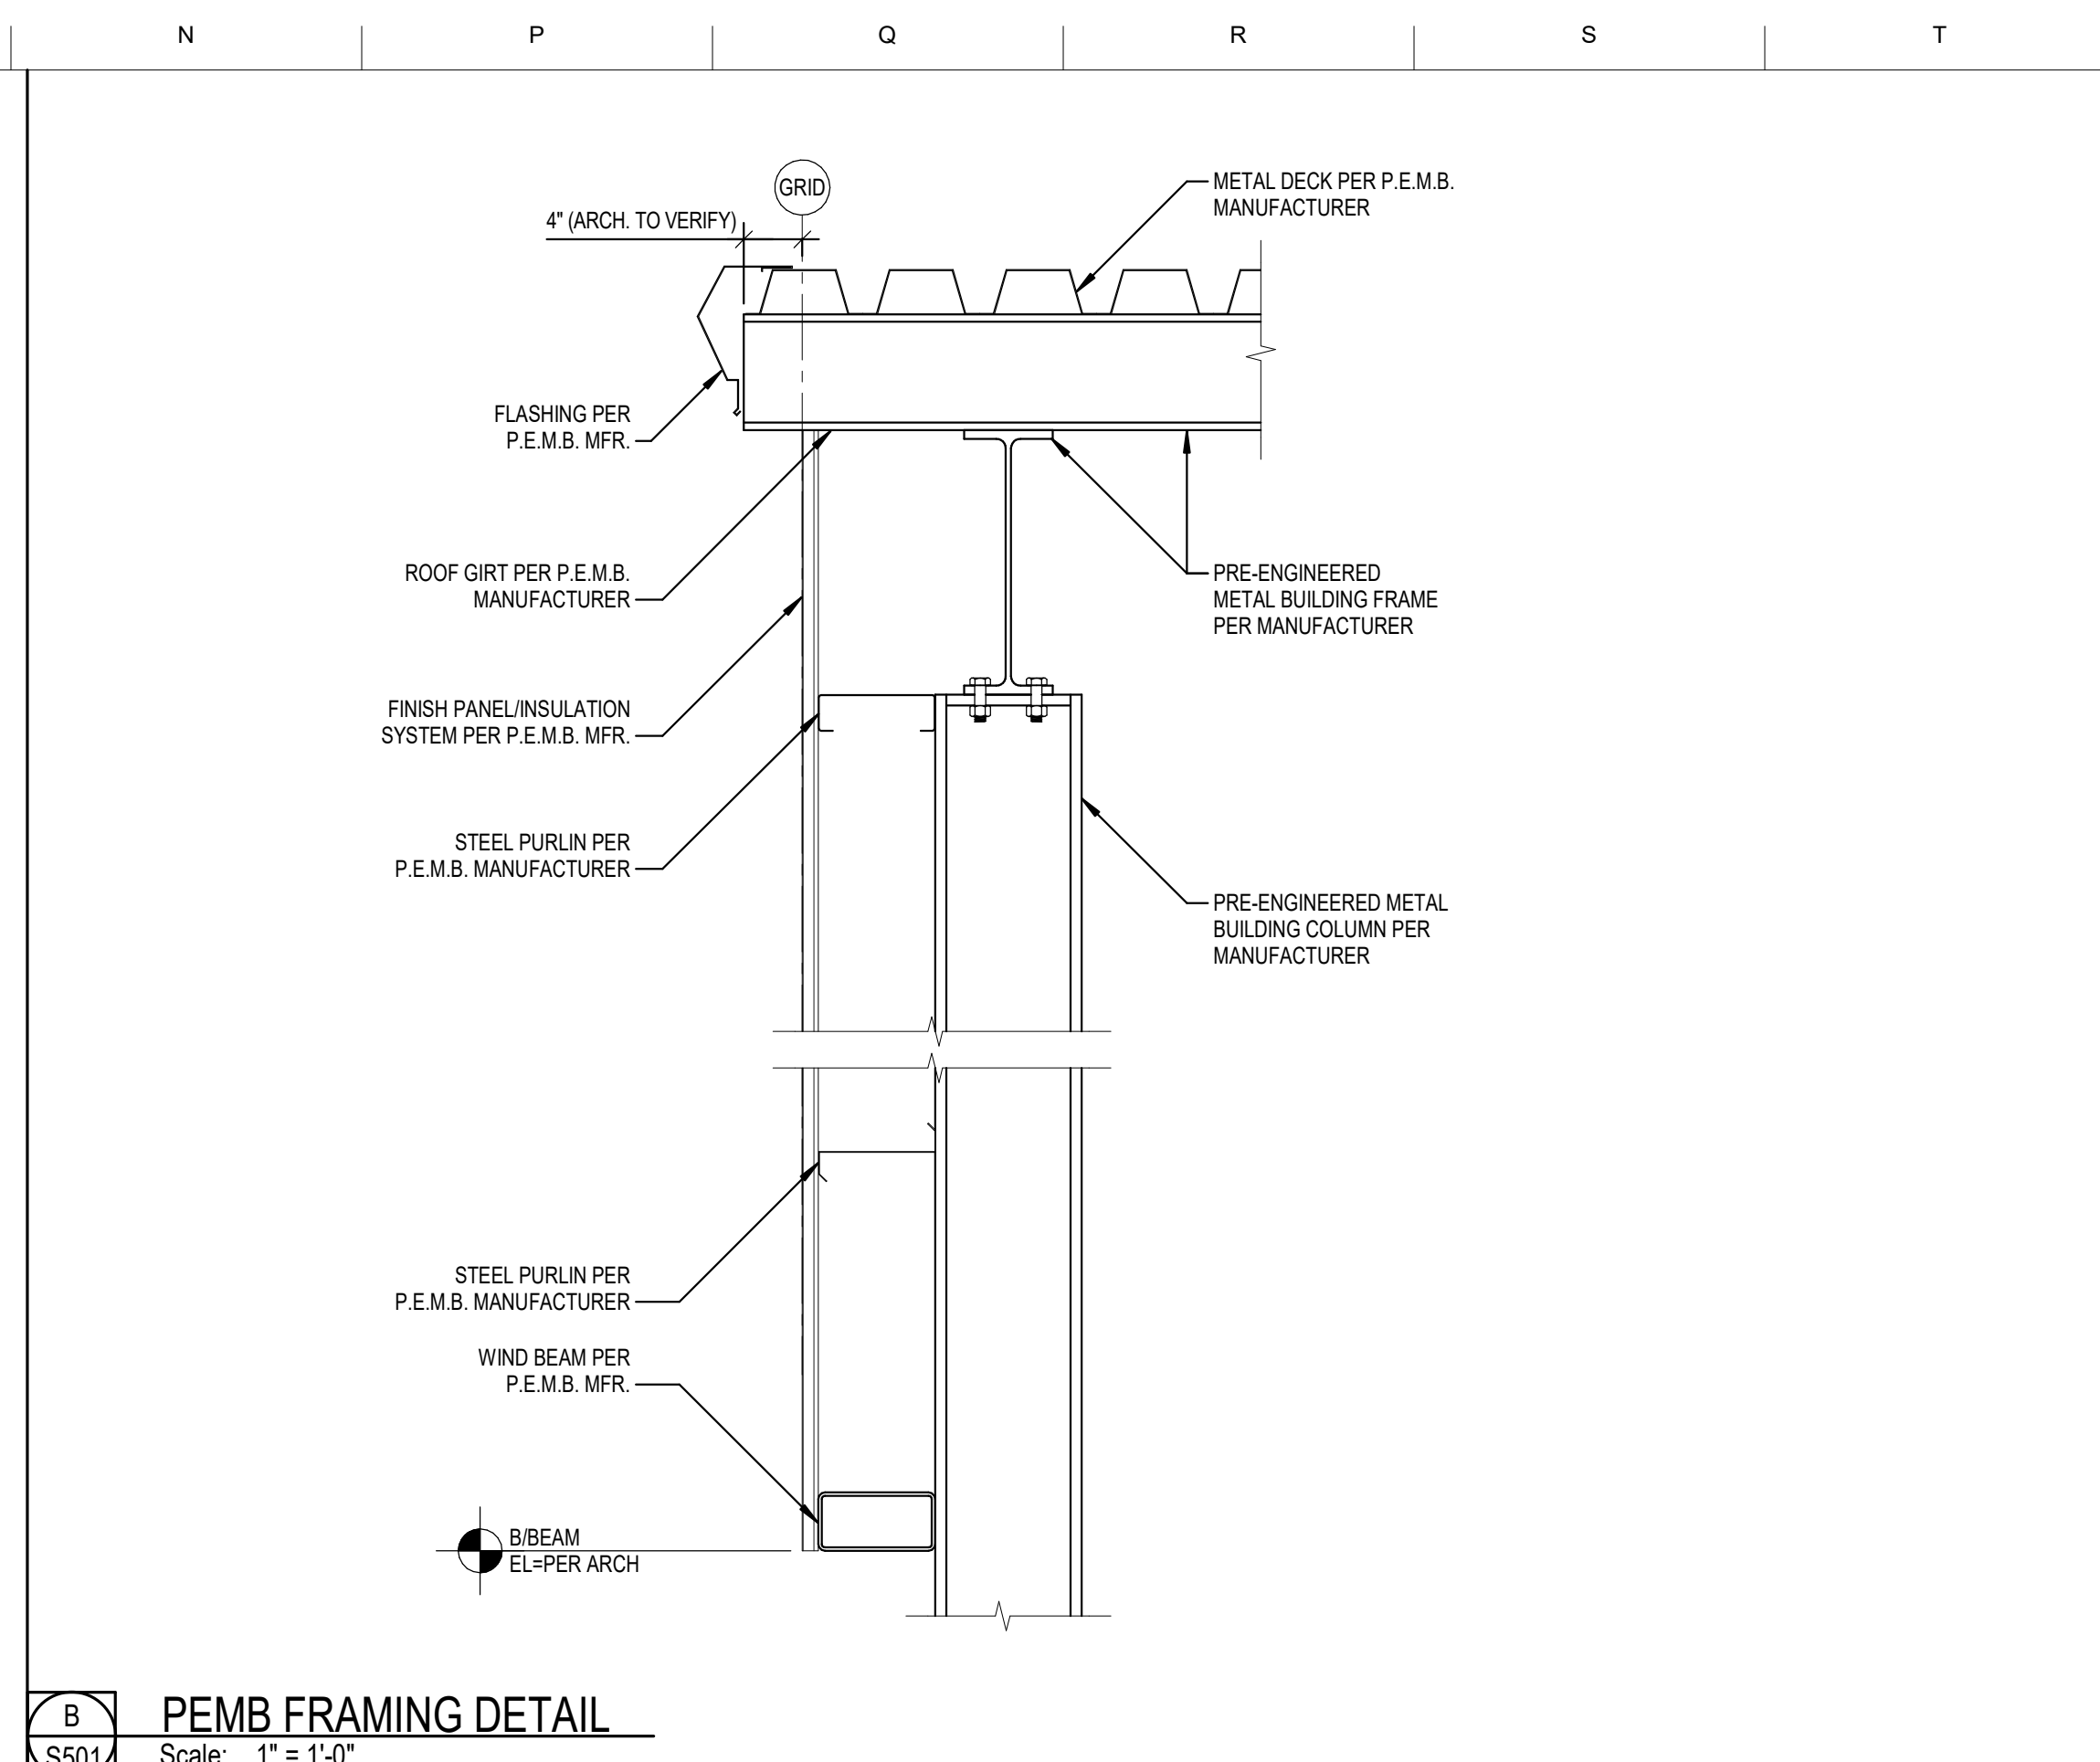

**B** PEMB FRAMING DETAIL  
Scale: 1" = 1'-0"

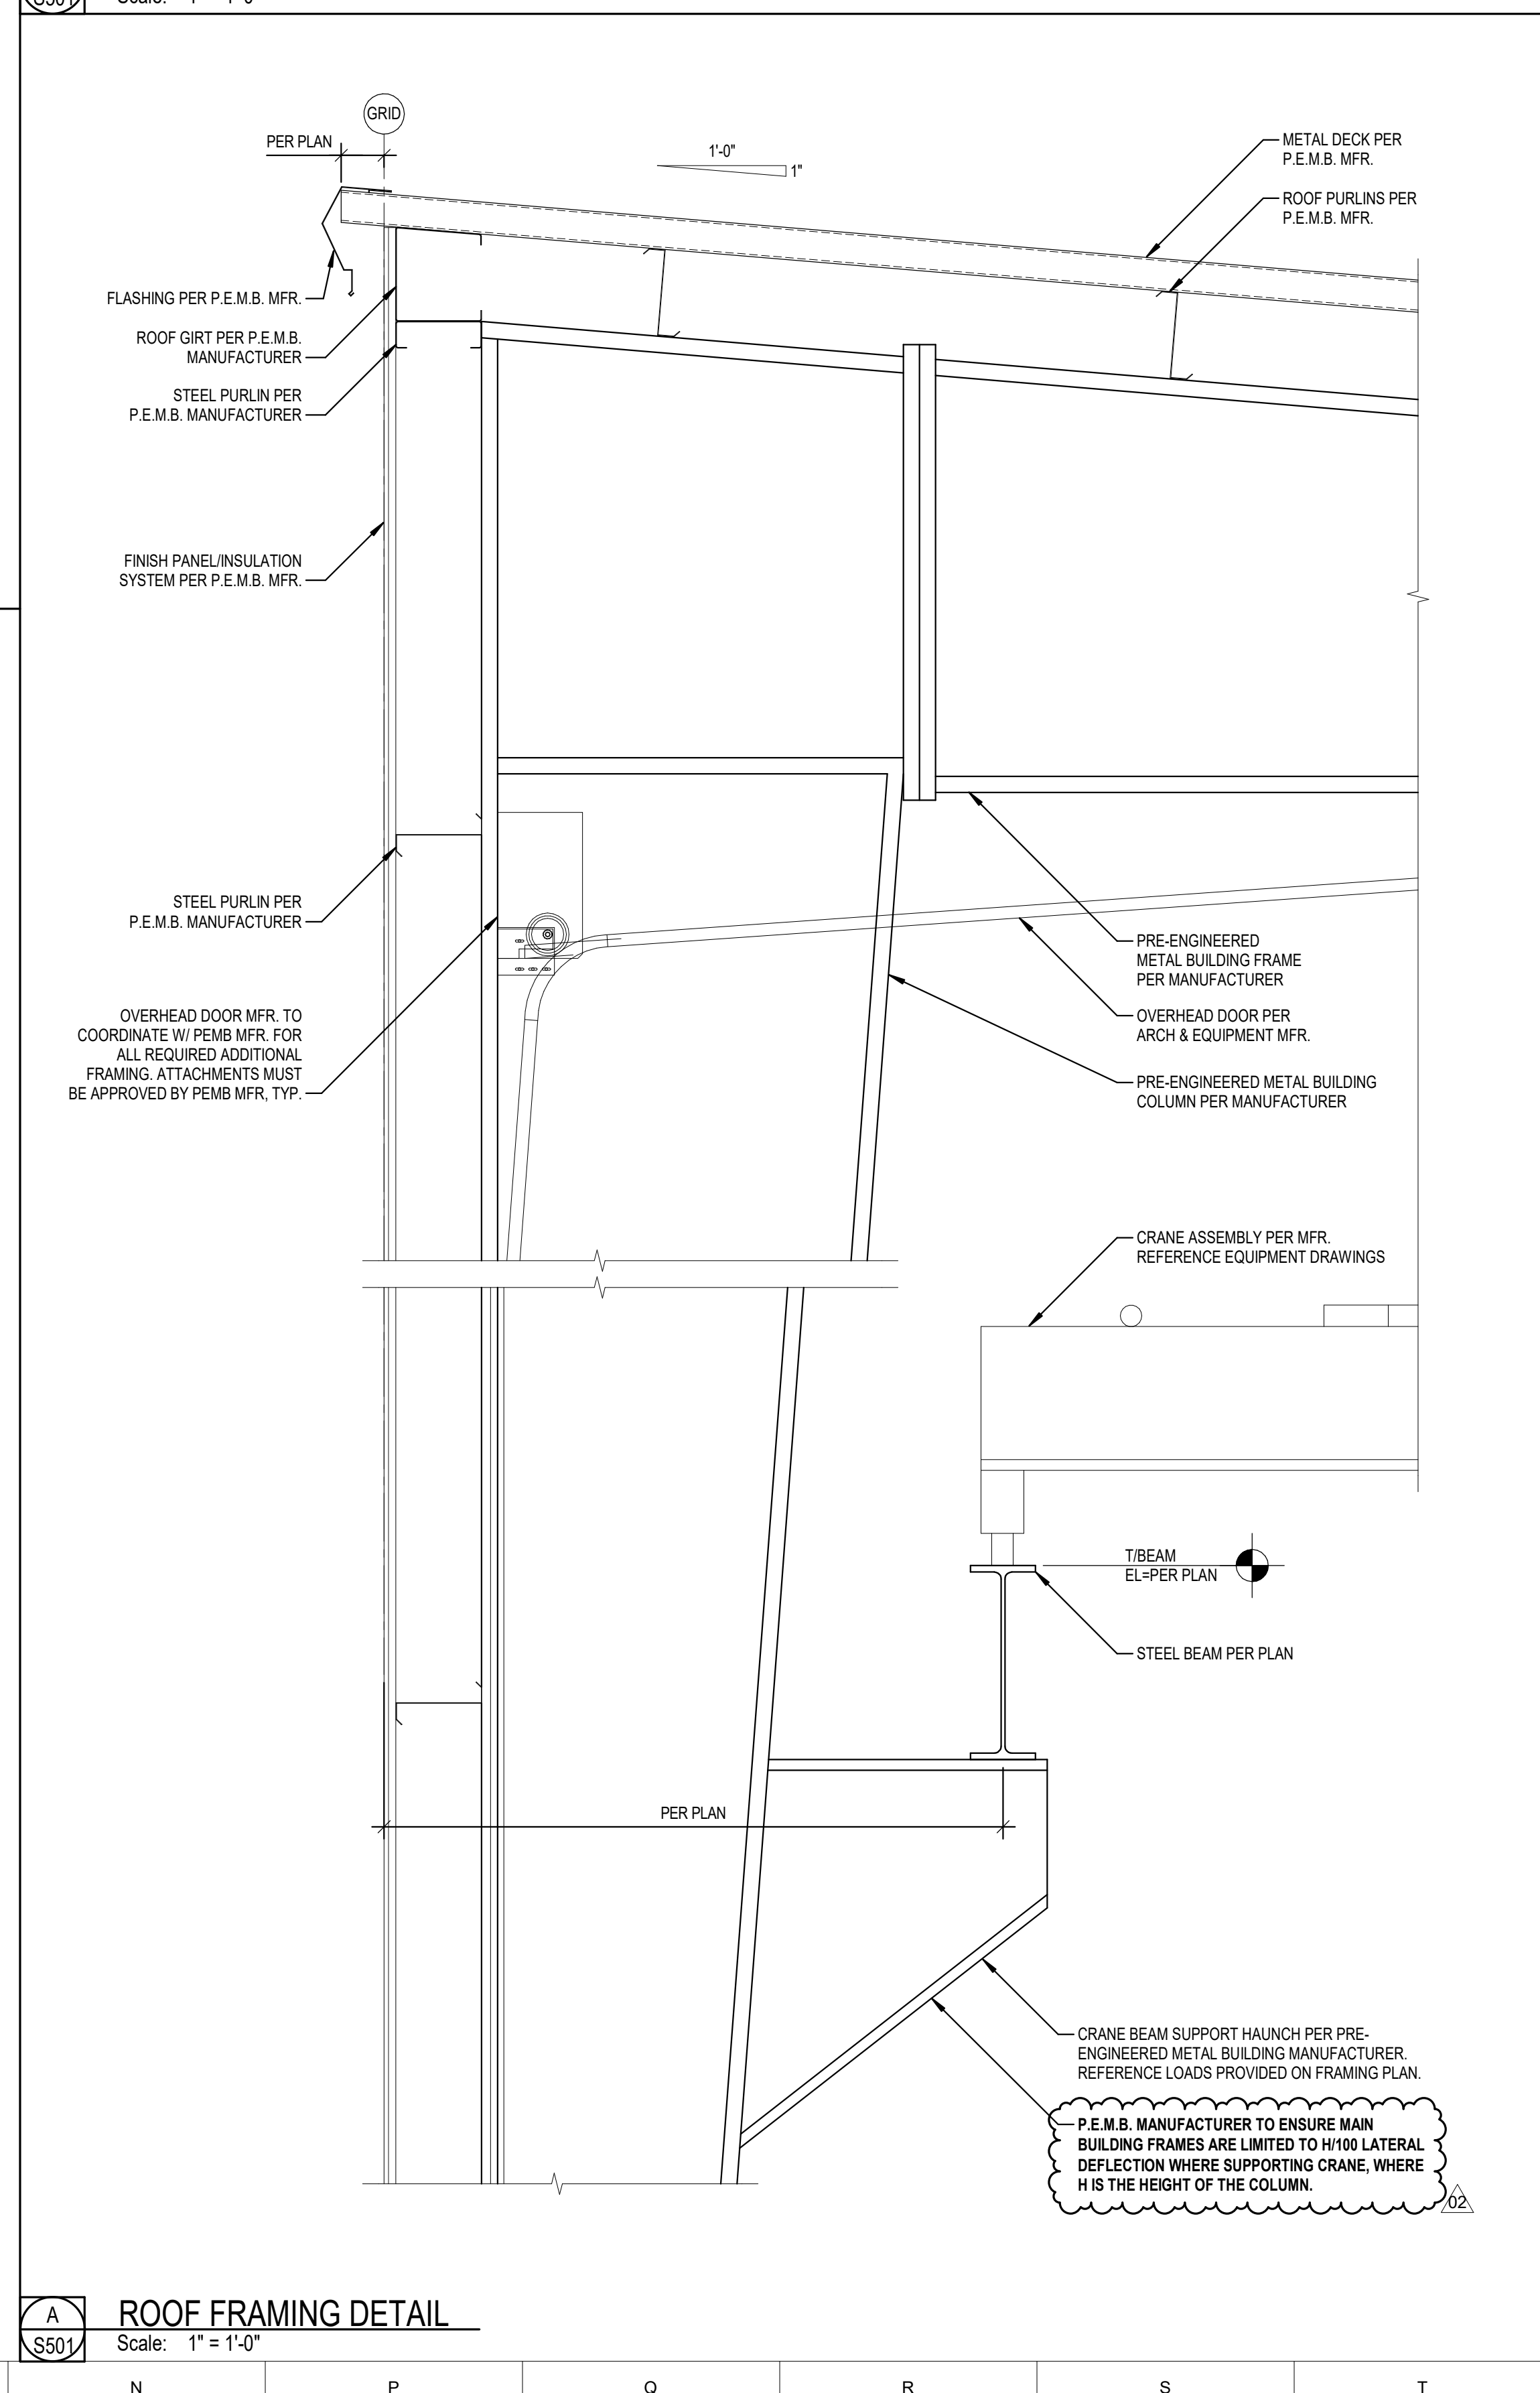

**A** ROOF FRAMING DETAIL  
Scale: 1" = 1'-0"



5039 S National Avenue | Springfield, MO 65810 | 417.887.6595

**OWNER**  
CITY OF WENTZVILLE, MISSOURI  
1001 SCHROEDER CREEK BLVD  
WENTZVILLE, MO 63385  
636.327.5101

**PROJECT TEAM**  
CIVIL ENGINEER  
PREMIER DESIGN GROUP  
100 MIDLAND PARK DRIVE  
WENTZVILLE, MO 63385  
314.925.7444  
MAINTENANCE CONSULTANT  
HDR ENGINEERING, INC.  
10450 HOLMES RD., STE. 600  
SPRINGFIELD, MO 65810  
816.360.2700  
STRUCTURAL ENGINEER  
METTEMEYER ENGINEERING  
2225 W CHESTERFIELD BLVD., SUITE 300  
SPRINGFIELD, MO 65807  
417.890.8002  
MEP ENGINEER  
HENDERSON ENGINEERING, INC.  
8345 LENEXA DR., #300  
LENEXA, KS 66214  
417.555.5555

NO.	DESCRIPTION	DATE
02	ADD 02	01/25/23

PROJECT NO.: 20-0067 DRAWN BY: MRH, TNB  
DATE: 12.15.22 REVIEWED BY: BSW

**PROFESSIONAL SEAL**  
ALAN METTEMEYER, PE  
PROFESSIONAL TITLE: ENGINEER  
MO# E-2000162147



© 2021 H DESIGN GROUP, LLC  
THIS DRAWING AND THE ARCHITECTURAL WORK REPRESENTED ARE OWNED BY H DESIGN GROUP, LLC. COPYRIGHT INCLUDES THE DRAWING, AS WELL AS ALL COMPONENTS OF THE CONCEPTUAL DESIGN. REPRODUCTION OF ANY KIND IS STRICTLY PROHIBITED WITHOUT THE EXPRESSED WRITTEN CONSENT OF H DESIGN GROUP, LLC.

**PROJECT TITLE**  
CITY OF WENTZVILLE, MO PUBLIC WORKS FACILITY

**PROJECT ADDRESS**  
1296 INTERSTATE DRIVE  
WENTZVILLE, MO 63385

**FRAMING DETAILS**

**SHEET**  
**S501**



## PROJECT TEAM

MEP ENGINEER  
HENDERSON ENGINEERING, INC.  
8345 LENEXA DR., #300  
LENEXA, KS 66214  
417.555.5555

Scale: 1" = 1'-0"

Scale: 1" = 1'-0"

PROJECT NO.: 20-0067 DRAWN BY: MRH, TNB  
DATE: 12.15.22 REVIEWED BY: BSW

PROJECT ADDRESS:  
1295 INTERSTATE DRIVE  
WENTZVILLE, MO 63385

## FRAMING DETAILS

SHEET  
S502


**OWNER**  
**CITY OF WENTZVILLE, MISSOURI**  
1001 SCHROEDER CREEK BLVD  
WENTZVILLE, MO 63385  
636.327.5101

**PROJECT TEAM**  
CIVIL ENGINEER  
PREMIER DESIGN GROUP  
100 MIDLAND PARK DRIVE  
WENTZVILLE, MO 63385  
314.925.7444


MAINTENANCE CONSULTANT  
HDR ENGINEERING, INC.  
10450 HOLMES RD., STE 600  
SPRINGFIELD, MO 65810  
816.360.2700

STRUCTURAL ENGINEER  
METTEMAYER ENGINEERING  
2225 W CHESTERFIELD BLVD., SUITE 300  
SPRINGFIELD, MO 65807  
417.890.8002


MEP ENGINEER  
HENDERSON ENGINEERING, INC.  
8345 LENEXA DR., #300  
LENEXA, KS 66214  
417.555.5555

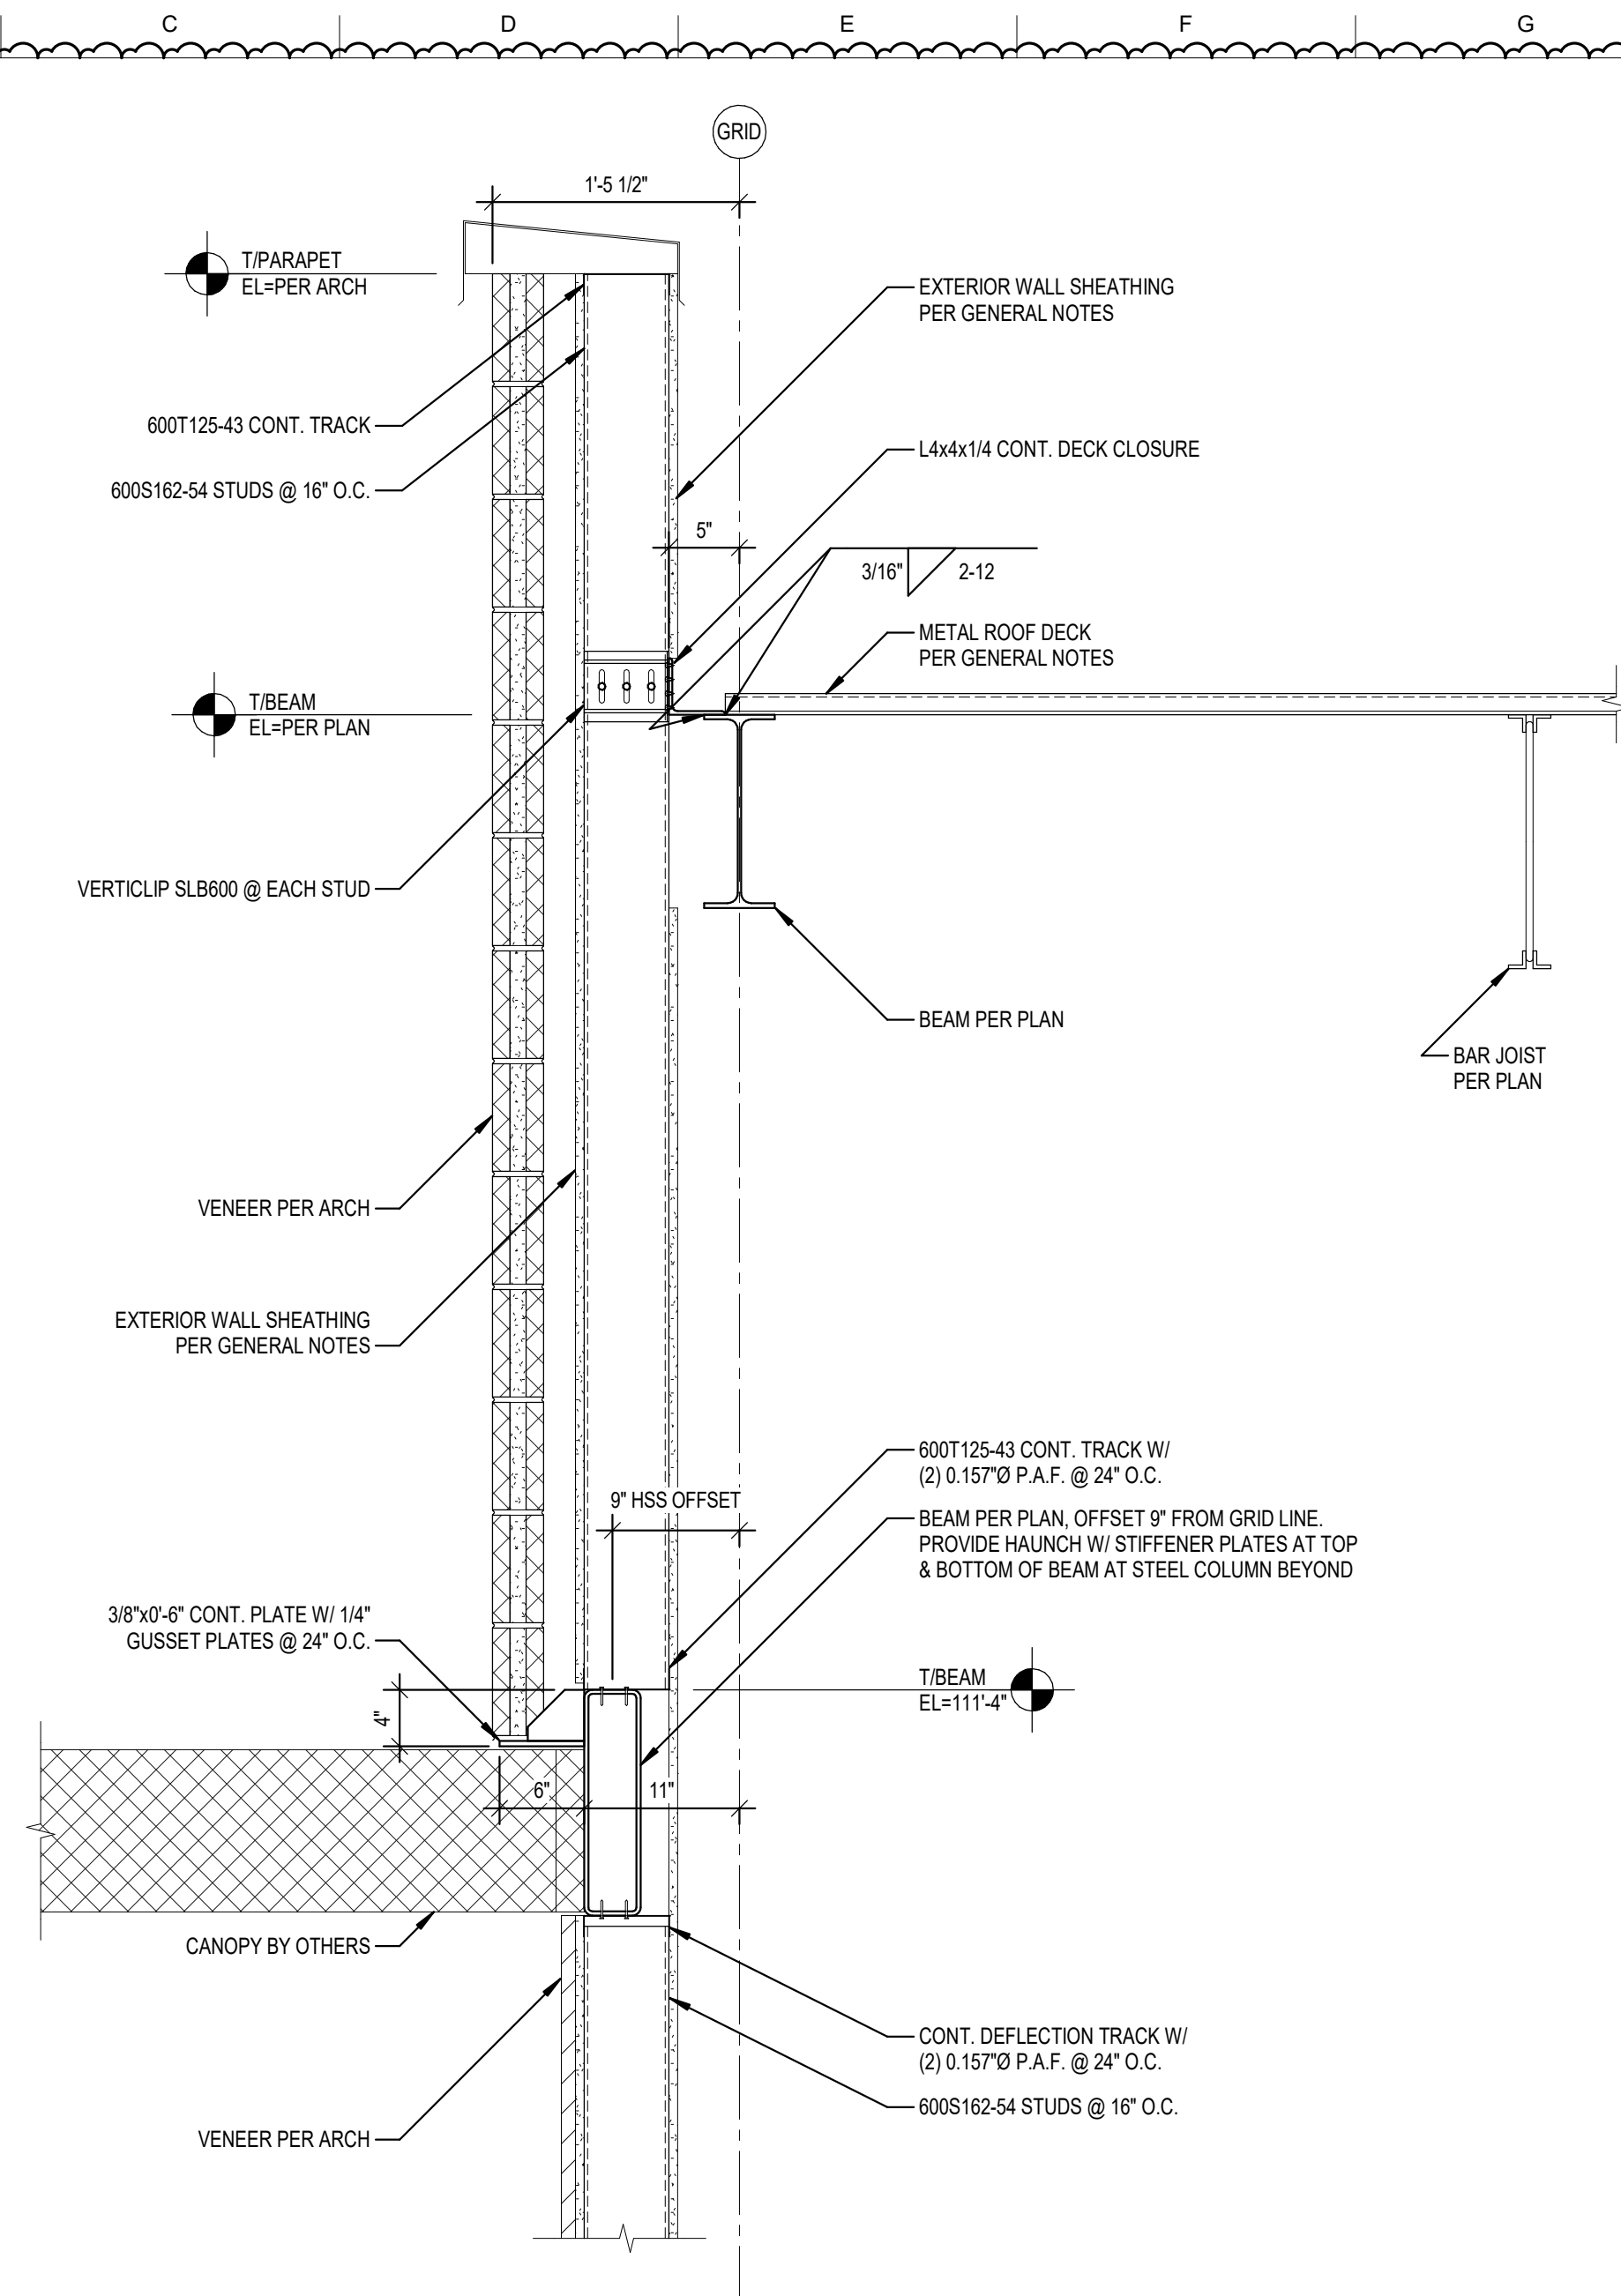


**H**  
**ROOF FRAMING DETAIL**  
Scale: 1" = 1'-0"

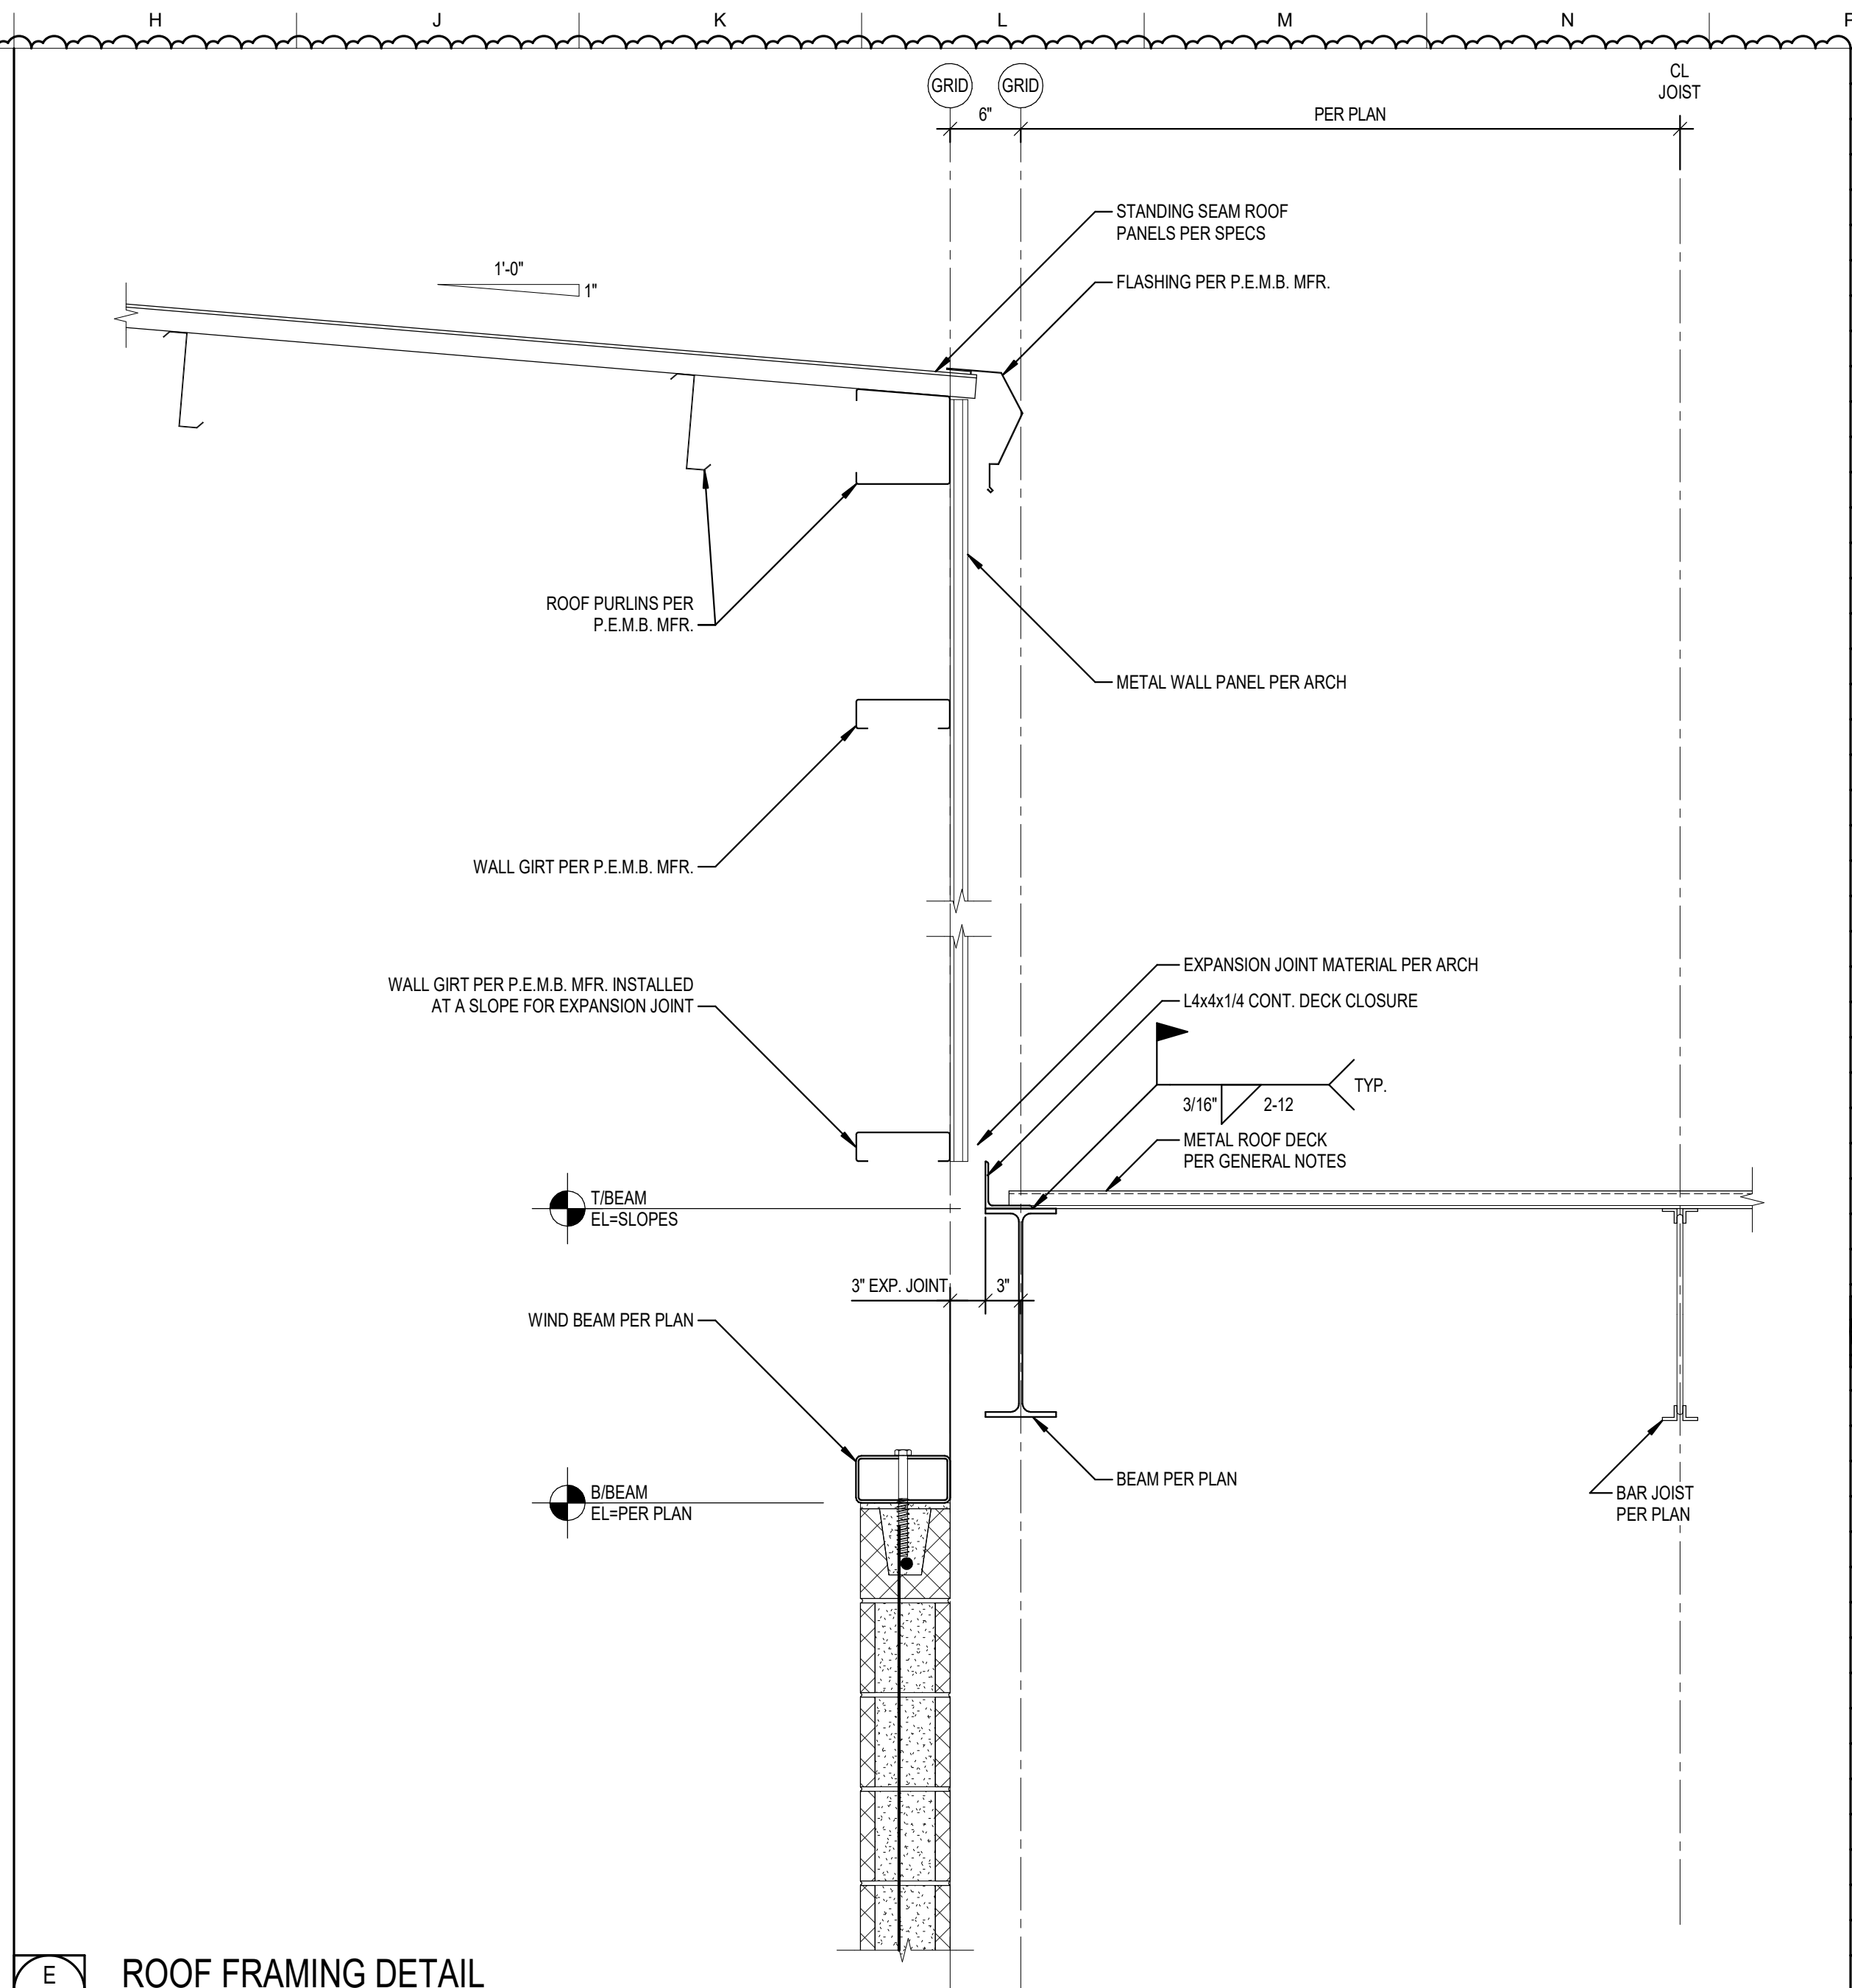


**E**  
**ROOF FRAMING DETAIL**  
Scale: 1" = 1'-0"

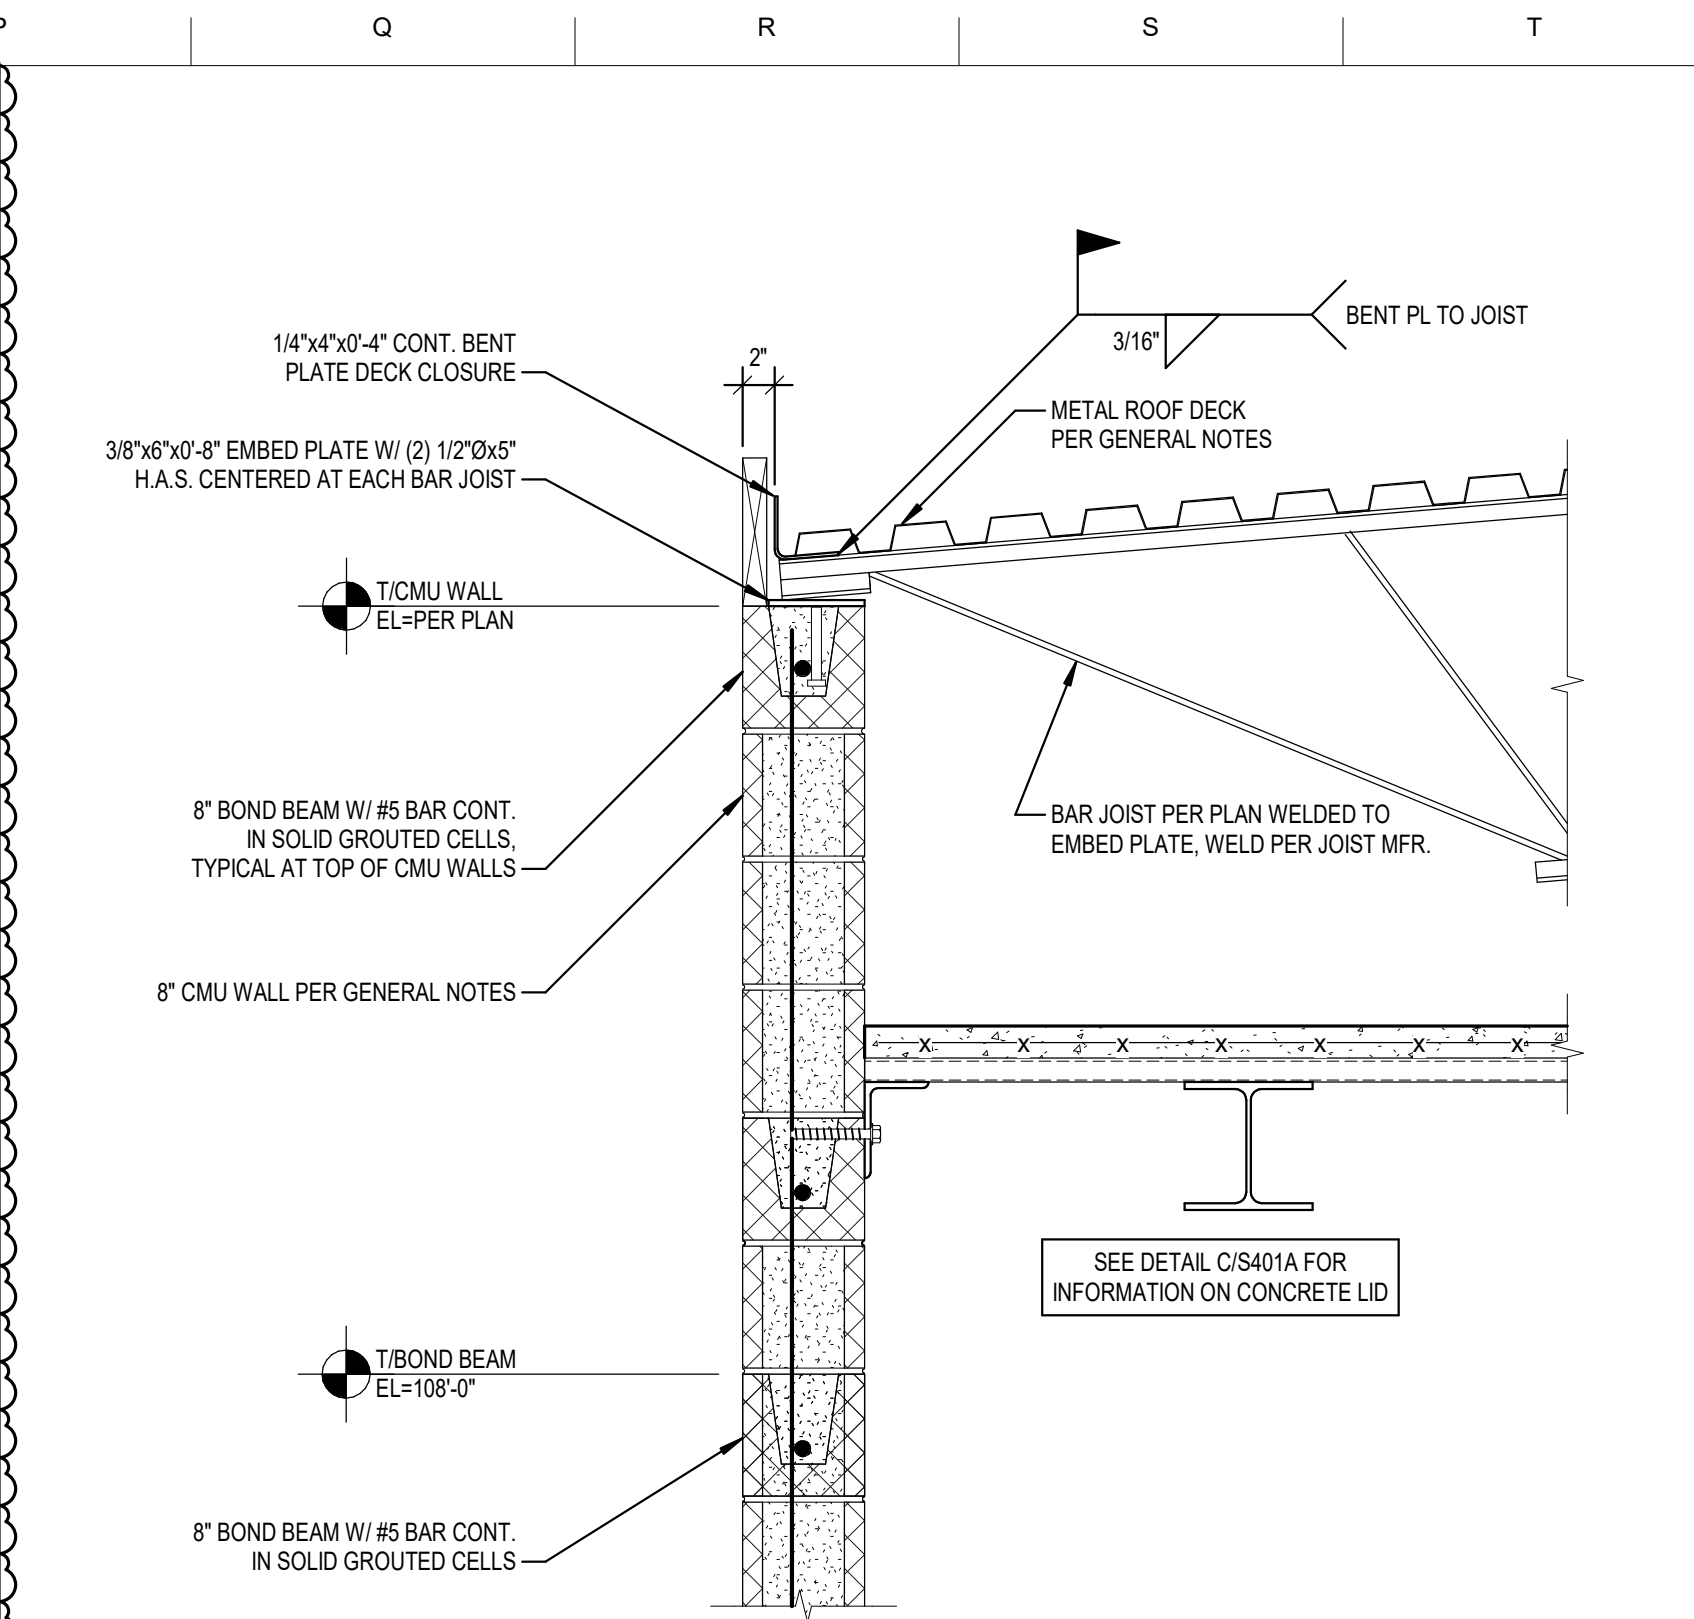


**C**  
**ROOF FRAMING DETAIL**  
Scale: 1" = 1'-0"

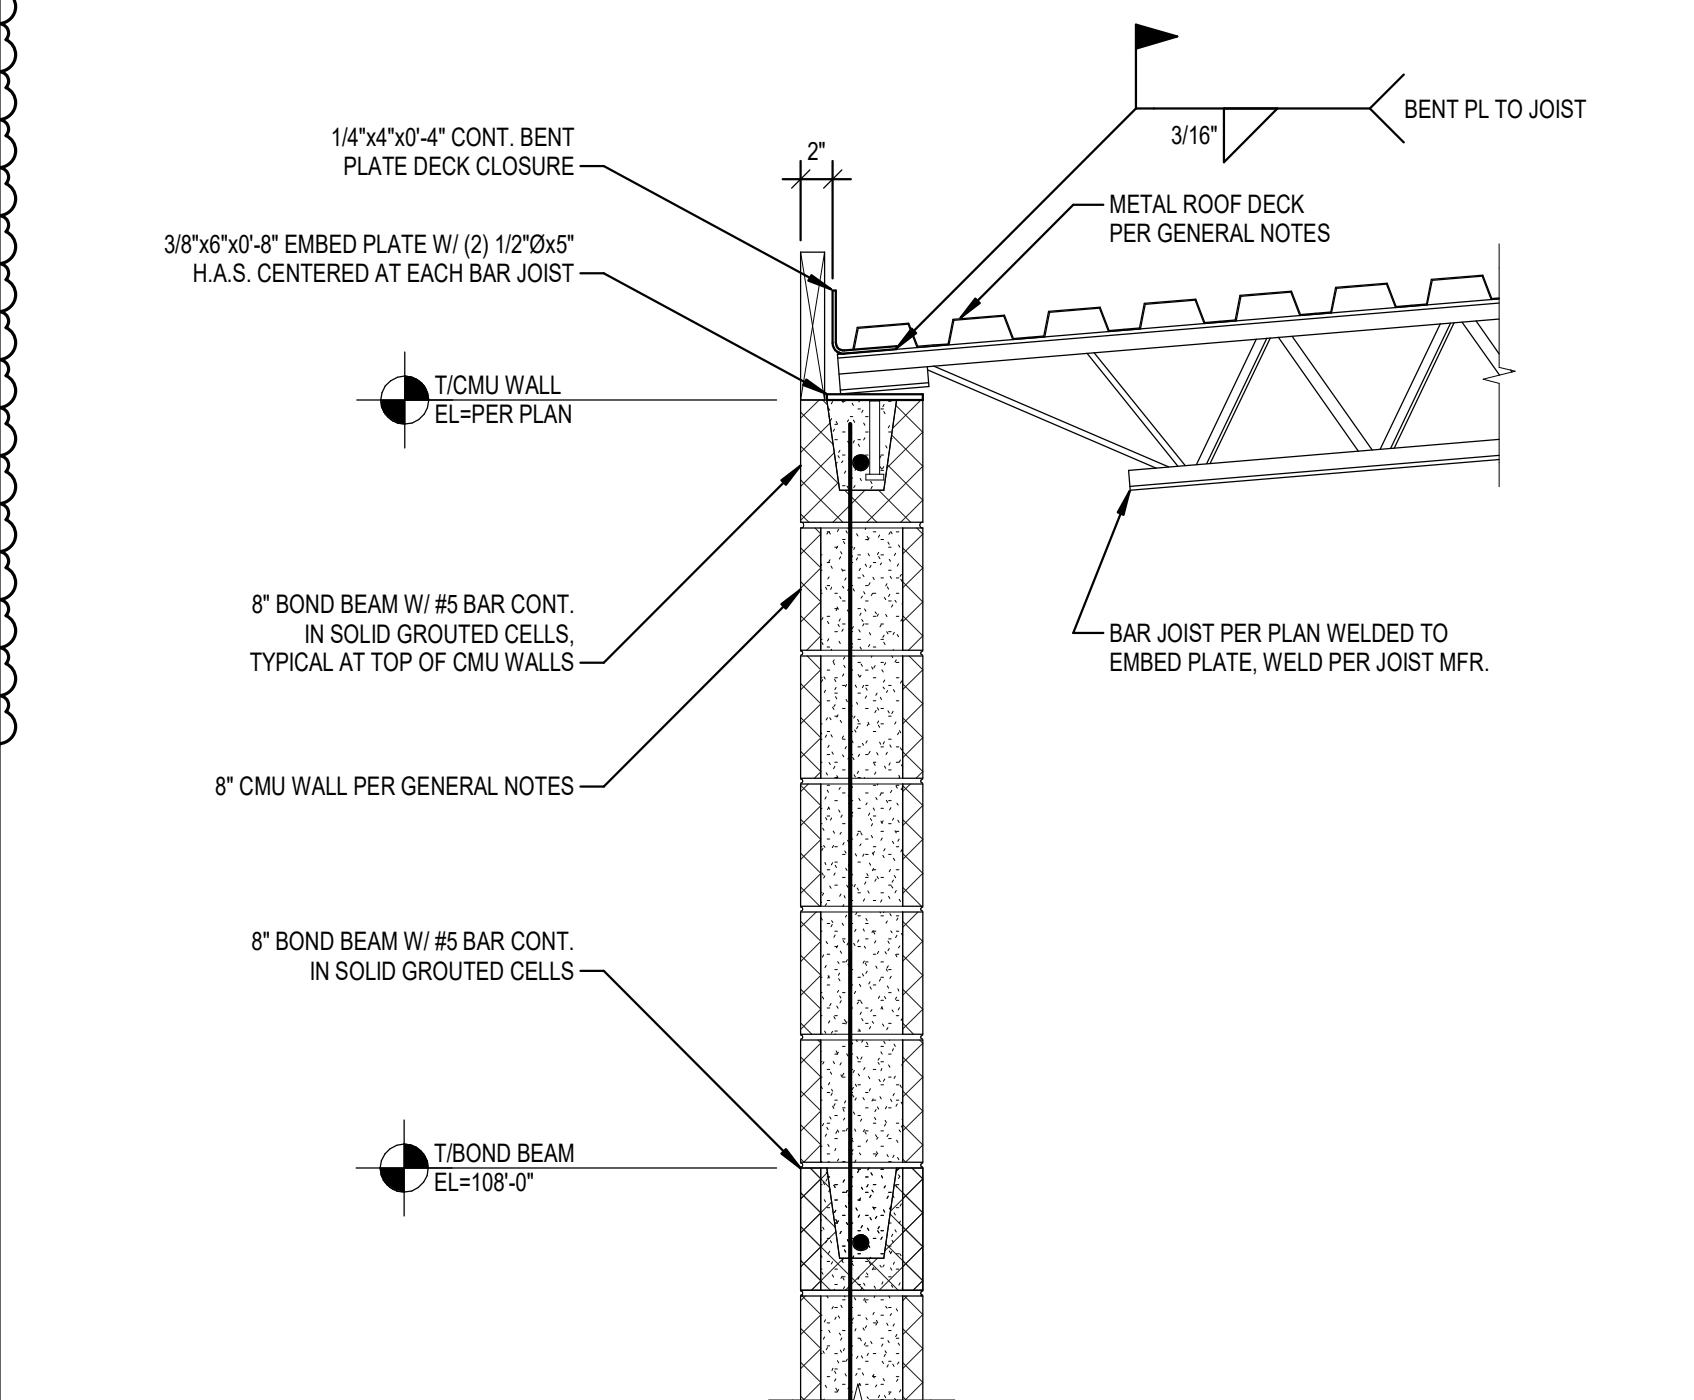


**B**  
**ROOF FRAMING DETAIL**  
Scale: 1" = 1'-0"

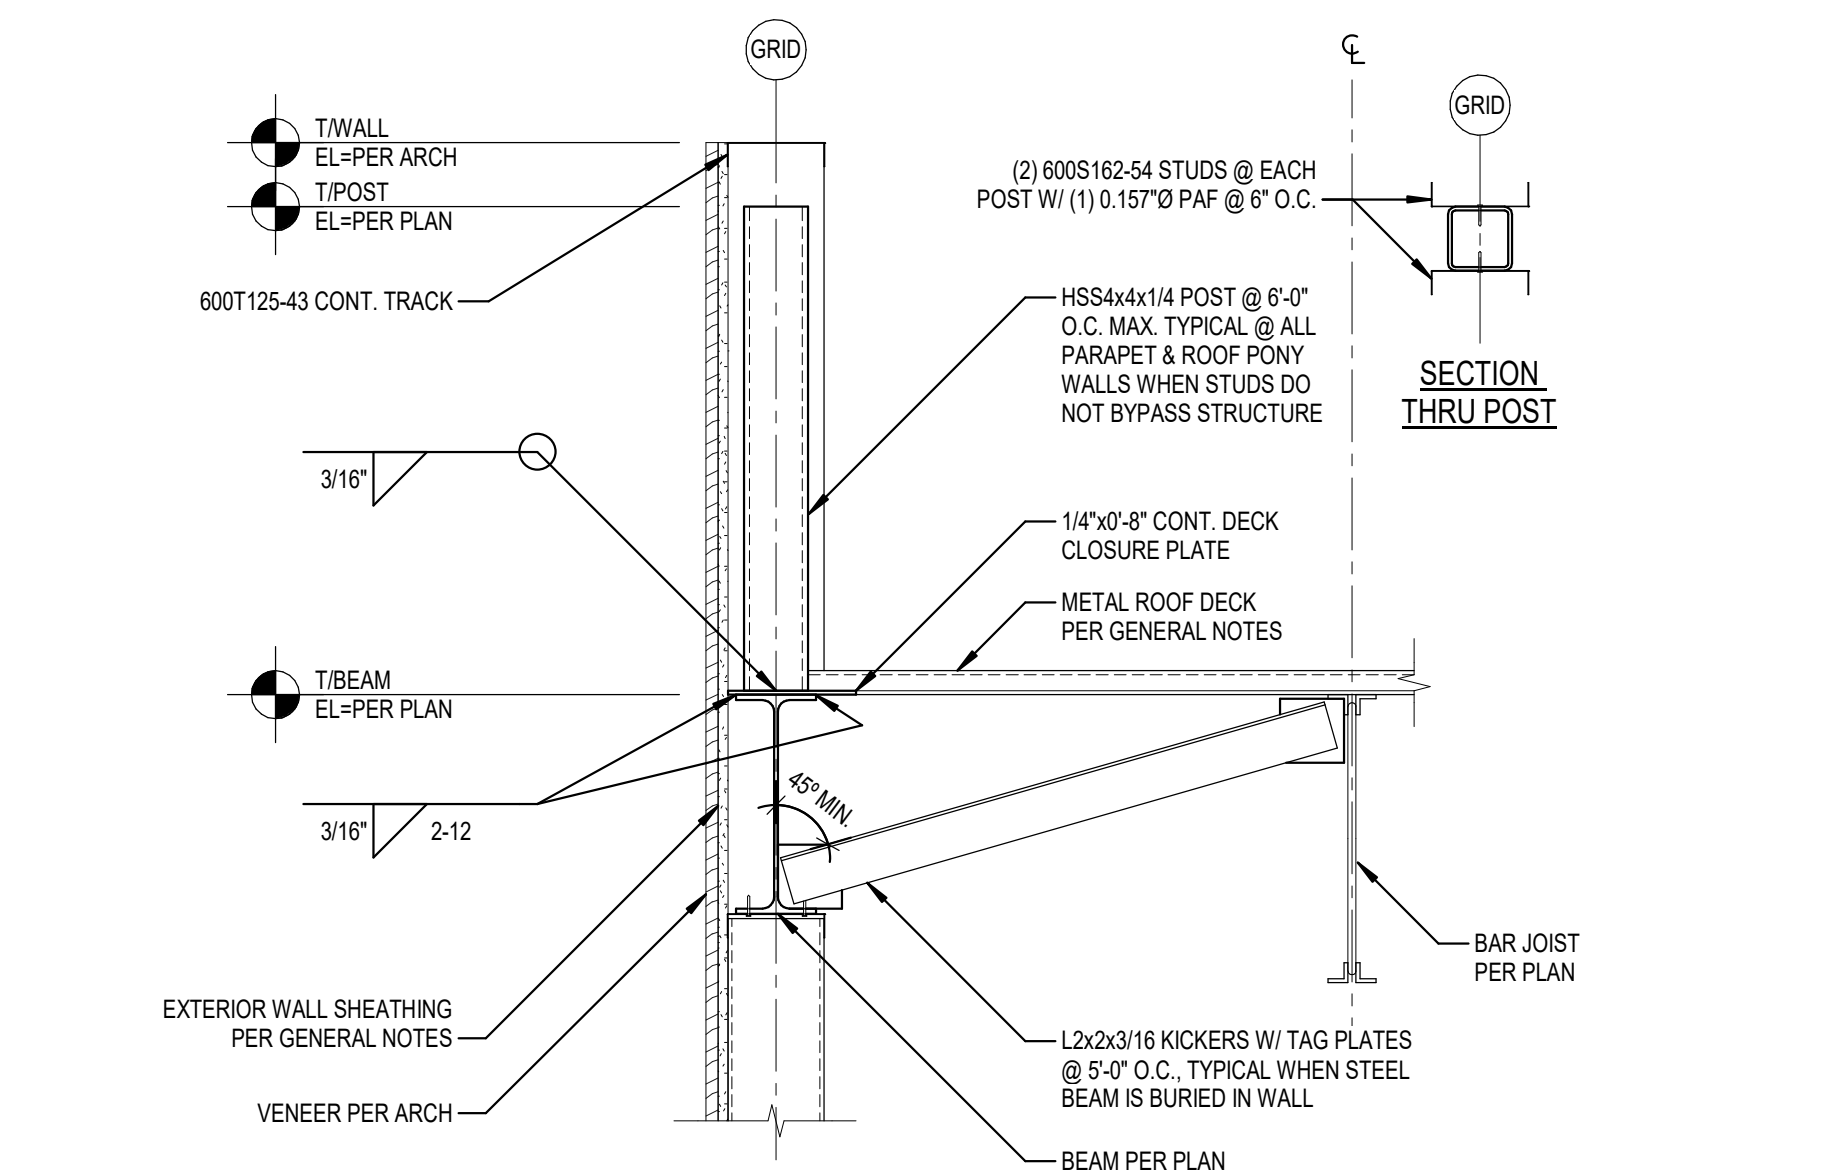


**G**  
**ROOF FRAMING DETAIL**  
Scale: 1" = 1'-0"

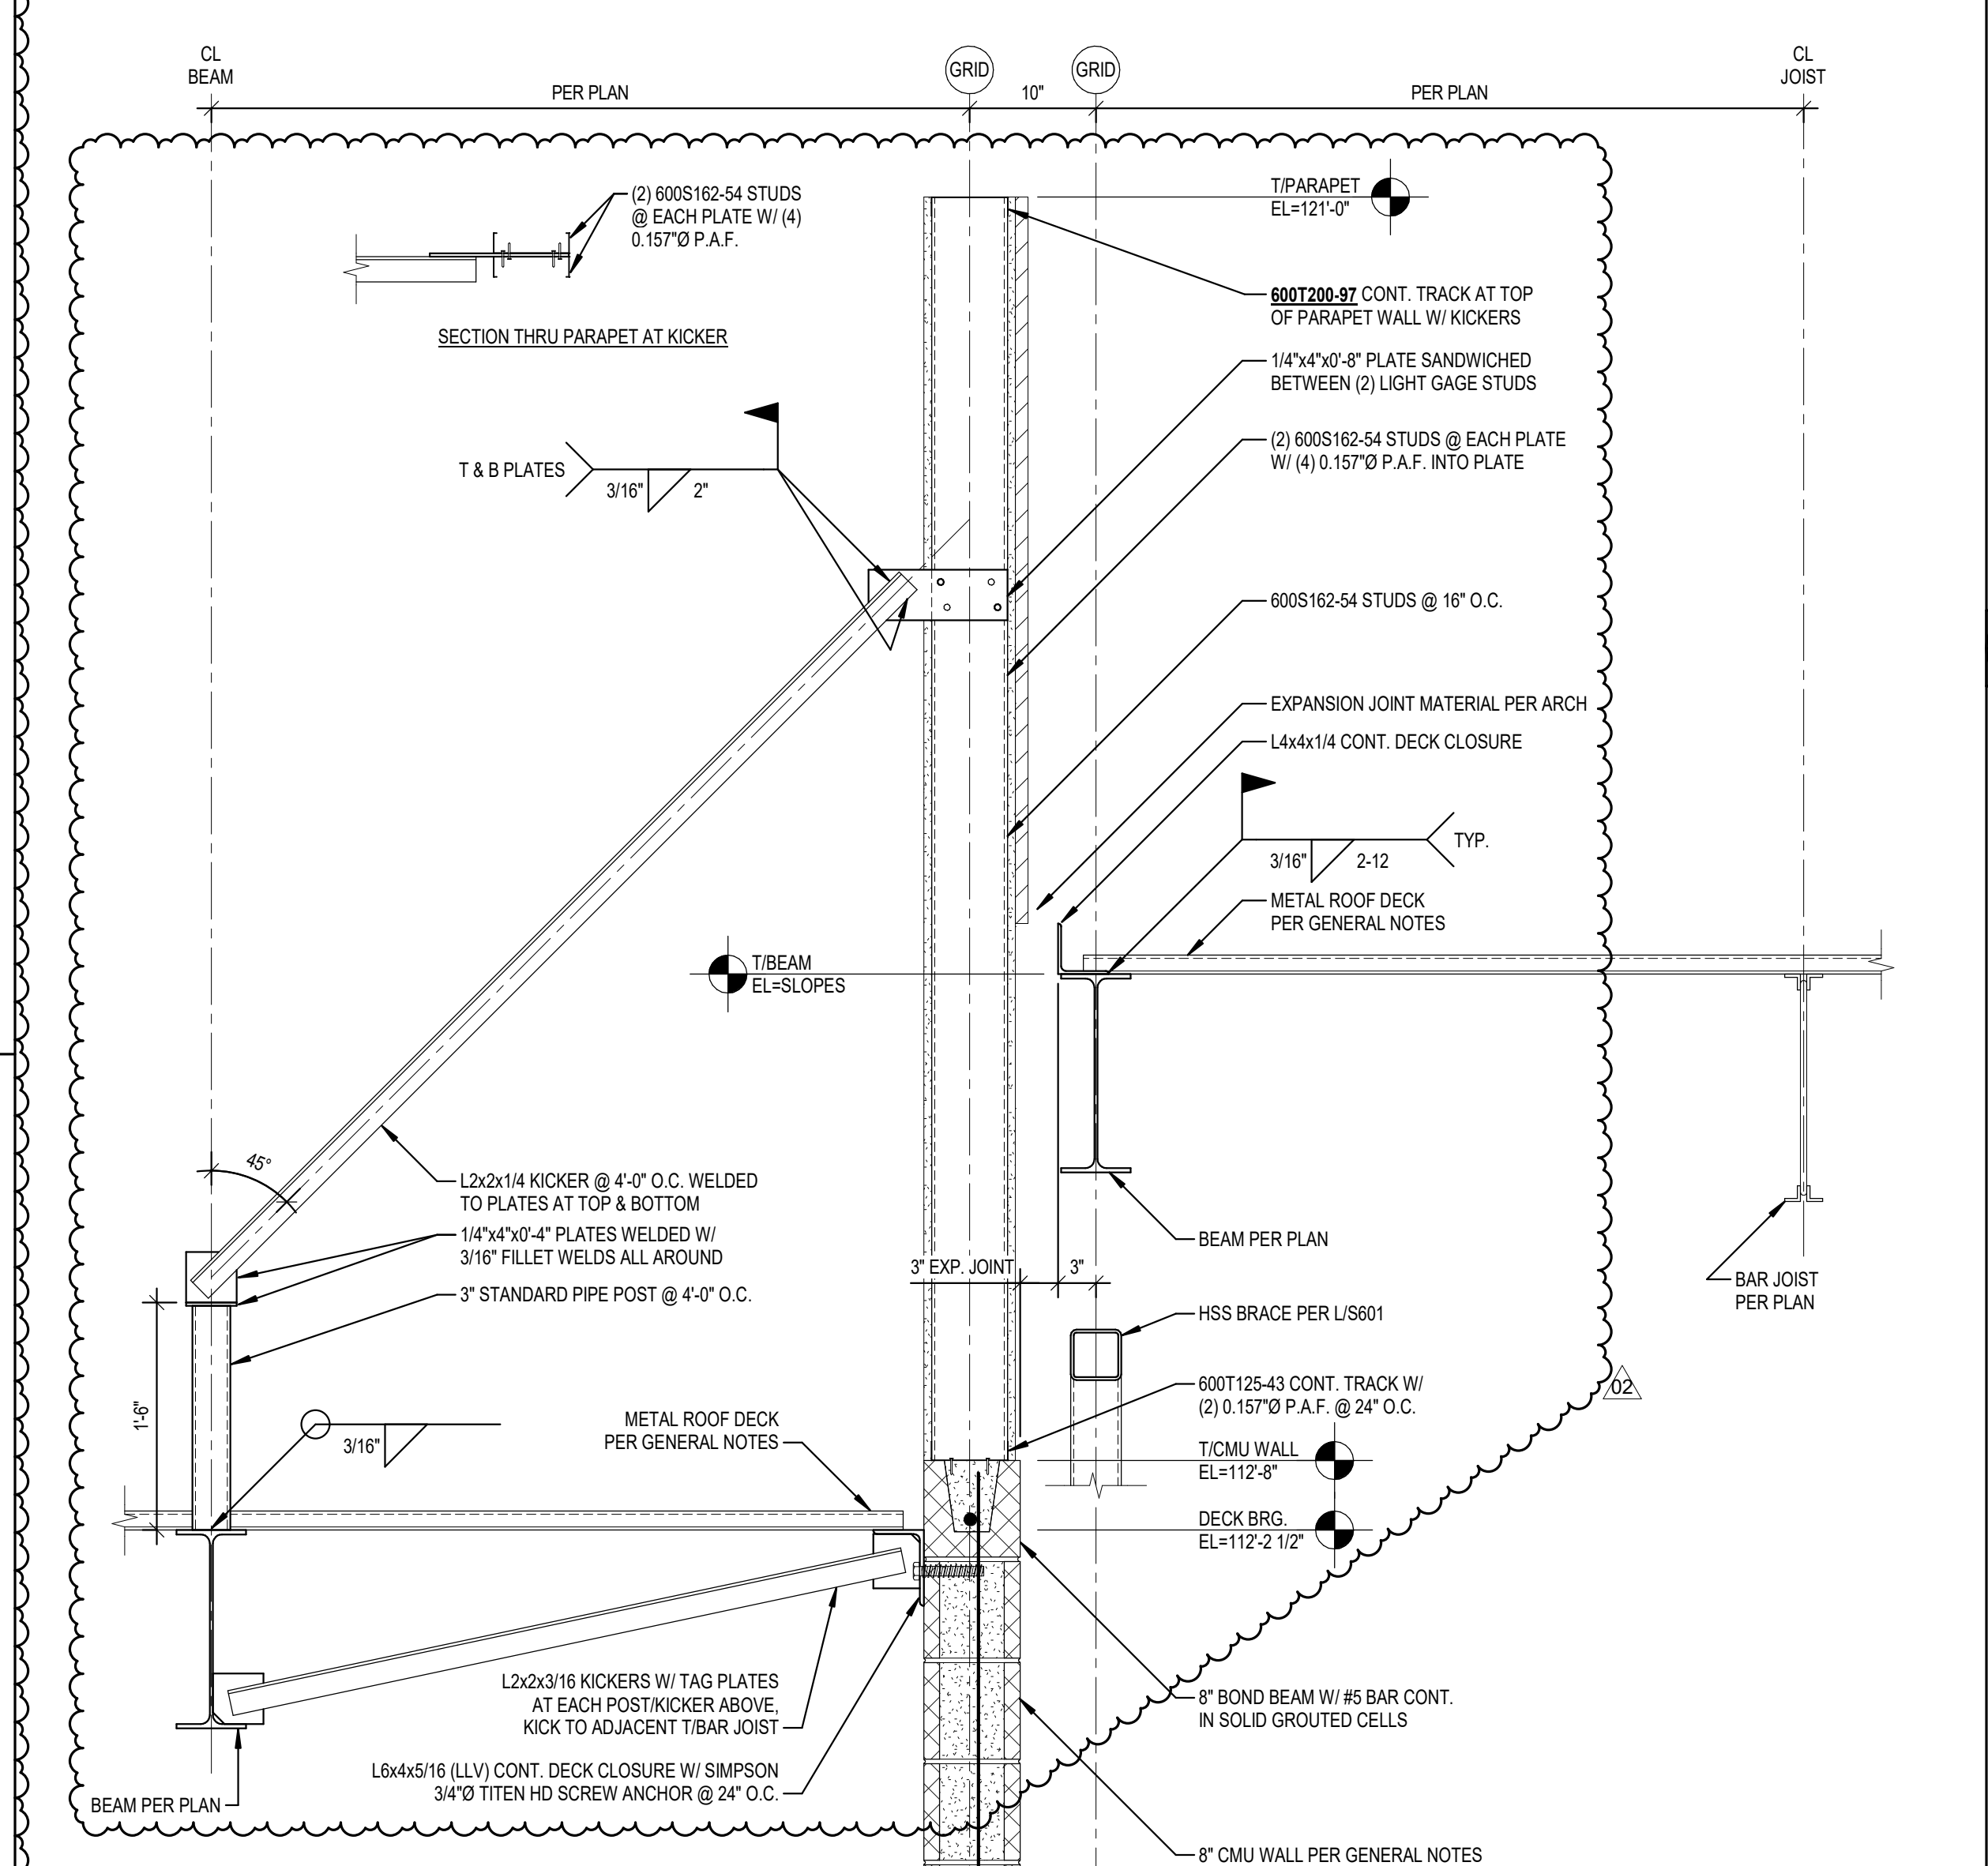

**D**  
**ROOF FRAMING DETAIL**  
Scale: 1" = 1'-0"

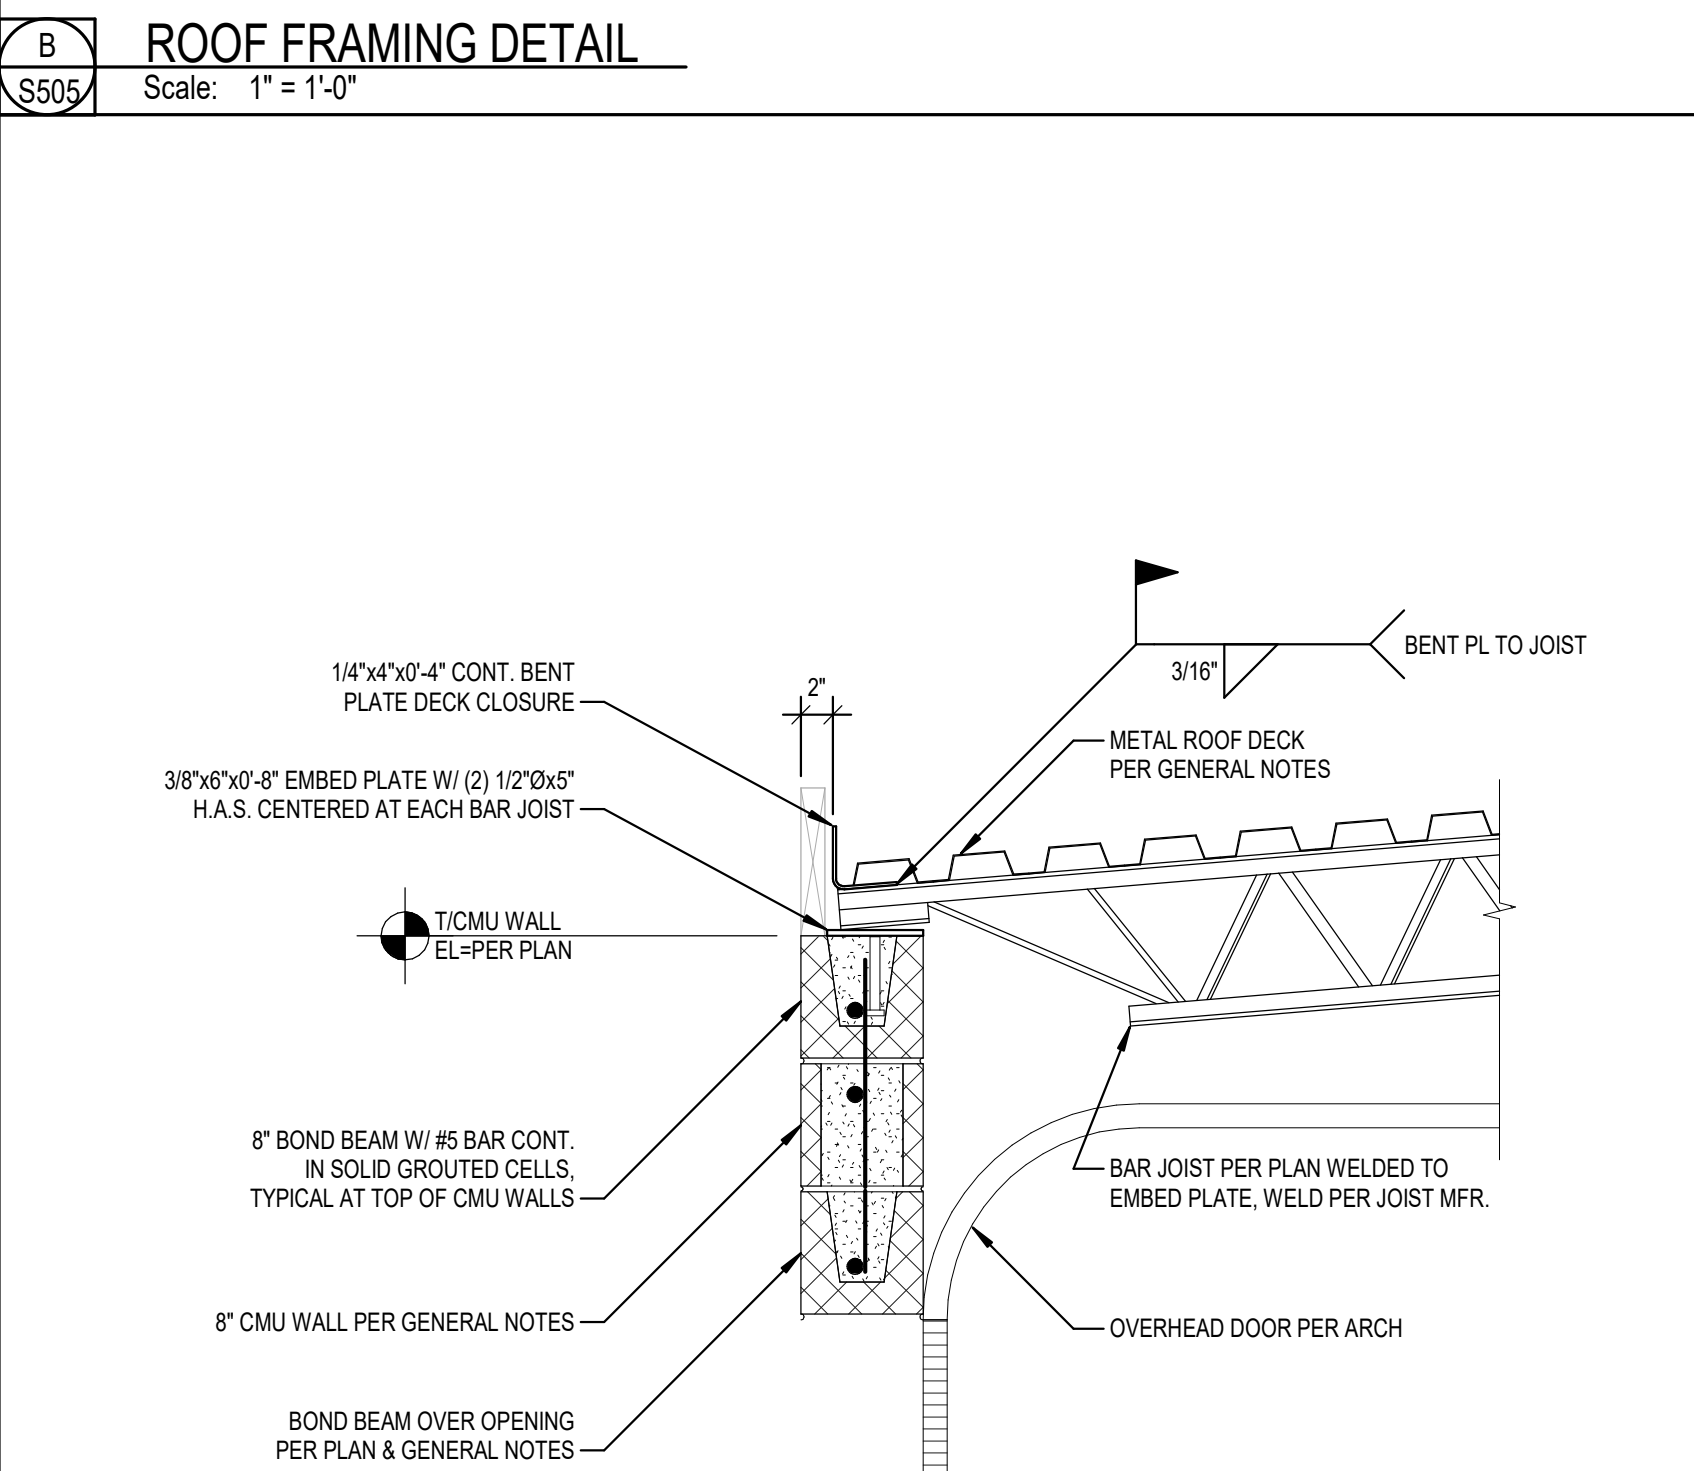

**A**  
**ROOF FRAMING DETAIL**  
Scale: 1" = 1'-0"

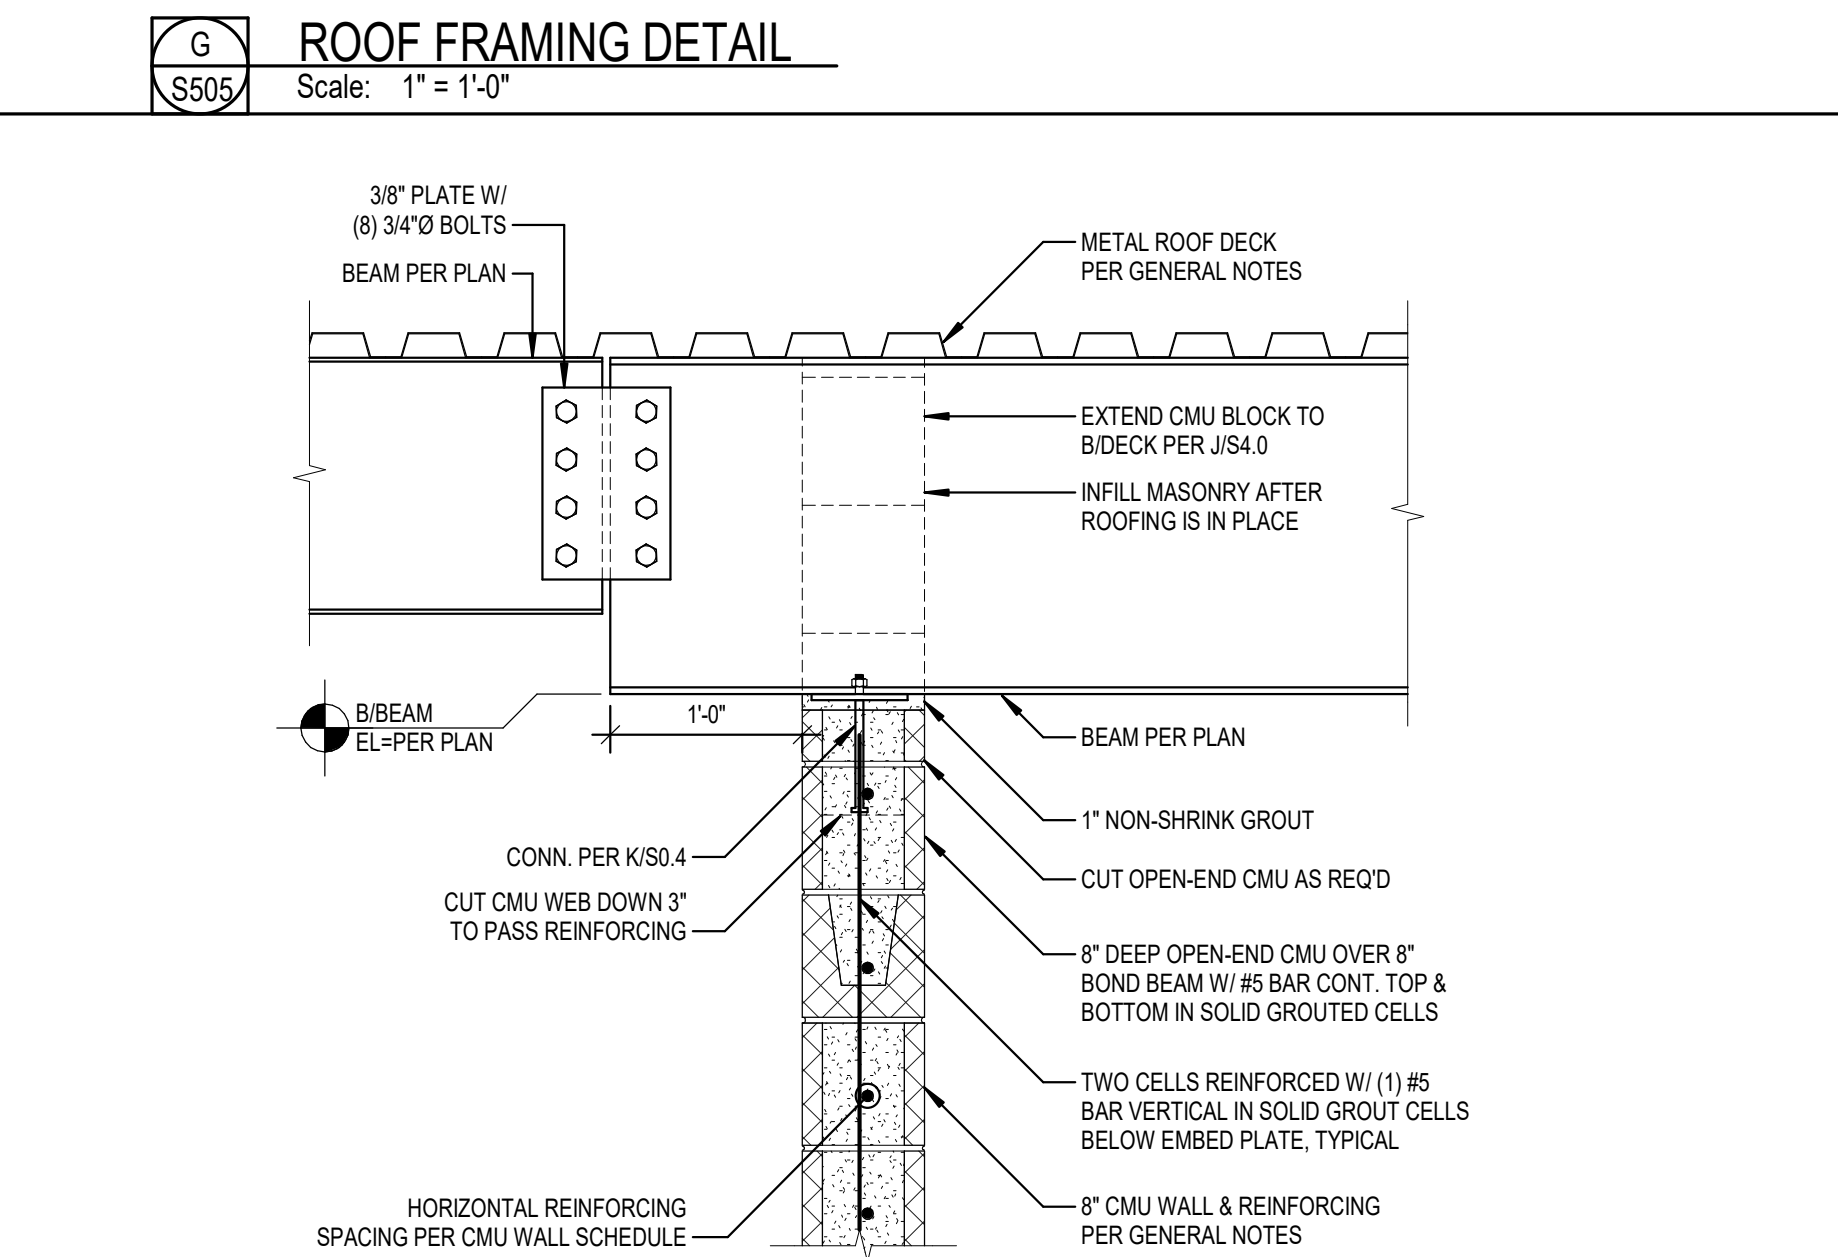


**F**  
**ROOF FRAMING DETAIL**  
Scale: 1" = 1'-0"

REVISIONS		
NO.	DESCRIPTION	DATE
02	ADD 02	01/25/23

PROJECT NO.: 20-0067 DRAWN BY: MRH, TNB  
DATE: 12.15.22 REVIEWED BY: BSW

**PROFESSIONAL SEAL**  
**ALAN METTEMAYER, PE**  
PROFESSIONAL TITLE: ENGINEER  
MOW E-2000162147

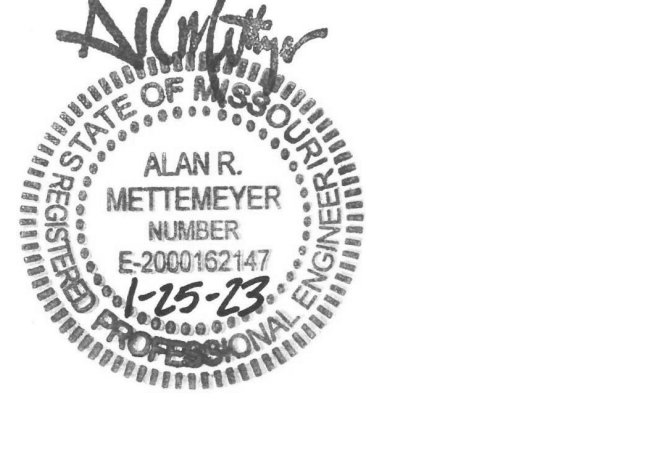

© 2021 H DESIGN GROUP, LLC.  
THIS DRAWING AND THE ARCHITECTURAL WORK REPRESENTED ARE OWNED BY H DESIGN GROUP, LLC. COPYRIGHT INCLUDES THE DRAWING, AS WELL AS ALL COMPONENTS OF THE CONCEPTUAL DESIGN. REPRODUCTION OF ANY KIND IS STRICTLY PROHIBITED WITHOUT THE EXPRESSED WRITTEN CONSENT OF H DESIGN GROUP, LLC.

**PROJECT TITLE**  
**CITY OF WENTZVILLE, MO PUBLIC WORKS FACILITY**

**PROJECT ADDRESS:**  
1295 INTERSTATE DRIVE  
WENTZVILLE, MO 63385

**FRAMING DETAILS**



**OWNER**  
**CITY OF WENTZVILLE, MISSOURI**  
1001 SCHROEDER CREEK BLVD  
WENTZVILLE, MO 63385  
636.327.5101

**PROJECT TEAM**  
CIVIL ENGINEER  
PREMIER DESIGN GROUP  
100 MIDLAND PARK DRIVE  
WENTZVILLE, MO 63385  
314.925.7444

MAINTENANCE CONSULTANT  
HDR ENGINEERING, INC.  
10450 HOLMES RD., STE 600  
SPRINGFIELD, MO 65810  
816.360.2700

STRUCTURAL ENGINEER  
METTEMMEYER ENGINEERING  
2225 W CHESTERFIELD BLVD., SUITE 300  
SPRINGFIELD, MO 65807  
417.890.8002

MEP ENGINEER  
HENDERSON ENGINEERING, INC.  
8345 LENEXA DR., #300  
LENEXA, KS 66214  
417.555.5555

REVISIONS		
NO.	DESCRIPTION	DATE
01	ADD 01	01/11/23
02	ADD 02	01/25/23

PROJECT NO.: 20-0067 DRAWN BY: MRH, TNB  
DATE: 12.15.22 REVIEWED BY: BSW

**PROFESSIONAL SEAL**  
**ALAN METTEMMEYER, PE**  
PROFESSIONAL TITLE: ENGINEER  
MO# E-2000162147




THIS DRAWING AND THE ARCHITECTURAL WORK REPRESENTED ARE OWNED BY H DESIGN GROUP, LLC. COPYRIGHT INCLUDES THE DRAWING, AS WELL AS ALL COMPONENTS OF THE CONCEPTUAL DESIGN. REPRODUCTION OF ANY PART OR STRICTLY PROHIBITED WITHOUT THE EXPRESSED WRITTEN CONSENT OF H DESIGN GROUP, LLC.

**PROJECT TITLE**  
**CITY OF WENTZVILLE, MO PUBLIC WORKS FACILITY**


**PROJECT ADDRESS**  
1295 INTERSTATE DRIVE  
WENTZVILLE, MO 63385

**FRAMING DETAILS**


**S506**

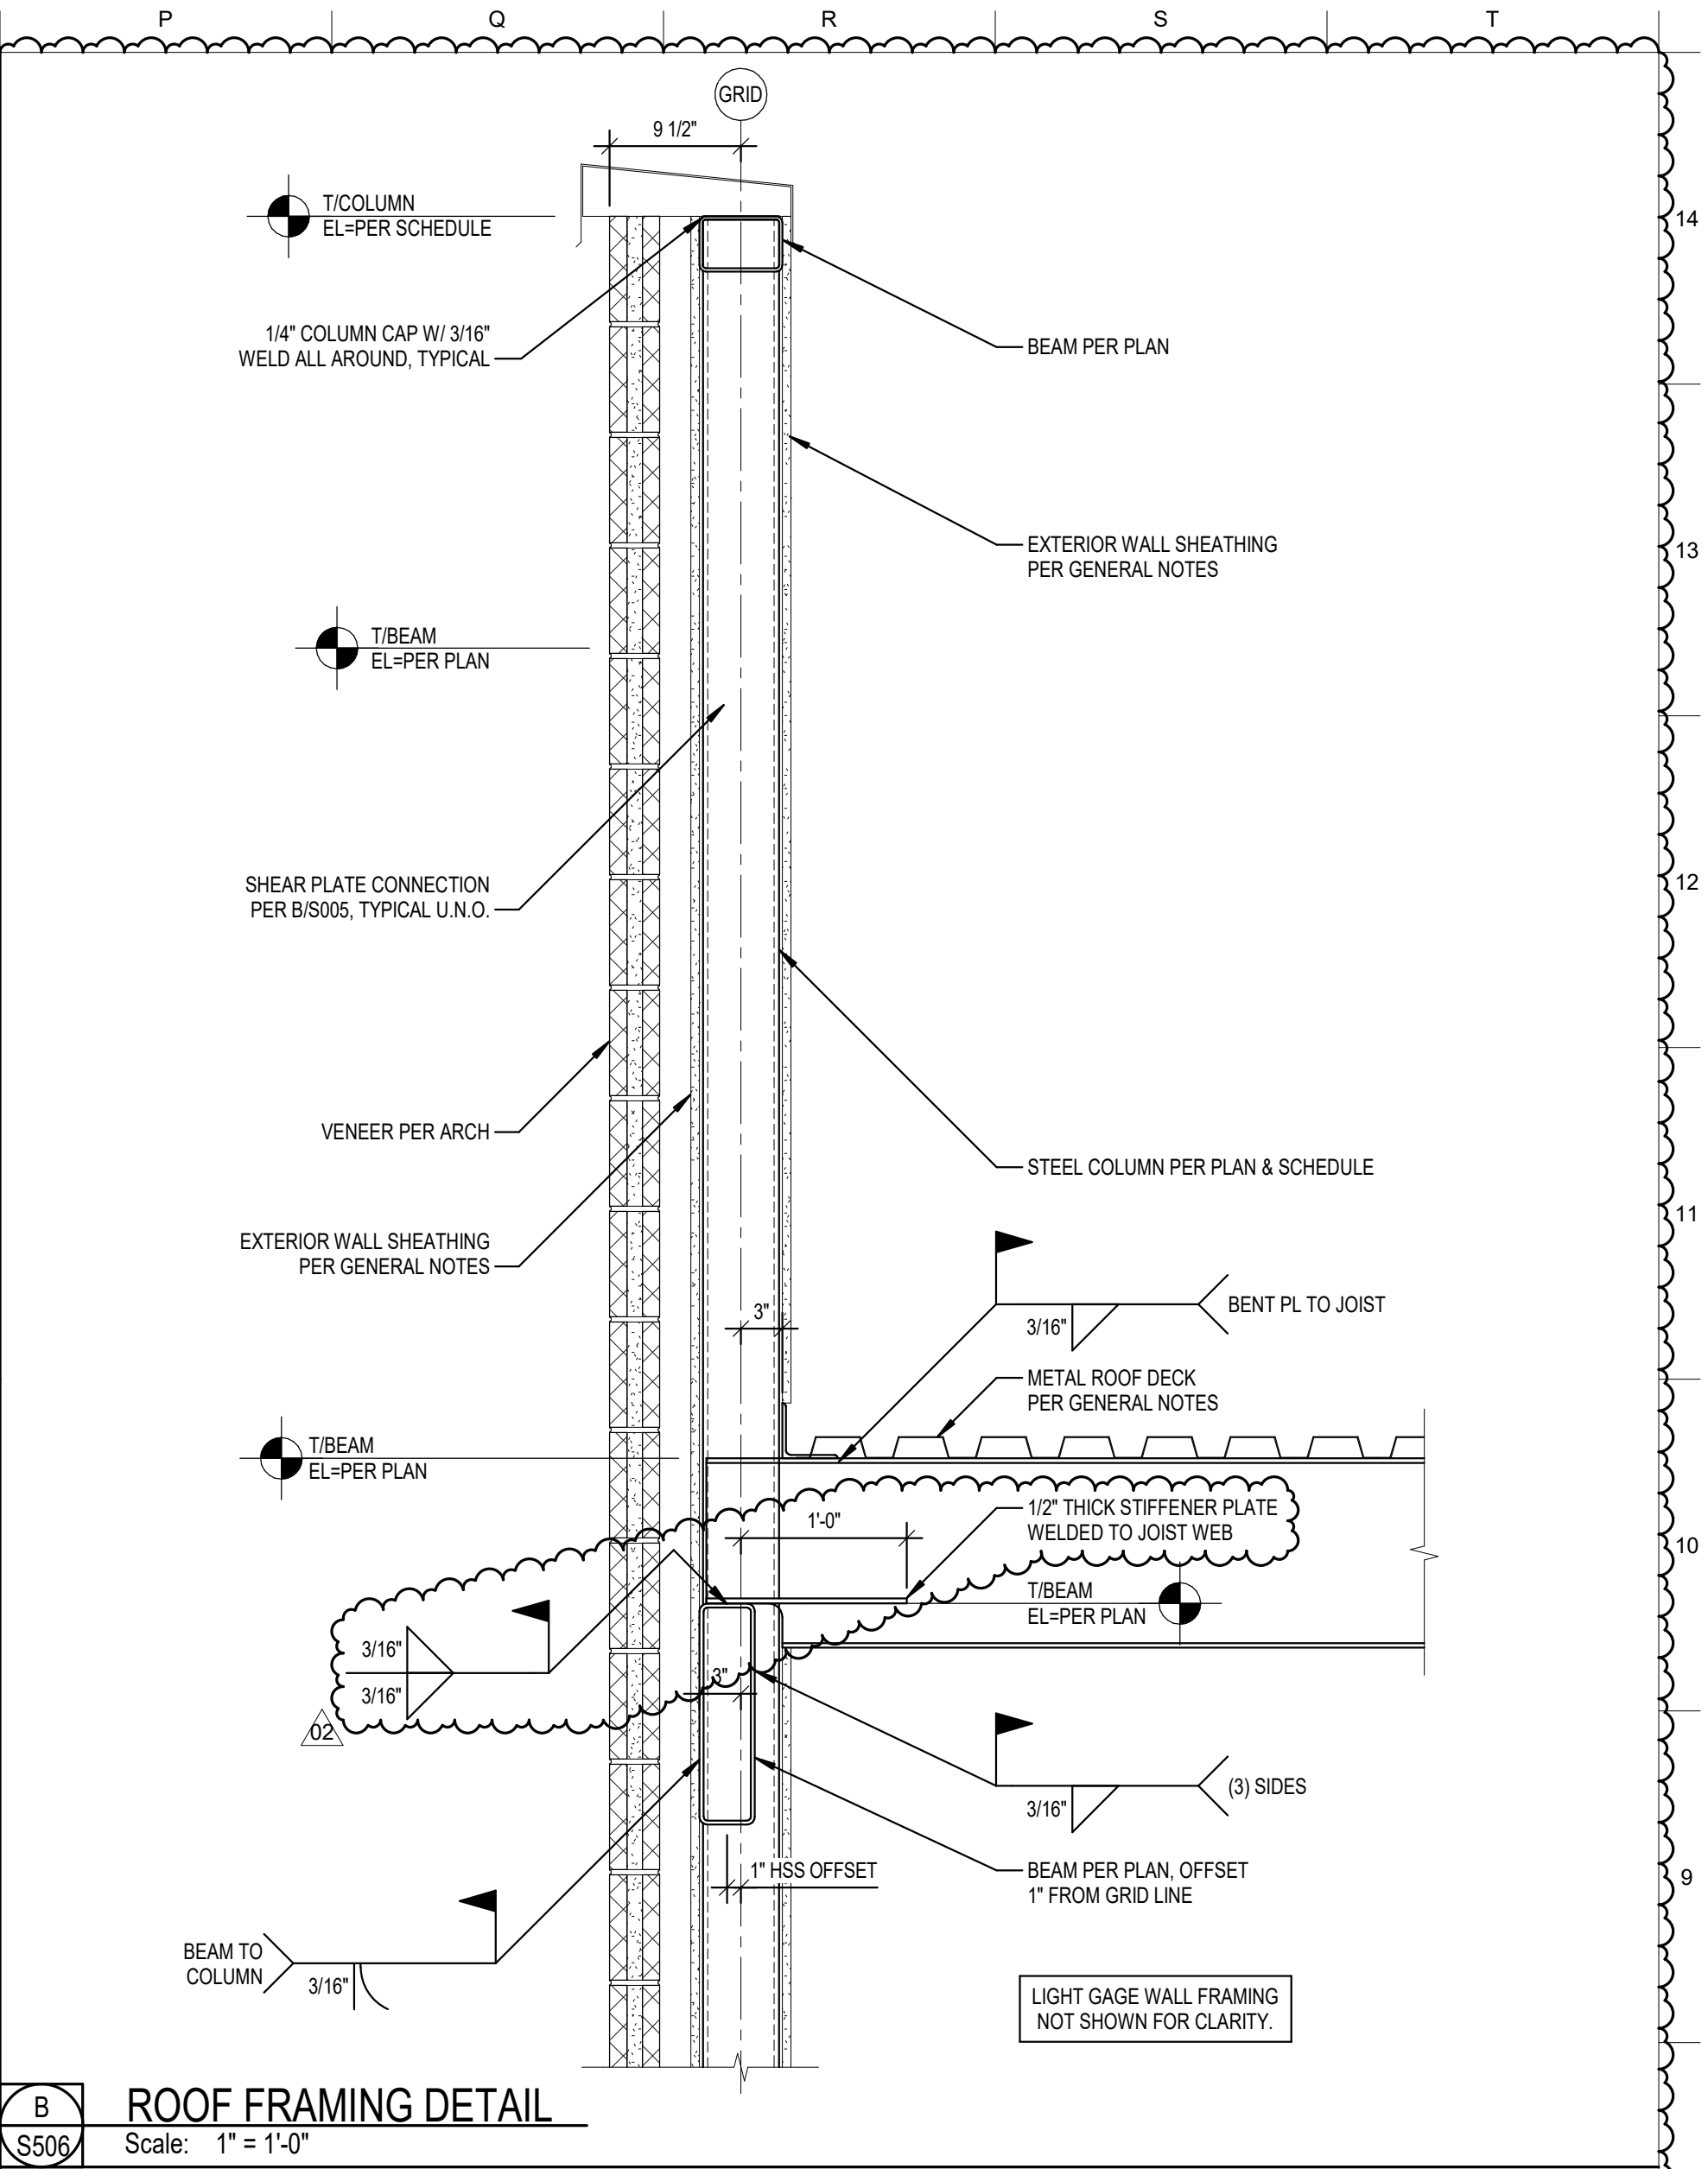


**P ROOF FRAMING DETAIL**  
Scale: 1" = 1'-0"

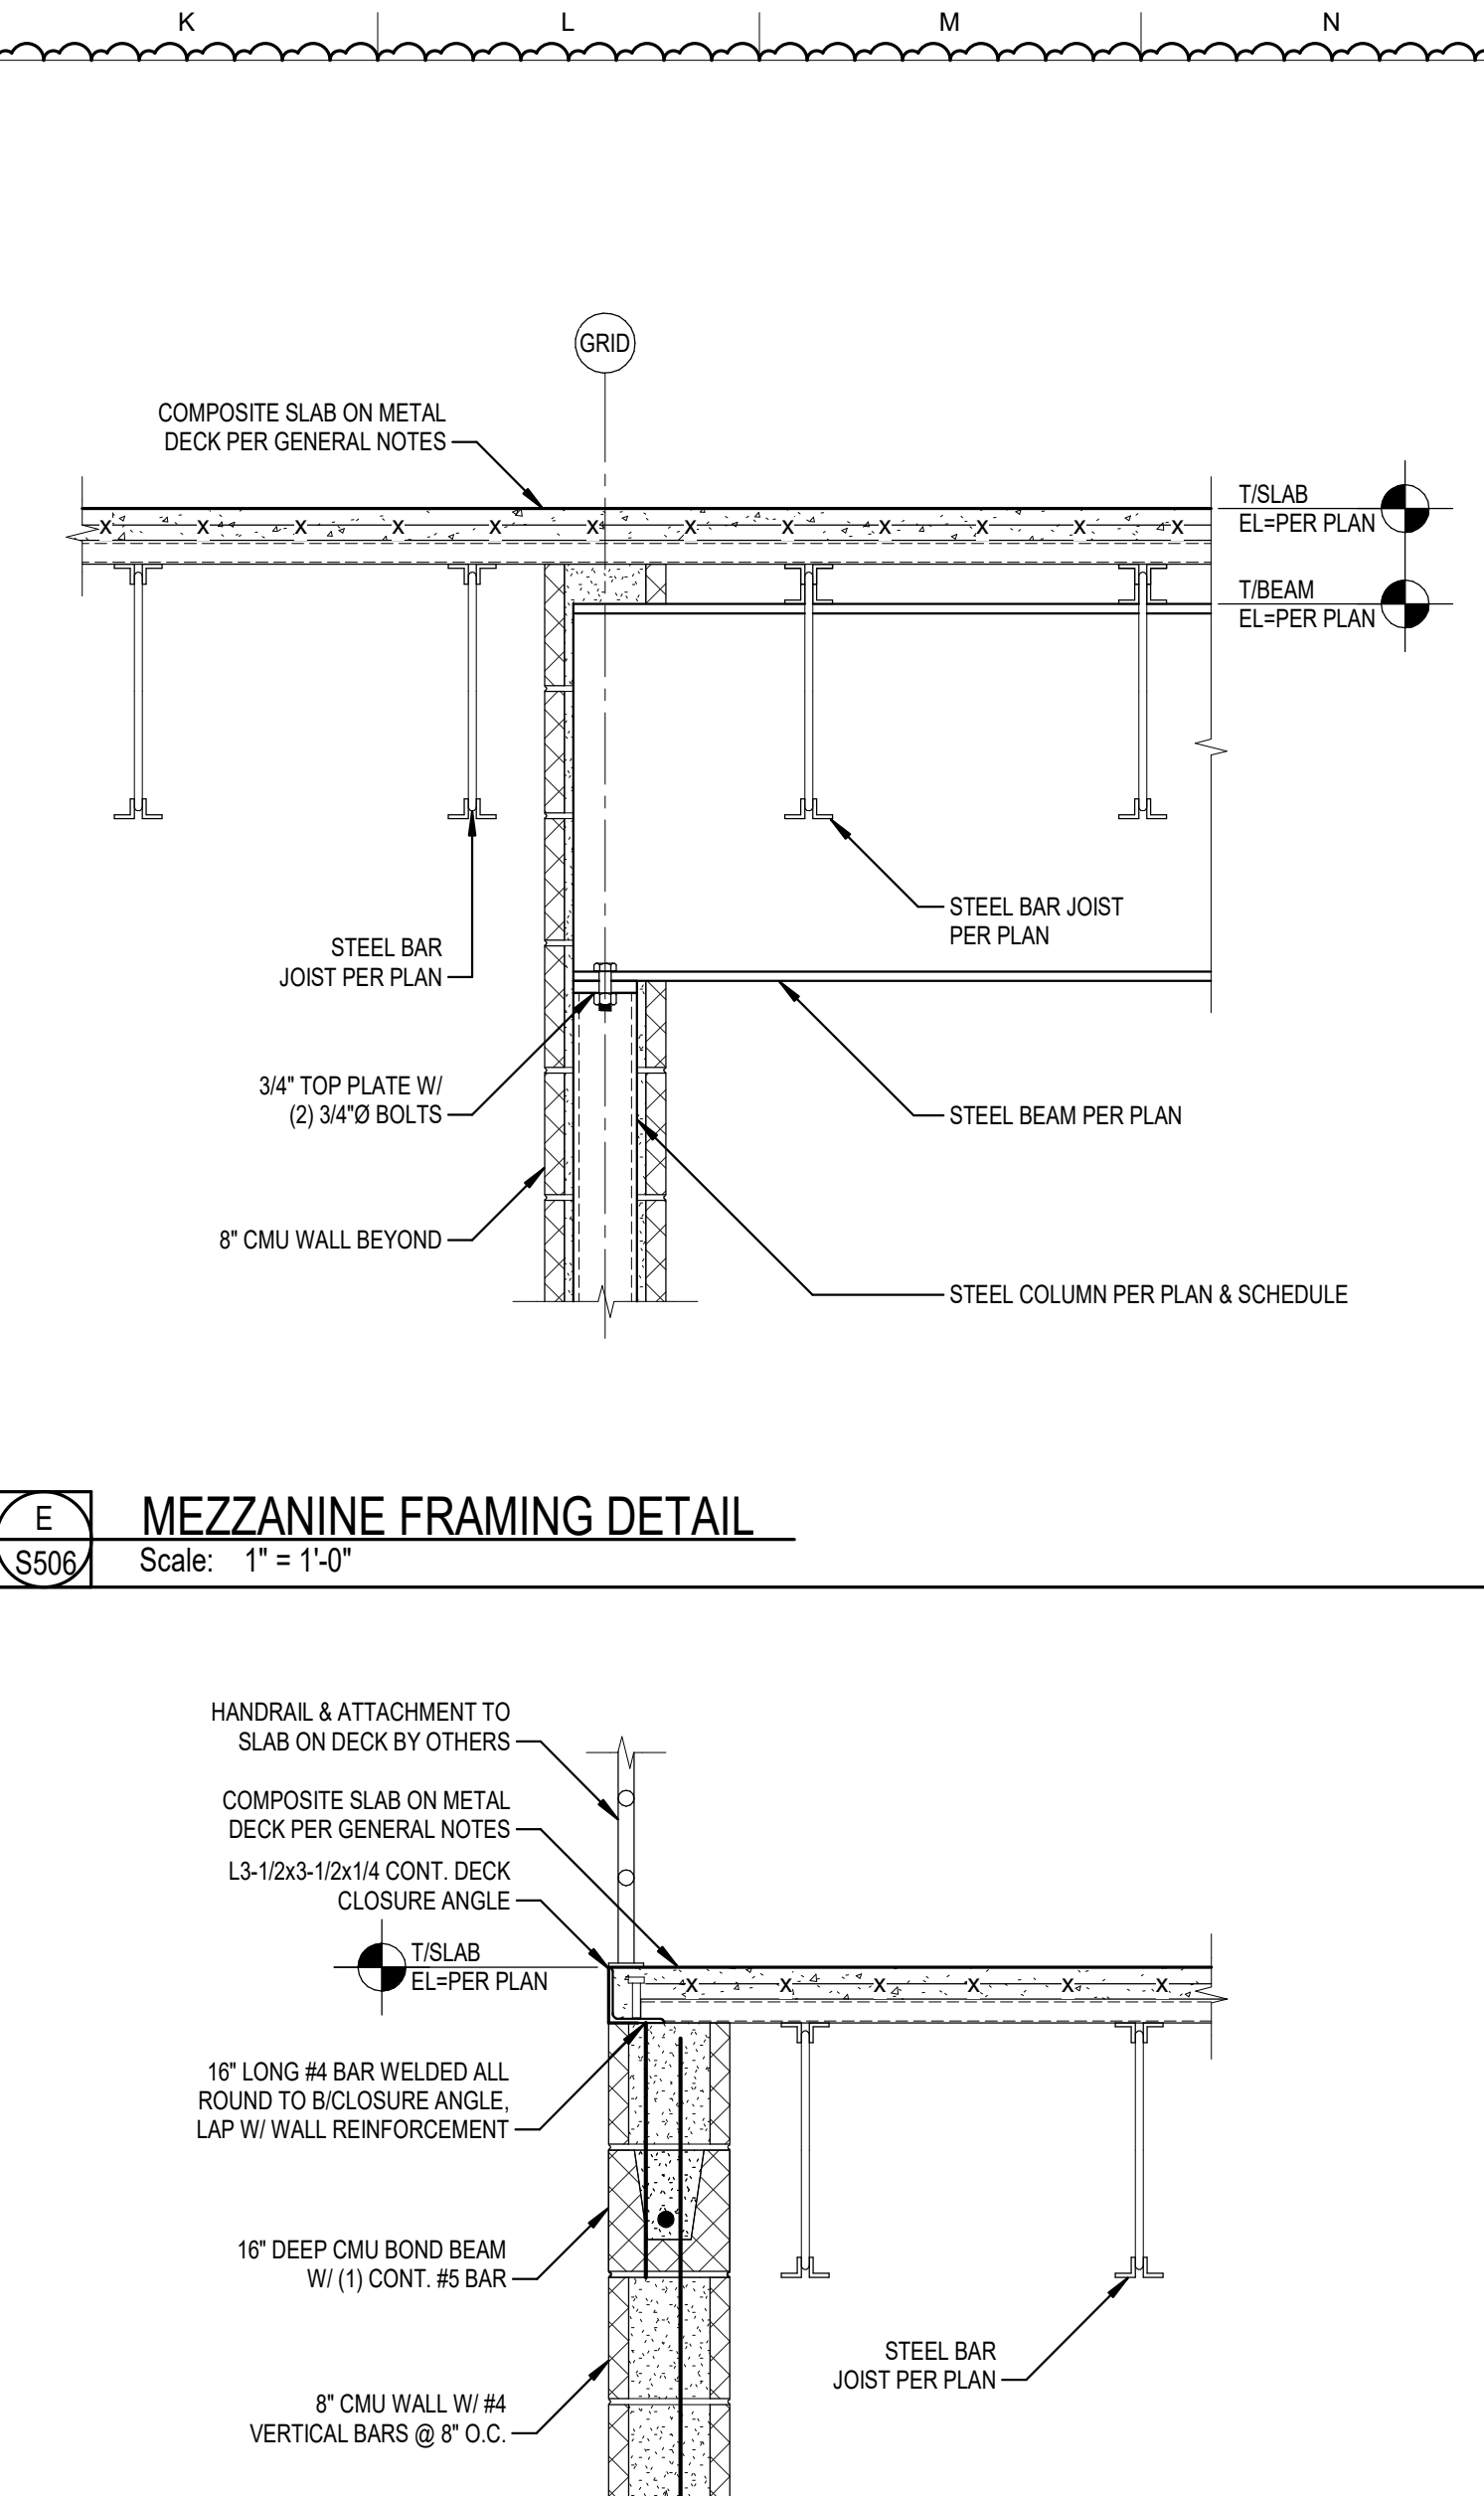


**E MEZZANINE FRAMING DETAIL**  
Scale: 1" = 1'-0"

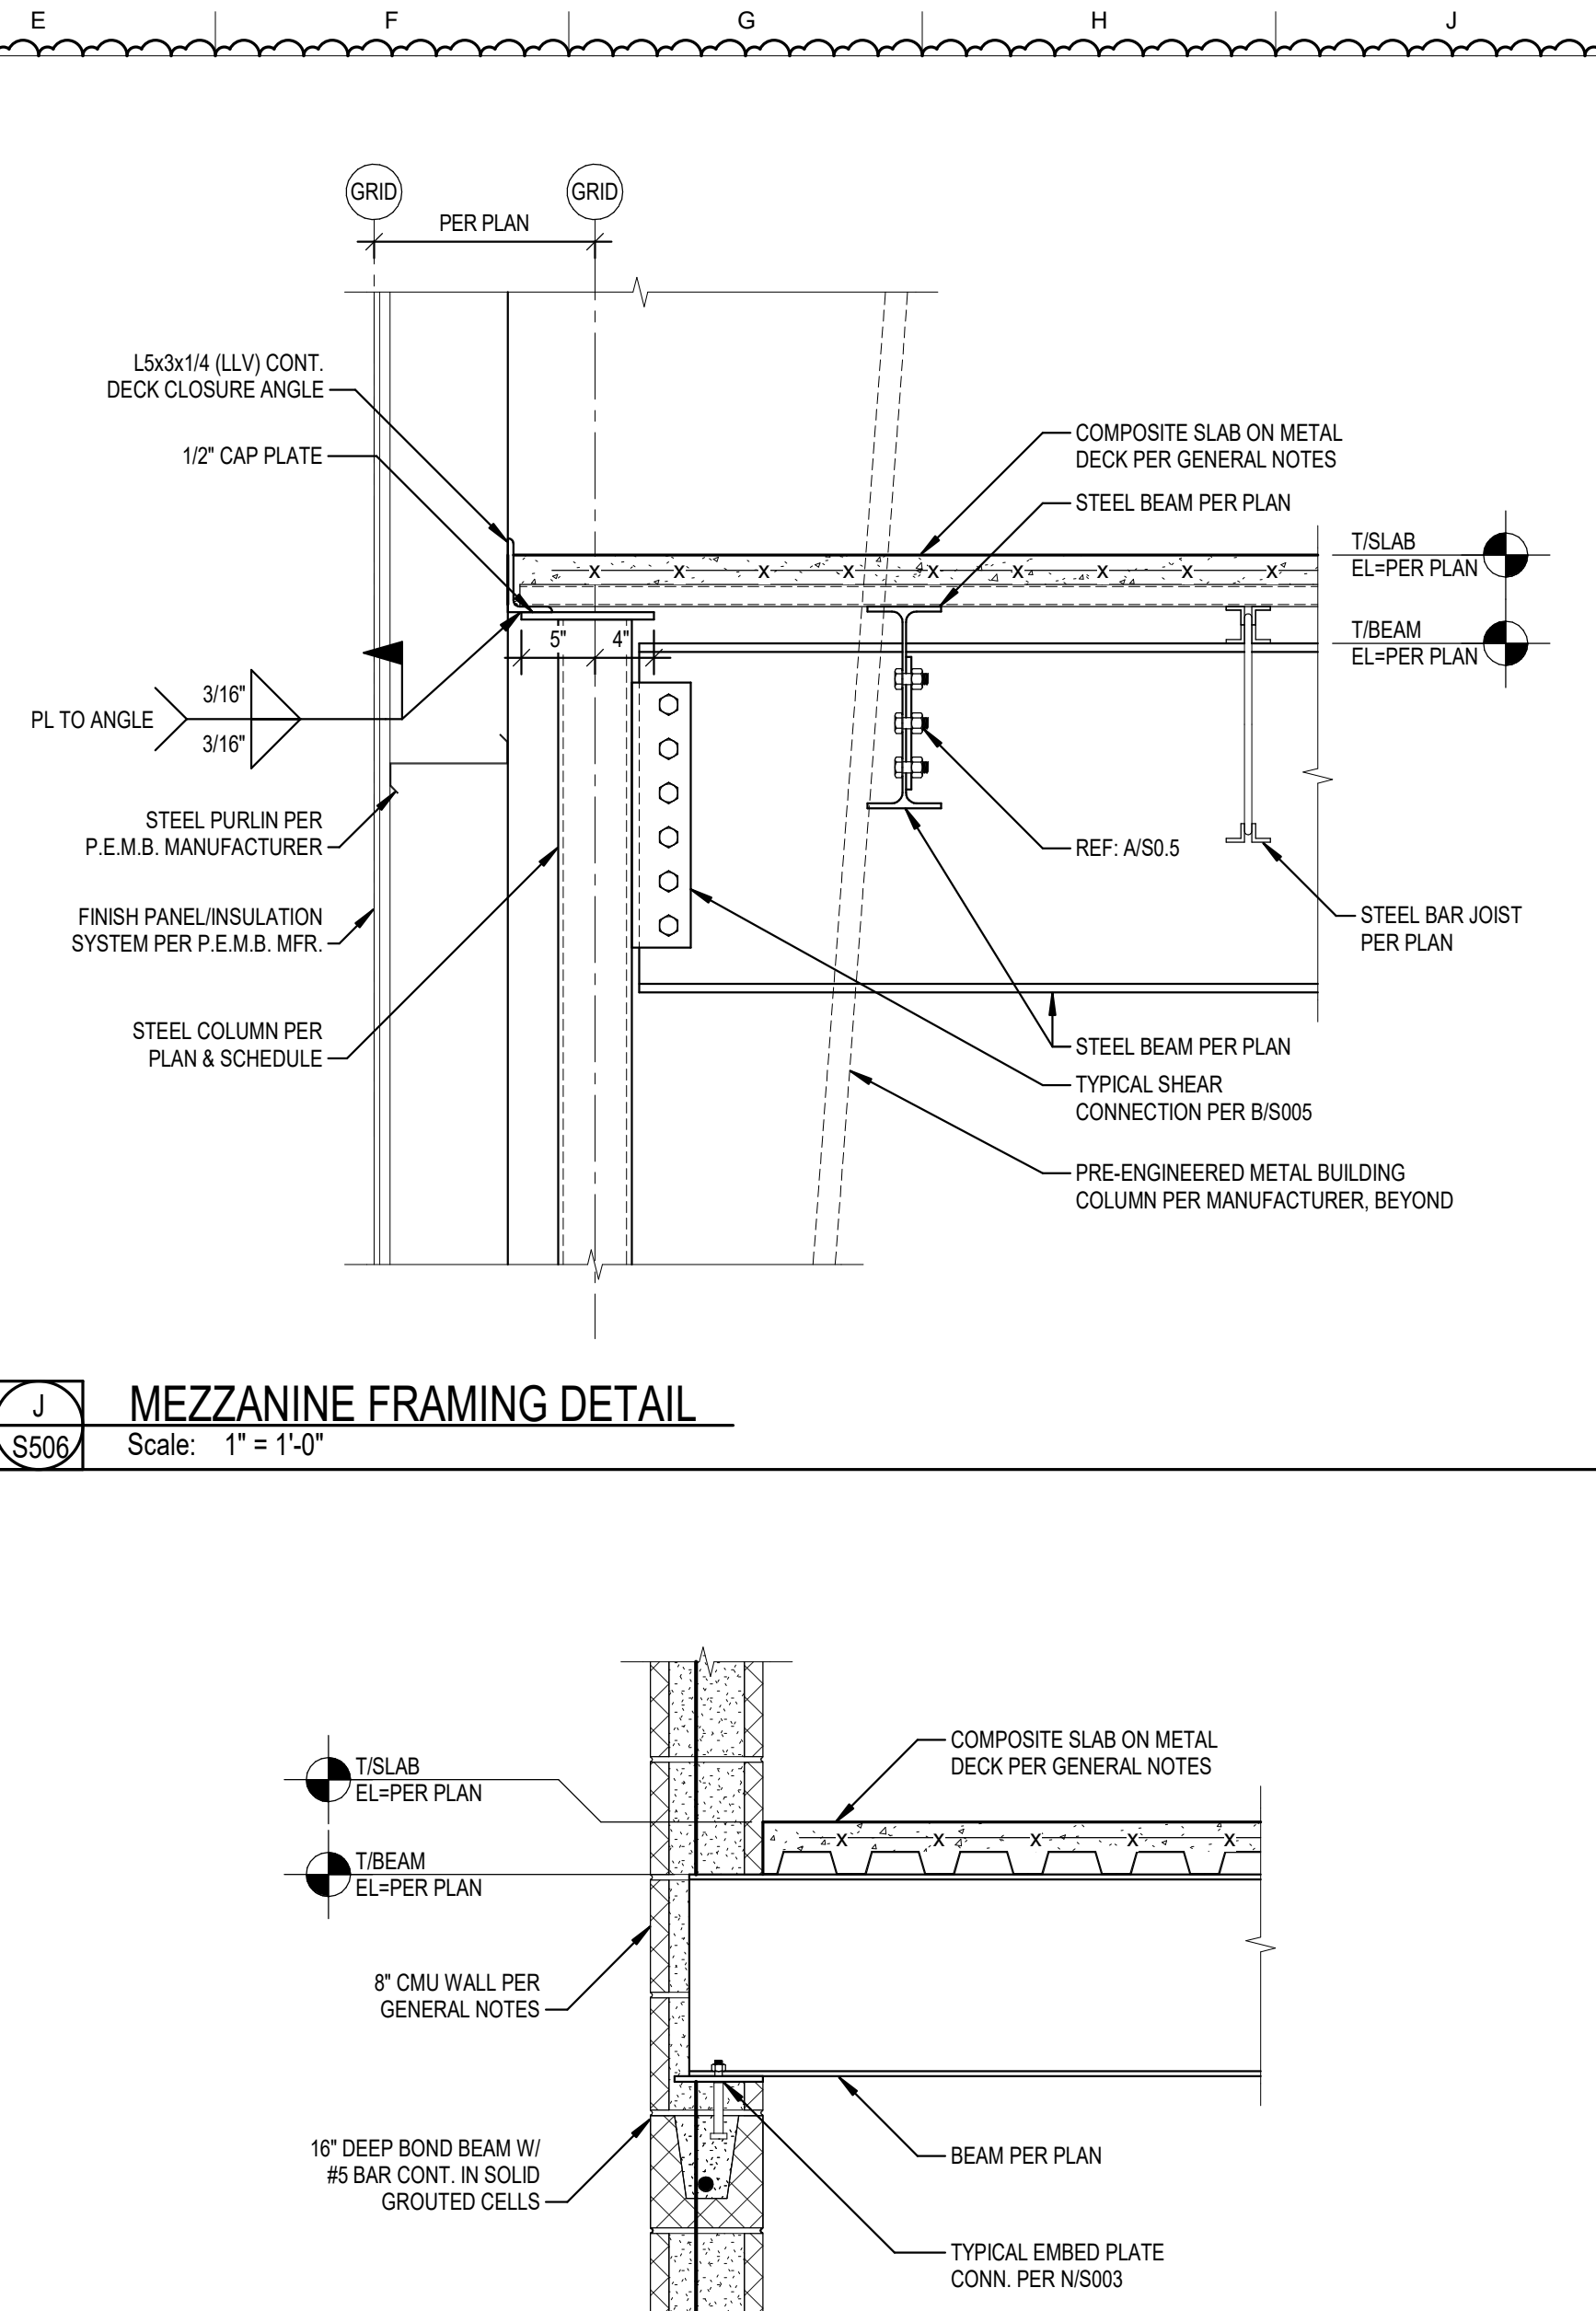


**J MEZZANINE FRAMING DETAIL**  
Scale: 1" = 1'-0"

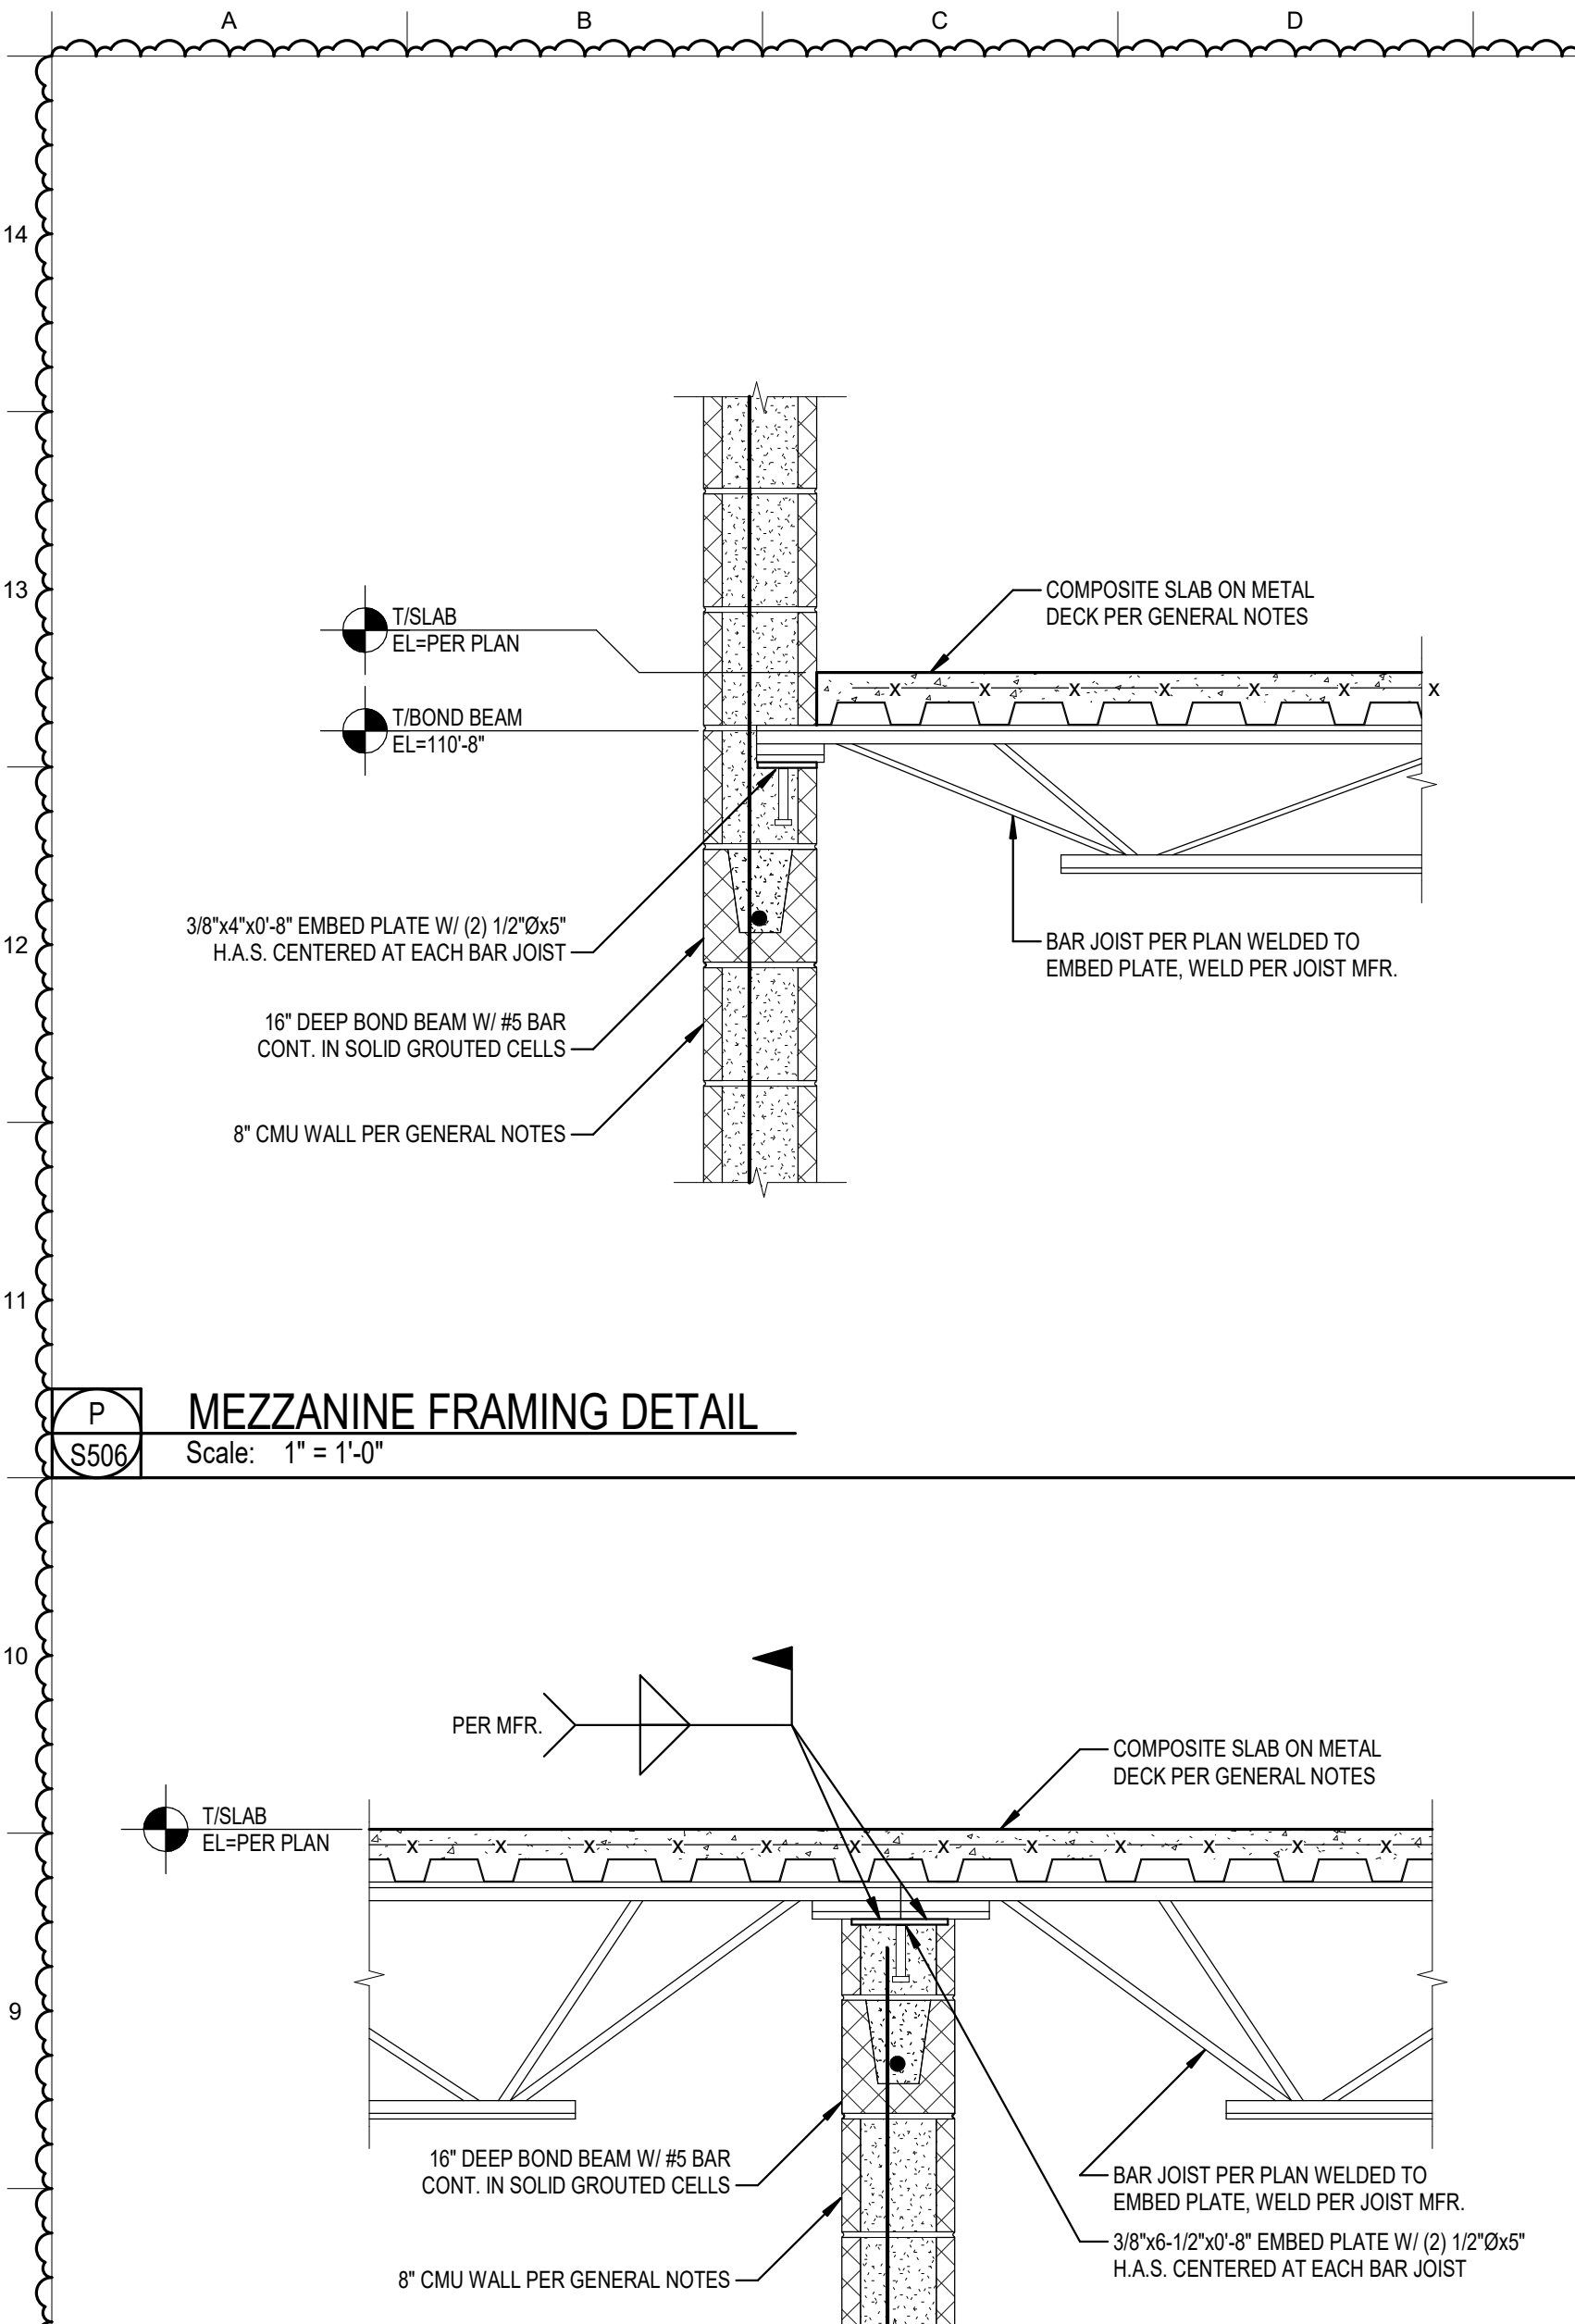


**P MEZZANINE FRAMING DETAIL**  
Scale: 1" = 1'-0"

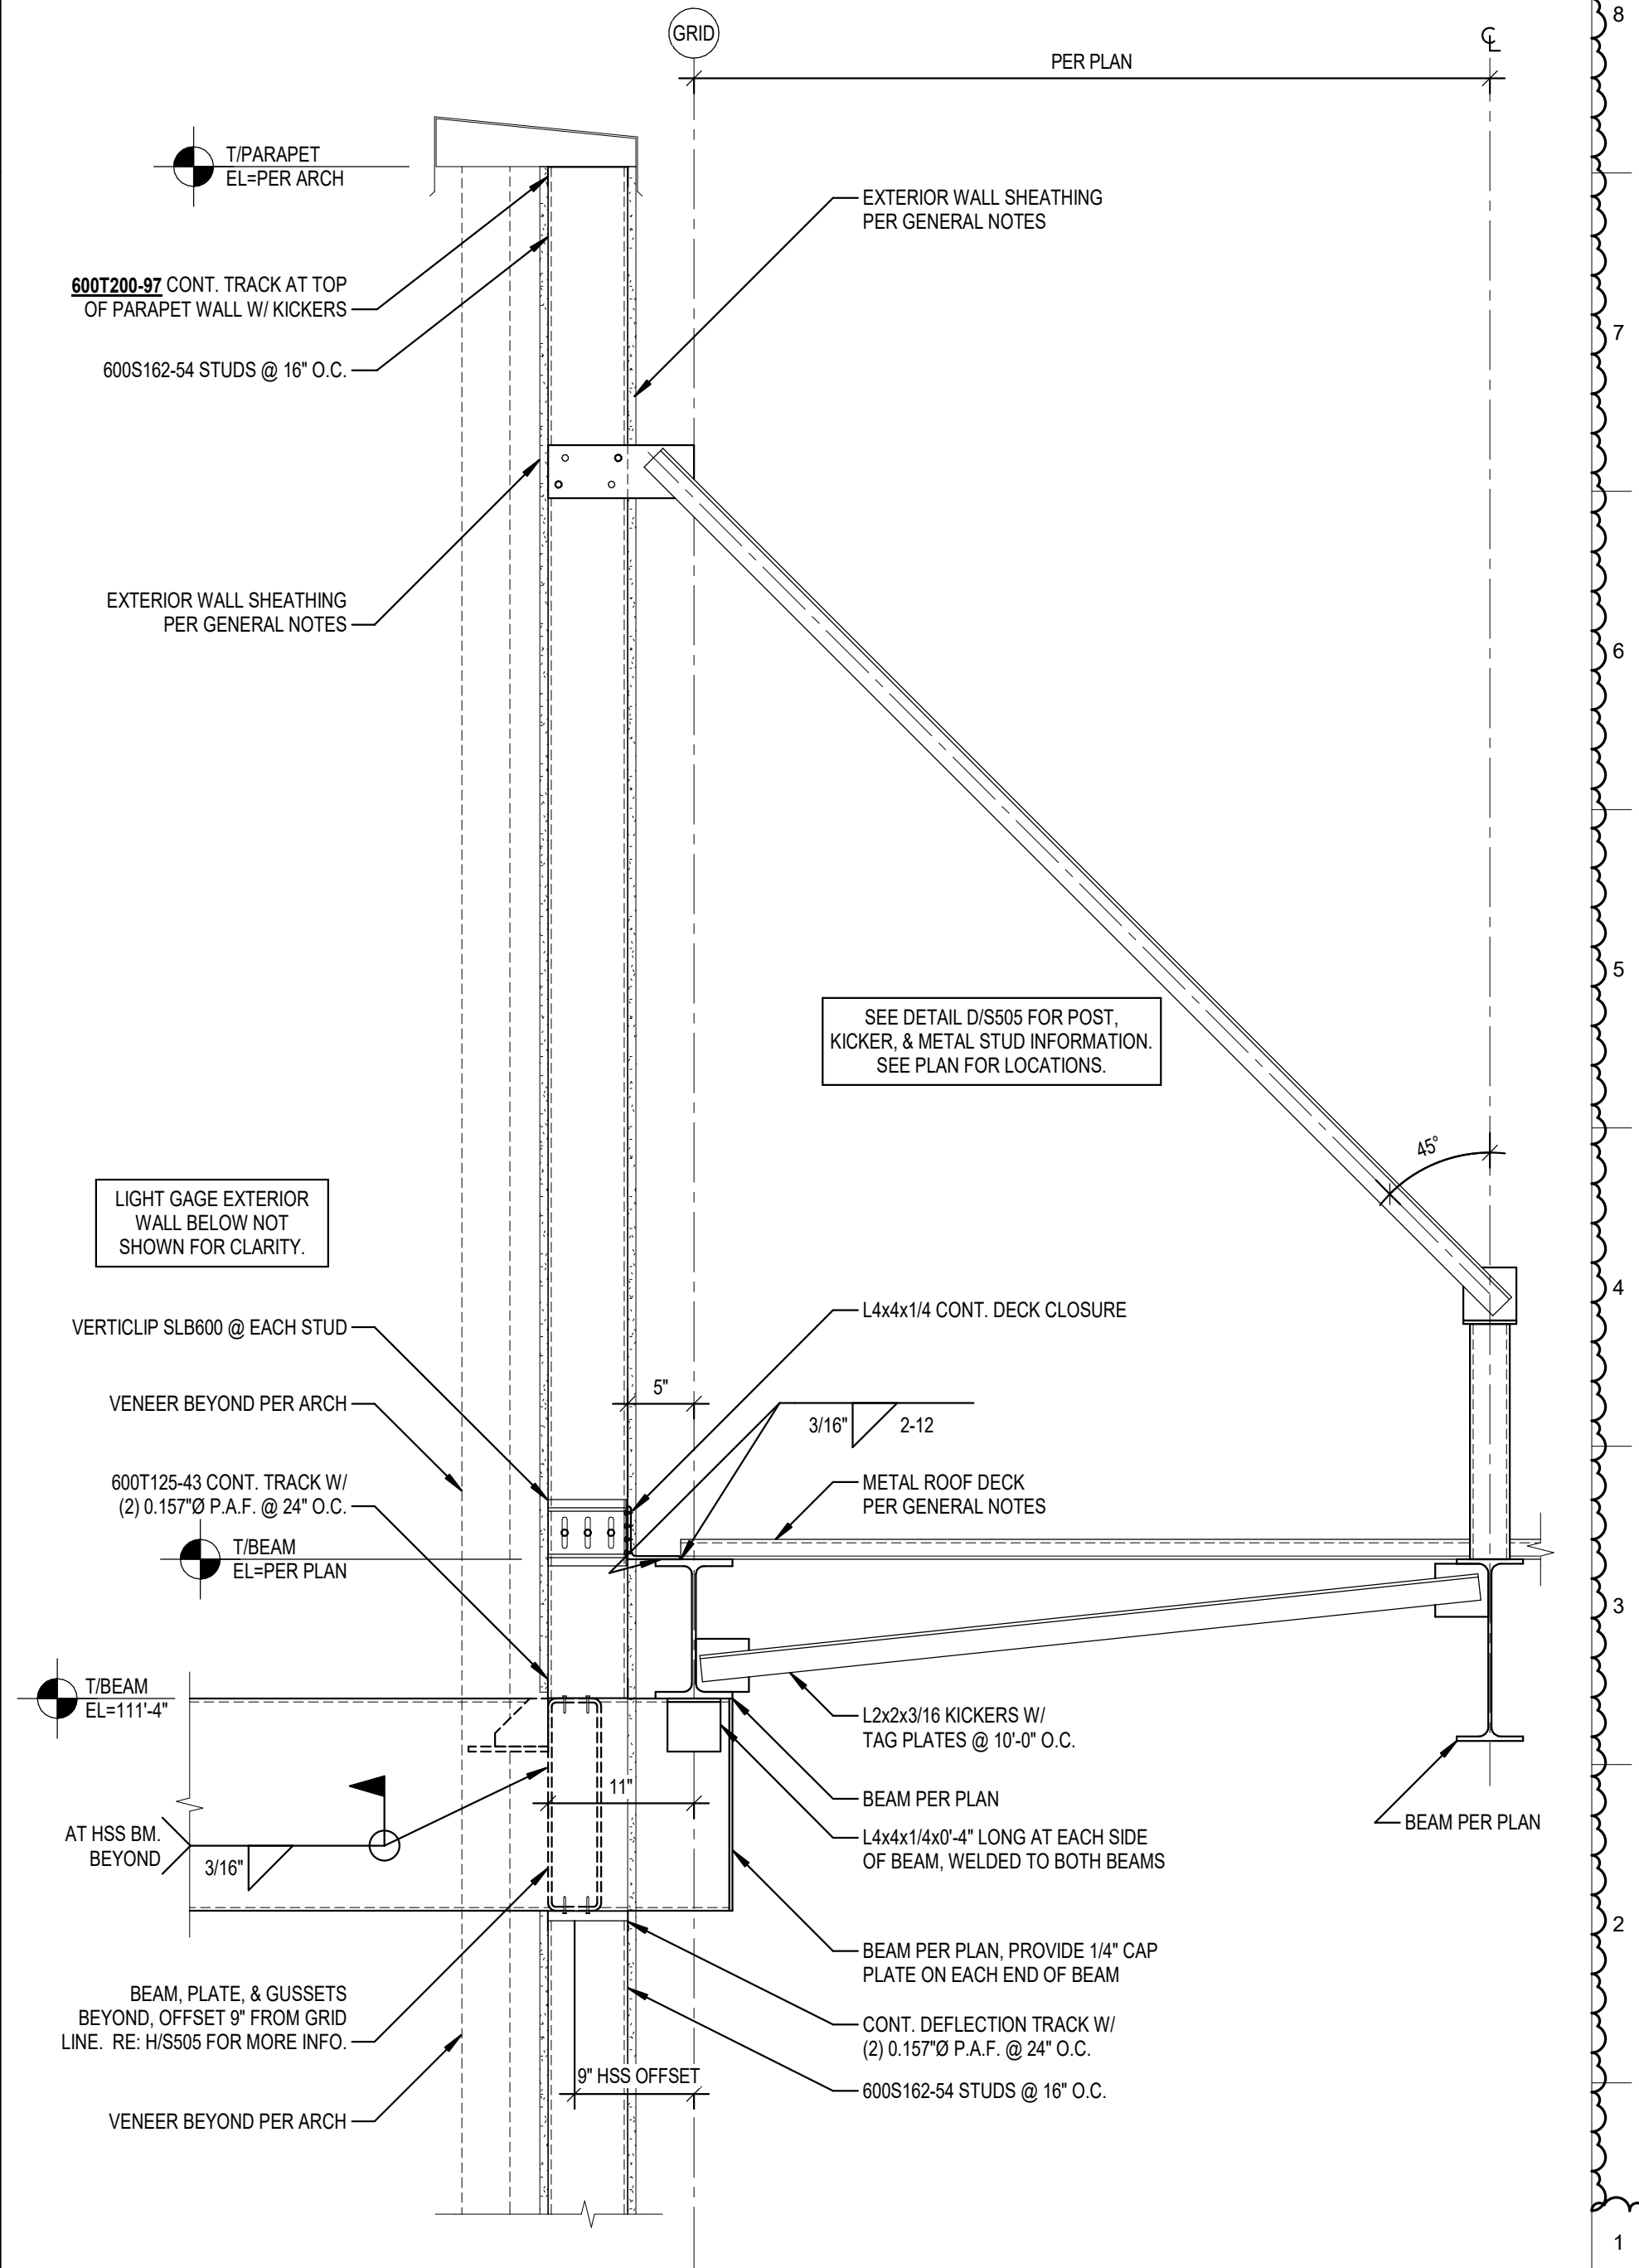


**B ROOF FRAMING DETAIL**  
Scale: 1" = 1'-0"

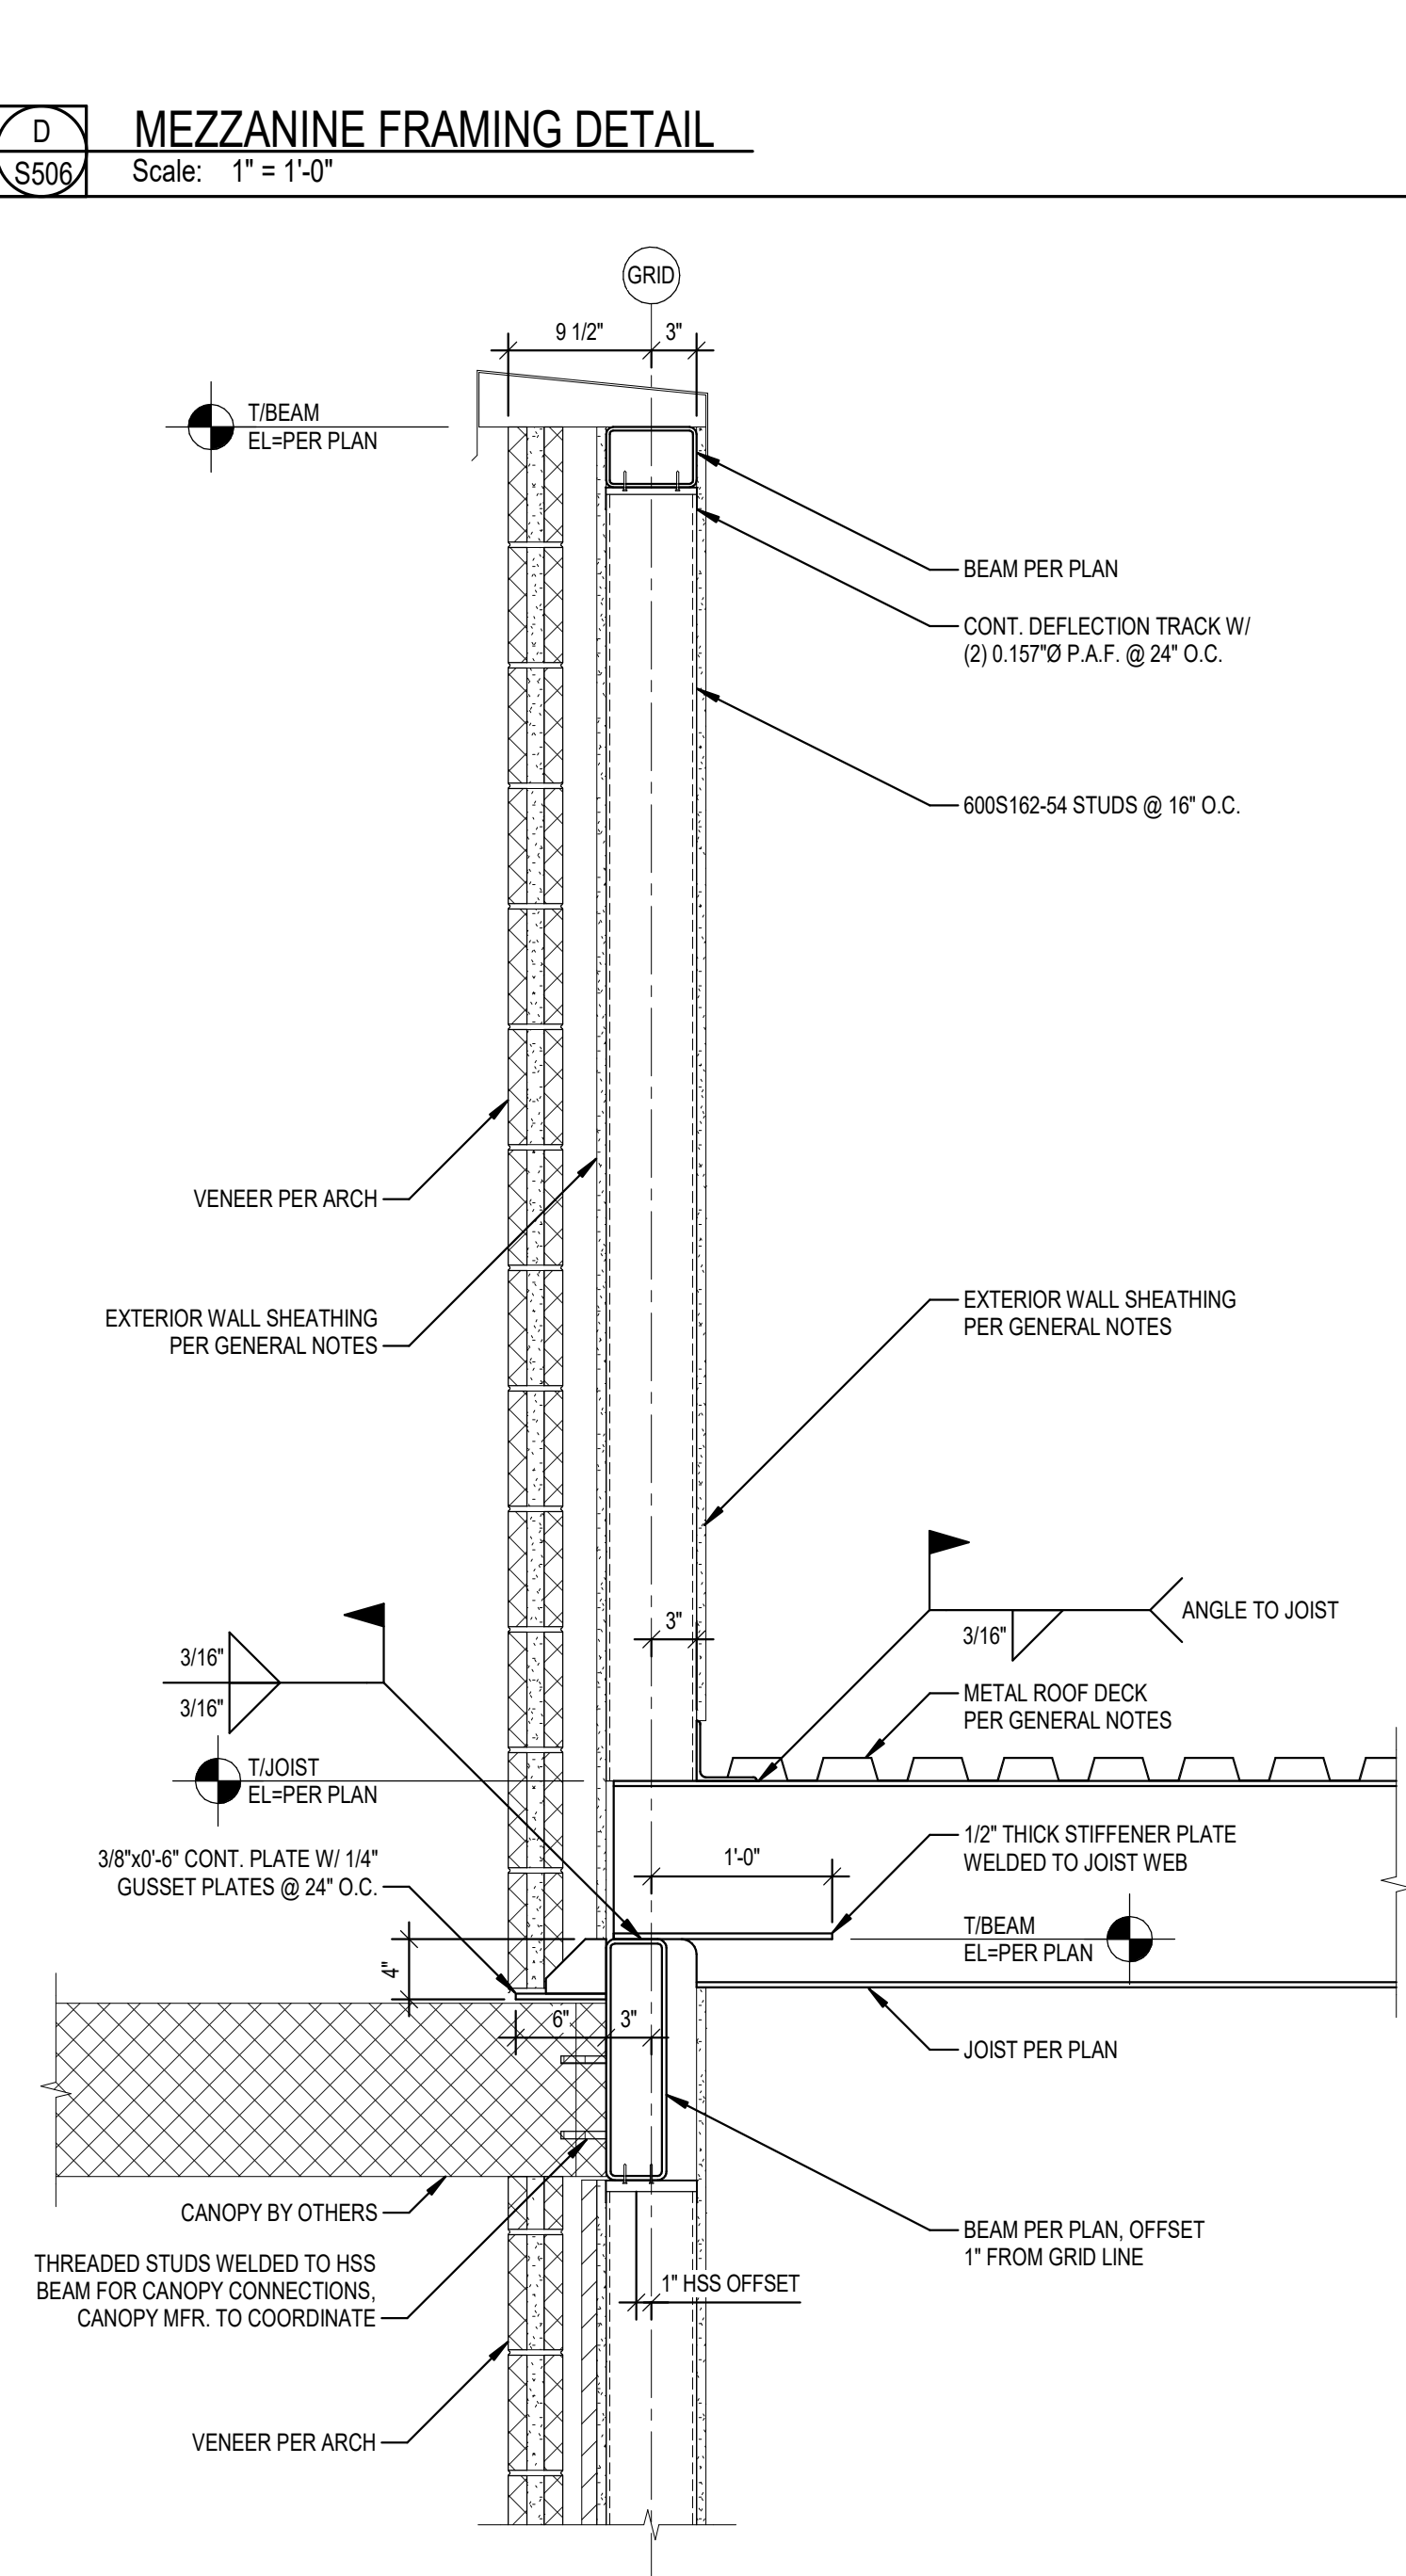

**D MEZZANINE FRAMING DETAIL**  
Scale: 1" = 1'-0"

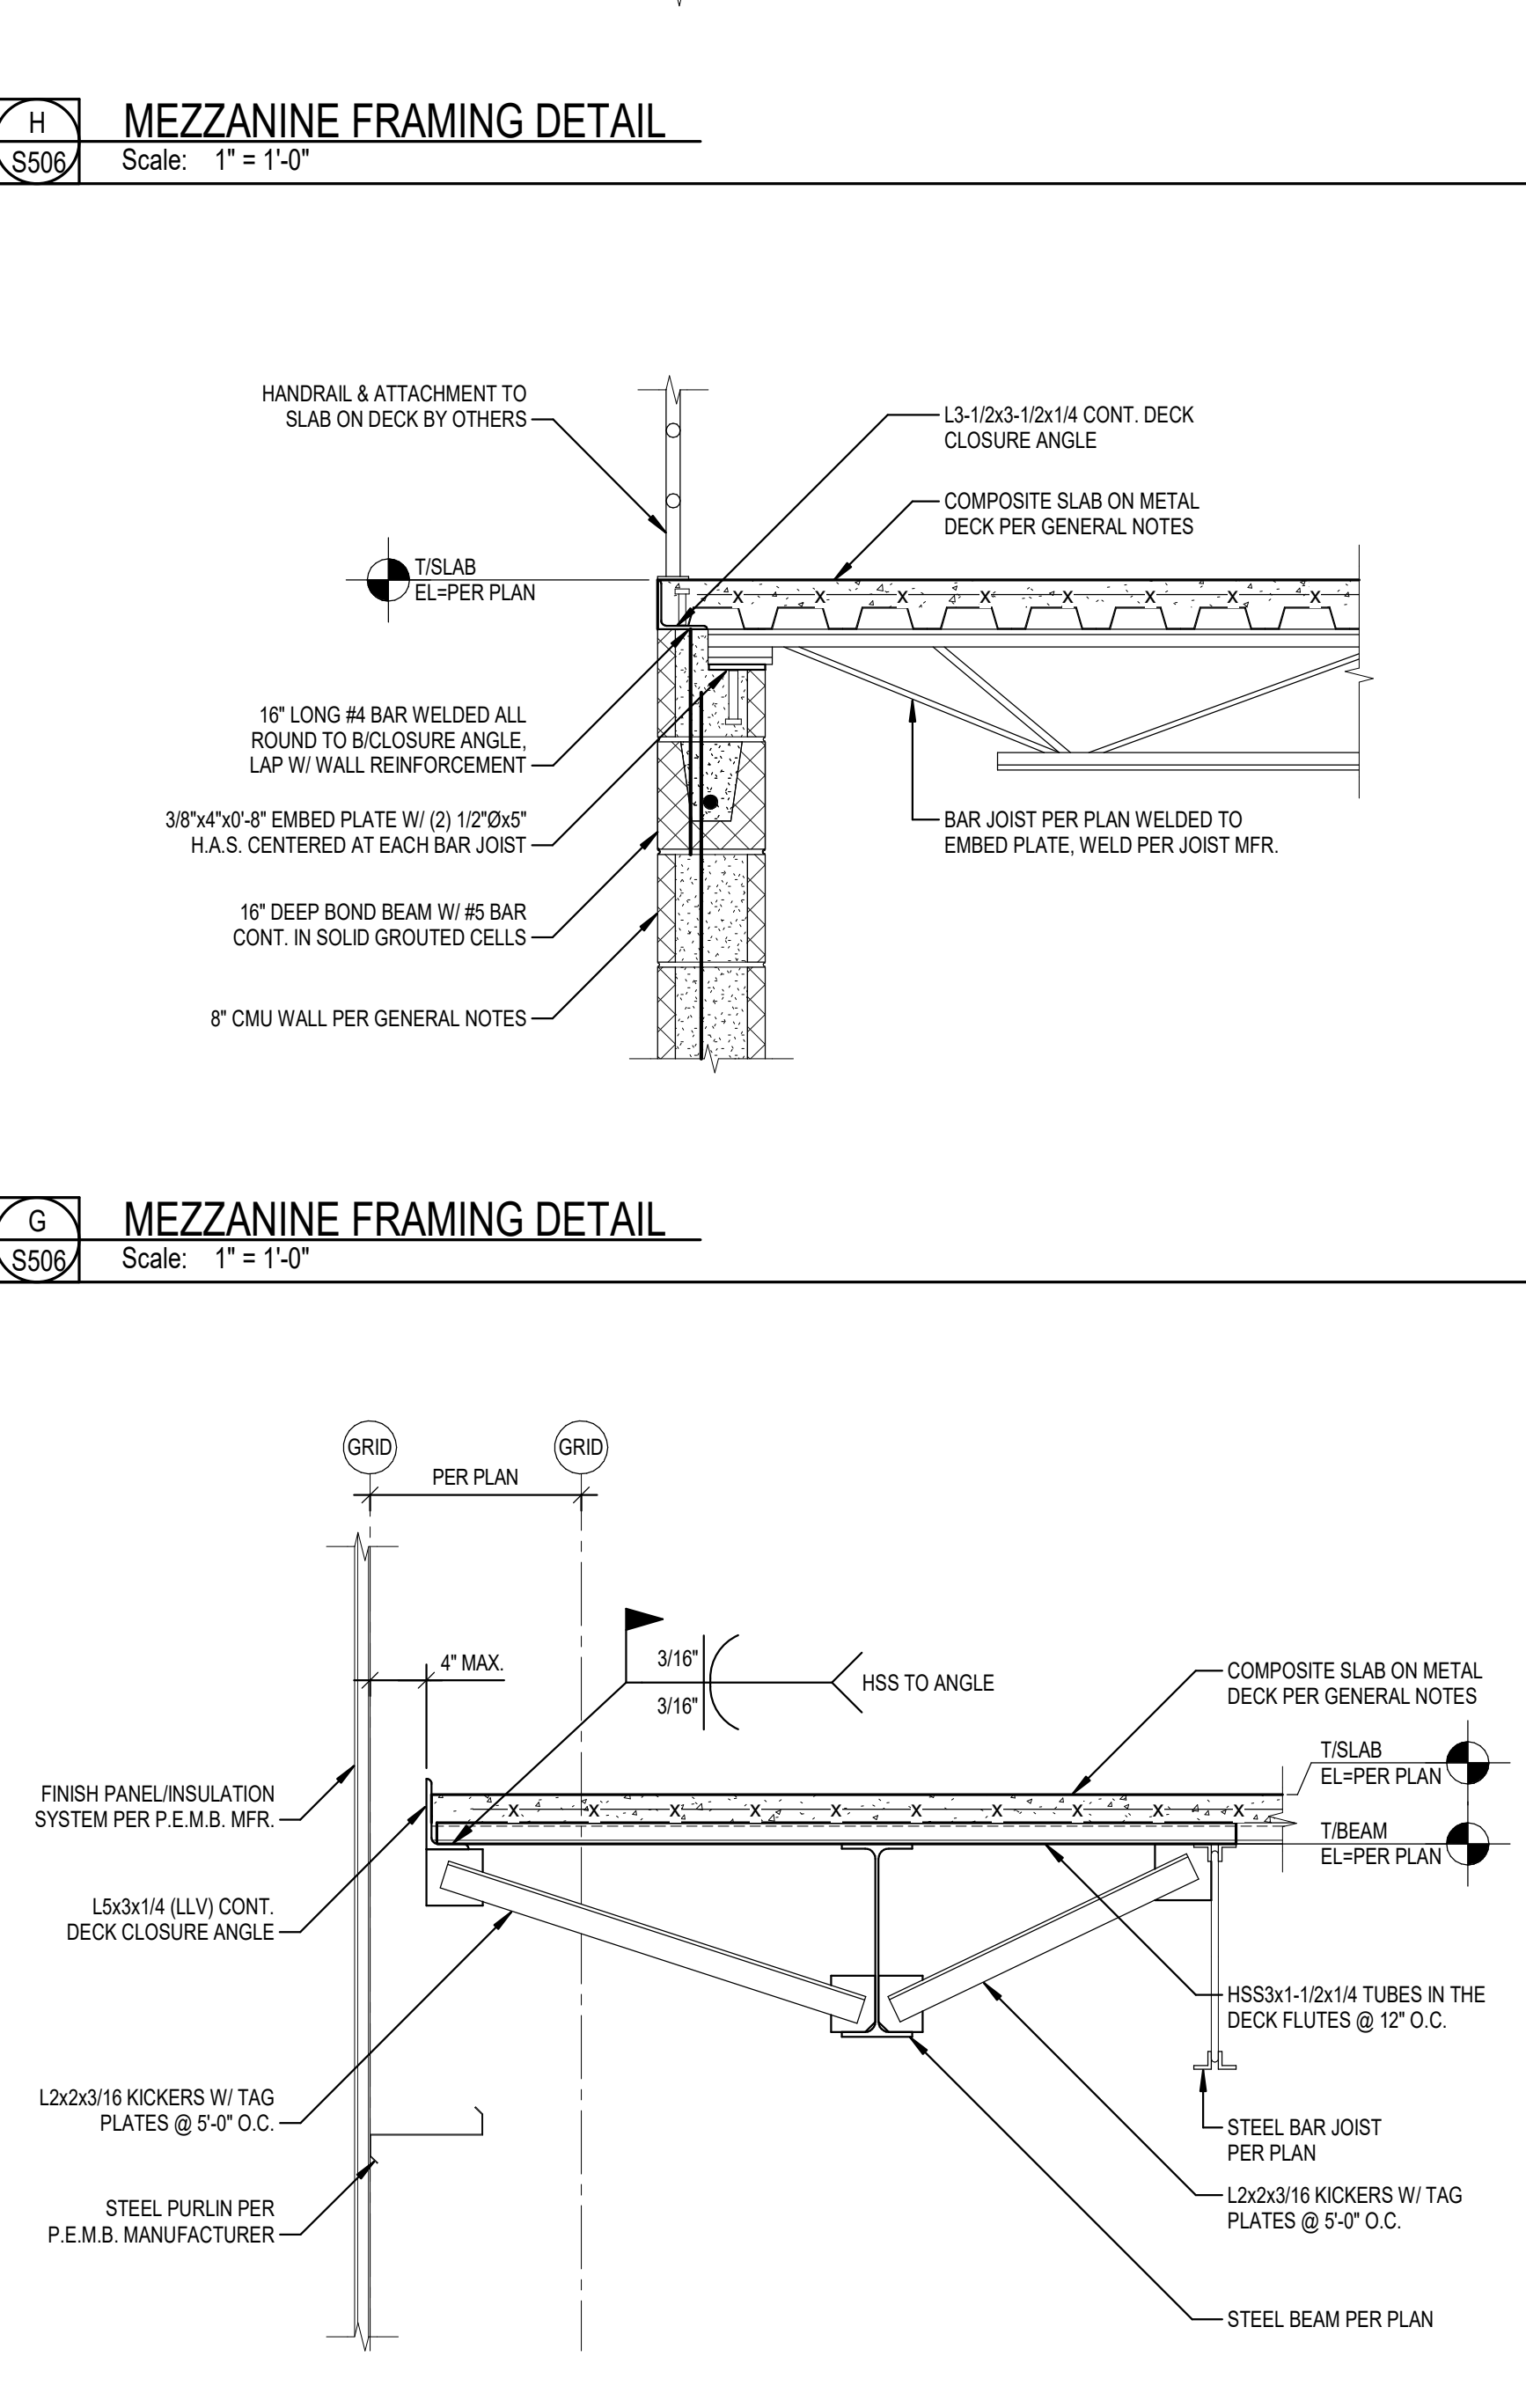

**H MEZZANINE FRAMING DETAIL**  
Scale: 1" = 1'-0"

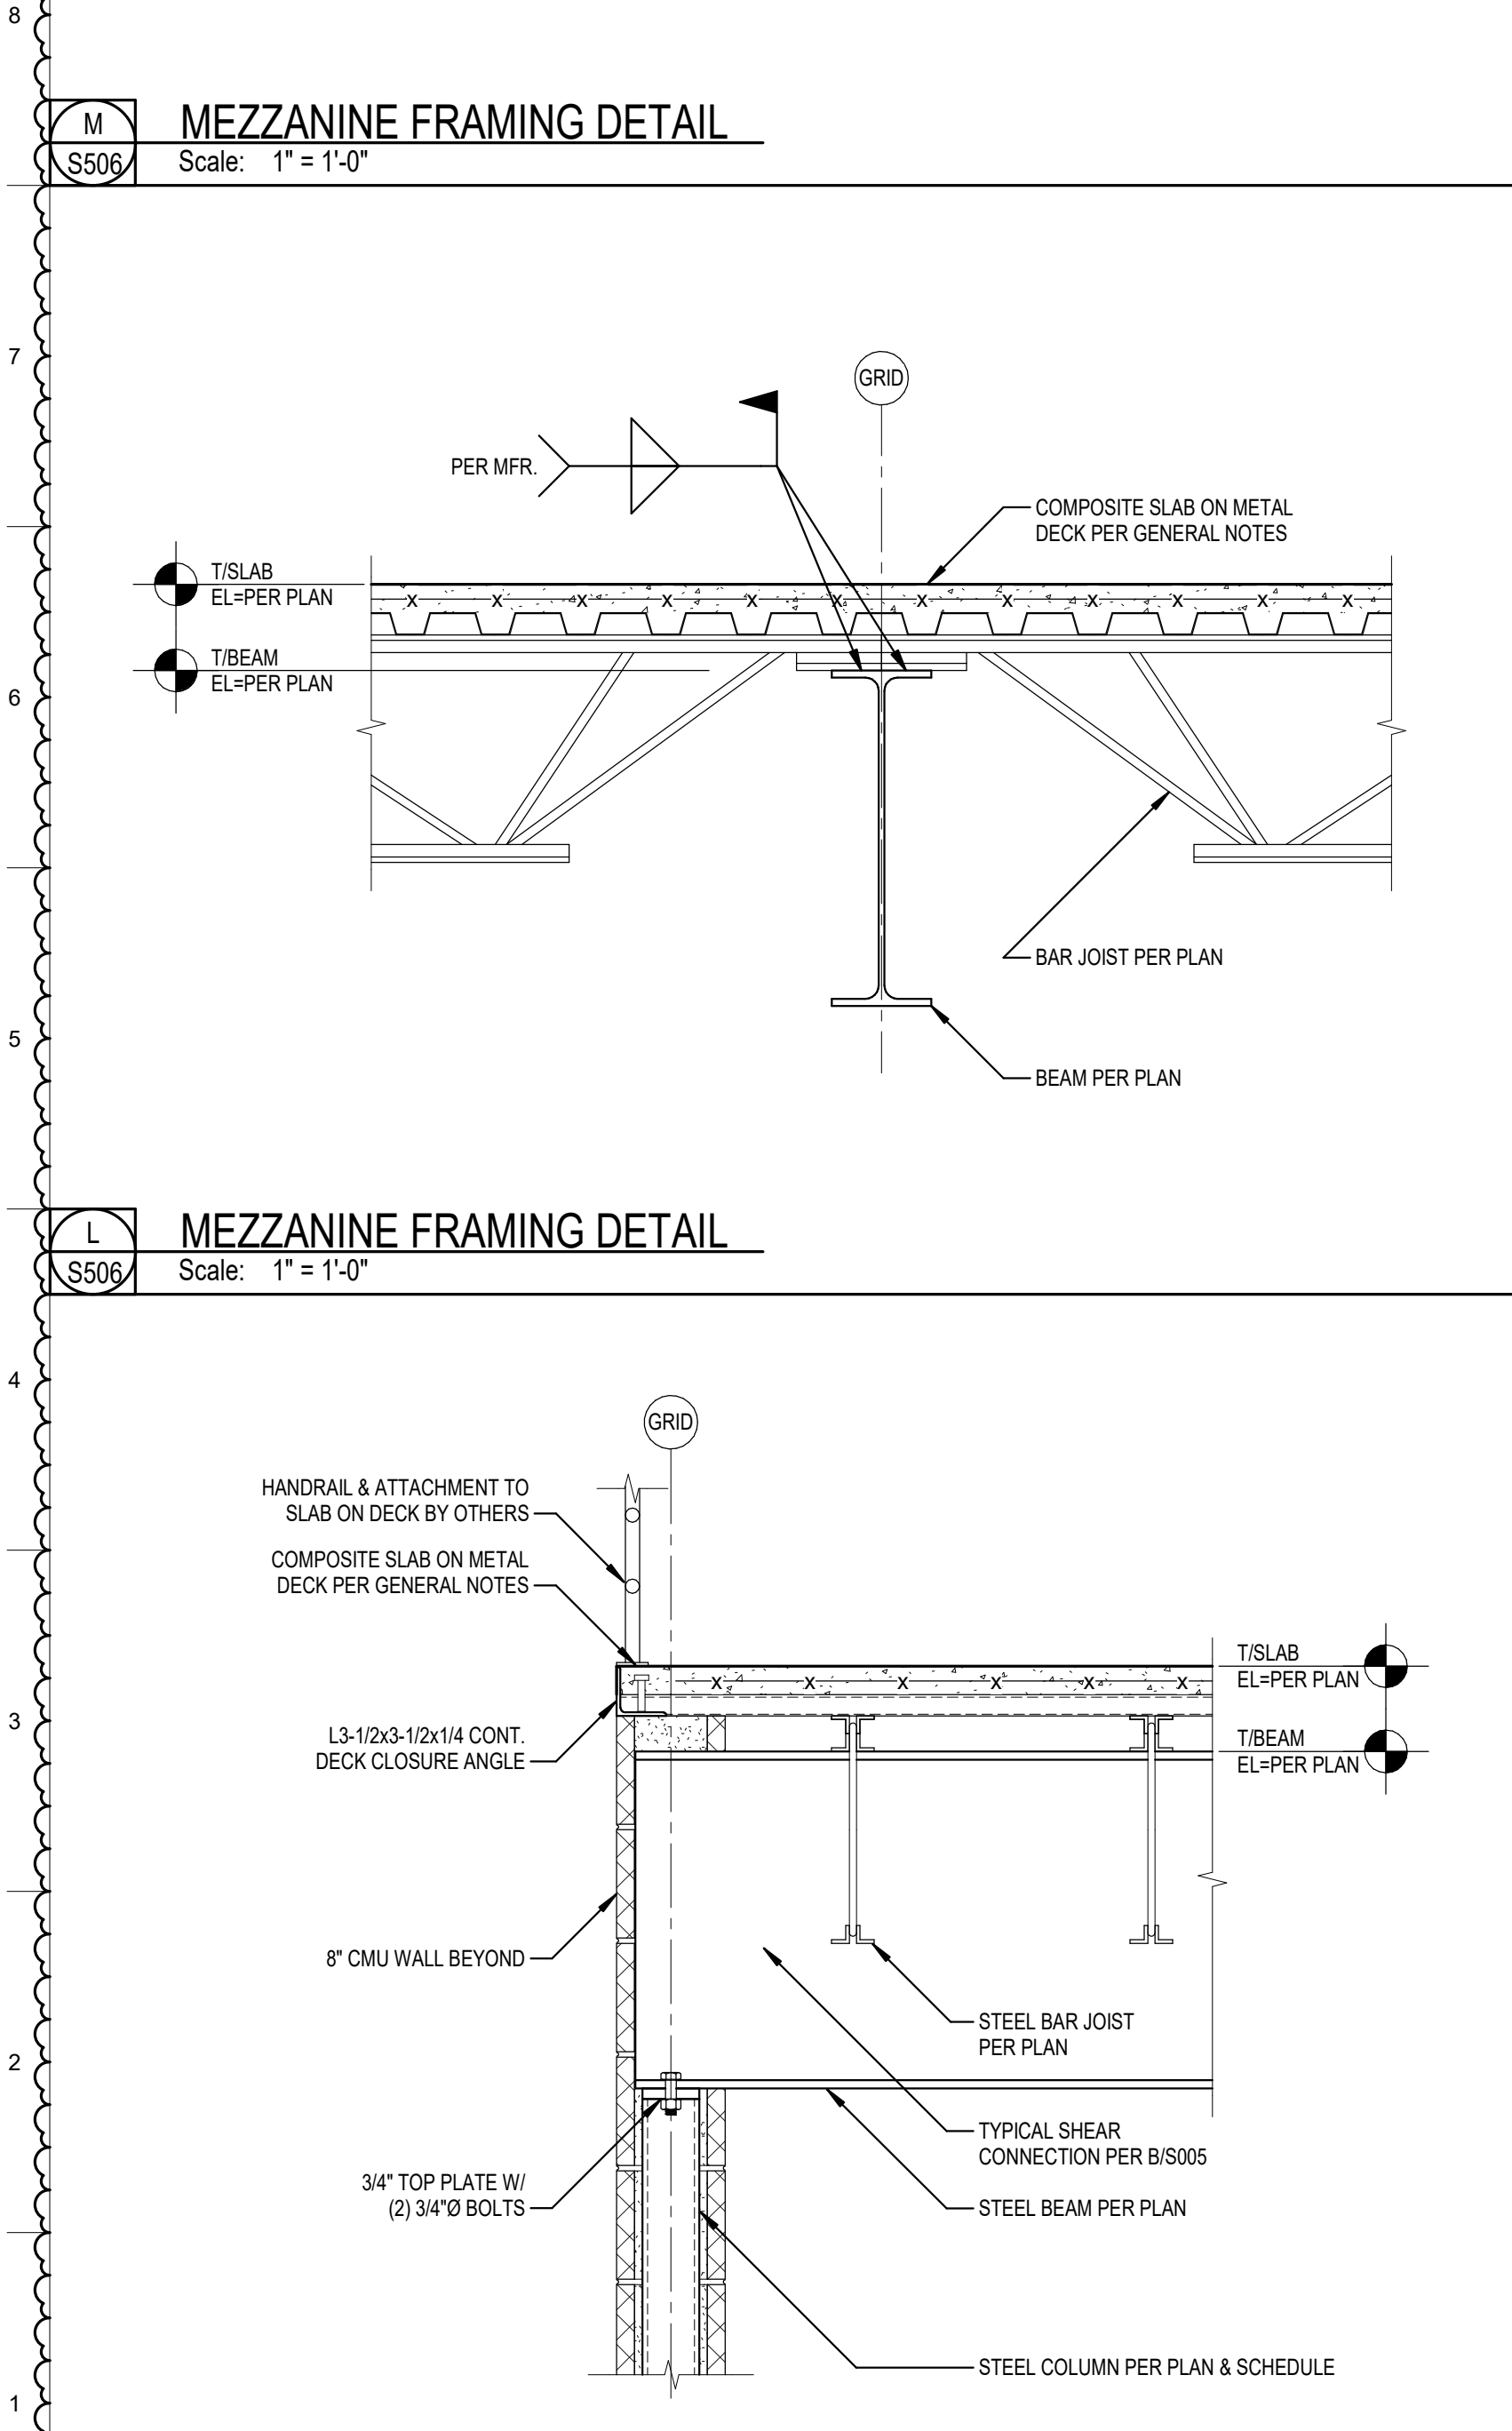

**M MEZZANINE FRAMING DETAIL**  
Scale: 1" = 1'-0"




**K MEZZANINE FRAMING DETAIL**  
Scale: 1" = 1'-0"



**OWNER**  
CITY OF WENTZVILLE, MISSOURI  
1001 SCHROEDER CREEK BLVD  
WENTZVILLE, MO 63385  
636.327.5101


**PROJECT TEAM**  
CIVIL ENGINEER  
PREMIER DESIGN GROUP  
100 MIDLAND PARK DRIVE  
WENTZVILLE, MO 63385  
314.925.7444  
MAINTENANCE CONSULTANT  
HDR ENGINEERING, INC.  
17725 KATY FREEWAY SUITE 102  
HOUSTON, TX 77054  
816.360.2700  
STRUCTURAL ENGINEER  
METTEMEYER ENGINEERING  
2225 W CHESTERFIELD BLVD., SUITE 300  
SPRINGFIELD, MO 65807  
417.890.8002  
MEP ENGINEER  
HENDERSON ENGINEERS, INC.  
8345 LENEXA DR., #300  
LENEXA, KS 66214  
913.742.5000

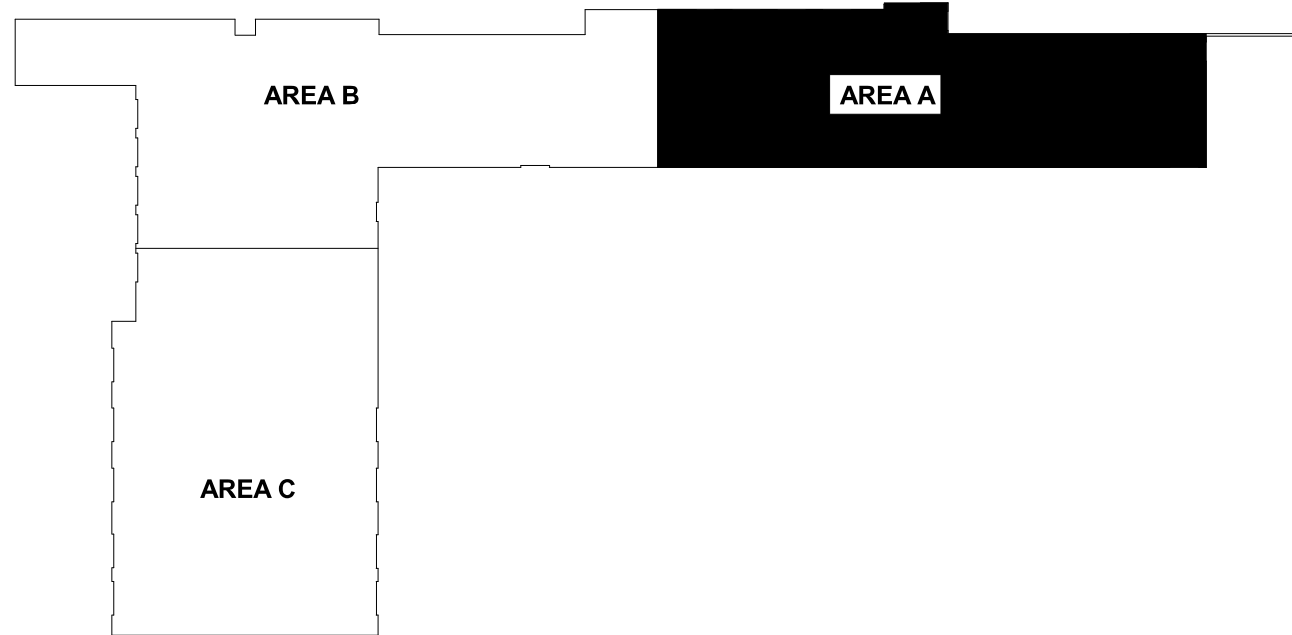

## KEY PLAN

### MECHANICAL PLAN NOTES:

- M4 PROVIDE FRAMED OPENING IN WALL ABOVE CEILING.
- M5 REFRIGERANT PIPE ROUTING SHOWN IS DIAGRAMMATIC. FINAL SIZING AND ROUTING OF REFRIGERANT LINES SHALL BE DETERMINED PER THE MANUFACTURER'S INSTRUCTIONS.
- M6 ROUTE REFRIGERANT PIPING DOWN WITHIN STUD WALL AND PENETRATE THE EXTERIOR WALL 1'-0" AFF.
- M19 TERMINATE 6 INCH DRYER VENT WITH THRU WALL VENT CAP.
- M22 ALL EXPOSED DUCTWORK SHALL BE PROVIDED WITH PAINT GRIP FINISH FOR FIELD PAINTING. REFER TO SPECIFICATIONS FOR MORE INFORMATION.
- M23 MOUNT CO SENSOR AND NO2 SENSOR AT 4 FEET AFF. SENSORS SHALL PROVIDE AN AUDIBLE ALARM TO THE OCCUPANTS IF THEIR SETPOINT IS EXCEEDED. REFER TO CONTROLS SHEET M702 FOR SETPOINTS.
- M24 LOCATION OF SUPPLY AIR DUCT STATIC PRESSURE SENSOR. REFER TO CONTROLS SHEET M701 FOR MORE INFORMATION.
- M25 LOCATION OF BUILDING DIFFERENTIAL PRESSURE SENSOR. REFER TO CONTROLS SHEETS FOR MORE INFORMATION.
- M26 COORDINATE INSTALLATION OF EQUIPMENT, DUCTWORK, AND PIPING WITH ALL TRADES. DO NOT ROUTE DUCTWORK OR PIPING OVER ELECTRICAL EQUIPMENT OR SERVER RACKS.
- M53 PROVIDE FIRE WRAP ON DRYER VENT DUCTWORK LOCATED WITHIN THE RETURN AIR PLenum.
- M55 PROVIDE ACCESS PANEL IN GYP CEILING BELOW VAV BOX. COORDINATE SIZE AND LOCATION OF ACCESS PANEL WITH VAV MANUFACTURER'S MAINTENANCE REQUIREMENTS. REFERENCE ARCHITECTURAL DRAWINGS AND SPECIFICATIONS FOR ADDITIONAL INFORMATION.

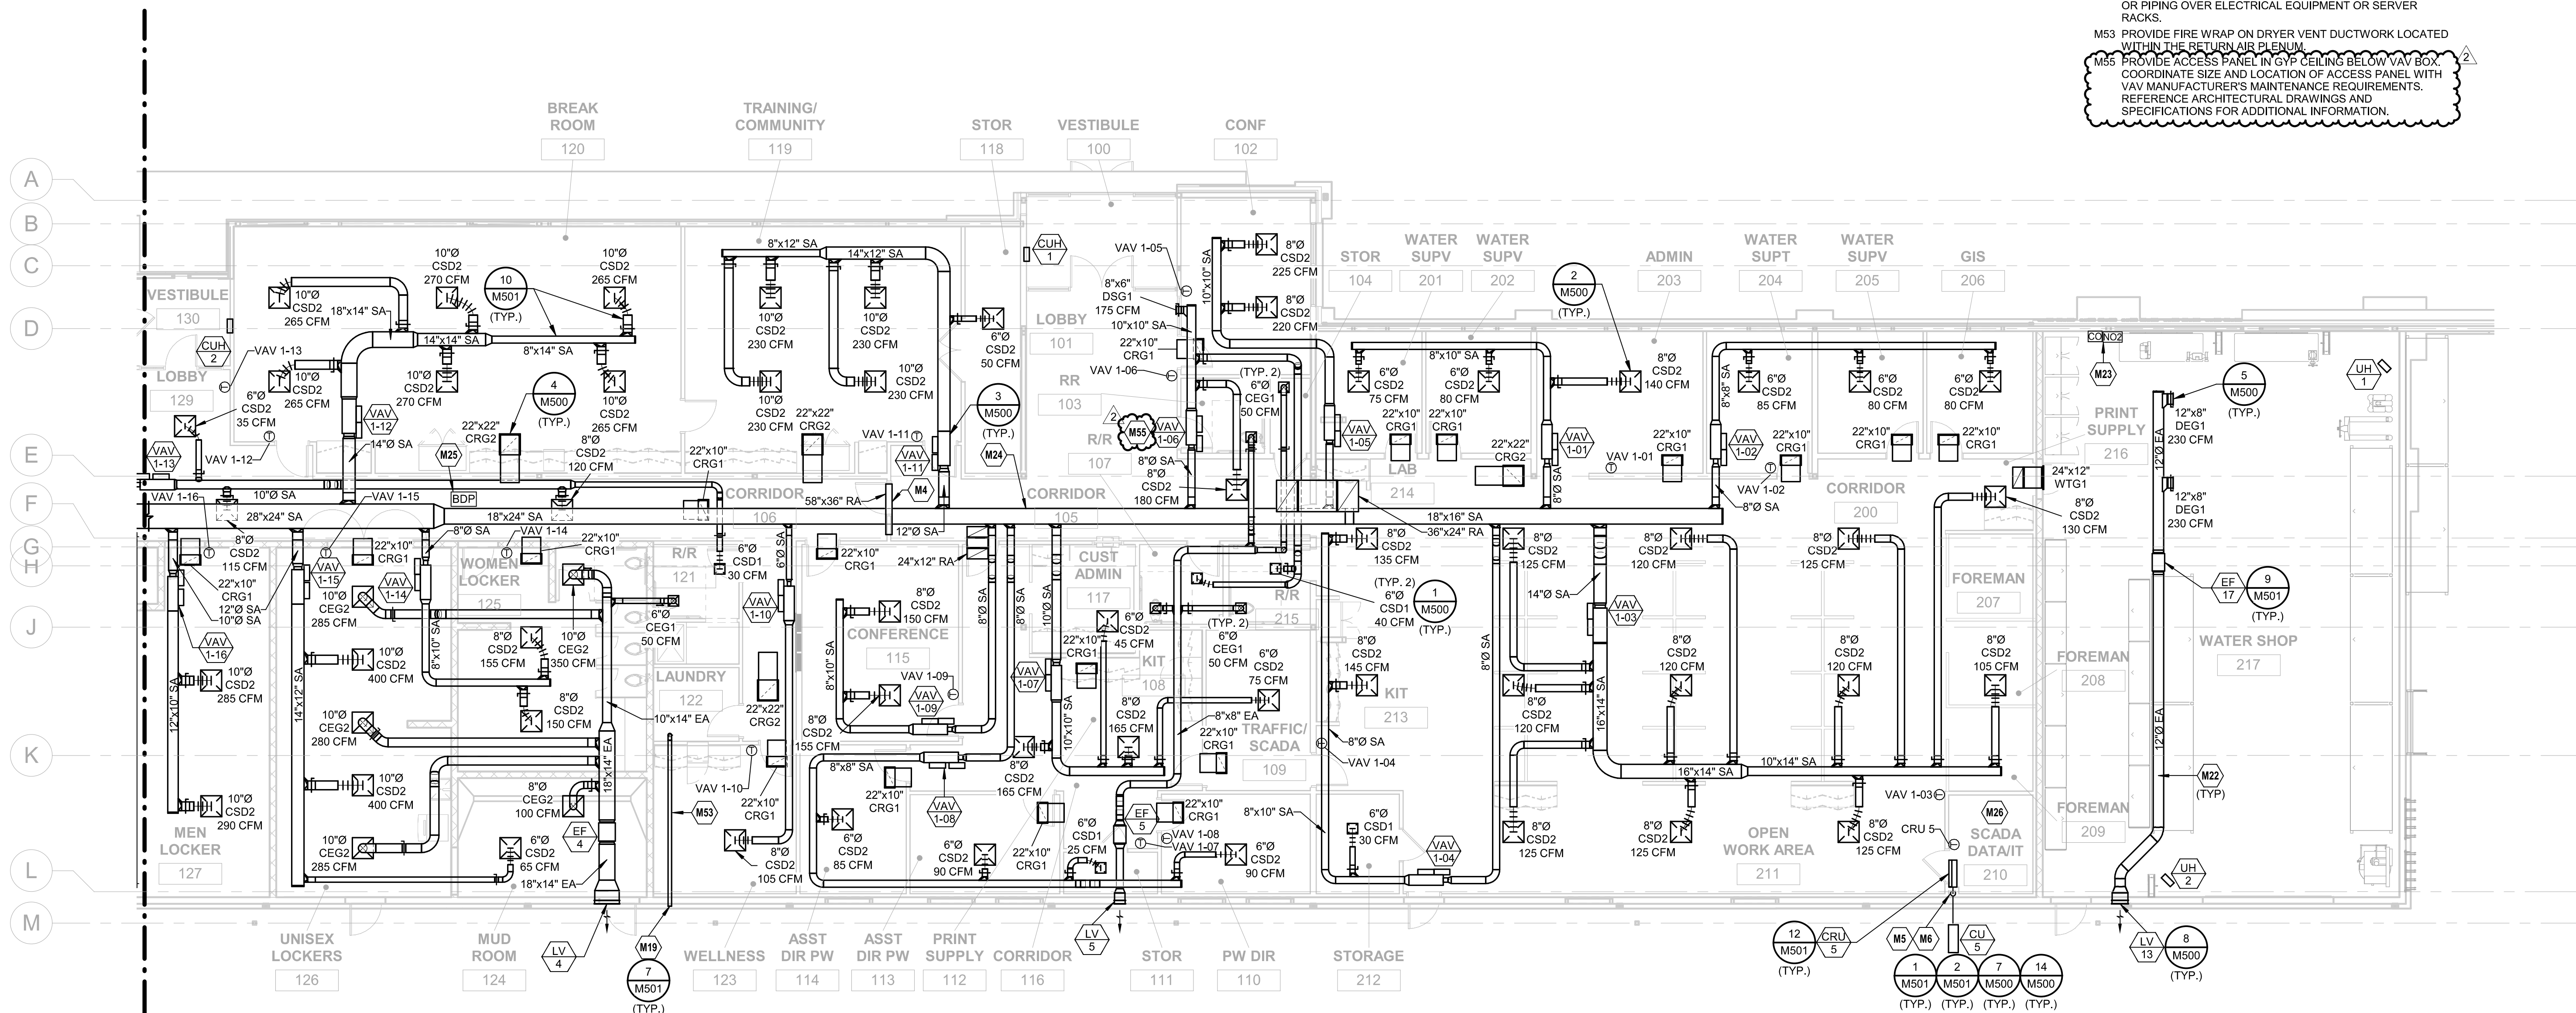



**OWNER**  
CITY OF WENTZVILLE, MISSOURI  
1001 SCHROEDER CREEK BLVD  
WENTZVILLE, MO 63385  
636.327.5101

**PROJECT TEAM**

CIVIL ENGINEER  
PREMIER DESIGN GROUP  
100 MIDLAND PARK DRIVE  
WENTZVILLE, MO 63385  
314.925.7444

MAINTENANCE CONSULTANT  
HDR ENGINEERING, INC.  
17725 KATY FREEWAY SUITE 102  
HOUSTON, TX 77054  
816.360.2700

STRUCTURAL ENGINEER  
METTEMMEYER ENGINEERING  
2225 W CHESTERFIELD BLVD., SUITE 300  
SPRINGFIELD, MO 65807  
417.890.8002

MEP ENGINEER  
HENDERSON ENGINEERS, INC.  
8345 LENEXA DR., #300  
LENEXA, KS 66214  
913.742.5000



8345 LENEXA DRIVE, SUITE 300  
LENEXA, KS 66214  
TEL 913.742.5000 FAX 913.742.5001  
WWW.HENDERSONENGINEERS.COM  
1950004840  
EXPIRES 12/31/2023

**REVISIONS**

NO.	DESCRIPTION	DATE
2	ADD 02	01.25.23

PROJECT NO.: 19-040 DRAWN BY: MJS  
DATE: 12.15.22 REVIEWED BY: CJH



01/24/2023

CARL J. HOLDEN  
LICENSE # PE-2020016283

**PROJECT TITLE**  
CITY OF WENTZVILLE, MO PUBLIC  
WORKS FACILITY

PROJECT ADDRESS:  
1235 INTERSTATE DRIVE  
WENTZVILLE, MO 63385

HVAC LEVEL 1 PLAN - AREA B


M101B

RADIANT HEATER COORDINATION:  
ALL CONTRACTORS SHALL COORDINATE ROUTING OF DUCTWORK, PIPING,  
CONDUIT, WIRING AND OTHER ELEMENTS WITH OVERHEAD RADIANT HEATER  
REQUIRED CLEARANCES. COORDINATE WITH DIVISION 23 CONTRACTOR TO  
MAINTAIN HEATER MANUFACTURER'S REQUIRED CLEARANCES TO COMBUSTIBLES.  
CONTRACTORS ARE RESPONSIBLE FOR RESOLVING CONFLICTS AS THEY ARISE.

**MECHANICAL PLAN NOTES:**

- M2 DIVISION 23 CONTRACTOR SHALL PROVIDE LINE VOLTAGE THERMOSTAT FOR  
RADIANT HEATERS. DIVISION 26 CONTRACTOR SHALL PROVIDE WALL SWITCH AND  
CONTRACTOR SYSTEM FOR CONTROL OF HEATERS. REFER TO ELECTRICAL PLANS  
AND MECHANICAL CONTROLS FOR MORE INFORMATION.
- M3 COORDINATE EXACT MOUNTING LOCATION AND HEIGHT WITH OTHER TRADES  
PRIOR TO INSTALLATION. REFER TO ARCHITECTURAL, EQUIPMENT, LIGHTING, AND  
ELECTRICAL PLANS FOR DOOR OPERATORS, EQUIPMENT, SWITCHES AND OTHER  
DEVICES.
- M4 PROVIDE FRAMED OPENING IN WALL ABOVE CEILING.
- M5 REFRIGERANT PIPE ROUTING SHOWN IS DIAGRAMMATIC. FINAL SIZING AND  
ROUTING OF REFRIGERANT LINES SHALL BE DETERMINED PER THE  
MANUFACTURER'S INSTRUCTIONS.
- M7 ROUTE REFRIGERANT PIPING WITHIN CHASE. PENETRATE EXTERIOR WALL AT 1'-0"  
AFF.
- M10 (1) CO SENSOR AND (2) NO2 SENSORS. MOUNT CO SENSOR AT 5 FEET AFF. MOUNT  
(1) NO2 SENSOR AT 5 FEET AFF AND (1) NO2 SENSOR AT 28 FEET AFF. SENSORS  
SHALL BE MOUNTED ON THE COLUMN. COORDINATE MOUNTING WITH  
COMPONENTS OF OTHER TRADES.
- M11 PROVIDE 4"Ø DIAMETER GAS WATER HEATER CONCENTRIC VENT AND INTAKE  
THROUGH ROOF. TERMINATE MINIMUM 24 INCH ABOVE ROOF SURFACE PER  
MANUFACTURER'S RECOMMENDATION. REFER TO SPECIFICATION FOR MORE  
INFORMATION.
- M13 6"Ø EXHAUST DUCT FROM VEHICLE EXHAUST HOSE REEL THROUGH SIDEWALL  
TERMINATING WITH SIDEWALL CAP.
- M14 PROVIDE BUILDING BAS PANEL. QUANTITY OF PANELS TO BE DETERMINED BY  
CONTROLS CONTRACTOR. COORDINATE POWER AND DATA REQUIREMENTS WITH  
OTHER TRADES. CONTROLS CONTRACTOR IS RESPONSIBLE FOR ADDITIONAL  
POWER AND DATA PROVISIONS.
- M17 PROVIDE DUCT ACCESS DOOR WITH LIMIT SWITCH FOR ACCESS TO UVC LIGHT.  
UVC LIGHT SHALL BE OFF WHILE ACCESS DOOR IS OPEN. DIVISION 26 SHALL  
PROVIDE DISCONNECT FOR LIGHT ON SIDE OF DUCTWORK.
- M18 PROVIDE WARNING SIGN ON DUCT NEXT TO ACCESS DOOR INDICATING "CAUTION:  
UVC LIGHT. DO NOT LOOK AT OR OPEN ACCESS DOOR WITHOUT FIRST TURNING  
OFF LIGHT."
- M21 FAN CONTROLLER PROVIDED WITH FAN. REFER TO ELECTRICAL PLANS FOR  
LOCATION OF CONTROLLER AND CONTROL OF FANS.
- M22 ALL EXPOSED DUCTWORK SHALL BE PROVIDED WITH PAINT GRIP FINISH FOR  
FIELD PAINTING. REFER TO SPECIFICATIONS FOR MORE INFORMATION.
- M23 MOUNT CO SENSOR AND NO2 SENSOR AT 4 FEET AFF. SENSORS SHALL PROVIDE  
AN AUDIBLE ALARM TO THE OCCUPANTS IF THEIR SETPOINT IS EXCEEDED. REFER  
TO CONTROLS SHEET M202 FOR SETPOINTS.
- M26 COORDINATE INSTALLATION OF EQUIPMENT, DUCTWORK, AND PIPING WITH ALL  
TRADES. DO NOT ROUTE DUCTWORK OR PIPING OVER ELECTRICAL EQUIPMENT  
OR SERVER RACKS.
- M27 ROUTE 60"x24" SA DUCT UP TO RTU-1 ON ROOF. TRANSITION TO UNIT  
CONNECTION SIZE IN ROOF CURB. SEAL ROOF PENETRATION AIR AND WATER  
TIGHT.
- M28 ROUTE 76"x24" RA DUCT UP TO RTU-1 ON ROOF. TRANSITION TO UNIT  
CONNECTION SIZE IN ROOF CURB. SEAL ROOF PENETRATION AIR AND WATER  
TIGHT.
- M29 ROUTE 28"Ø EA DUCT UP TO EF-7 ON ROOF. TRANSITION TO UNIT CONNECTION  
SIZE IN ROOF CURB. SEAL ROOF PENETRATION AIR AND WATER TIGHT.
- M40 ROUTE EXHAUST DUCT DOWN TO 12" AFF AND TERMINATE WITH 1/2" GALVANIZED  
STEEL MESH SCREEN SECURED OVER DUCT OPENING. BALANCE BRANCH TO  
AIRFLOW INDICATED.
- M41 ROUTE ALL EXPOSED DUCTWORK TIGHT TO STRUCTURE.
- M45 ROUTE 12"Ø RETURN AIR DUCT UP AND TERMINATE OPEN ENDED WITHIN  
PLENUM.
- M46 DUCT UP TO CEILING PLENUM. ROUTE DUCT TIGHT TO WALL. LEAVE END OF  
RETURN DUCT OPEN TO PLENUM. COVER WITH BIRDSCREEN.
- M47 TERMINATE RETURN AIR DUCT OPEN ENDED WITHIN PLENUM.
- M48 BALANCE MANUAL DAMPER TO 1485 CFM.
- M49 BALANCE MANUAL DAMPER TO 14,515 CFM.


**KEY PLAN**

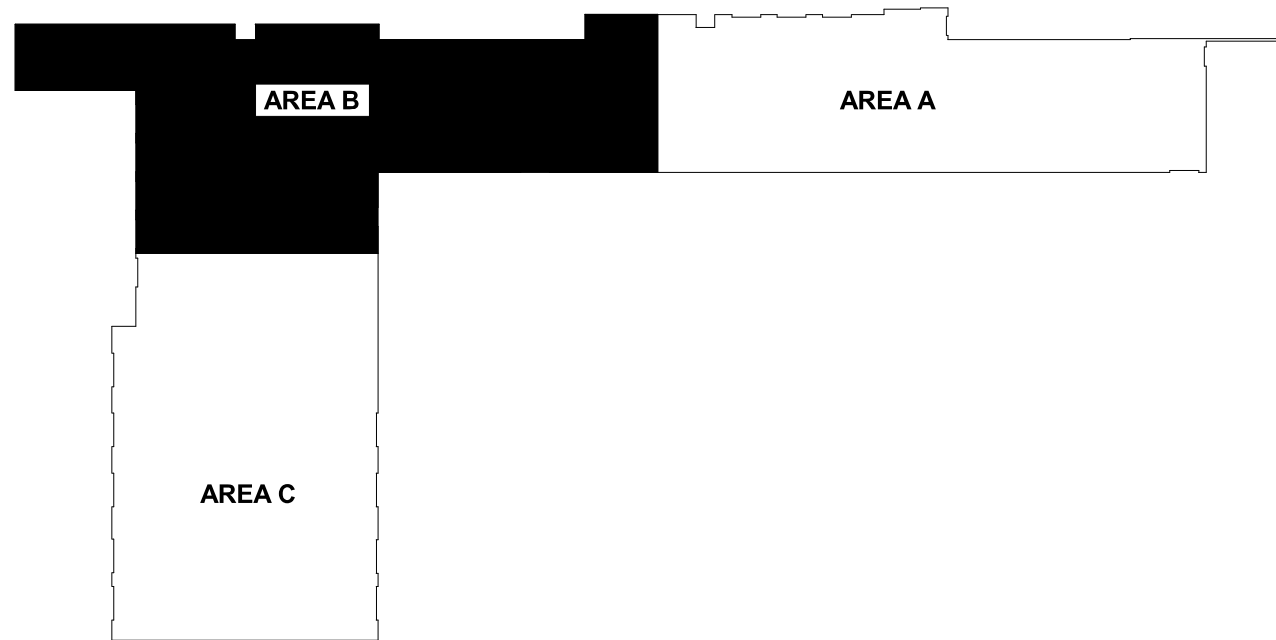

1 HVAC LEVEL 1 PLAN - AREA B  
1/8" = 1'-0"





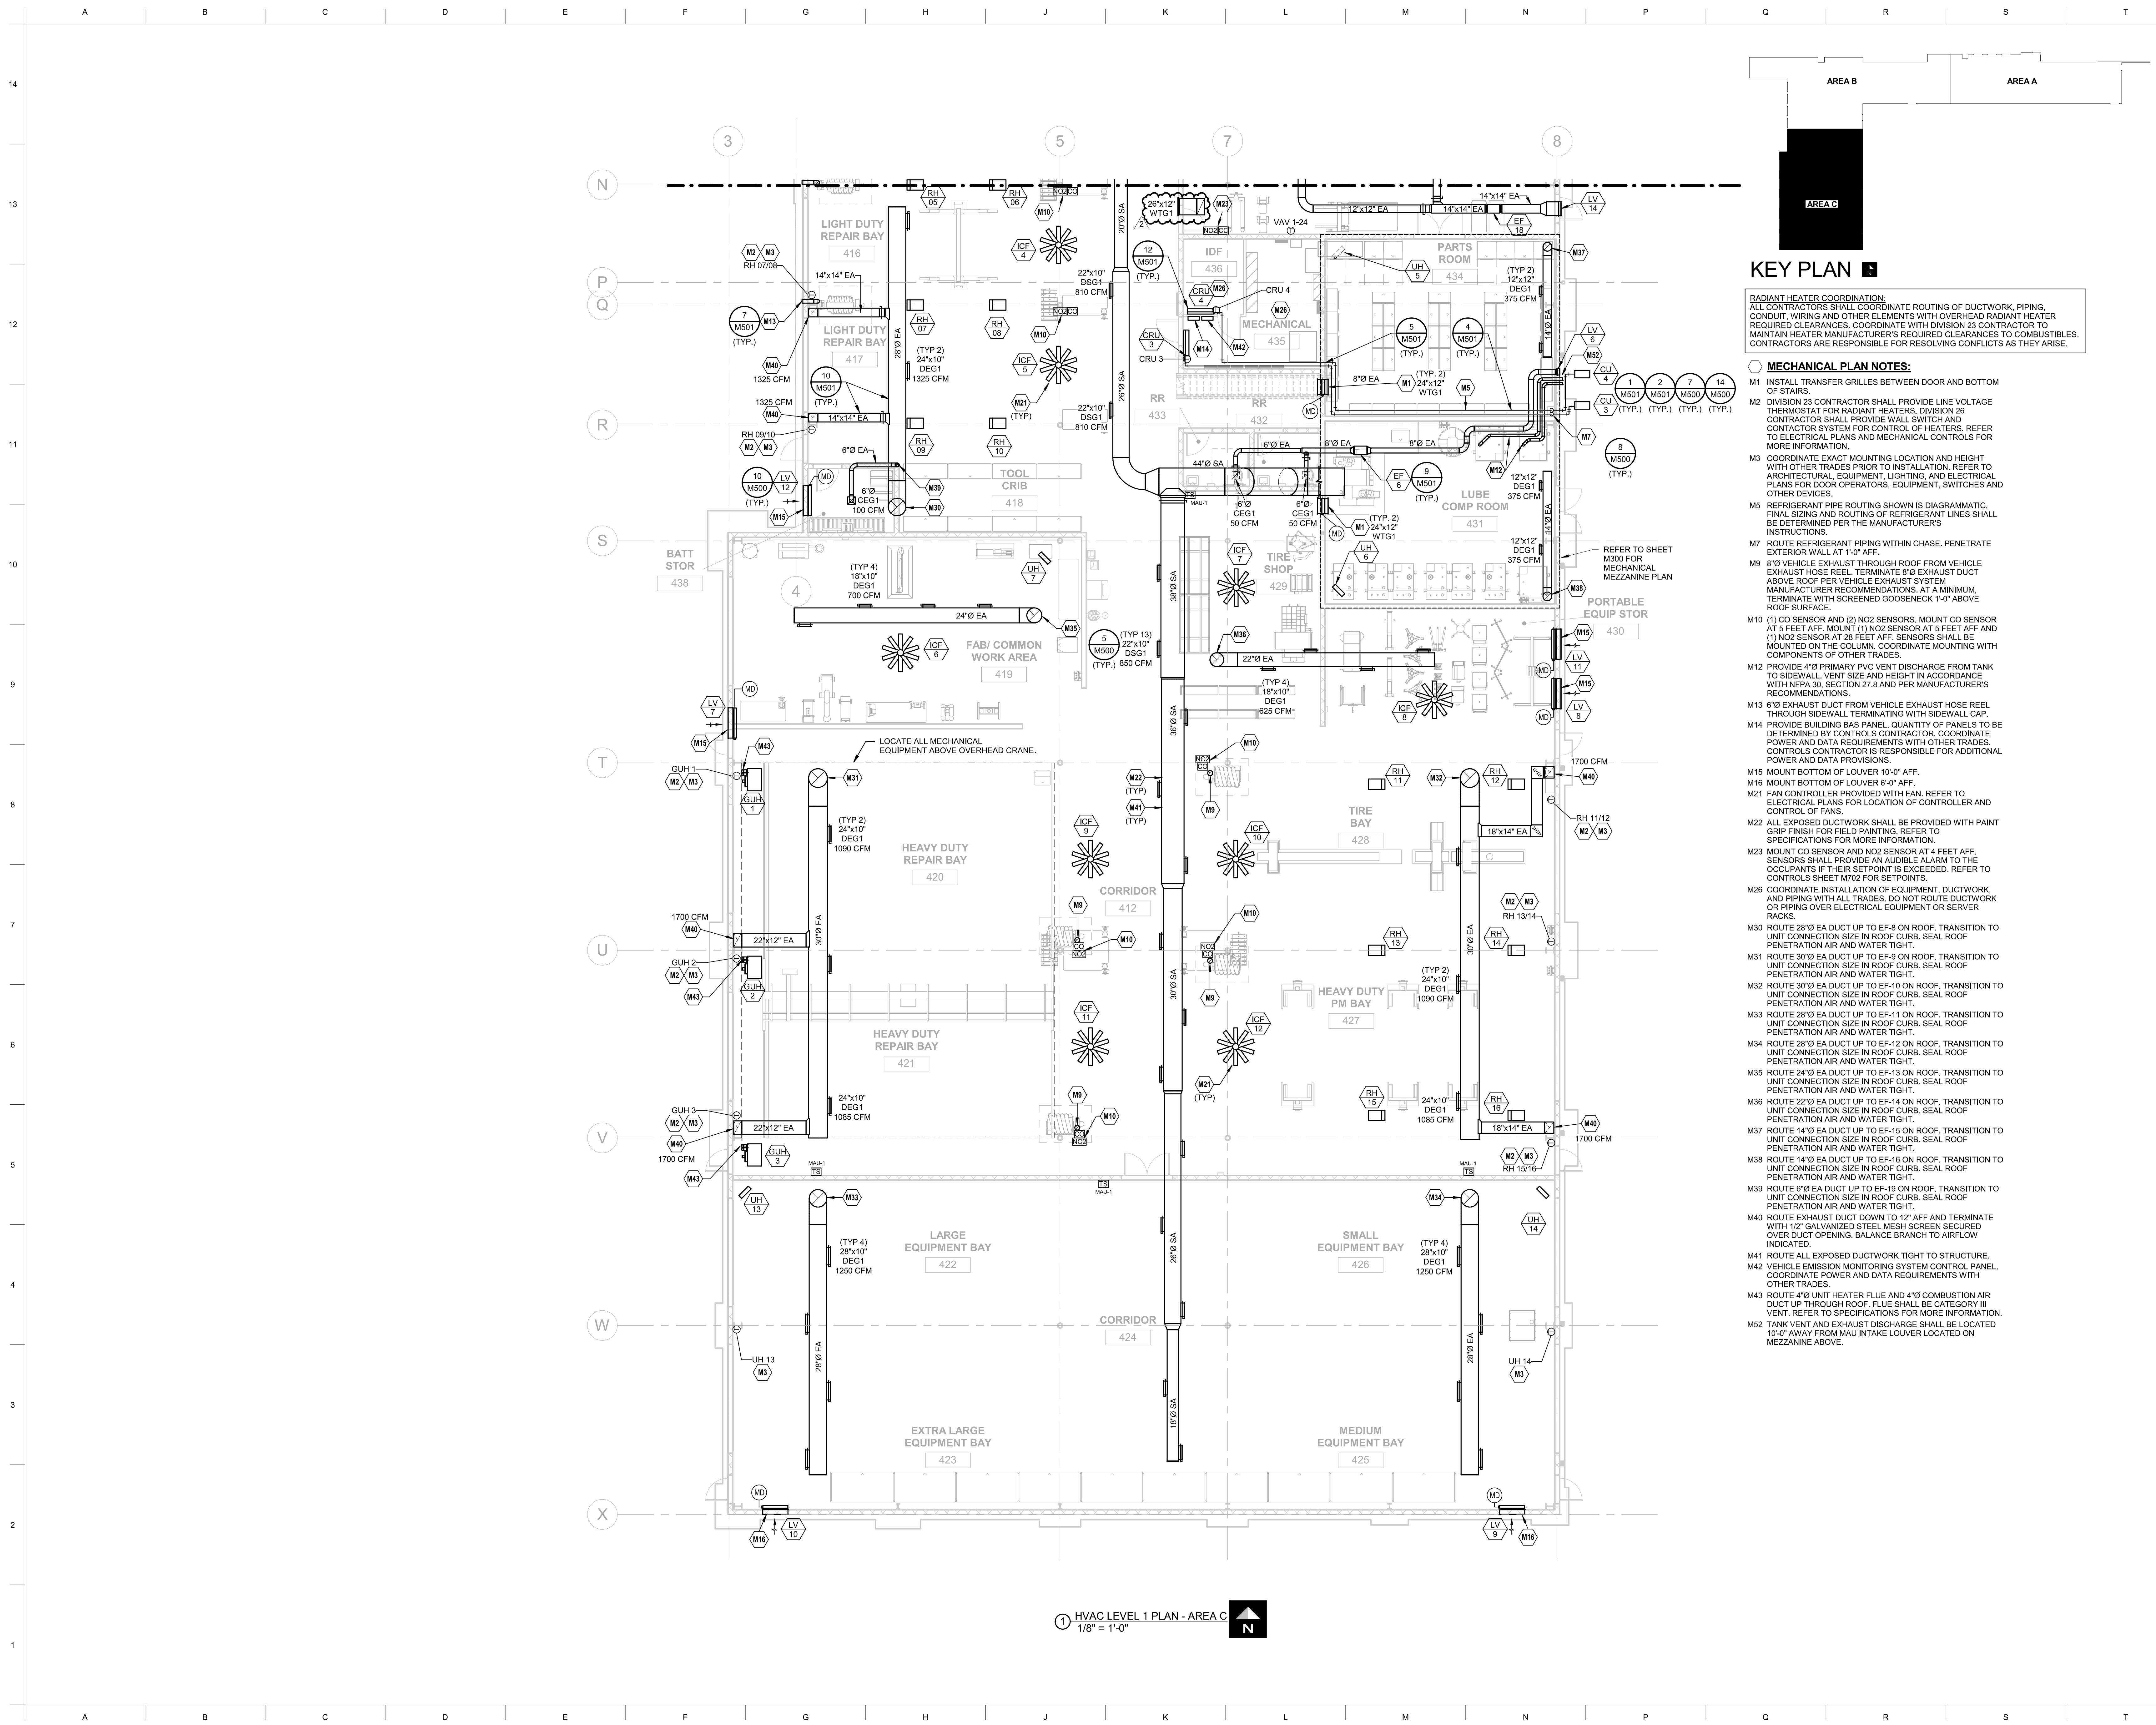

5039 S National Avenue | Springfield, MO 65810 | 417.887.6599

**OWNER**  
CITY OF WENTZVILLE, MISSOURI  
1001 SCHROEDER CREEK BLVD  
WENTZVILLE, MO 63385  
636.327.5101

**PROJECT TEAM**  
CIVIL ENGINEER  
PREMIER DESIGN GROUP  
10100 MIDLAND PARK DRIVE  
WINTERVILLE, MO 63385  
417.925.7444  
MAINTENANCE CONSULTANT  
HENDERSON ENGINEERS, INC.  
117725 KATY FREEWAY SUITE 102  
HOUSTON, TX 77094  
616.360.2700  
STRUCTURAL ENGINEER  
METTEMPEY ENGINEERING  
2225 W CHERSTERFIELD BLVD., SUITE 300  
SPRINGFIELD, MO 65807  
417.177.890-8022  
MEP ENGINEER  
HENDERSON ENGINEERS, INC.  
3484 LEXEN AVE. #300  
LENEXA, KS 66214  
913.742.5000

**HENDERSON**  
ENGINEERS  
8345 LENEXA DRIVE, SUITE 300  
LENEXA, KS 66214  
TEL 913.742.5000 FAX 913.742.5001  
[WWW.HENDERSONENGINEERS.COM](http://WWW.HENDERSONENGINEERS.COM)  
1950004840  
EXPIRES 12/31/2023

[illegible]

PROJECT NO.: 19-040 DRAWN BY: MJ  
DATE: 12.15.22 REVIEWED BY: CJ



01/24/2023

CARL J. HOLDEN  
LICENSE # PE-2020016283

**PROJECT TITLE**  
**CITY OF WENTZVILLE, MO PUBLIC**  
**WORKS FACILITY**

PROJECT ADDRESS:  
1295 INTERSTATE DRIVE  
WENTZVILLE, MO 63385

HVAC LEVEL 1 PLAN - AREA C

# M101C

**SHE**

CARL J. HOLDEN







VARIABLE AIR VOLUME TERMINAL SCHEDULE (ELECTRIC HEAT)																
MARK	SERVED FROM	MANUFACTURER	MODEL	INLET SIZE (IN)					HEATING COIL					CP TRANS V/PH	NOTES	
					PRIMARY CFM	MIN PRIM CFM	MIN HEAT CFM	MAX HEAT CFM	EAT	LAT	MBH	KW	STEPS			V/PH
VAV-1-01	RTU-1	PRICE	SDV	5"	295	90	90	185	55.0	90.0	7.2	2.5	SCR	277/1	INTEGRAL	ALL
VAV-1-02	RTU-1	PRICE	SDV	5"	245	65	65	185	55.0	90.0	6.9	2.5	SCR	277/1	INTEGRAL	ALL
VAV-1-03	RTU-1	PRICE	SDV	12"	1340	540	540	605	55.0	85.0	19.5	6.0	SCR	480/1	INTEGRAL	ALL
VAV-1-04	RTU-1	PRICE	SDV	5"	310	140	140	140	55.0	85.0	4.5	1.5	SCR	277/1	INTEGRAL	ALL
VAV-1-05	RTU-1	PRICE	SDV	7"	445	115	115	225	55.0	90.0	8.4	2.5	SCR	277/1	INTEGRAL	ALL
VAV-1-06	RTU-1	PRICE	SDV	6"	435	90	90	200	55.0	85.0	6.3	2.0	SCR	277/1	INTEGRAL	ALL
VAV-1-07	RTU-1	PRICE	SDV	7"	450	160	160	160	55.0	85.0	5.1	1.5	SCR	277/1	INTEGRAL	ALL
VAV-1-08	RTU-1	PRICE	SDV	5"	290	75	75	205	55.0	90.0	7.7	2.5	SCR	277/1	INTEGRAL	ALL
VAV-1-09	RTU-1	PRICE	SDV	5"	305	155	155	155	55.0	85.0	4.9	1.5	SCR	277/1	INTEGRAL	ALL
VAV-1-10	RTU-1	PRICE	SDV	4"	105	30	30	45	55.0	90.0	1.8	0.5	SCR	277/1	INTEGRAL	ALL
VAV-1-11	RTU-1	PRICE	SDV	9"	920	460	460	460	55.0	85.0	14.9	4.5	SCR	480/1	INTEGRAL	ALL
VAV-1-12	RTU-1	PRICE	SDV	12"	1600	800	800	800	55.0	85.0	25.9	8.0	SCR	480/3	INTEGRAL	ALL
VAV-1-13	RTU-1	PRICE	SDV	5"	300	90	90	900	55.0	85.0	2.9	1.0	SCR	277/1	INTEGRAL	ALL
VAV-1-14	RTU-1	PRICE	SDV	5"	305	65	65	125	55.0	90.0	4.6	1.5	SCR	277/1	INTEGRAL	ALL
VAV-1-15	RTU-1	PRICE	SDV	9"	865	175	175	390	55.0	85.0	12.6	4.0	SCR	277/1	INTEGRAL	ALL
VAV-1-16	RTU-1	PRICE	SDV	7"	575	115	115	205	55.0	85.0	6.5	2.0	SCR	277/1	INTEGRAL	ALL
VAV-1-17	RTU-1	PRICE	SDV	8"	615	125	125	310	55.0	90.0	11.6	3.5	SCR	277/1	INTEGRAL	ALL
VAV-1-18	RTU-1	PRICE	SDV	5"	300	75	75	240	55.0	90.0	9.1	3.0	SCR	277/1	INTEGRAL	ALL
VAV-1-19	RTU-1	PRICE	SDV	7"	580	205	205	320	55.0	90.0	12.1	4.0	SCR	277/1	INTEGRAL	ALL
VAV-1-20	RTU-1	PRICE	SDV	9"	895	405	405	405	55.0	85.0	13.0	4.0	SCR	277/1	INTEGRAL	ALL
VAV-1-21	RTU-1	PRICE	SDV	9"	945	475	475	475	55.0	90.0	17.9	5.5	SCR	480/1	INTEGRAL	ALL
VAV-1-22	RTU-1	PRICE	SDV	6"	320	65	65	160	55.0	90.0	6.0	2.0	SCR	277/1	INTEGRAL	ALL
VAV-1-23	RTU-1	PRICE	SDV	8"	630	130	130	315	55.0	90.0	11.9	3.5	SCR	277/1	INTEGRAL	ALL
VAV-1-24	RTU-1	PRICE	SDV	12"	1445	290	290	795	55.0	90.0	30.0	9.0	SCR	480/3	INTEGRAL	ALL
VAV-1-25	RTU-1	PRICE	SDV	10"	1165	410	410	985	55.0	90.0	22.0	6.5	SCR	480/1	INTEGRAL	ALL
VAV-1-26	RTU-1	PRICE	SDV	4"	85	30	30	80	55.0	90.0	2.9	1.0	SCR	277/1	INTEGRAL	ALL
VAV-1-27	RTU-1	PRICE	SDV	4"	110	30	30	80	55.0	90.0	2.9	1.0	SCR	277/1	INTEGRAL	ALL
VAV-1-28	RTU-1	PRICE	SDV	4"	125	25	25	75	55.0	90.0	2.8	1.0	SCR	277/1	INTEGRAL	ALL

MODEL NUMBERS SHALL NOT BE CONSIDERED COMPLETE AND MATERIAL SHALL NOT BE ORDERED BY MANUFACTURER AND MODEL NUMBERS ONLY. REVIEW THE COMPLETE DESCRIPTION, NOTES AND SPECIFICATIONS TO DETERMINE THE EXACT MATERIAL AND ACCESSORIES TO BE ORDERED. THE MANUFACTURERS LISTED ARE THE BASIS FOR THE DESIGN.

- NOTES:
- A. HEATING COIL BASED ON 45° F MAX. AIR TEMPERATURE RISE, AND 450 FPM MINIMUM COIL FACE VELOCITY.
  - B. INSTALL FLEXIBLE DUCT CONNECTOR AT INLET CONNECTION.
  - C. PROVIDE INTEGRAL DISCONNECT SWITCH.
  - D. PROVIDE FACTORY INSTALLED CONTROL TRANSFORMER, COORDINATE PRIMARY POWER WITH ELECTRICAL DRAWINGS.
  - E. PROVIDE FACTORY-INSTALLED, PRESSURE-INDEPENDENT, ODC CONTROL PACKAGE.
  - F. PROVIDE BOX WITH EITHER RIGHT HAND OR LEFT HAND CONFIGURATION AS SHOWN ON DRAWINGS.
  - G. PROVIDE BOX WITH MAGNETIC CONTACTORS FOR NON-HORIZONTAL MOUNTING.
  - H. FURNISH WITH VAV BOX CONTROLLER AND HIGH SPEED ELECTRONIC ACTUATOR.
  - I. INLET SIZE SHOWN IS THE MINIMUM ALLOWABLE INLET SIZE. NO SMALLER SIZES SHALL BE ACCEPTED.
  - J.

MARK	LOCATION	MANUFACTURER	MOUNTING	MODEL	CFM	MAX CFM	ESP (IN)	NOM HP	FAN RPM	DRIVE (BELT/DIRECT)	ECM (Y/N)	ELECTRICAL		STARTER TYPE	WEIGHT (LBS)	NOTES
												V/PH	DISC TYPE			
EF 1	401 - RESTROOM	GREENHECK	CEILING	SP-A90	70	-	0.28	0.01	900	DIRECT	No	120/1	NF	MAG	15	C, D, E, H, J, K
EF 2	RESTROOMS/LOCKERS	GREENHECK	INLINE	SQ-90-VG	470	-	0.44	0.10	1609	DIRECT	Yes	120/1	NF	ECM	70	C, D, E, F, H, J
EF 3	RESTROOMS/LOCKERS	GREENHECK	INLINE	SQ-100-VG	945	-	0.50	0.25	1472	DIRECT	Yes	120/1	NF	ECM	65	C, D, E, F, H, J
EF 4	RESTROOMS/LOCKERS	GREENHECK	INLINE	SQ-120-VG	1350	-	0.48	0.50	1420	DIRECT	Yes	120/1	NF	ECM	75	C, D, E, F, H, J
EF 5	RESTROOMS/LOCKERS	GREENHECK	INLINE	SQ-90-VG	200	-	0.41	0.10	1442	DIRECT	Yes	120/1	NF	ECM	70	C, D, E, F, H, J
EF 6	RESTROOMS	GREENHECK	INLINE	SQ-70-VG	100	-	0.26	0.07	1364	DIRECT	Yes	120/1	NF	ECM	45	C, D, E, F, H, J
EF 7	FLEET MAINTENANCE BAY	GREENHECK	ROOF	G-200-VG	1900	5300	1.11	3.00	1233	DIRECT	Yes	208/3	NF	ECM	210	A, B, D, E, F, G, J
EF 8	FLEET MAINTENANCE BAY	GREENHECK	ROOF	G-200-VG	1900	5300	1.11	3.00	1233	DIRECT	Yes	208/3	NF	ECM	210	A, B, D, E, F, G, J
EF 9	FLEET MAINTENANCE BAY	GREENHECK	ROOF	G-240-C-VGD	2500	6665	0.45	2.00	824	DIRECT	Yes	208/3	NF	ECM	260	A, B, D, E, F, G, J
EF 10	FLEET MAINTENANCE BAY	GREENHECK	ROOF	G-240-C-VGD	2500	6665	0.45	2.00	824	DIRECT	Yes	208/3	NF	ECM	260	A, B, D, E, F, G, J
EF 11	FLEET MAINTENANCE BAY	GREENHECK	ROOF	G-200HP-VG	1800	5000	1.01	3.00	1486	DIRECT	Yes	208/3	NF	ECM	215	A, B, D, E, F, G, J
EF 12	FLEET MAINTENANCE BAY	GREENHECK	ROOF	G-200HP-VG	1800	5000	1.01	3.00	1486	DIRECT	Yes	208/3	NF	ECM	215	A, B, D, E, F, G, J
EF 13	COMMON WORK AREA	GREENHECK	ROOF	G-185-VG	1000	2800	0.68	1.00	954	DIRECT	Yes	120/1	NF	ECM	130	A, B, D, E, F, G, J
EF 14	TIRE SHOP	GREENHECK	ROOF	G-140-VG	1000	2500	0.37	1.00	1477	DIRECT	Yes	120/1	NF	ECM	80	A, B, D, E, F, G, J
EF 15	PARTS ROOM	GREENHECK	ROOF	G-095-VG	750	-	0.58	0.17	1725	DIRECT	Yes	120/1	NF	ECM	50	A, B, D, E, F, H, J
EF 16	LUBE/COMPRESSOR	GREENHECK	ROOF	G-095-VG	750	-	0.58	0.17	1725	DIRECT	Yes	120/1	NF	ECM	50	A, B, D, E, F, H, J
EF 17	WATER SHOP	GREENHECK	INLINE	SQ-90-VG	460	-	0.44	0.10	1398	DIRECT	Yes	120/1	NF	ECM	60	C, D, E, F, H, J
EF 18	FACILITIES WAREHOUSE	GREENHECK	INLINE	SQ-120-VG	1000	-	0.48	0.50	1072	DIRECT	Yes	120/1	NF	ECM	75	C, D, E, F, H, J
EF 19	BATTERY STORAGE	GREENHECK	ROOF	G-090-VG	100	-	0.25	0.07	1486	DIRECT	Yes	120/1	NF	ECM	20	A, B, D, E, F, H, J
EF 20	401 - RESTROOM	GREENHECK	CEILING	SP-A90	70	-	0.28	0.01	900	DIRECT	No	120/1	NF	MAG	15	C, D, E, H, J, K

MODEL NUMBERS SHALL NOT BE CONSIDERED COMPLETE AND MATERIAL SHALL NOT BE ORDERED BY MANUFACTURER AND MODEL NUMBERS ONLY. REVIEW THE COMPLETE DESCRIPTION, NOTES AND SPECIFICATIONS TO DETERMINE THE EXACT MATERIAL AND ACCESSORIES TO BE ORDERED. THE MANUFACTURERS LISTED ARE THE BASIS FOR THE DESIGN.

- NOTES:
- A. PROVIDE INSULATED ROOF CURB WITH MINIMUM HEIGHT REQUIRED TO MAINTAIN BOTTOM OF EQUIPMENT A MINIMUM OF 8 INCHES ABOVE FINISHED ROOF SURFACE. PROVIDE SLOPED CURB IF NEEDED TO MATCH ROOF SLOPE. COORDINATE WITH ROOF INSULATION THICKNESS AND ROOF TAPER AT INSTALLED LOCATION. COORDINATE CURB TYPE WITH DRAWINGS.
  - B. PROVIDE BRISSCREEN AND GRAVITY BACKDRAFT DAMPER.
  - C. PROVIDE WITH SPRING VIBRATION ISOLATION AND ALL-THREAD HANGING RODS.
  - D. DIVISION 26 CONTRACTOR SHALL PROVIDE DISCONNECT SWITCH.
  - E. STARTER FURNISHED INTEGRAL WITH UNIT.
  - F. PROVIDE WITH MANUFACTURER'S ELECTRONICALLY COMMUTATED (EC) MOTOR.
  - G. SCHEDULED MAX CFM IS THE EXHAUST FAN CFM DURING EMERGENCY MODE. REFER TO CONTROLS FOR MORE INFORMATION.
  - H. EXHAUST FAN IS CONSTANT VOLUME.
  - I. REFER TO CONTROLS SHEET M702 FOR FAN OPERATION CONTROLS.
  - J. INTERLOCK FAN WITH LOCAL LIGHT SWITCH.
  - K.

MARK	LOCATION	MANUFACTURER	MODEL	MOUNTING	DIAMETER (FT)	BLADES	DRIVE (BELT/DIRECT)	MIN WATTS	FAN RPM	VFD	ELECTRICAL		NOTES
											VOLTS	PH	
ICF 1	MAINTENANCE BAY	MARLEY	60001HP	SUSPENDED	5	3	DIRECT	70	315	No	120	1	A-D
ICF 2	MAINTENANCE BAY	MARLEY	60001HP	SUSPENDED	5	3	DIRECT	70	315	No	120	1	A-D
ICF 3	MAINTENANCE BAY	MARLEY	60001HP	SUSPENDED	5	3	DIRECT	70	315	No	120	1	A-D
ICF 4	MAINTENANCE BAY	MARLEY	60001HP	SUSPENDED	5	3	DIRECT	70	315	No	120	1	A-D
ICF 5	MAINTENANCE BAY	MARLEY	60001HP	SUSPENDED	5	3	DIRECT	70	315	No	120	1	A-D
ICF 6	MAINTENANCE BAY	MARLEY	60001HP	SUSPENDED	5	3	DIRECT	70	315	No	120	1	A-D
ICF 7	MAINTENANCE BAY	MARLEY	60001HP	SUSPENDED	5	3	DIRECT	70	315	No	120	1	A-D
ICF 8	MAINTENANCE BAY	MARLEY	60001HP	SUSPENDED	5	3	DIRECT	70	315	No	120	1	A-D
ICF 9	MAINTENANCE BAY	MARLEY	60001HP	SUSPENDED	5	3	DIRECT	70	315	No	120	1	A-D
ICF 10	MAINTENANCE BAY	MARLEY	60001HP	SUSPENDED	5	3	DIRECT	70	315	No	120	1	A-D
ICF 11	MAINTENANCE BAY	MARLEY	60001HP	SUSPENDED	5	3	DIRECT	70	315	No	120	1	A-D
ICF 12	MAINTENANCE BAY	MARLEY	60001HP	SUSPENDED	5	3	DIRECT	70	315	No	120	1	A-D

MODEL NUMBERS SHALL NOT BE CONSIDERED COMPLETE AND MATERIAL SHALL NOT BE ORDERED BY MANUFACTURER AND MODEL NUMBERS ONLY. REVIEW THE COMPLETE DESCRIPTION, NOTES AND SPECIFICATIONS TO DETERMINE THE EXACT MATERIAL AND ACCESSORIES TO BE ORDERED. THE MANUFACTURERS LISTED ARE THE BASIS FOR THE DESIGN.

- NOTES:
- A. PROVIDE WITH MANUFACTURER'S WALL SPEED CONTROLLER WITH ON/OFF CONTROL AND REVERSIBLE FUNCTION.
  - B. MOUNT FAN TO STRUCTURE. COORDINATE ATTACHMENTS TO STRUCTURE WITH STRUCTURAL ENGINEER.
  - C. COORDINATE FAN INSTALLATION WITH GC AND ALL OTHER TRADES. MAINTAIN MANUFACTURER RECOMMENDED CLEARANCES FOR PROPER OPERATION AND MAINTENANCE.
  - D. PROVIDE WITH 24 INCH DOWNROD.

M

N

P

Q

R

COMPUTER ROOM UNIT SCHEDULE

MARK	MANUFACTURER	MODEL	REFRA TYPE	EVAPORATOR SECTION				CONDENSING SECTION					NOTES
				CFM	TC (MBH)	V/PH	MCA	CU MARK	AMB (°F)	V/PH	MCA	MOCP	
CRU 1	DAIKIN	PKAA-A24PUV-A24	R410A	700	24.0	208/1	1.0	CU 1	105	208/1	19.0	26	ALL
CRU 2	DAIKIN	PKAA-A24PUV-A24	R410A	700	24.0	208/1	1.0	CU 2	105	208/1	19.0	26	ALL
CRU 3	DAIKIN	PKAA-A24PUV-A24	R410A	700	24.0	208/1	1.0	CU 3	105	208/1	19.0	26	ALL
CRU 4	DAIKIN	PKAA-A24PUV-A24	R410A	700	24.0	208/1	1.0	CU 4	105	208/1	19.0	26	ALL
CRU 5	DAIKIN	PKAA-A12PUV-A12	R410A	425	12.0	208/1	1.0	CU 5	105	208/1	11.0	28	ALL

MODEL NUMBERS SHALL NOT BE CONSIDERED COMPLETE AND MATERIAL SHALL NOT BE ORDERED BY MANUFACTURER AND MODEL NUMBERS ONLY. REVIEW THE COMPLETE DESCRIPTION, NOTES AND SPECIFICATIONS TO DETERMINE THE EXACT MATERIAL AND ACCESSORIES TO BE ORDERED. THE MANUFACTURERS LISTED ARE THE BASIS FOR THE DESIGN.

NOTES:

A.

B.

C.

D.

E.

F.

G.

H.

CONTRACTOR SHALL VERIFY WITH EQUIPMENT SUPPLIER EXACT ROUTING AND SIZE OF INSULATED REFRIGERANT PIPING. INSTALL PER MANUFACTURER'S RECOMMENDATIONS.

DIVISION 26 CONTRACTOR TO PROVIDE DISCONNECT SWITCH FOR EVAPORATOR SECTION AND CONDENSING SECTION.

PROVIDE WITH WALL MOUNTED THERMOSTAT BY UNIT MANUFACTURER.

PROVIDE WITH INTEGRAL CONDENSATE PUMP.

PROVIDE CONDENSER COIL HAIL GUARDS.

PROVIDE WITH EQUIPMENT SUPPORT RAILS. INSTALL OUTDOOR UNIT ON RAILS AND ANCHOR TO EXTERIOR CONCRETE PAD.

INDOOR UNIT POWERED THROUGH OUTDOOR UNIT. WIRING BETWEEN INDOOR AND OUTDOOR UNITS PROVIDED BY DIVISION 26 CONTRACTOR.

COORDINATE CONDUCTOR QUANTITY WITH MANUFACTURER'S REQUIREMENTS.


PROVIDE WITH WIND BAFFLE AND LOW AMBIENT OPERATION DOWN TO 0°F.

NATURAL GAS-FIRED INFRARED HEATERS SCHEDULE											
MARK	LOCATION	MANUFACTURER	MODEL	NOM INPUT (MBH)	MIN NO STAGES	MOUNTING		ELECTRICAL		WEIGHT (LBS)	NOTES
						MIN HEIGHT A.F.F. (FT)	ANGLE	VOLTS	PH		
RH 01	MAINTENANCE BAY	MODINE	IHR60	60	1	20	20°	120	1	60	ALL
RH 02	MAINTENANCE BAY	MODINE	IHR60	60	1	20	20°	120	1	60	ALL
RH 03	MAINTENANCE BAY	MODINE	IHR60	60	1	20	20°	120	1	60	ALL
RH 04	MAINTENANCE BAY	MODINE	IHR60	60	1	20	20°	120	1	60	ALL
RH 05	MAINTENANCE BAY	MODINE	IHR60	60	1	20	20°	120	1	60	ALL
RH 06	MAINTENANCE BAY	MODINE	IHR60	60	1	20	20°	120	1	60	ALL
RH 07	MAINTENANCE BAY	MODINE	IHR60	60	1	20	20°	120	1	60	ALL
RH 08	MAINTENANCE BAY	MODINE	IHR60	60	1	20	20°	120	1	60	ALL
RH 09	MAINTENANCE BAY	MODINE	IHR60	60	1	20	20°	120	1	60	ALL
RH 10	MAINTENANCE BAY	MODINE	IHR60	60	1	20	20°	120	1	60	ALL
RH 11	MAINTENANCE BAY	MODINE	IHR60	60	1	18	20°	120	1	60	ALL
RH 12	MAINTENANCE BAY	MODINE	IHR60	60	1	18	20°	120	1	60	ALL
RH 13	MAINTENANCE BAY	MODINE	IHR60	60	1	18	20°	120	1	60	ALL
RH 14	MAINTENANCE BAY	MODINE	IHR60	60	1	18	20°	120	1	60	ALL
RH 15	MAINTENANCE BAY	MODINE	IHR60	60	1	18	20°	120	1	60	ALL
RH 16	MAINTENANCE BAY	MODINE	IHR60	60	1	18	20°	120	1	60	ALL







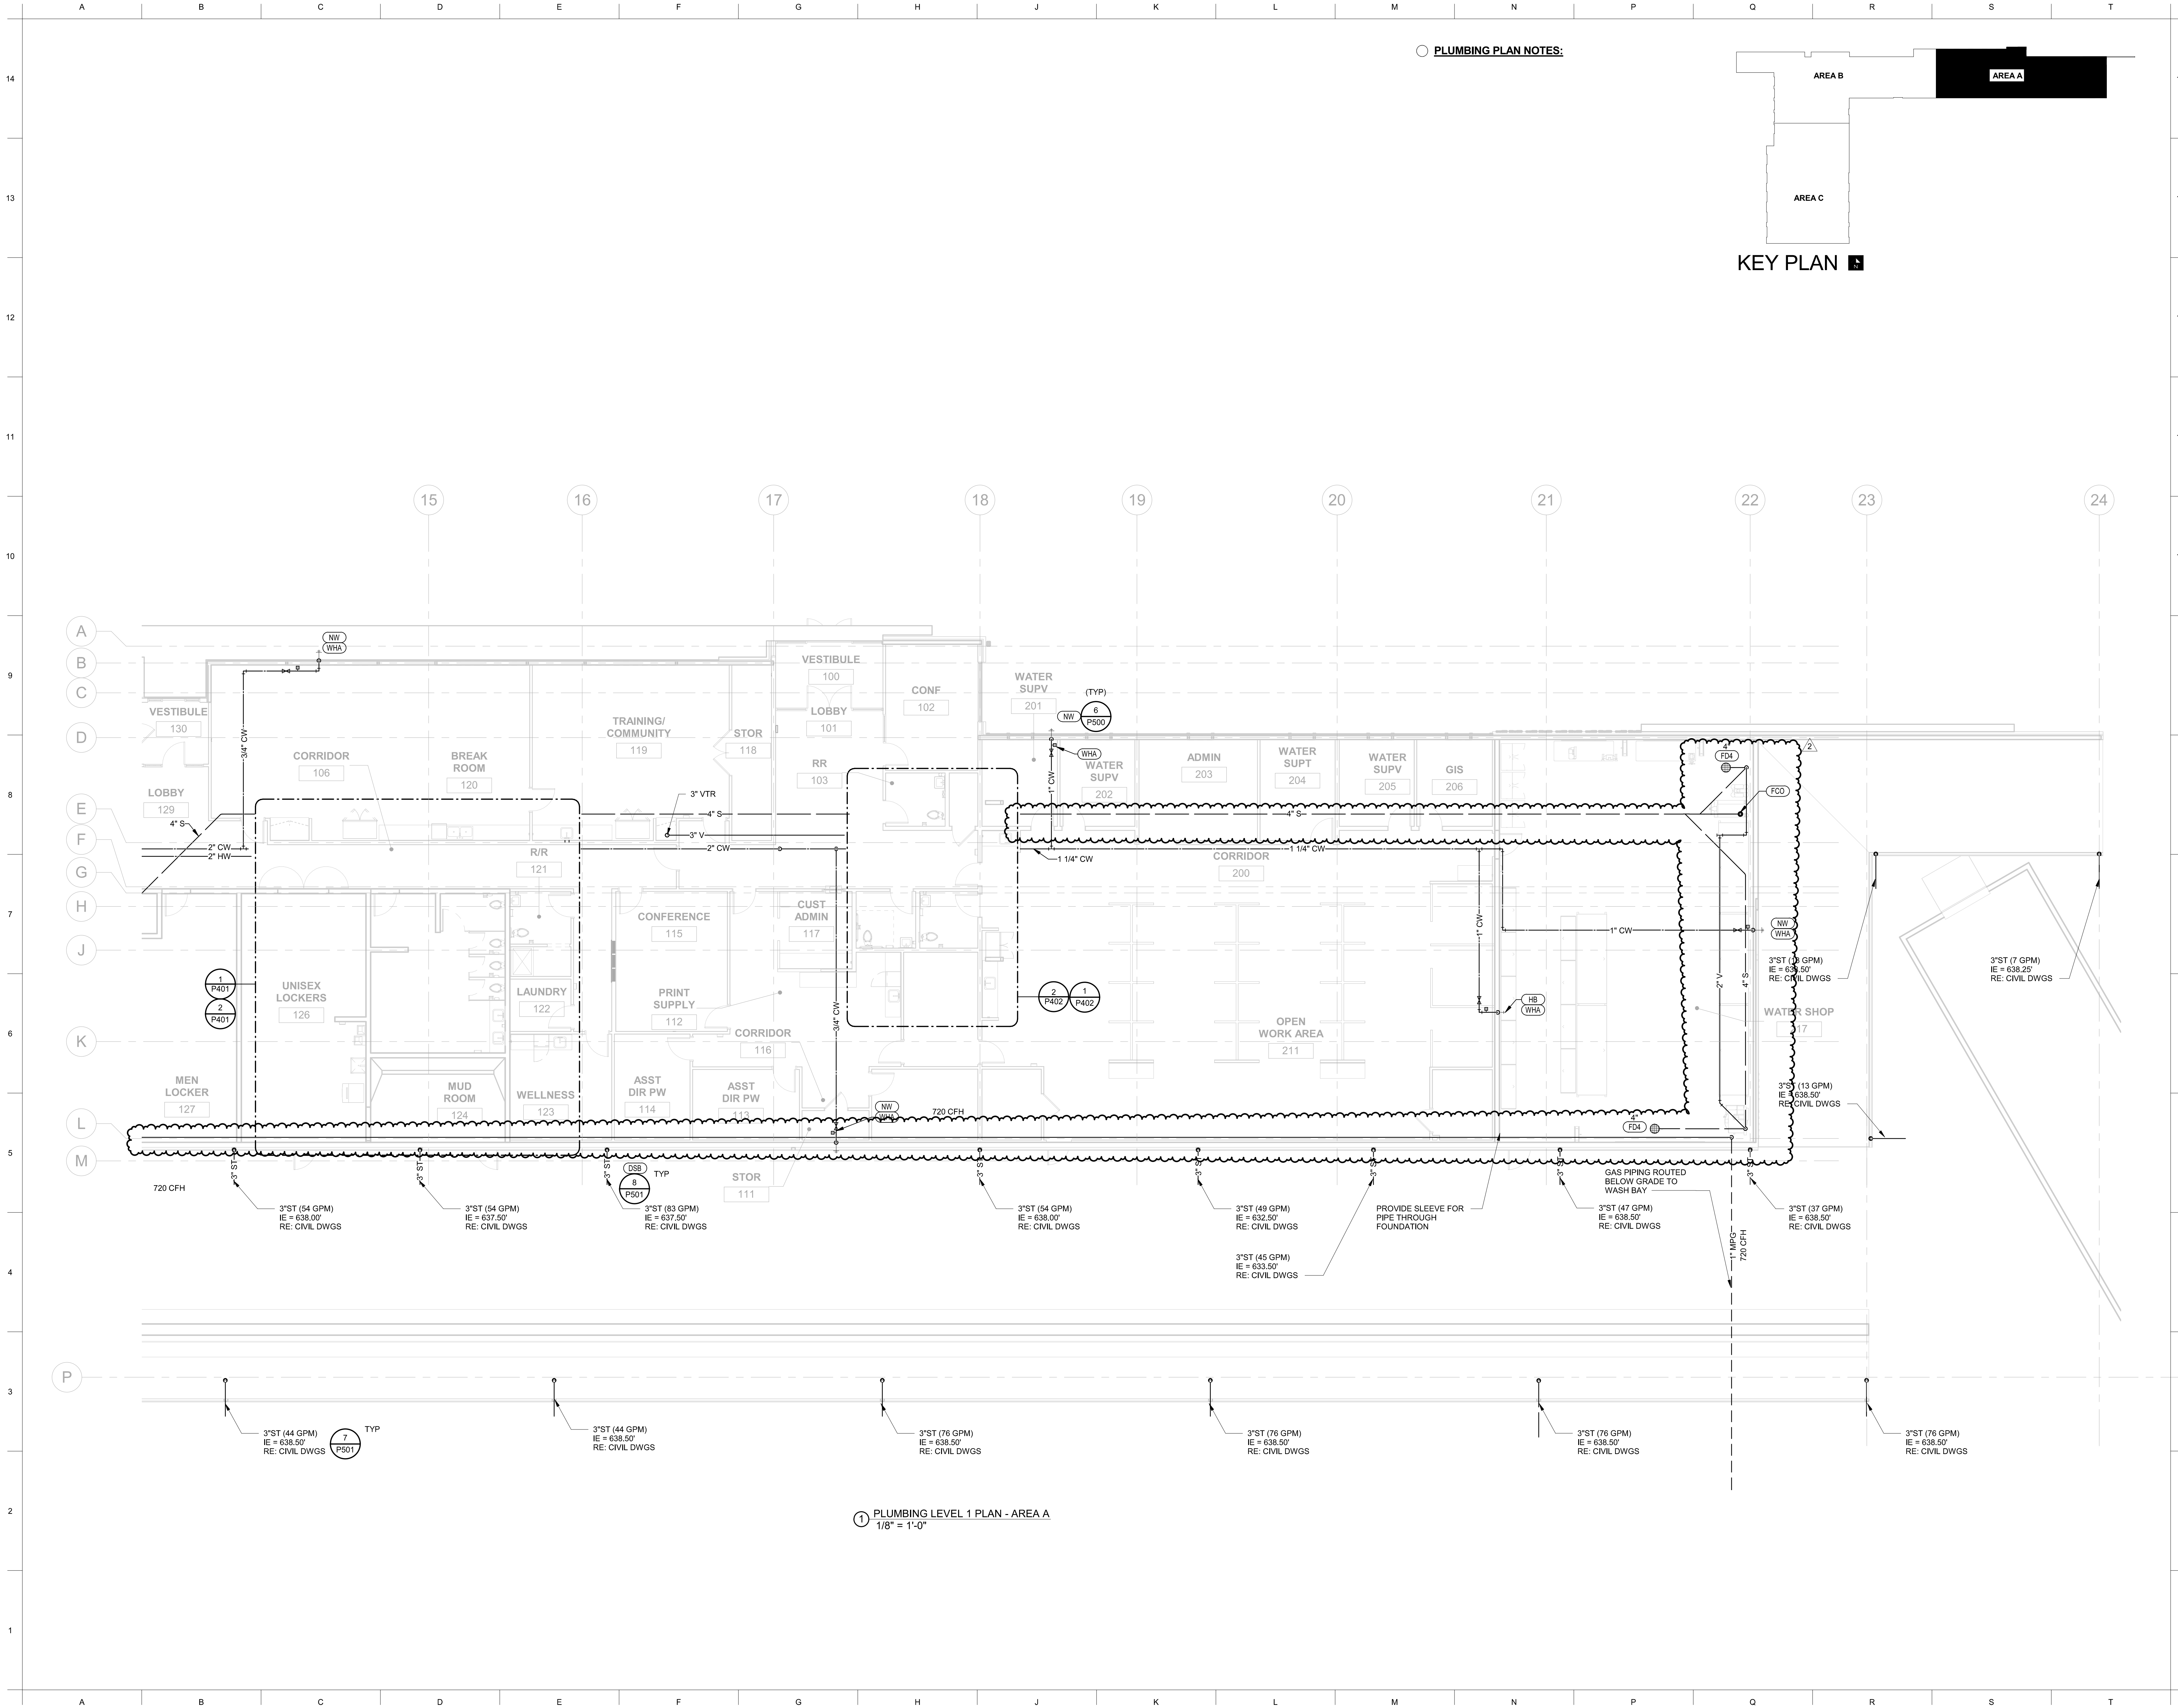

PLUMBING PLAN NOTES:

KEY PLAN



5039 S National Avenue | Springfield, MO 65810 | 417.887.6595


**OWNER**  
CITY OF WENTZVILLE, MISSOURI  
1001 SCHROEDER CREEK BLVD  
WENTZVILLE, MO 63385  
636.327.5101

**PROJECT TEAM**  
**CIVIL ENGINEER**  
PREMIER DESIGN GROUP  
100 MIDLAND PARK DRIVE  
WENTZVILLE, MO 63385  
314.925.7444  
**MAINTENANCE CONSULTANT**  
HDR ENGINEERING, INC.  
17725 KATY FREEWAY SUITE 102  
HOUSTON, TX 77054  
816.360.2700  
**STRUCTURAL ENGINEER**  
METTEMAYER ENGINEERING  
2225 W CHESTERFIELD BLVD., SUITE 300  
SPRINGFIELD, MO 65807  
417.890.8002  
**MEP ENGINEER**  
HENDERSON ENGINEERS, INC.  
8345 LENEKA DR., #300  
LENEKA, KS 66214  
913.742.5000



NO.	DESCRIPTION	DATE
2	ADD 02	01.25.23

PROJECT NO.: 19-040 DRAWN BY: MJ  
DATE: 12.15.22 REVIEWED BY: HEI

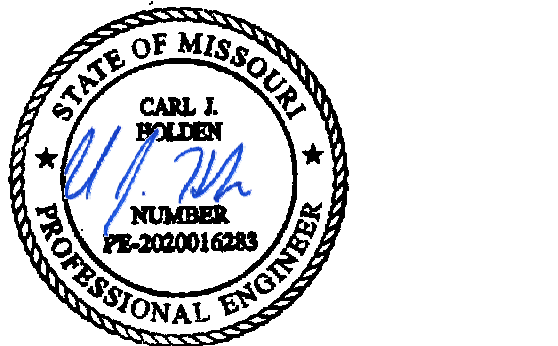

01/24/2023

CARL J. HOLDEN  
LICENSE # PE-2020016283

**PROJECT TITLE**  
CITY OF WENTZVILLE, MO PUBLIC  
WORKS FACILITY  
**PROJECT ADDRESS:**  
1295 INTERSTATE DRIVE  
WENTZVILLE, MO 63385

PLUMBING LEVEL 1 PLAN - AREA A

P101A





**OWNER**  
CITY OF WENTZVILLE, MISSOURI  
1001 SCHROEDER CREEK BLVD  
WENTZVILLE, MO 63385  
636.327.5101

**PROJECT TEAM**  
CIVIL ENGINEER  
PREMIER DESIGN GROUP  
100 MIDLAND PARK DRIVE  
WENTZVILLE, MO 63385  
314.925.7444  
MAINTENANCE CONSULTANT  
HDR ENGINEERING, INC.  
17725 KATY FREEWAY SUITE 102  
HOUSTON, TX 77054  
816.360.2700

STRUCTURAL ENGINEER  
METTEMAYER ENGINEERING  
2225 W CHESTERFIELD BLVD., SUITE 300  
SPRINGFIELD, MO 65807  
417.890.8002

MEP ENGINEER  
HENDERSON ENGINEERS, INC.  
8345 LENEKA DR., #300  
LENEKA, KS 66214  
913.742.5000

**HENDERSON**  
ENGINEERS  
8345 LENEKA DRIVE, SUITE 300  
LENEKA, KS 66214  
TEL 913.742.5000 FAX 913.742.5001  
WWW.HENDERSONENGINEERS.COM  
1950004840  
EXPIRES 12/31/2023

REVISIONS		
NO.	DESCRIPTION	DATE
2	ADD 02	01.25.23

PROJECT NO.: 19-040 DRAWN BY: MJ  
DATE: 12.15.22 REVIEWED BY: HEI




CARL J. HOLDEN  
LICENSE # PE-2020016283

**PROJECT TITLE**  
CITY OF WENTZVILLE, MO PUBLIC  
WORKS FACILITY

PROJECT ADDRESS:  
1295 INTERSTATE DRIVE  
WENTZVILLE, MO 63385

PLUMBING LEVEL 1 PLAN - AREA C

P101C

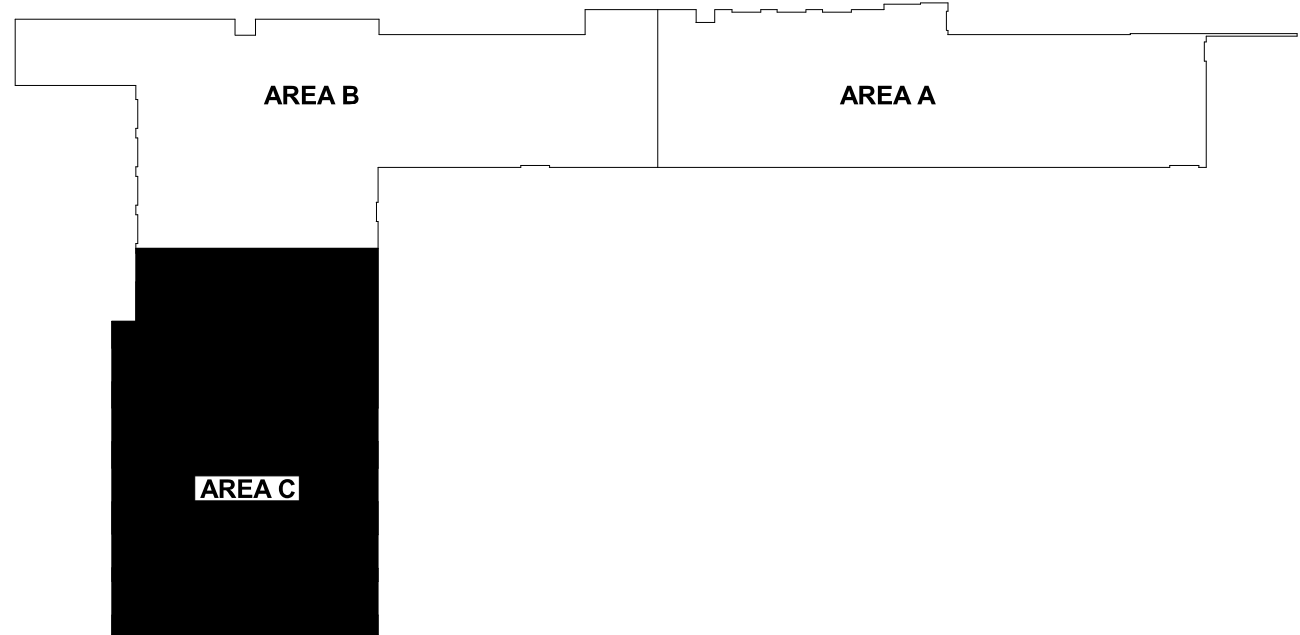

KEY PLAN



**RADIANT HEATER COORDINATION:**  
ALL CONTRACTORS SHALL COORDINATE ROUTING OF DUCTWORK, PIPING,  
CONDUIT, WIRING AND OTHER ELEMENTS WITH OVERHEAD RADIANT HEATER  
REQUIRED CLEARANCES. COORDINATE WITH DIVISION 23 CONTRACTOR TO  
MAINTAIN HEATER MANUFACTURER'S REQUIRED CLEARANCES TO COMBUSTIBLES.  
CONTRACTORS ARE RESPONSIBLE FOR RESOLVING CONFLICTS AS THEY ARISE.

1 PLUMBING LEVEL 1 PLAN - AREA C  
1/8" = 1'-0"





CARL J. HOLDEN

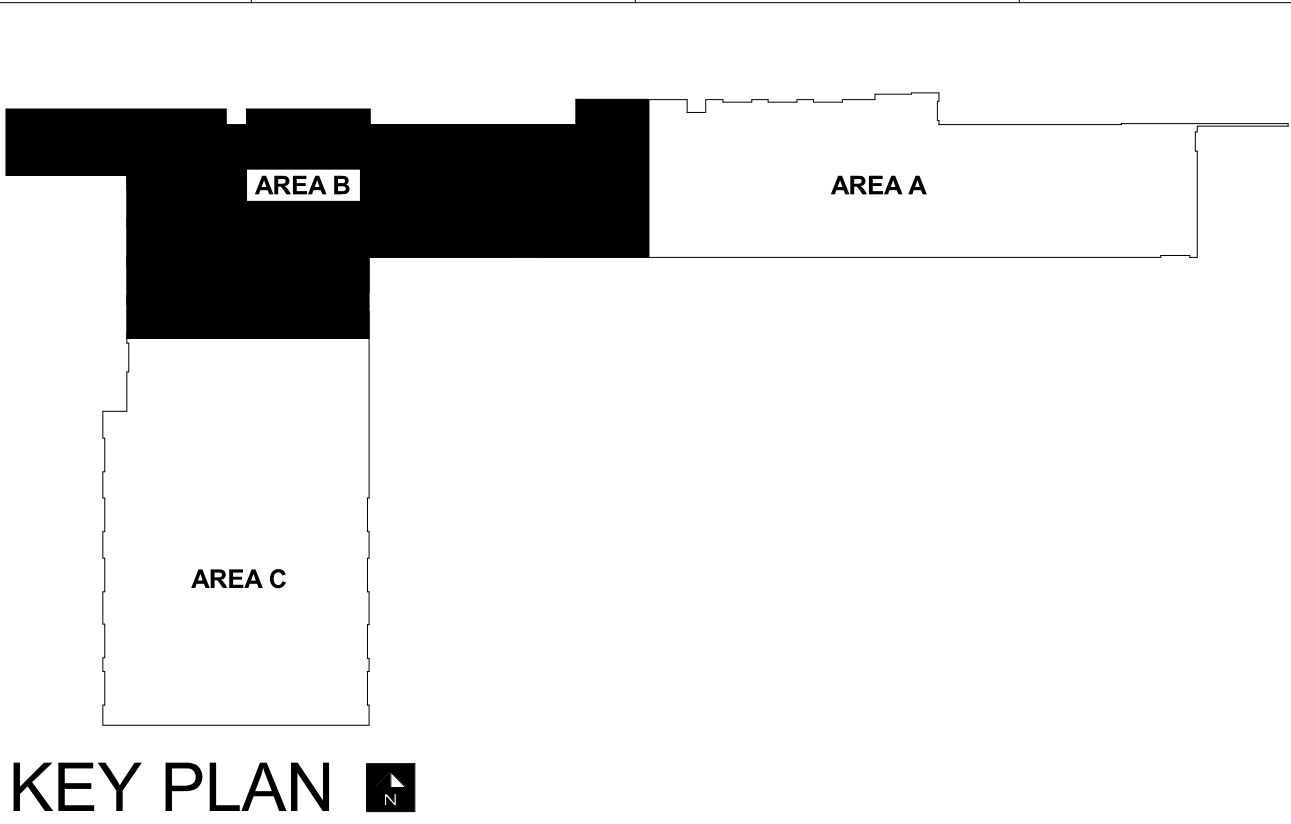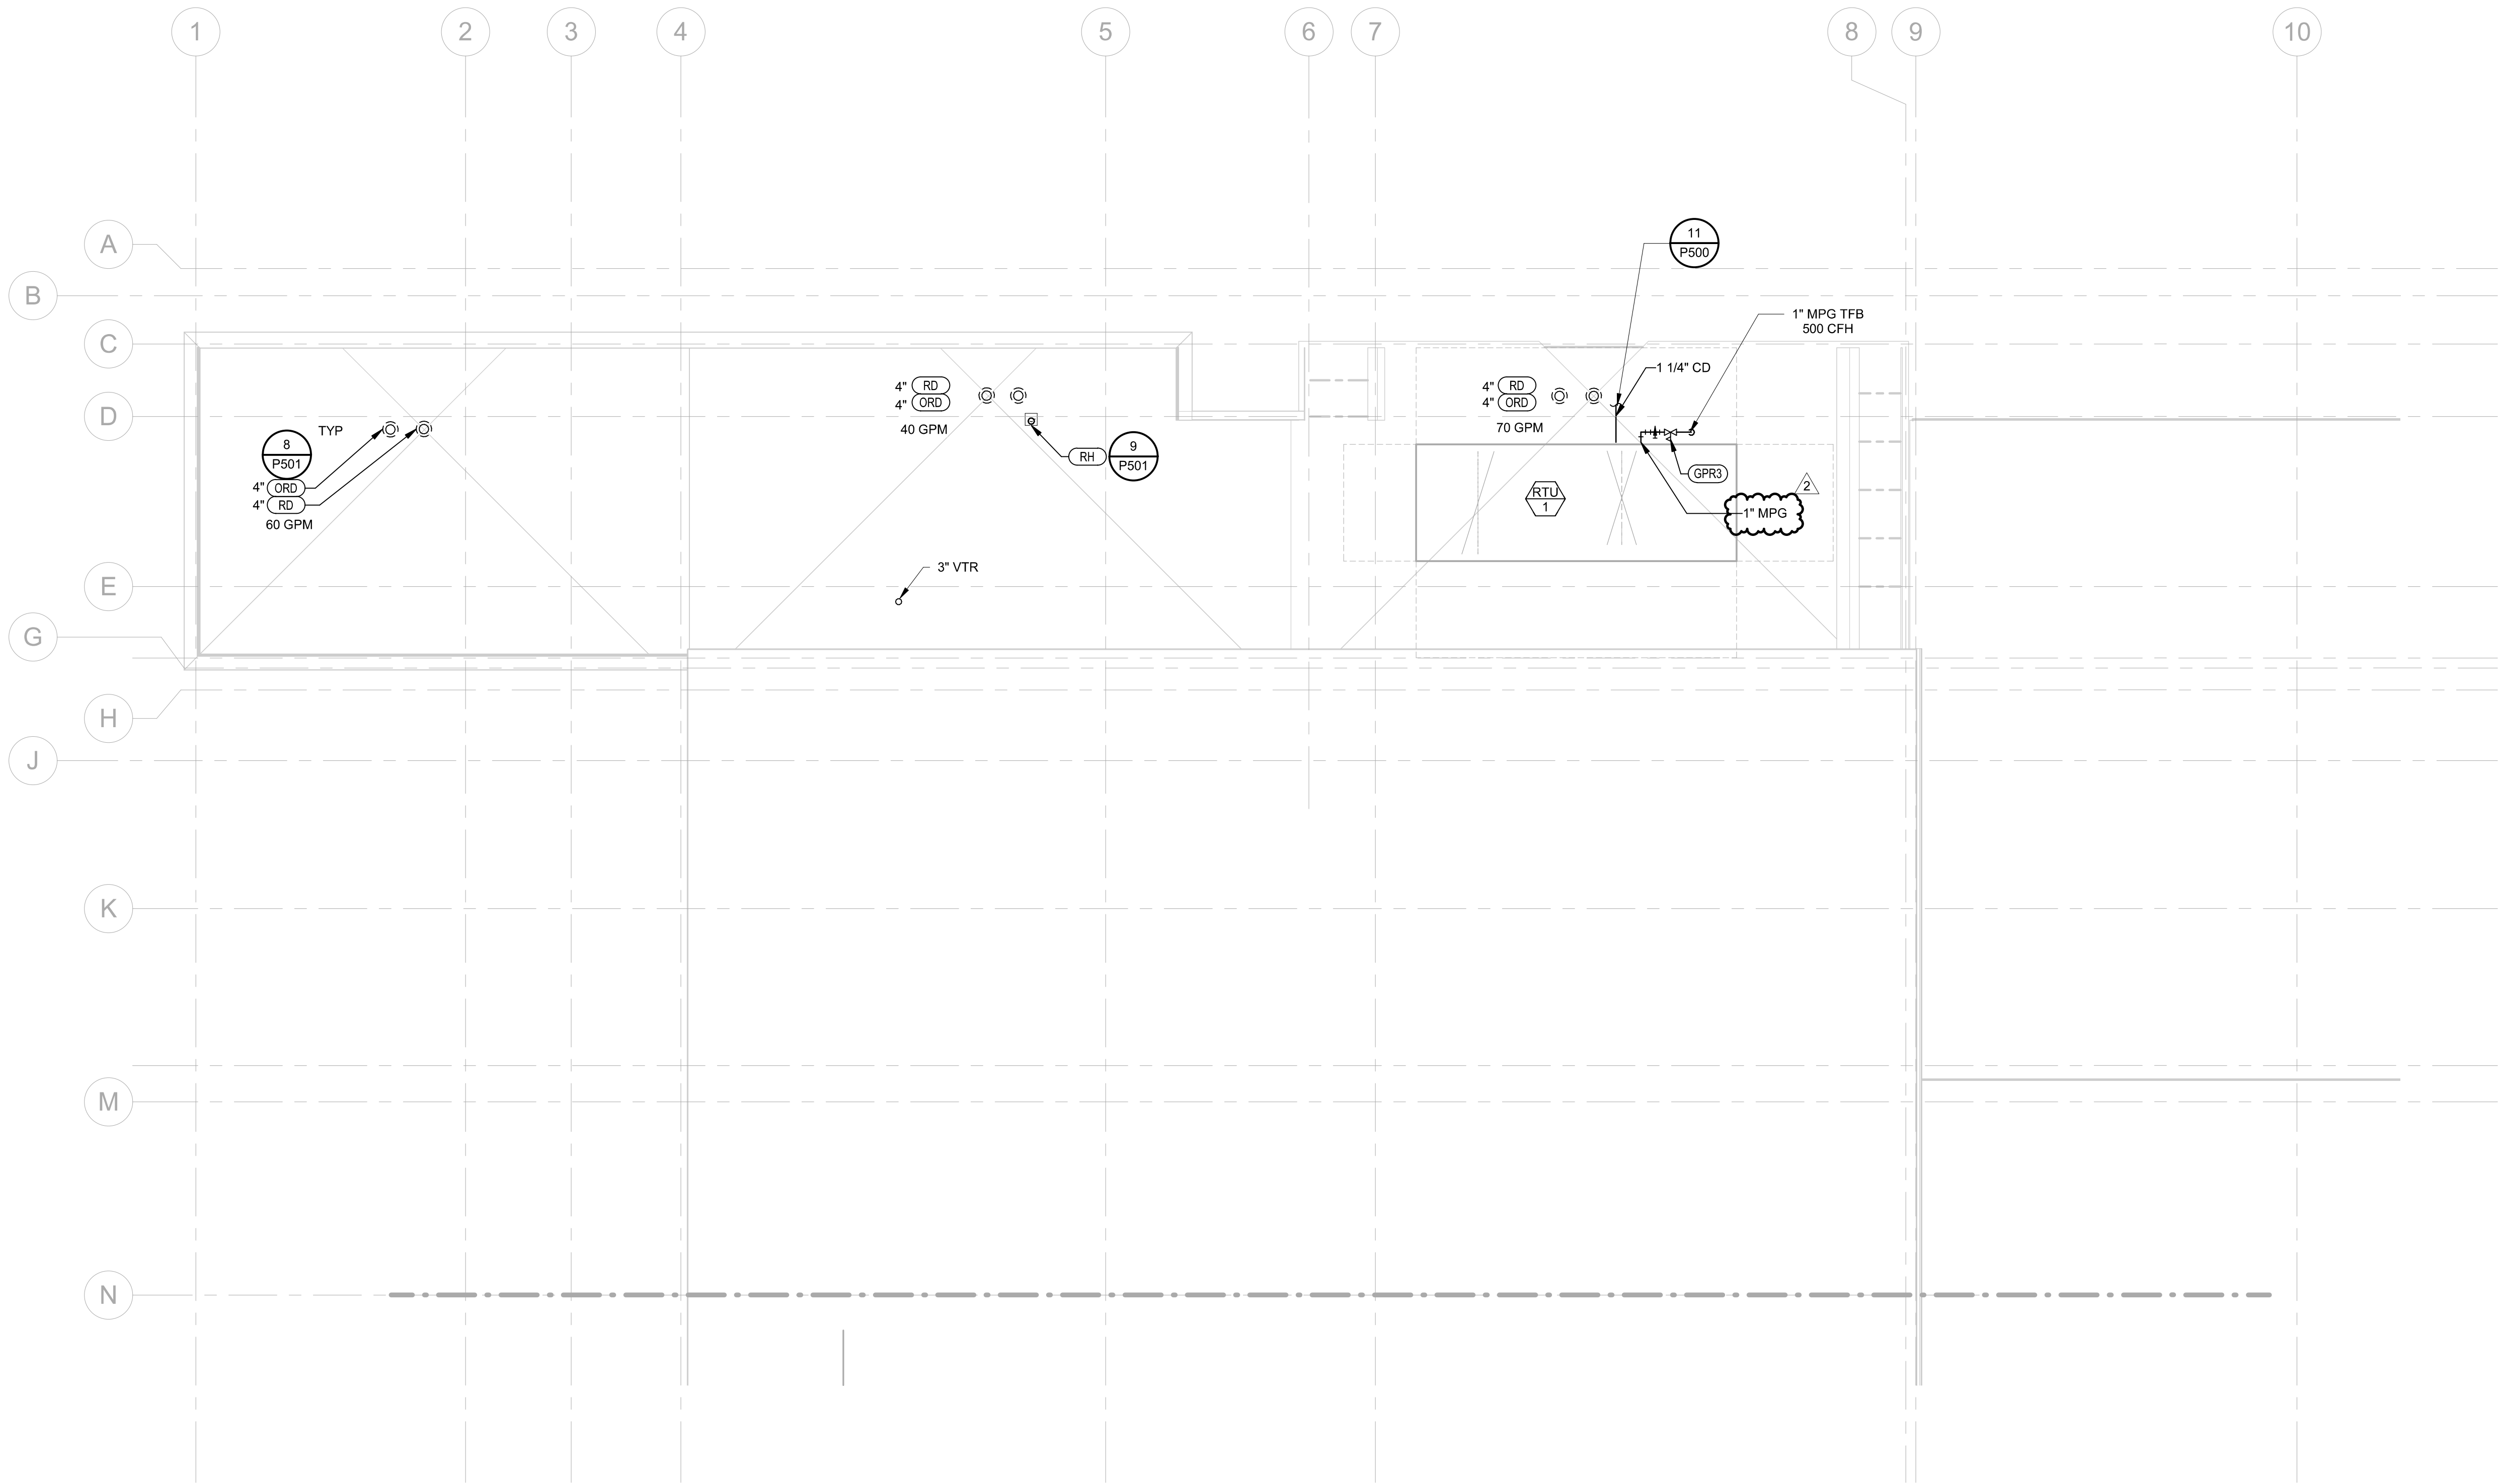

5039 S National Avenue | Springfield, MO 65810 | 417.887.6595

**OWNER**  
CITY OF WENTZVILLE, MISSOURI  
1001 SCHROEDER CREEK BLVD  
WENTZVILLE, MO 63385  
636.327.5101

**PROJECT TEAM**  
**CIVIL ENGINEER**  
PREMIER DESIGN GROUP  
100 MIDLAND PARK DRIVE  
WENTZVILLE, MO 63385  
314.925.7444  
**MAINTENANCE CONSULTANT**  
HDR ENGINEERING, INC.  
17725 KATY FREEWAY SUITE 102  
HOUSTON, TX 77054  
816.360.2700  
**STRUCTURAL ENGINEER**  
METTEMAYER ENGINEERING  
2225 W CHESTERFIELD BLVD., SUITE 300  
SPRINGFIELD, MO 65807  
417.890.8002  
**MEP ENGINEER**  
HENDERSON ENGINEERS, INC.  
8345 LENEXA DR., #300  
LENEXA, KS 66214  
913.742.5000  
.  
.



REVISIONS		
NO.	DESCRIPTION	DATE
2	ADD 02	01.25.23

PROJECT NO.: 19-040 DRAWN BY: Author  
DATE: 12.15.22 REVIEWED BY: Checker





CARL J. HOLDEN  
LICENSE # PE-2020016283

**PROJECT TITLE**  
CITY OF WENTZVILLE, MO PUBLIC  
WORKS FACILITY  
**PROJECT ADDRESS:**  
1295 INTERSTATE DRIVE  
WENTZVILLE, MO 63385

PLUMBING ROOF PLAN - AREA B

SHEET  
**P203B**

CARL J. HOLDEN

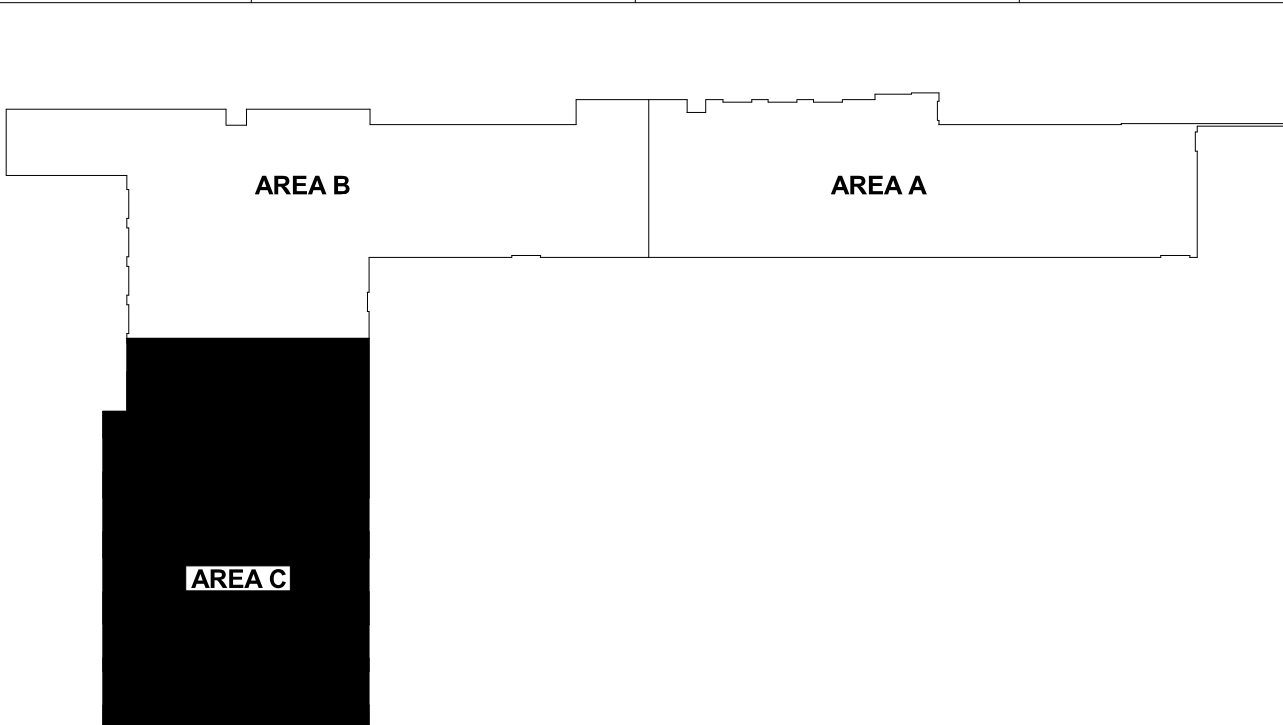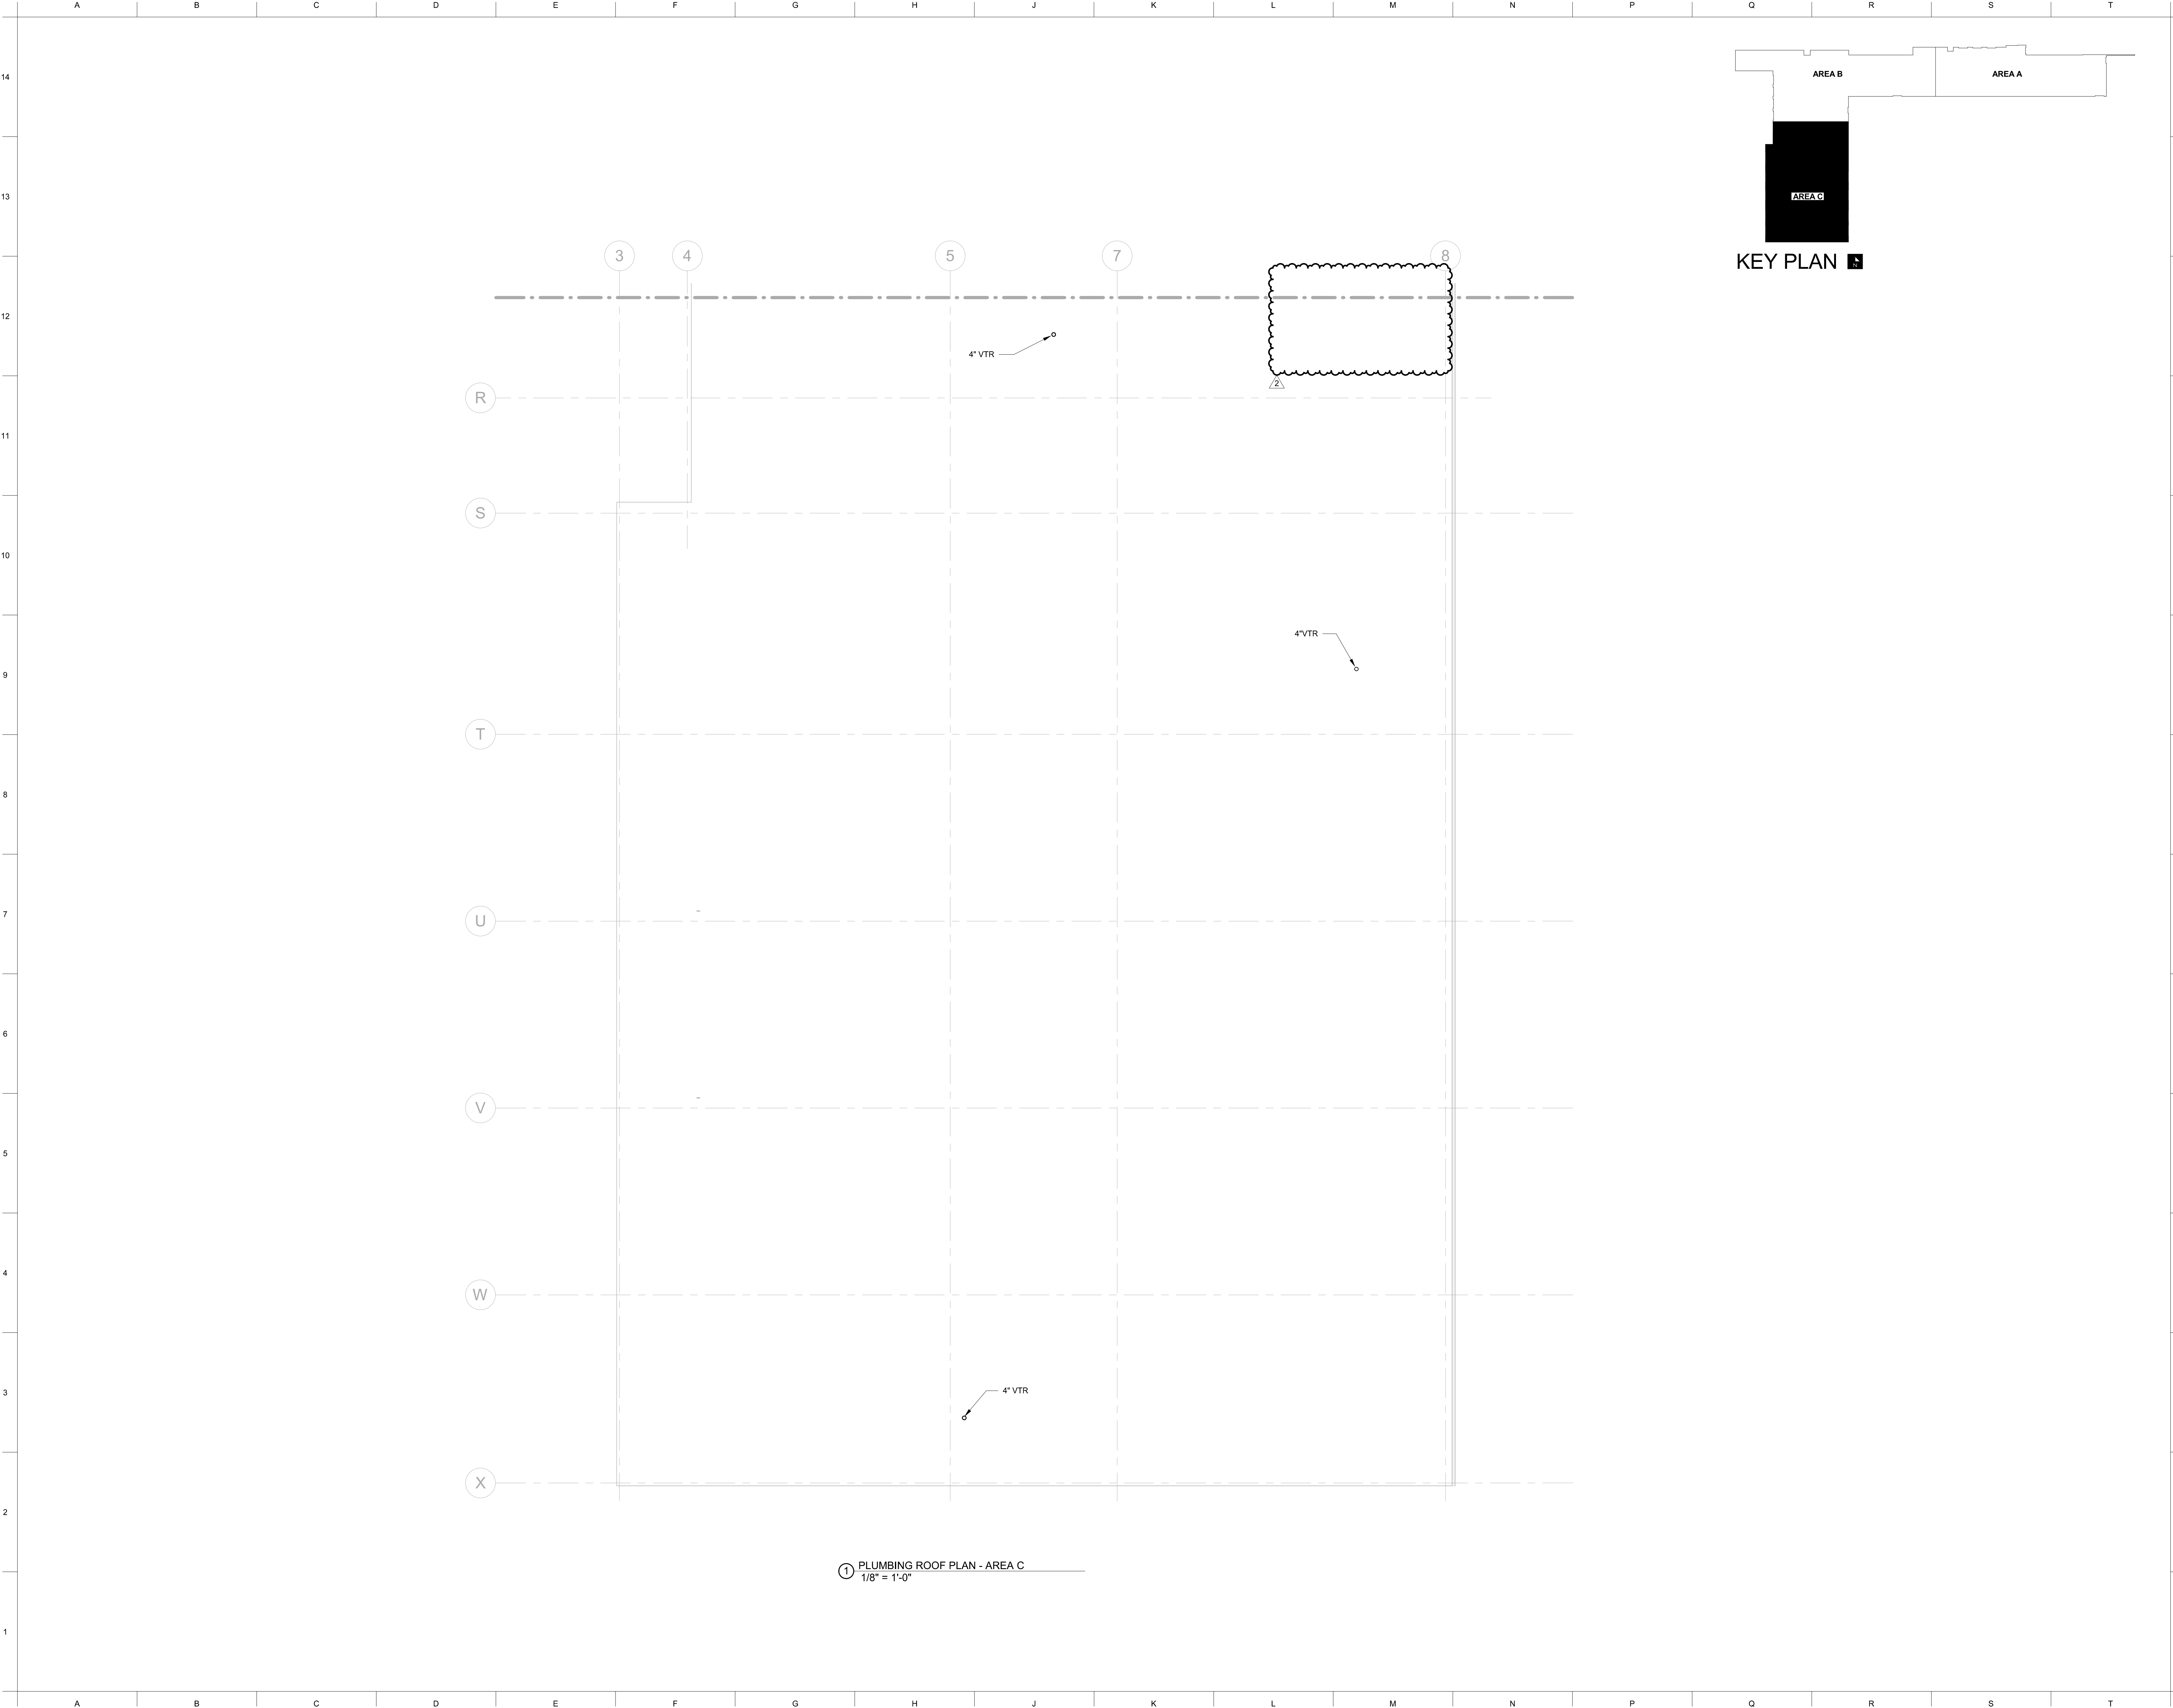


KEY PLAN



5039 S National Avenue | Springfield, MO 65810 | 417.887.6595

**OWNER**  
CITY OF WENTZVILLE, MISSOURI  
1001 SCHROEDER CREEK BLVD  
WENTZVILLE, MO 63385  
636.327.5101

**PROJECT TEAM**  
CIVIL ENGINEER  
PREMIER DESIGN GROUP  
100 MIDLAND PARK DRIVE  
WENTZVILLE, MO 63385  
314.925.7444  
MAINTENANCE CONSULTANT  
HDR ENGINEERING, INC.  
17725 KATY FREEWAY SUITE 102  
HOUSTON, TX 77054  
816.360.2700  
STRUCTURAL ENGINEER  
METTEMAYER ENGINEERING  
2225 W CHESTERFIELD BLVD., SUITE 300  
SPRINGFIELD, MO 65807  
417.890.8002  
MEP ENGINEER  
HENDERSON ENGINEERS, INC.  
8345 LENEXA DR., #300  
LENEXA, KS 66214  
913.742.5000  
.  
.

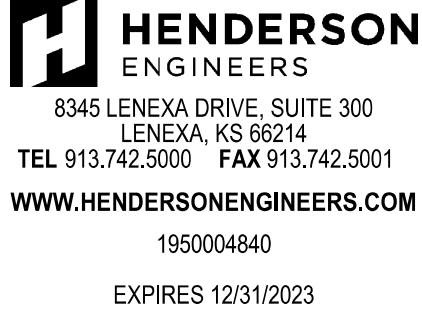

NO.	DESCRIPTION	DATE
2	ADD 02	01.25.23

PROJECT NO.: 19-040 DRAWN BY: Author  
DATE: 12.15.22 REVIEWED BY: Checker



01/24/2023


CARL J. HOLDEN  
LICENSE # PE-2020016283

**PROJECT TITLE**  
CITY OF WENTZVILLE, MO PUBLIC  
WORKS FACILITY  
PROJECT ADDRESS:  
1295 INTERSTATE DRIVE  
WENTZVILLE, MO 63385

PLUMBING ROOF PLAN - AREA C

P203C

SHEET

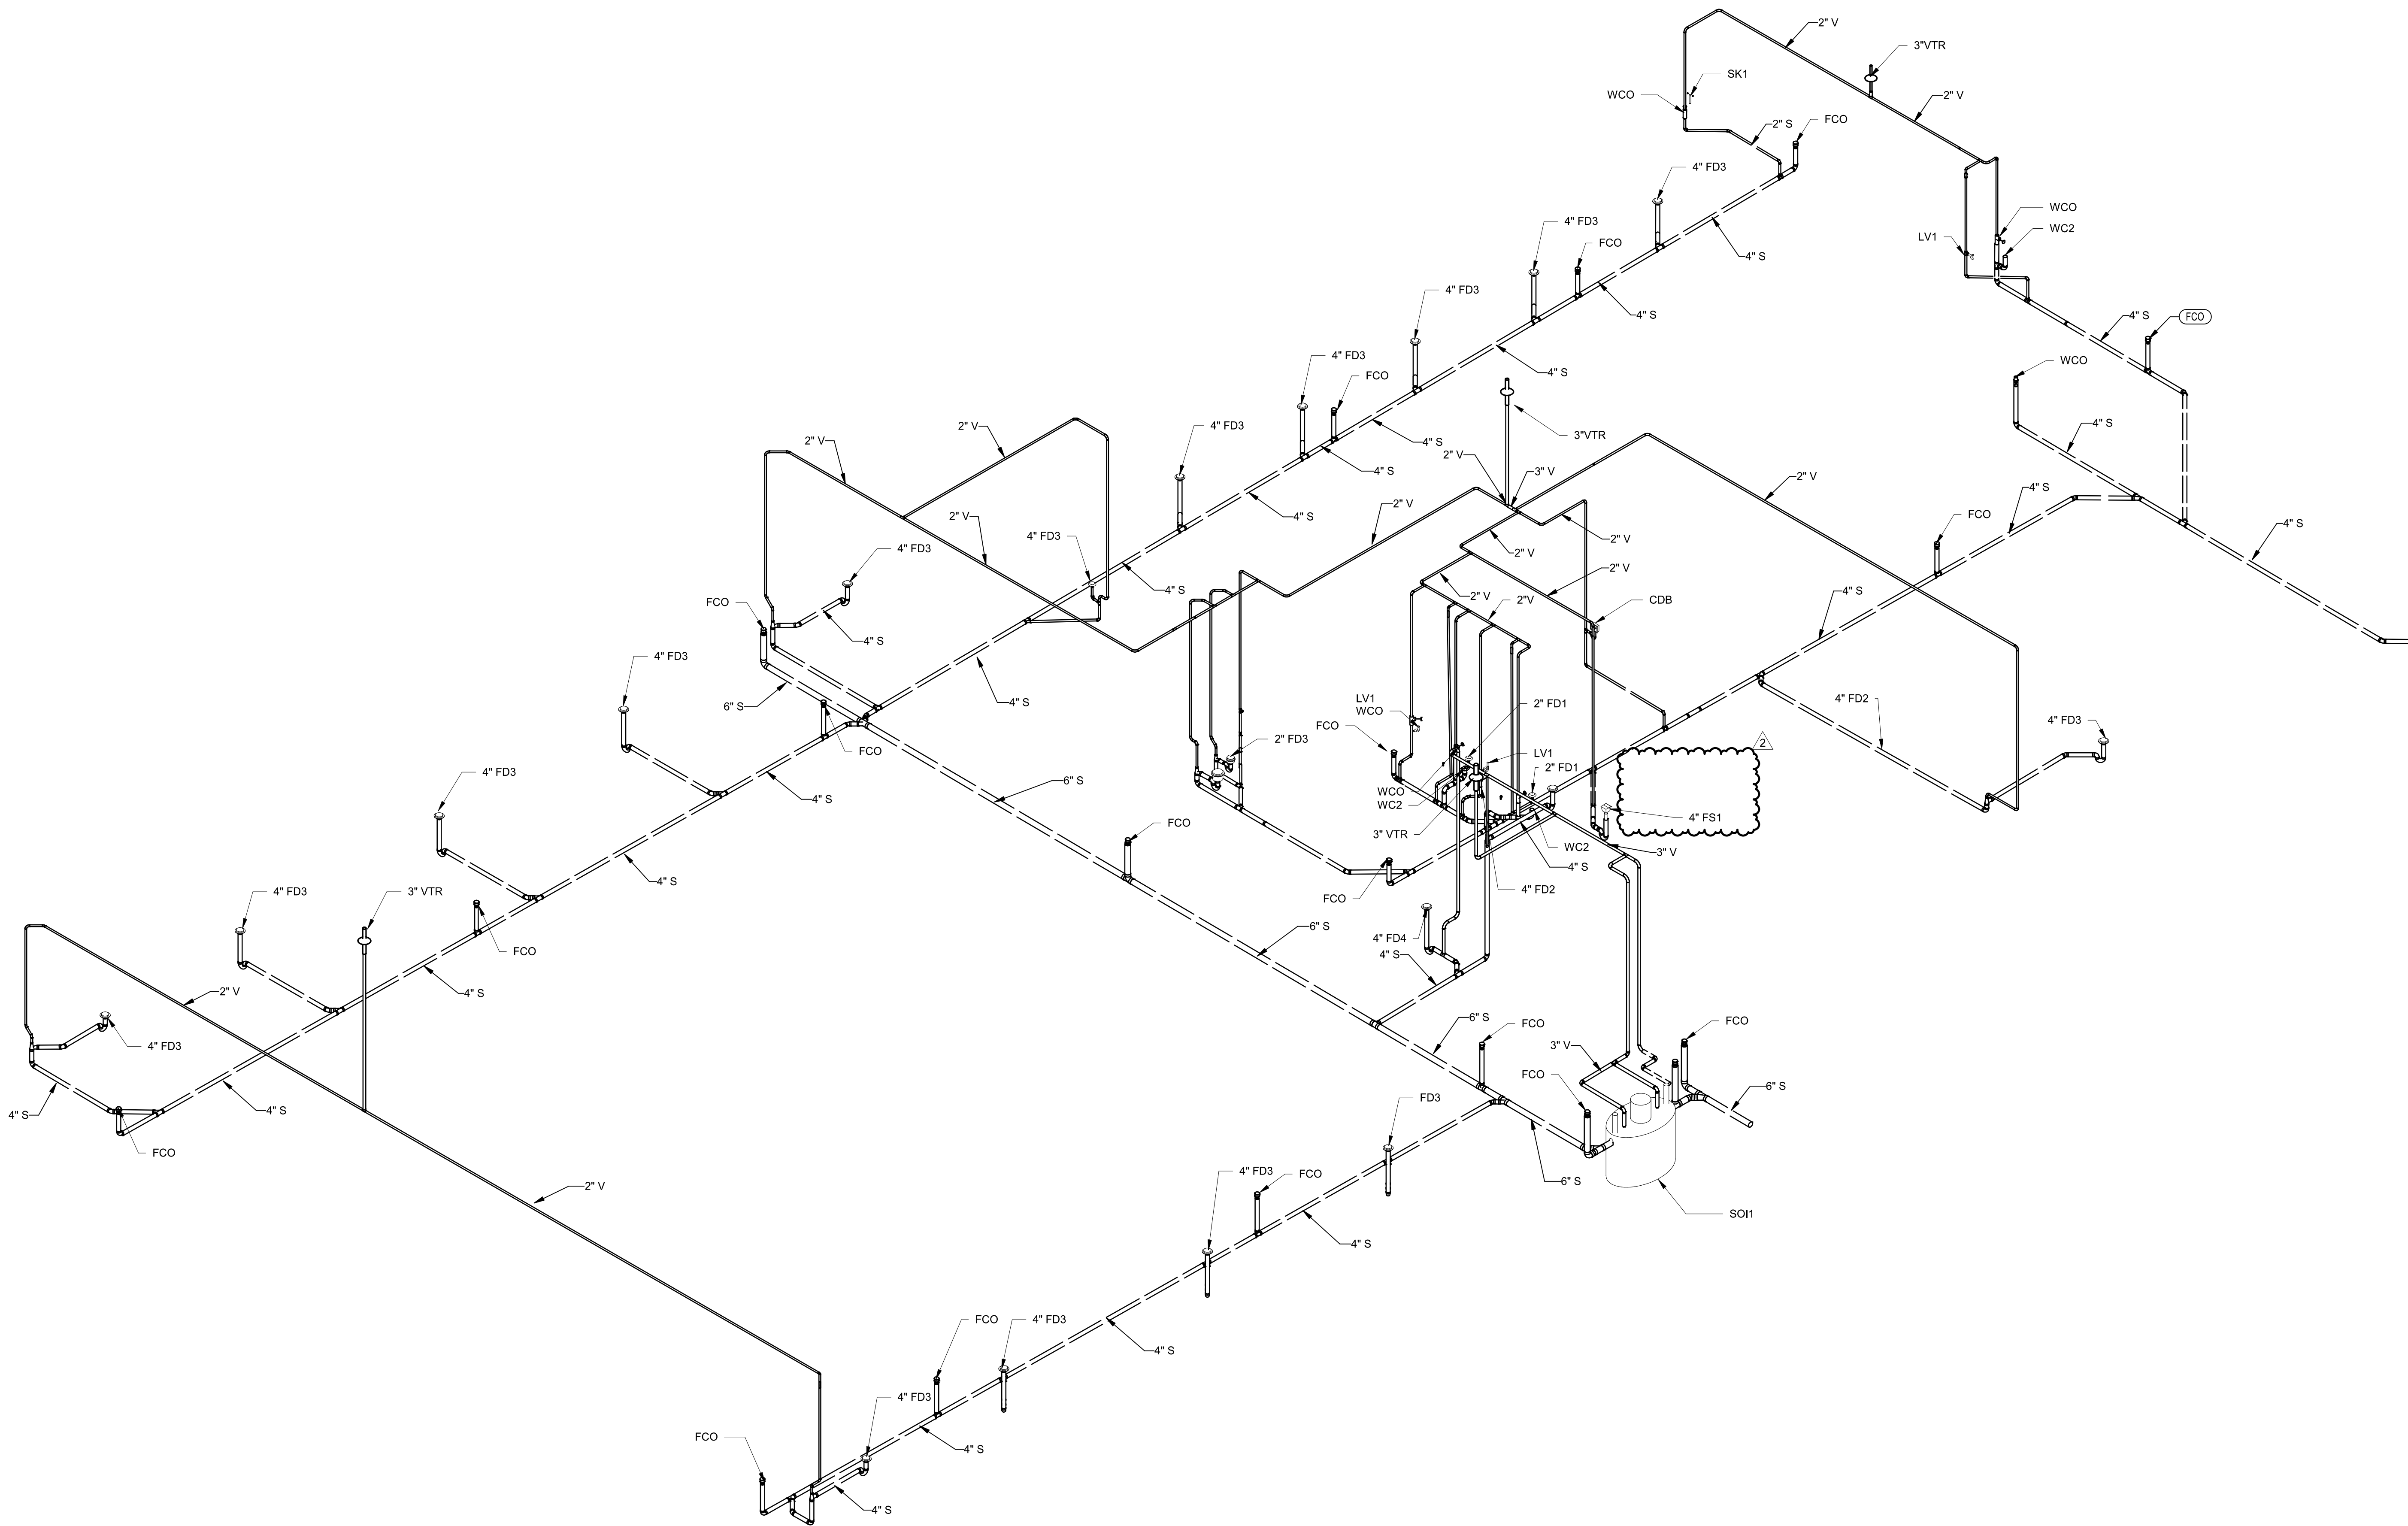

1 PLUMBING RISER - AREA B & C  
NTS



5039 S National Avenue | Springfield, MO 65810 | 417.887.6595

**OWNER**  
CITY OF WENTZVILLE, MISSOURI  
1001 SCHROEDER CREEK BLVD  
WENTZVILLE, MO 63385  
636.327.5101

**PROJECT TEAM**  
**CIVIL ENGINEER**  
PREMIER DESIGN GROUP  
100 MIDLAND PARK DRIVE  
WENTZVILLE, MO 63385  
314.925.7444  
**MAINTENANCE CONSULTANT**  
HDR ENGINEERING, INC.  
17725 KATY FREEWAY SUITE 102  
HOUSTON, TX 77054  
816.360.2700  
**STRUCTURAL ENGINEER**  
METTEMAYER ENGINEERING  
2225 W CHESTERFIELD BLVD., SUITE 300  
SPRINGFIELD, MO 65807  
417.890.8002  
**MEP ENGINEER**  
HENDERSON ENGINEERS, INC.  
8345 LENEXA DR., #300  
LENEXA, KS 66214  
913.742.5000  
. . .



REVISIONS		
NO.	DESCRIPTION	DATE
2	ADD 02	01.25.23

PROJECT NO.: 19-040 DRAWN BY: Author  
DATE: 12.15.22 REVIEWED BY: Checker



01/24/2023

CARL J. HOLDEN  
LICENSE # PE-2020016283

**PROJECT TITLE**  
CITY OF WENTZVILLE, MO PUBLIC  
WORKS FACILITY  
**PROJECT ADDRESS:**  
1295 INTERSTATE DRIVE  
WENTZVILLE, MO 63385

PLUMBING SANITARY RISER





## PROJECT TEAM


MEP ENGINEER  
HENDERSON ENGINEERS, INC.  
8345 LENEXA DR., #300  
LENEXA, KS 66214  
913.742.5000

8345 LENEXA DRIVE, SUITE 300  
LENEXA, KS 66214  
TEL 913.742.5000 FAX 913.742.5001  
**WWW.HENDERSONENGINEERS.COM**

EXPIRES 12/31/2023

## REVISIONS

PROJECT NO.: 19-040 DRAWN BY: Author  
DATE: 12.15.22 REVIEWED BY: Checker

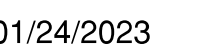

PROJECT ADDRESS:  
1295 INTERSTATE DRIVE  
WENTZVILLE, MO 63385

## PLUMBING SANITARY RISER

SHEET  
P301



② PLUMBING RISER - AREA D  
NTS



**OWNER**  
CITY OF WENTZVILLE, MISSOURI  
1001 SCHROEDER CREEK BLVD  
WENTZVILLE, MO 63385  
636.327.5101

**PROJECT TEAM**  
CIVIL ENGINEER  
PREMIER DESIGN GROUP  
100 MIDLAND PARK DRIVE  
WENTZVILLE, MO 63385  
314.925.7444  
MAINTENANCE CONSULTANT  
HDR ENGINEERING, INC.  
17725 KATY FREEWAY SUITE 102  
HOUSTON, TX 77044  
816.360.2700  
STRUCTURAL ENGINEER  
METTEMAYER ENGINEERING  
2225 W CHESTERFIELD BLVD., SUITE 300  
SPRINGFIELD, MO 65807  
417.890.8002  
MEP ENGINEER  
HENDERSON ENGINEERS, INC.  
8345 LENEXA DR., #300  
LENEXA, KS 66214  
913.742.5000

**HENDERSON**  
ENGINEERS  
8345 LENEXA DRIVE, SUITE 300  
LENEXA, KS 66214  
TEL 913.742.5000 FAX 913.742.5001  
WWW.HENDERSONENGINEERS.COM  
1950004840  
EXPIRES 12/31/2023

**REVISIONS**

NO.	DESCRIPTION	DATE
2	ADD 02	01.25.23

PROJECT NO.: 19-040 DRAWN BY: MJ  
DATE: 12.15.22 REVIEWED BY: HEI



01/24/2023

CARL J. HOLDEN  
LICENSE # PE-2020016283

**PROJECT TITLE**  
CITY OF WENTZVILLE, MO PUBLIC  
WORKS FACILITY


**PROJECT ADDRESS:**  
1295 INTERSTATE DRIVE  
WENTZVILLE, MO 63385

**PLUMBING ENLARGED PLANS**


P400

**PLUMBING PLAN NOTES:**


③ PLUMBING LEVEL 1 PLAN - RESTROOM WATER & GAS  
1/4" = 1'-0"

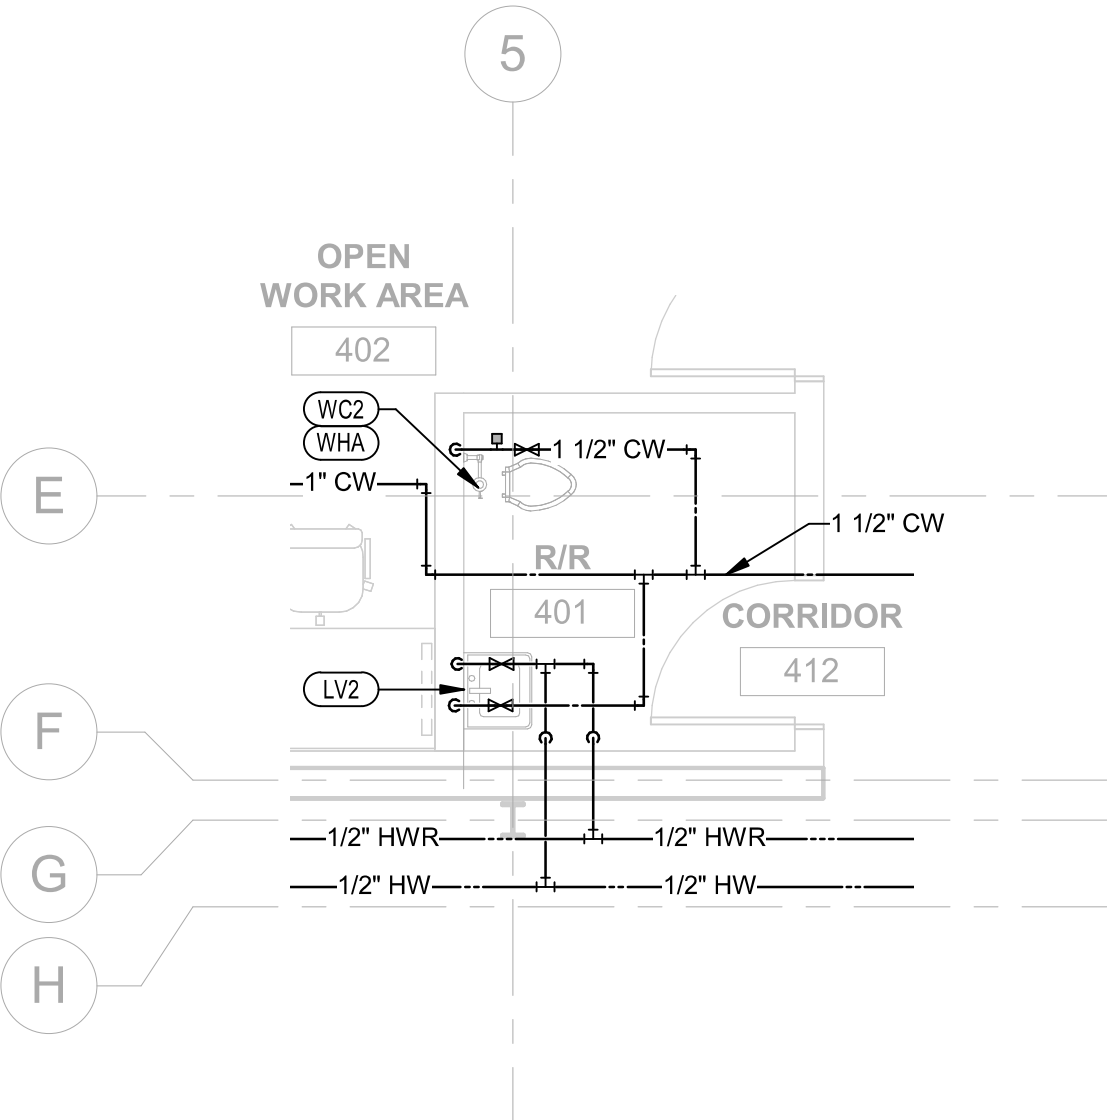


⑤ PLUMBING LEVEL 1 WATER AND GAS ENLARGED PLAN  
1/4" = 1'-0"

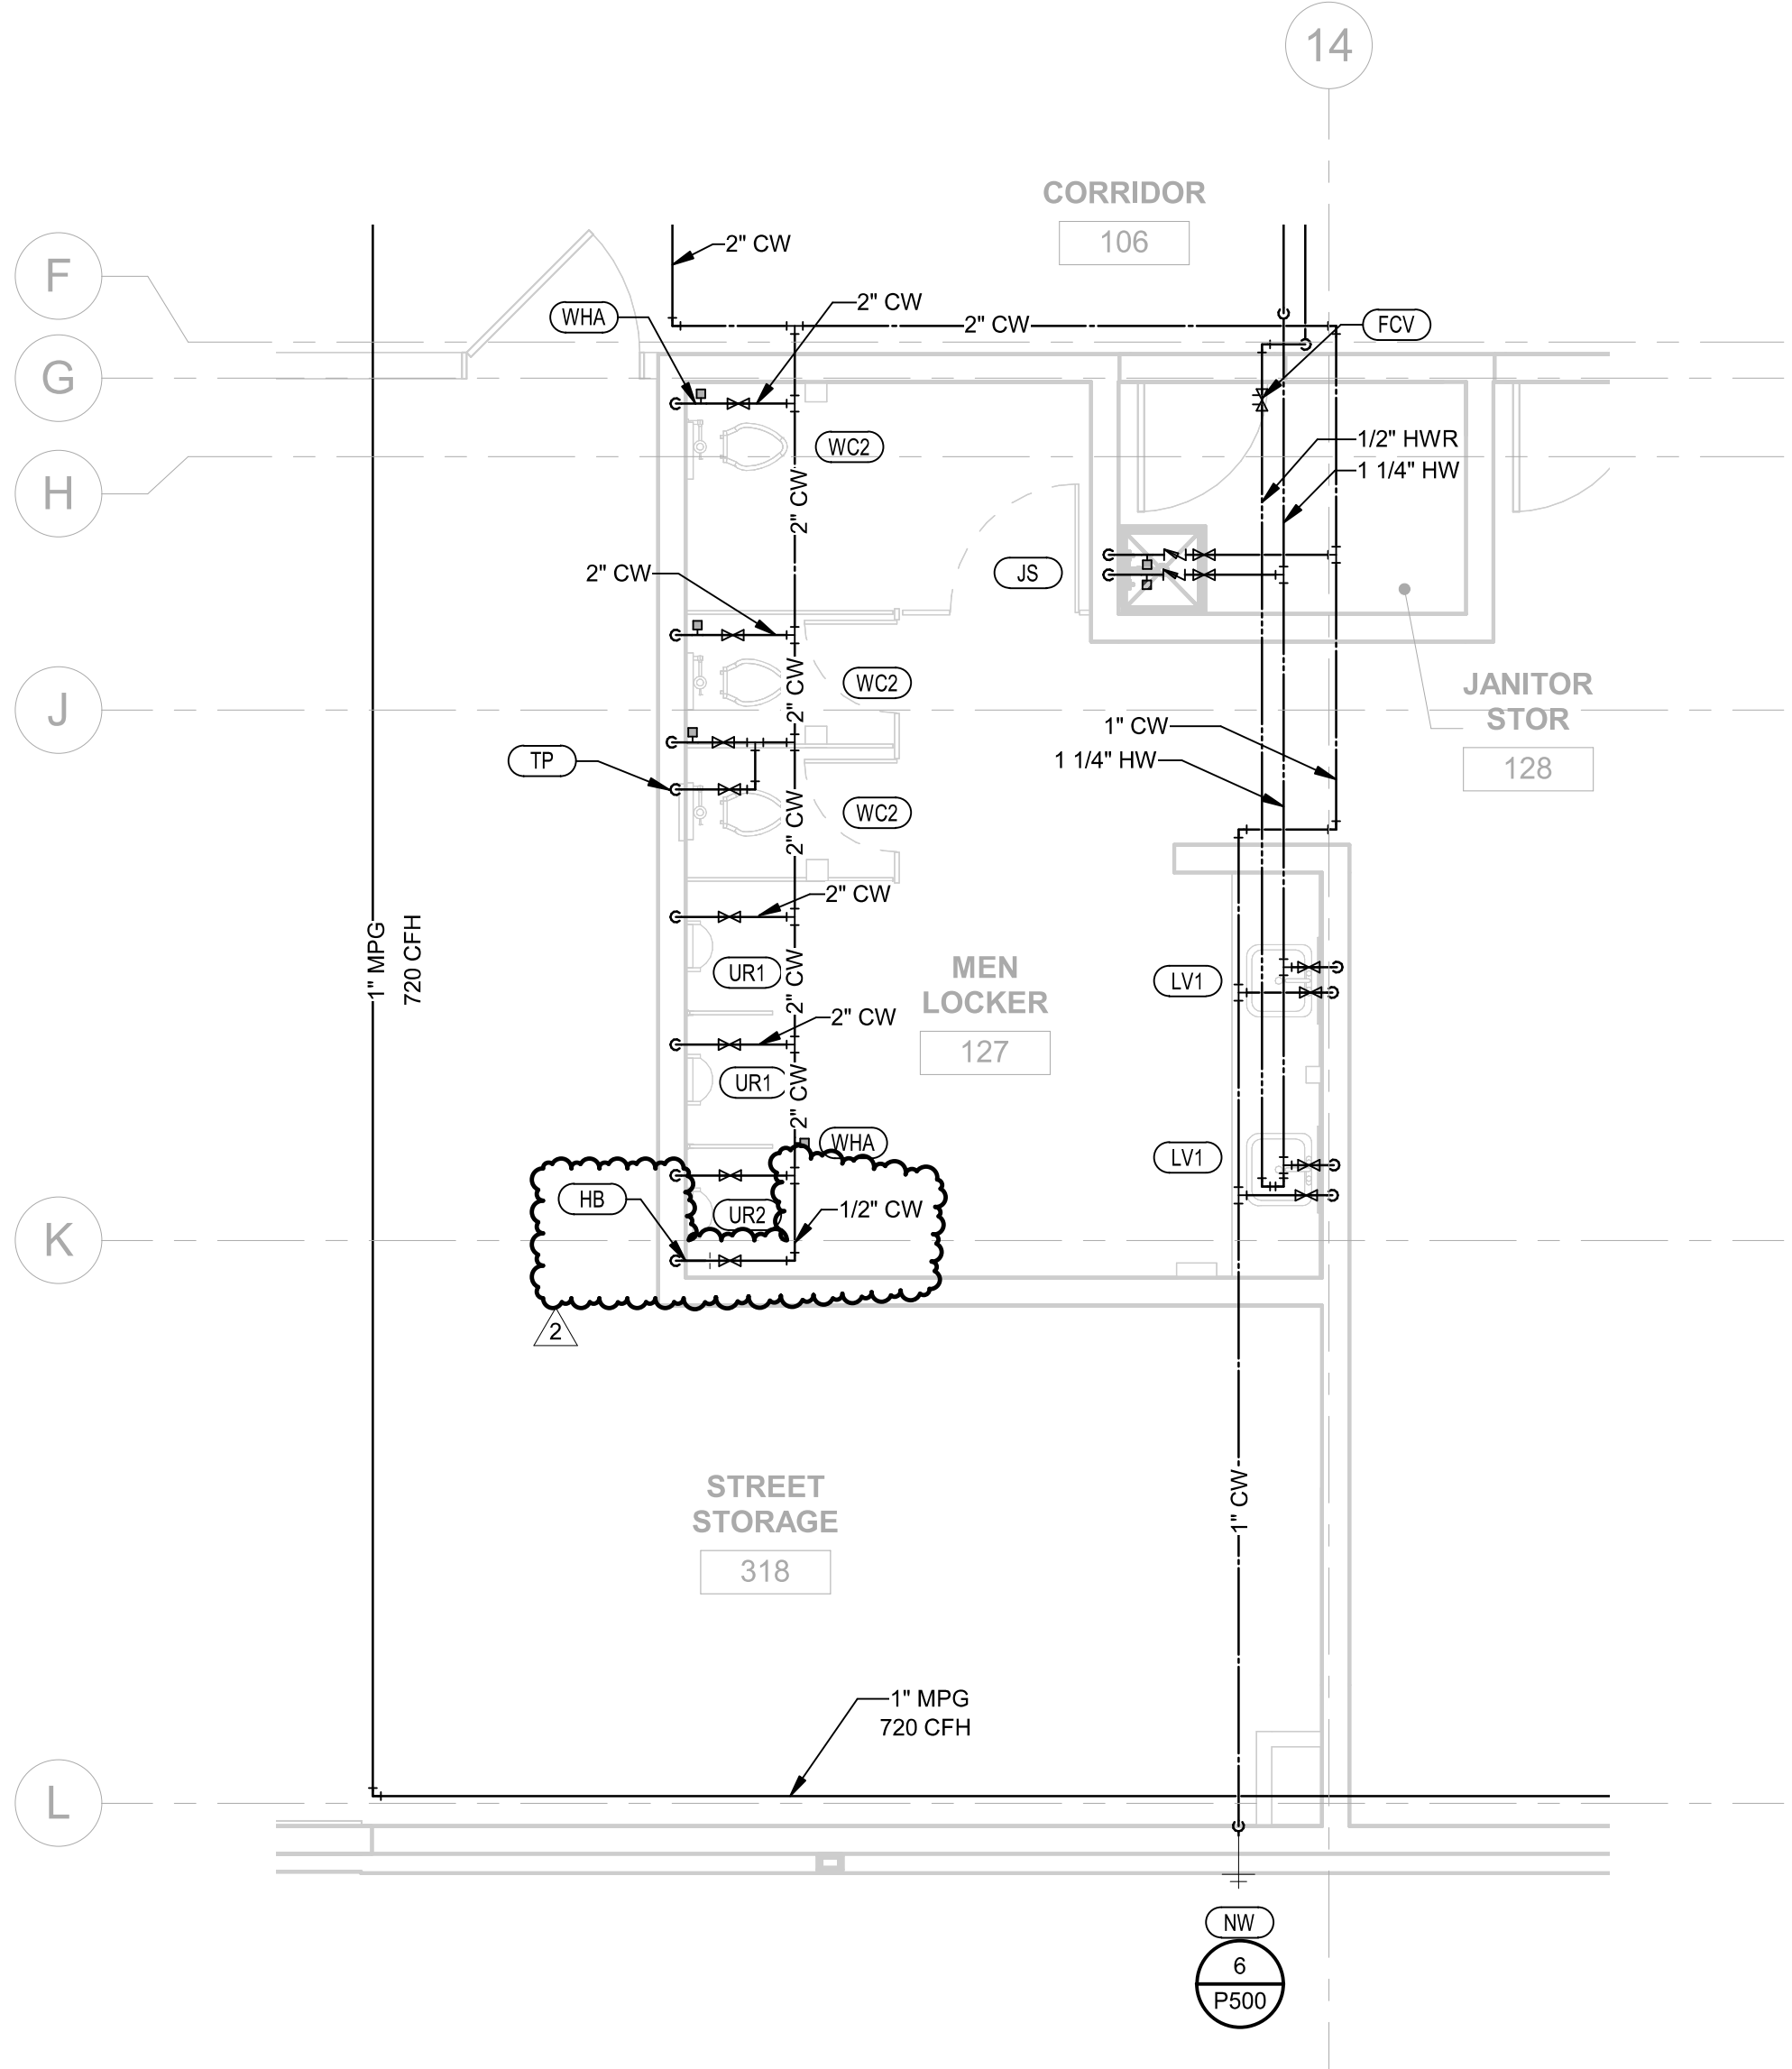


④ PLUMBING LEVEL 1 WASTE AND VENT ENLARGED PLAN  
1/4" = 1'-0"

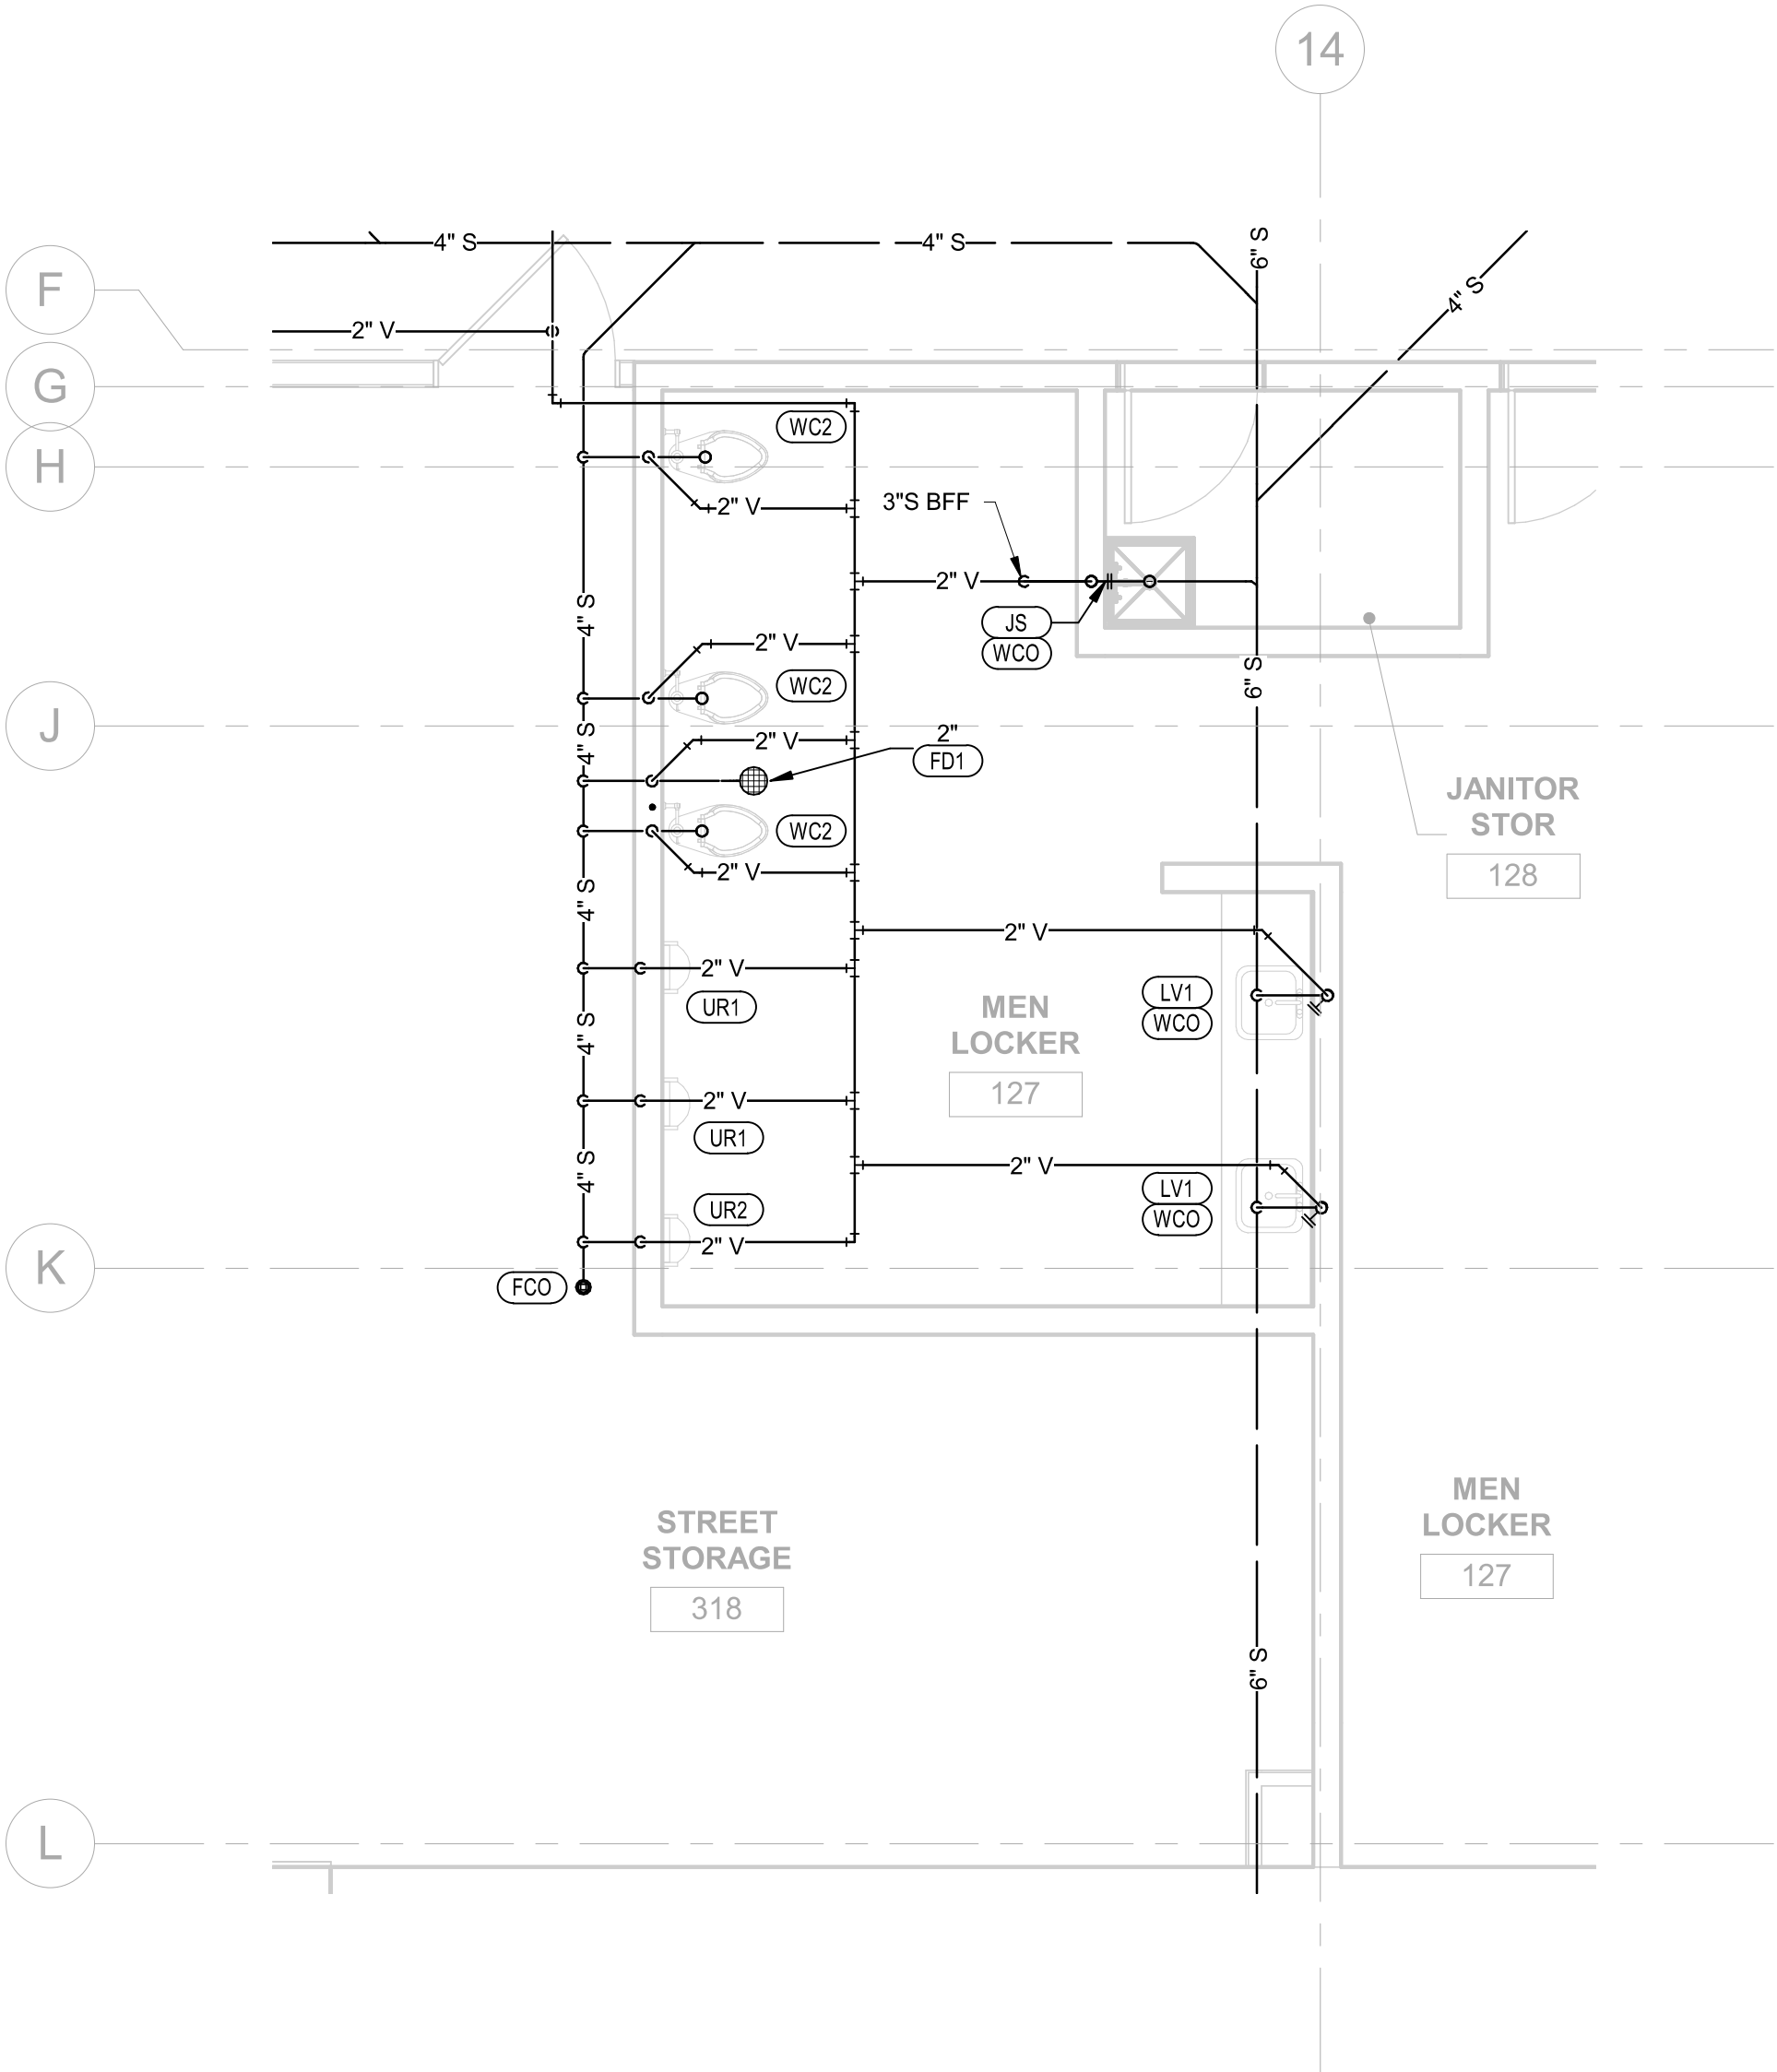


③ PLUMBING LEVEL 1 PLAN - RESTROOM WASTE & VENT  
1/4" = 1'-0"

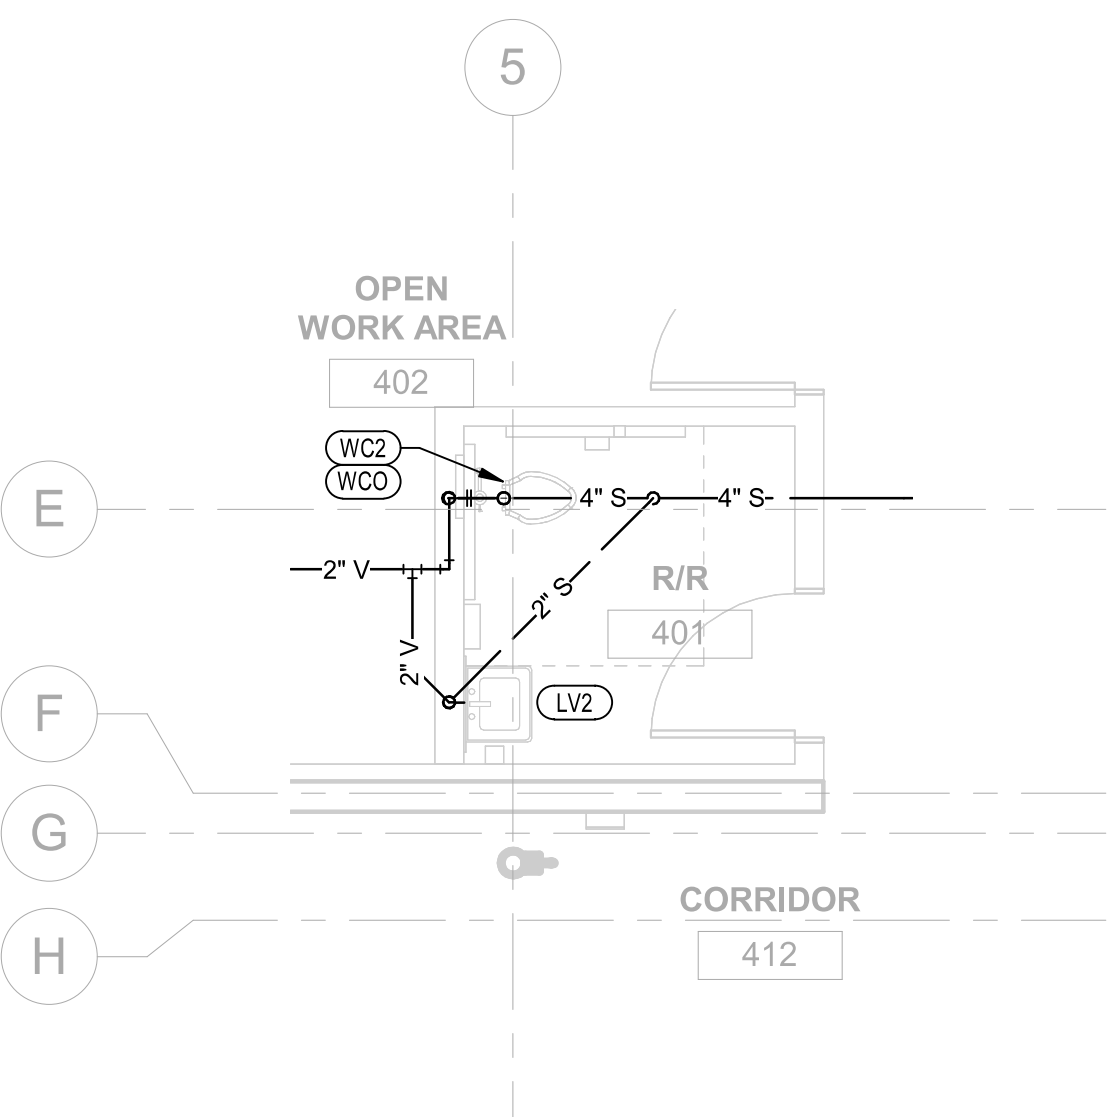

② PLUMBING LEVEL 1 WATER AND GAS ENLARGED PLAN  
1/4" = 1'-0"

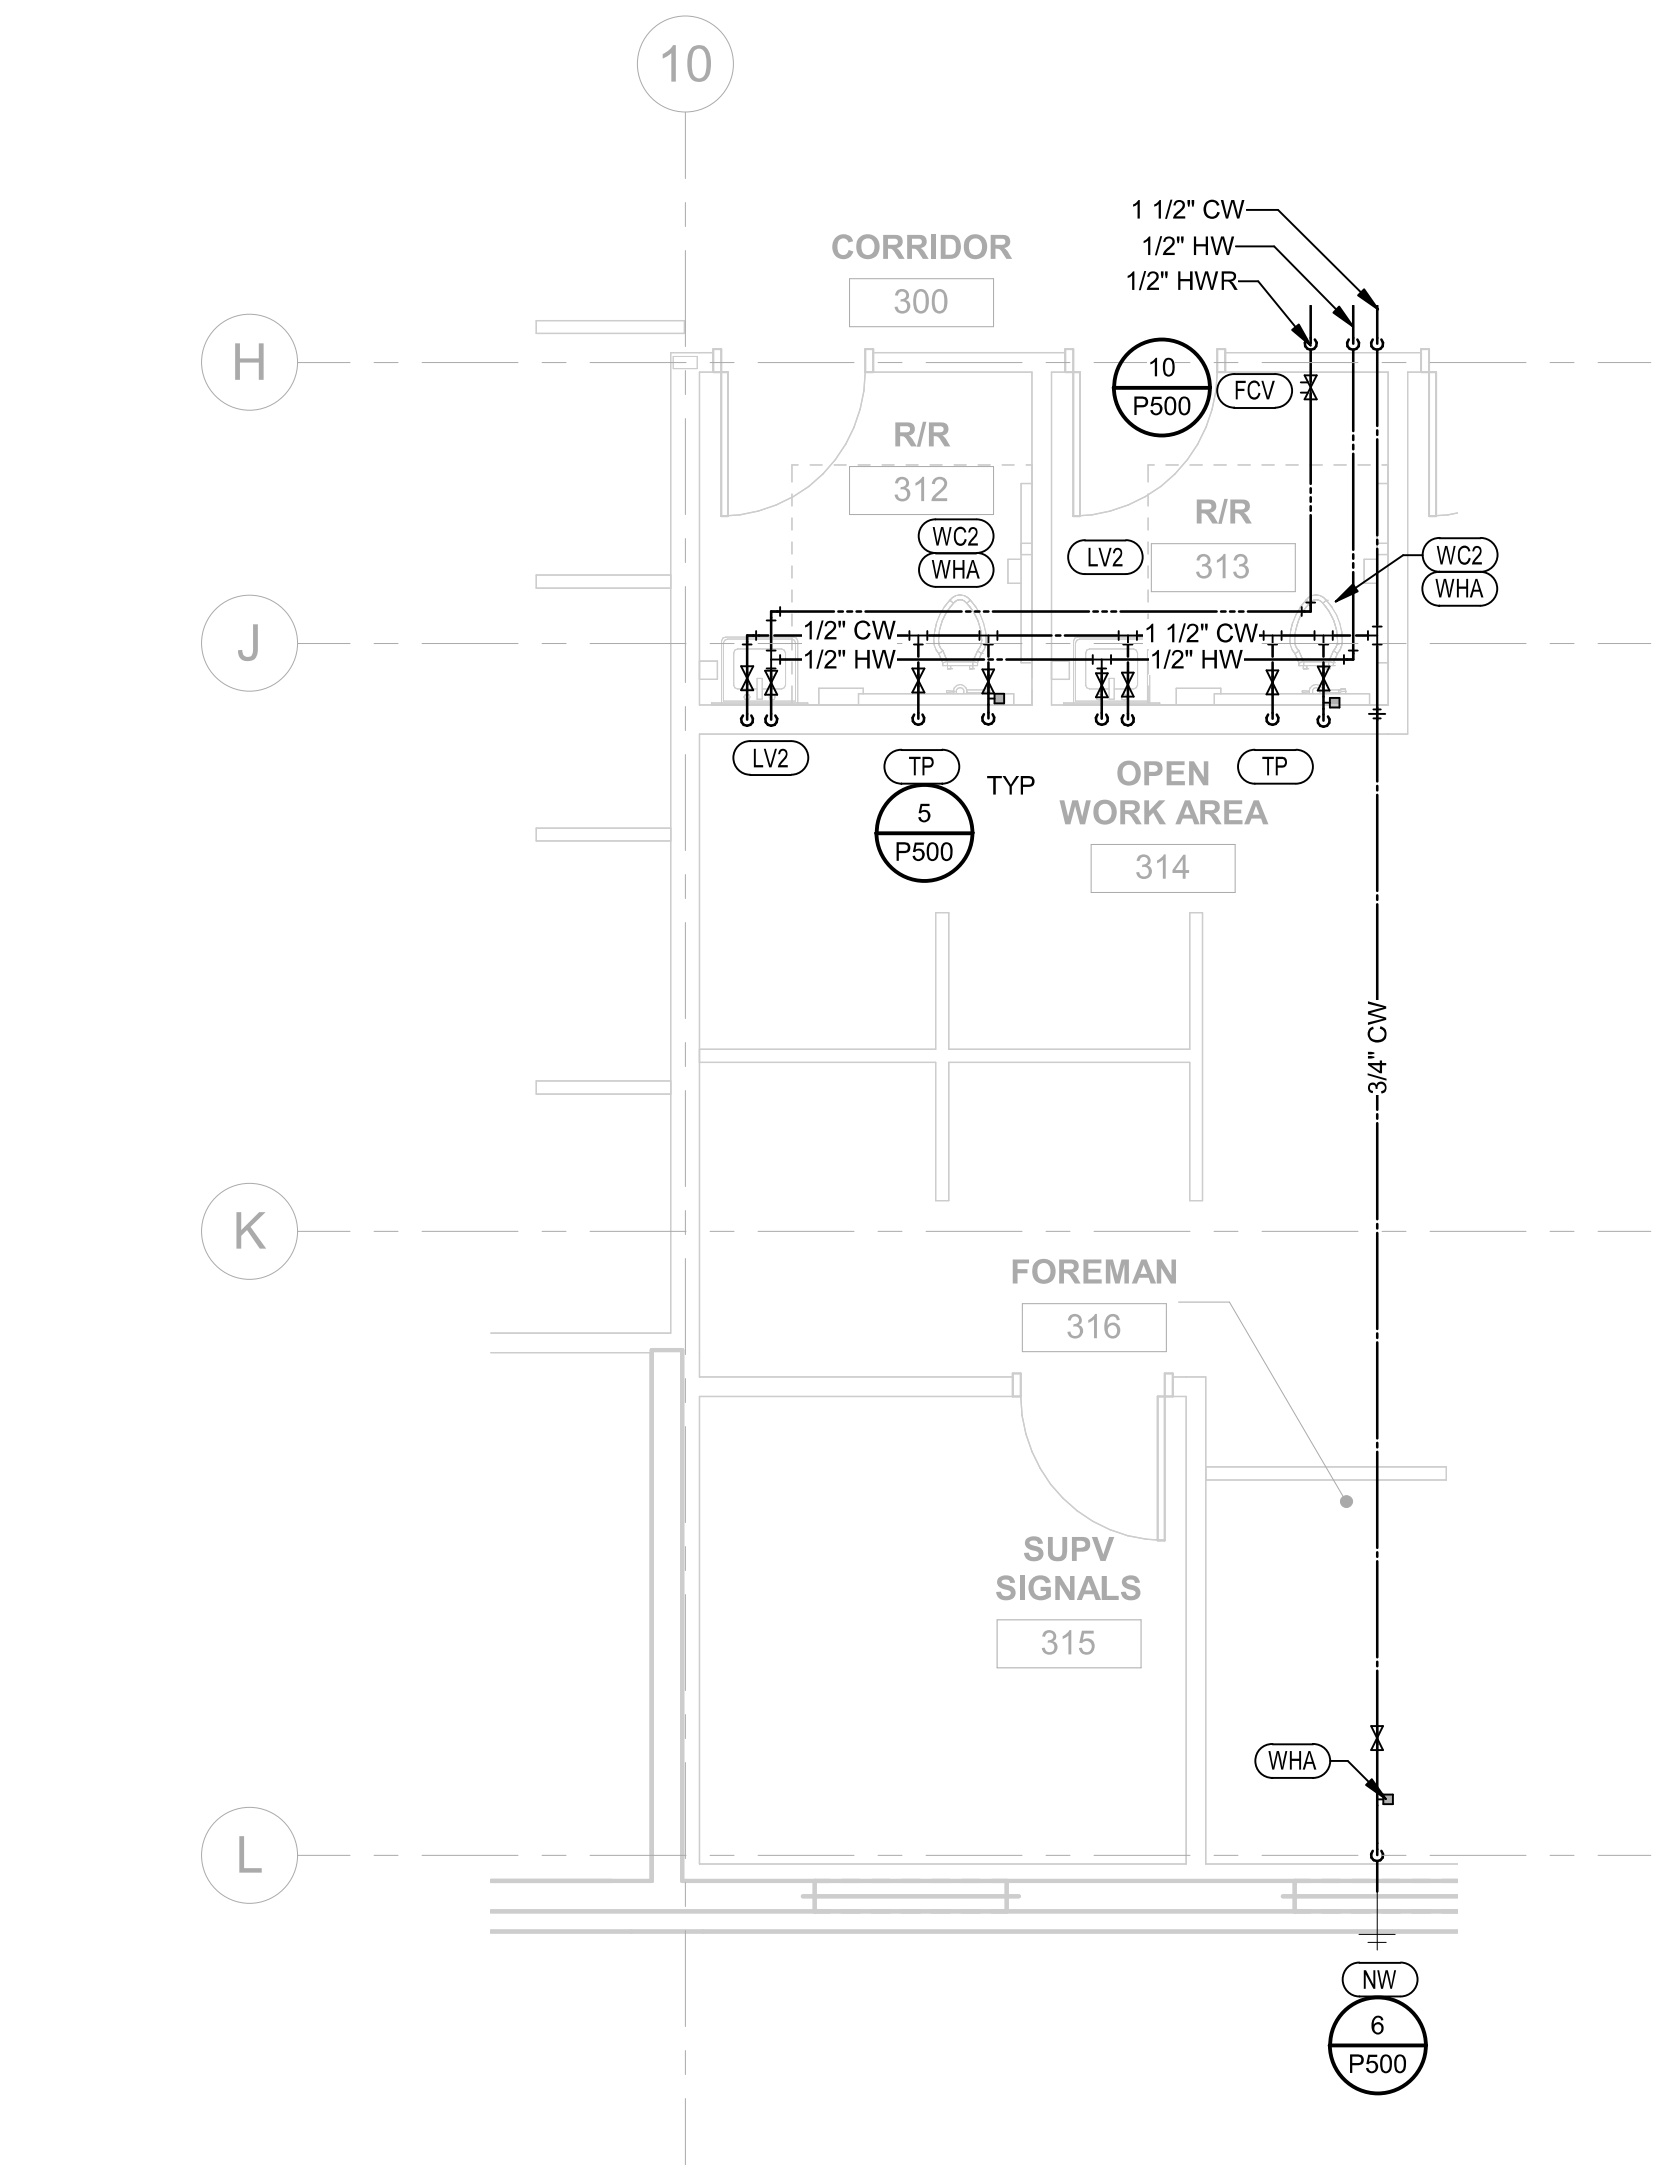

① PLUMBING LEVEL 1 WASTE AND VENT ENLARGED PLAN  
1/4" = 1'-0"

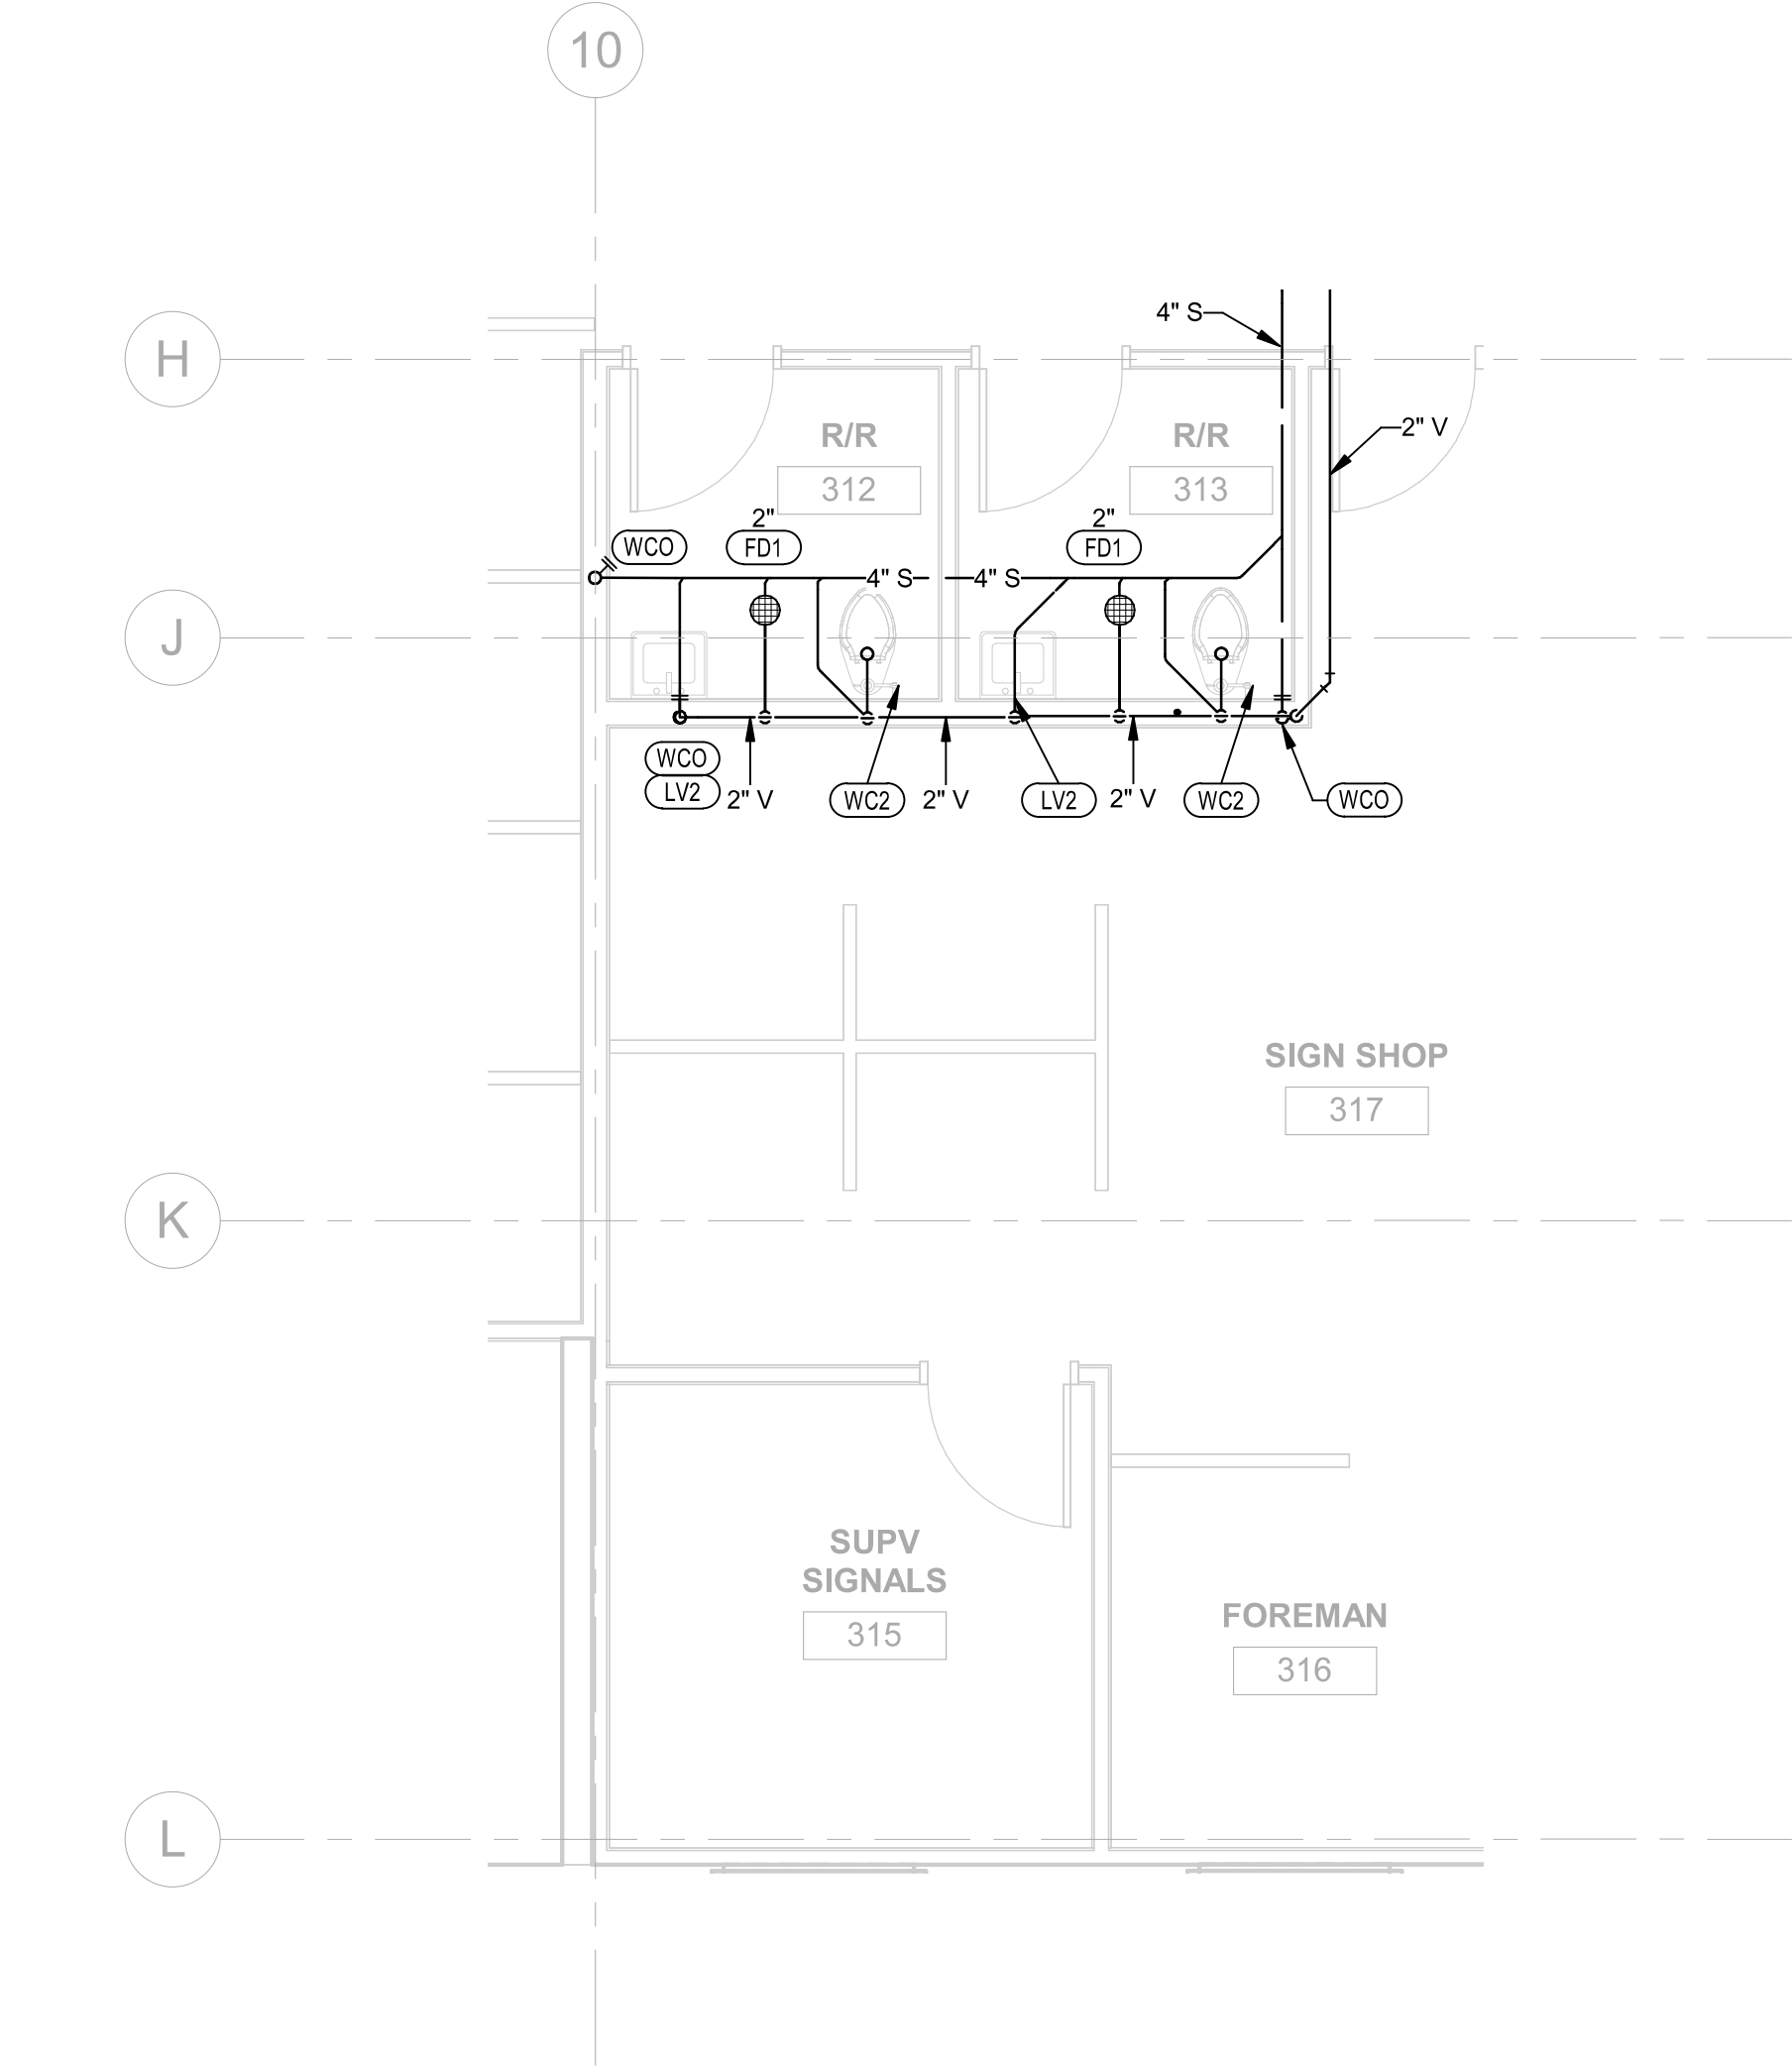

**OWNER**  
CITY OF WENTZVILLE, MISSOURI  
1001 SCHROEDER CREEK BLVD  
WENTZVILLE, MO 63385  
636.327.5101

**PROJECT TEAM**  
CIVIL ENGINEER  
PREMIER DESIGN GROUP  
100 MIDLAND PARK DRIVE  
WENTZVILLE, MO 63385  
314.925.7444  
MAINTENANCE CONSULTANT  
HDR ENGINEERING, INC.  
17725 KATY FREEWAY SUITE 102  
HOUSTON, TX 77054  
816.360.2700  
STRUCTURAL ENGINEER  
METTEMAYER ENGINEERING  
2225 W CHESTERFIELD BLVD., SUITE 300  
SPRINGFIELD, MO 65807  
417.890.8002  
MEP ENGINEER  
HENDERSON ENGINEERS, INC.  
8345 LENEXA DR., #300  
LENEXA, KS 66214  
913.742.5000

**HENDERSON**  
ENGINEERS  
8345 LENEXA DRIVE, SUITE 300  
LENEXA, KS 66214  
TEL 913.742.5000 FAX 913.742.5001  
WWW.HENDERSONENGINEERS.COM  
1950004840  
EXPIRES 12/31/2023

REVISIONS		
NO.	DESCRIPTION	DATE
2	ADD 02	01.25.23

PROJECT NO.: 19-040 DRAWN BY: MJ  
DATE: 12.15.22 REVIEWED BY: HEI




CARL J. HOLDEN  
LICENSE # PE-2020016283


**PROJECT TITLE**  
CITY OF WENTZVILLE, MO PUBLIC  
WORKS FACILITY  
PROJECT ADDRESS:  
1295 INTERSTATE DRIVE  
WENTZVILLE, MO 63385

PLUMBING ENLARGED PLANS


- PLUMBING PLAN NOTES:**
- P1 DO NOT INSTALL PLUMBING PIPING OVER ELECTRICAL PANELS OR EQUIPMENT.
- P2 DO NOT ROUTE ANY PLUMBING PIPING OVERHEAD IN THE DF OR MDF (DATA) ROOMS. ANY PIPING ABOVE THIS AREA SHALL BE PROTECTED WITH DRIP PAN AS PER THE SPECIFICATIONS.

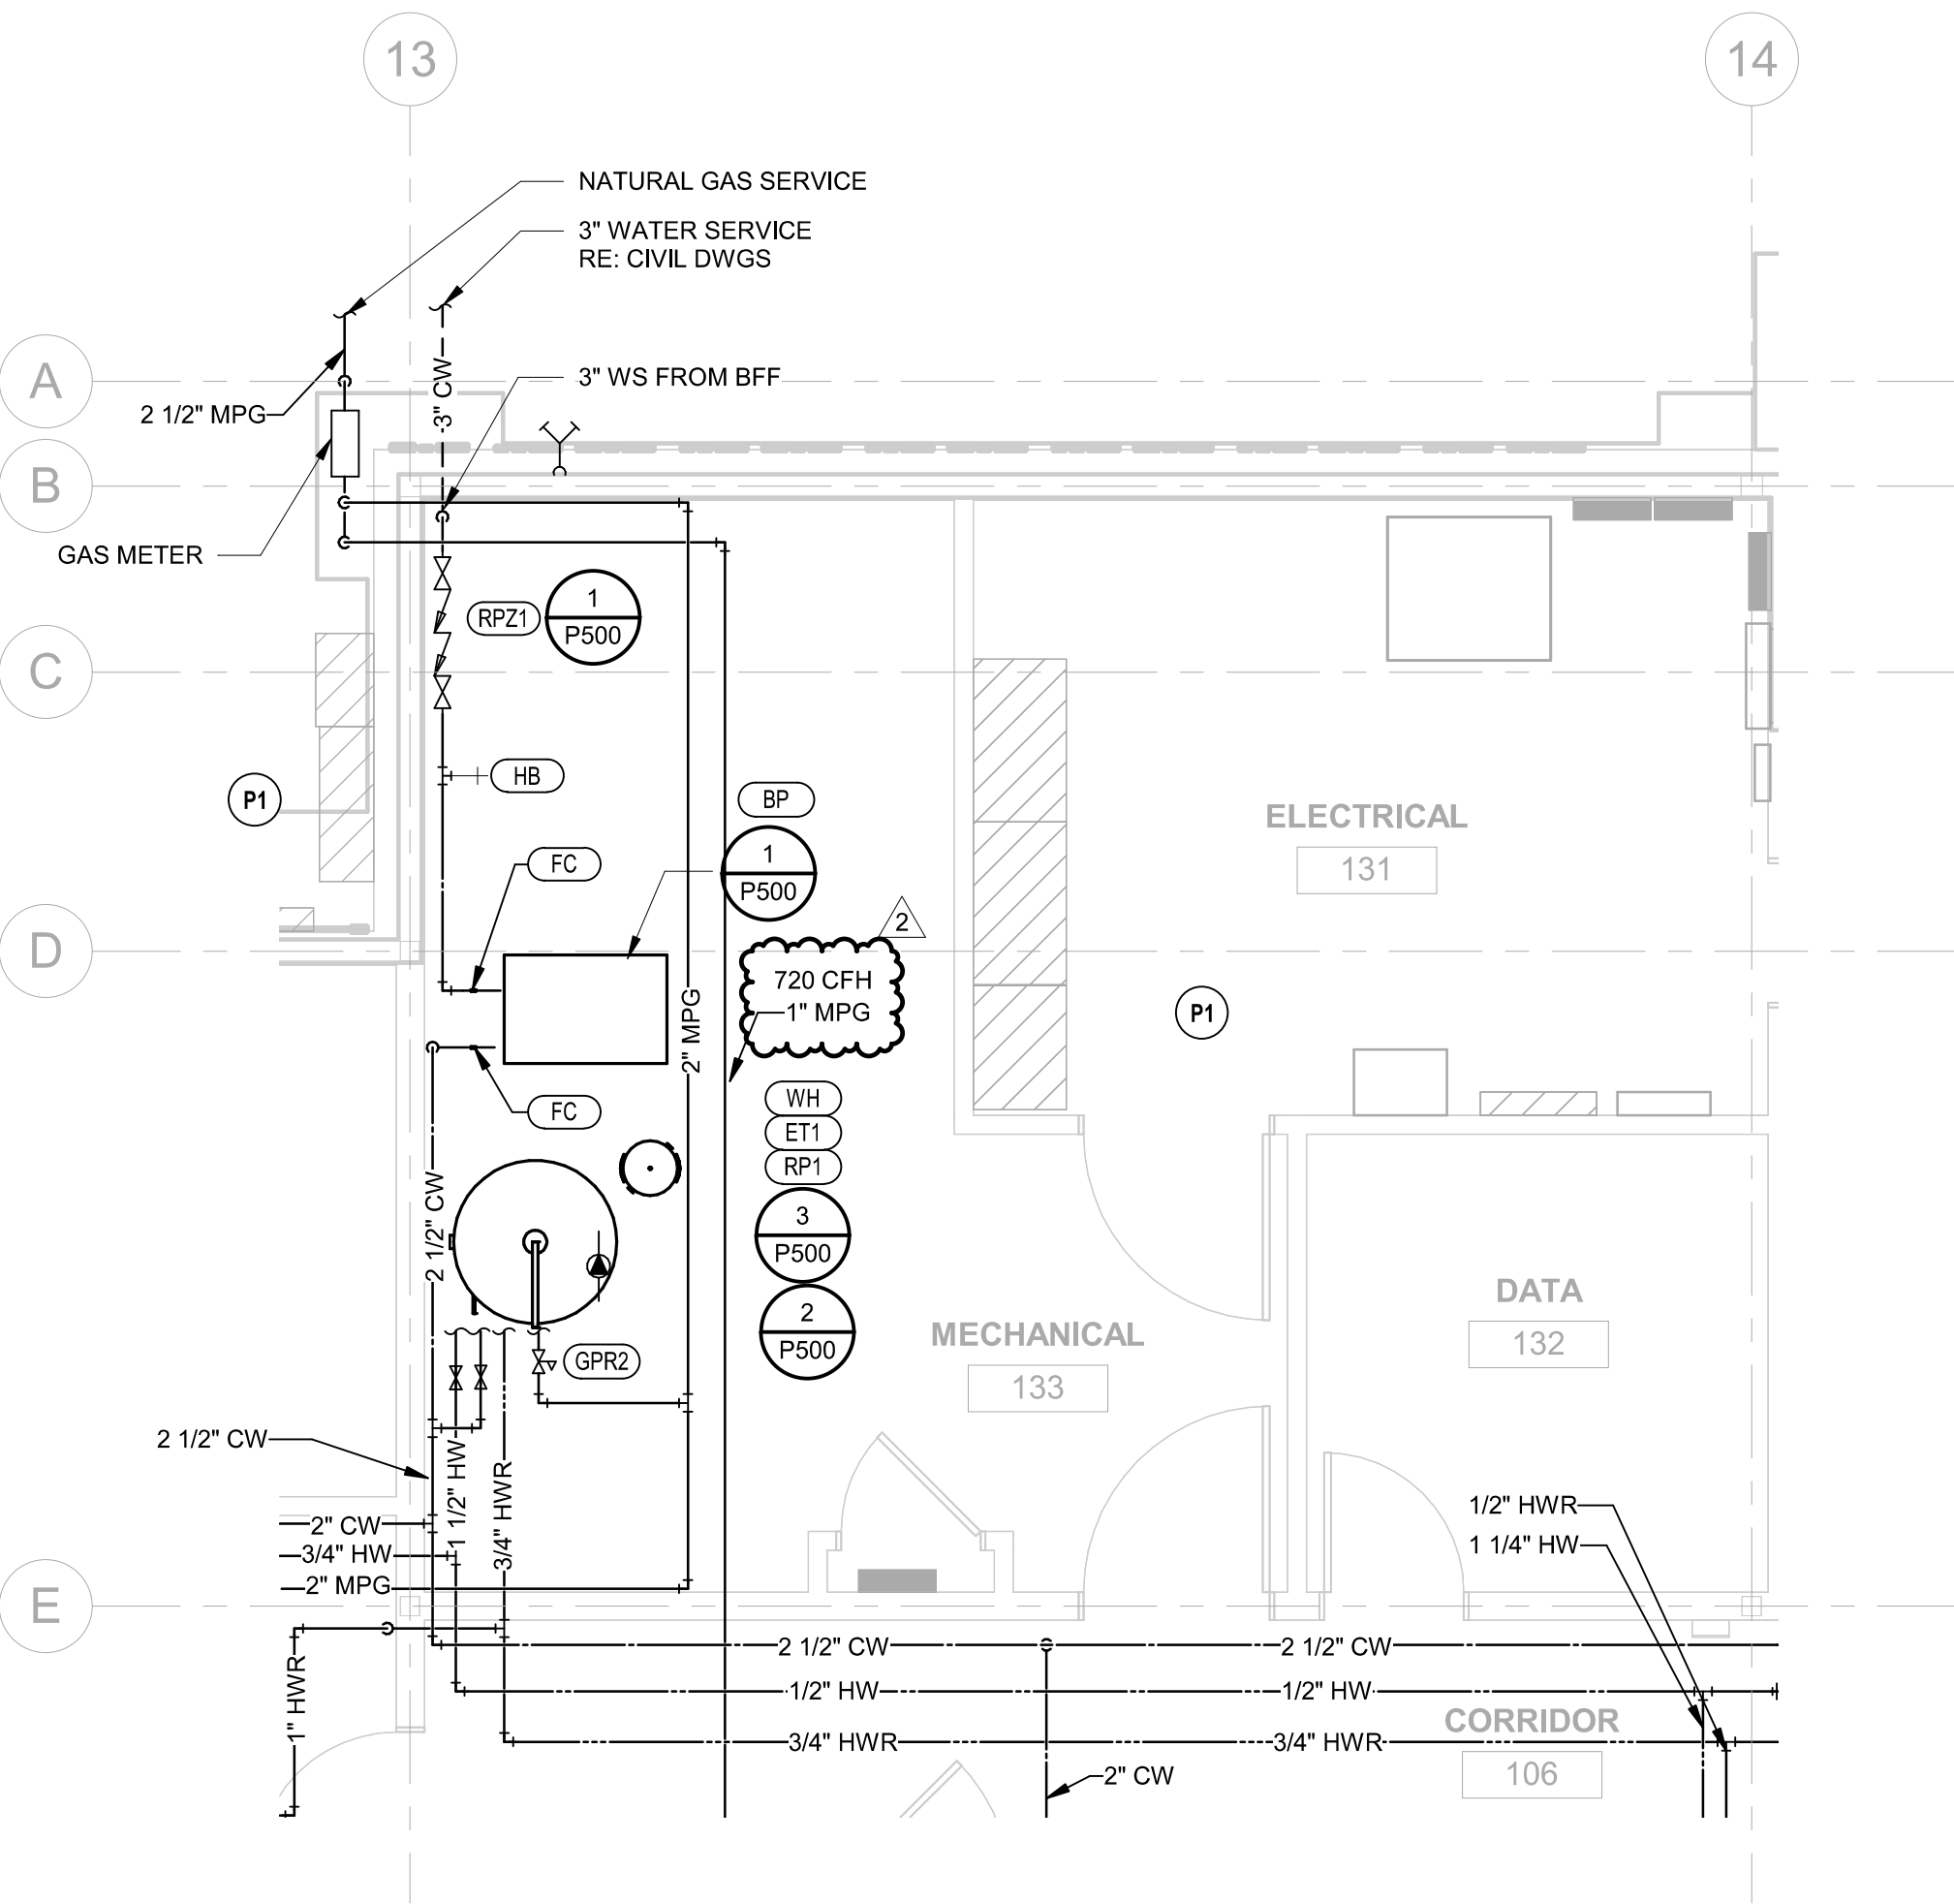


4 PLUMBING LEVEL 1 WATER AND GAS ENLARGED PLAN  
1/4" = 1'-0"

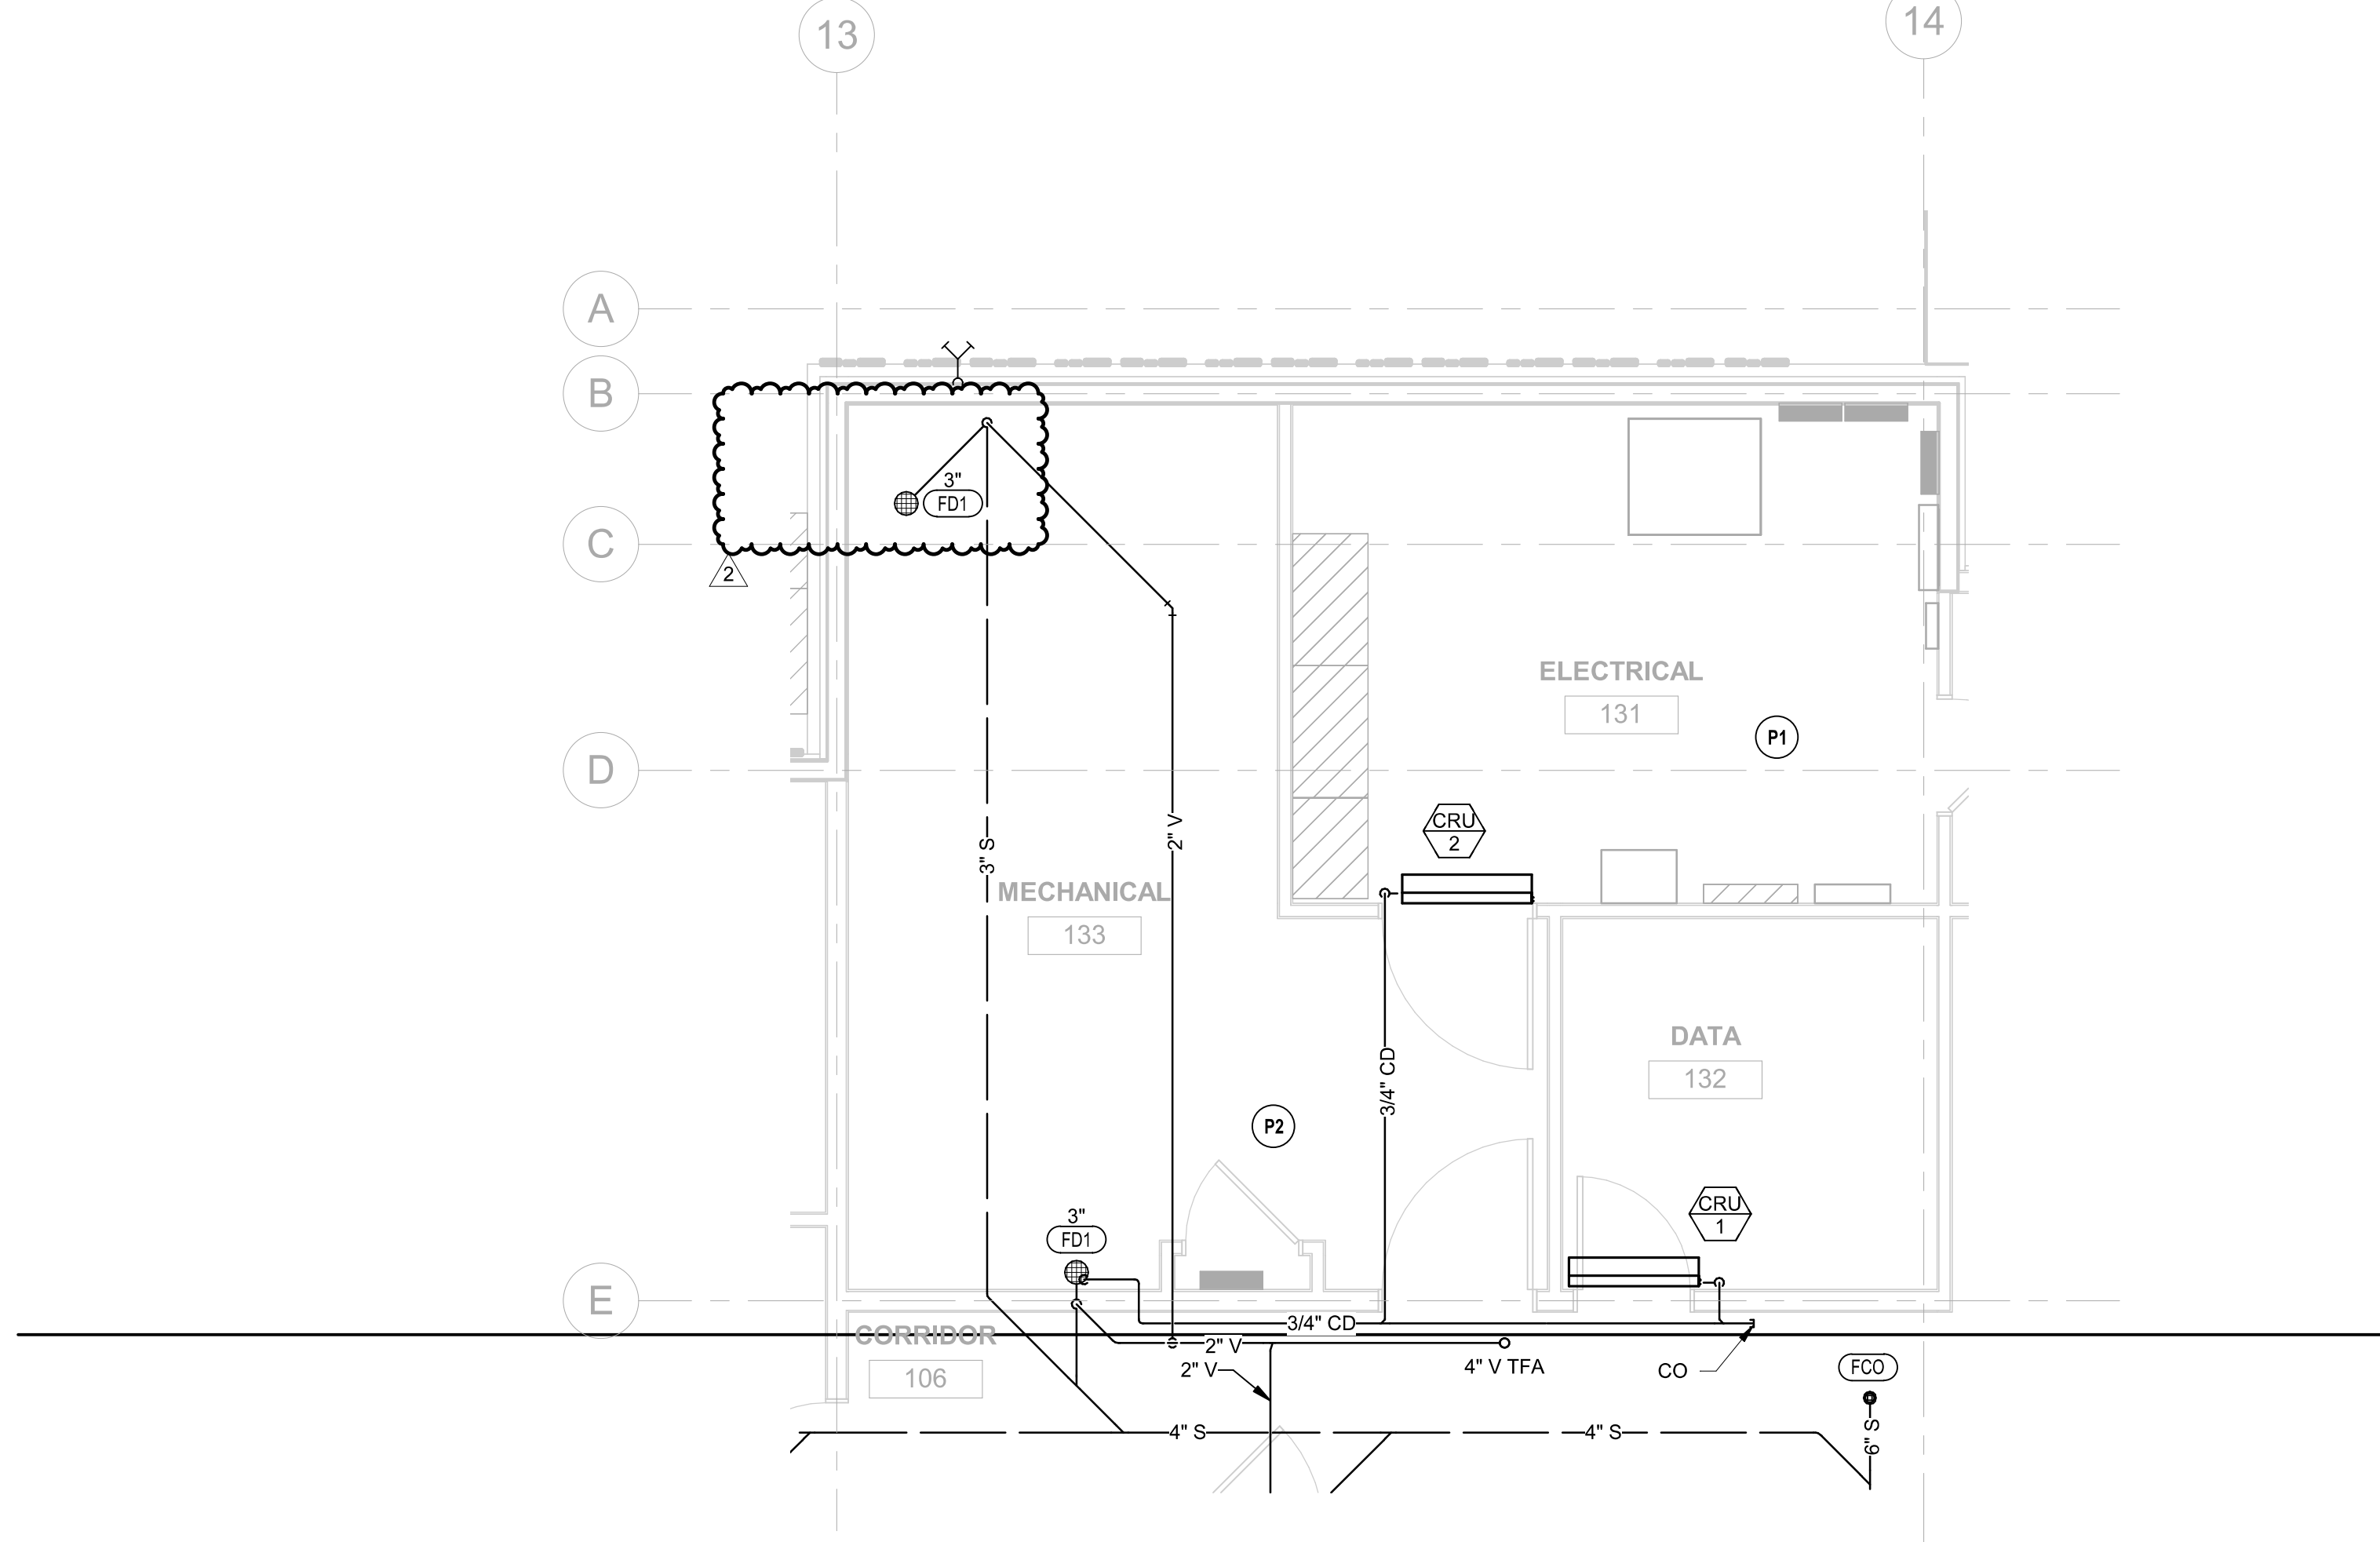

3 PLUMBING LEVEL 1 WASTE AND VENT ENLARGED PLAN  
1/4" = 1'-0"

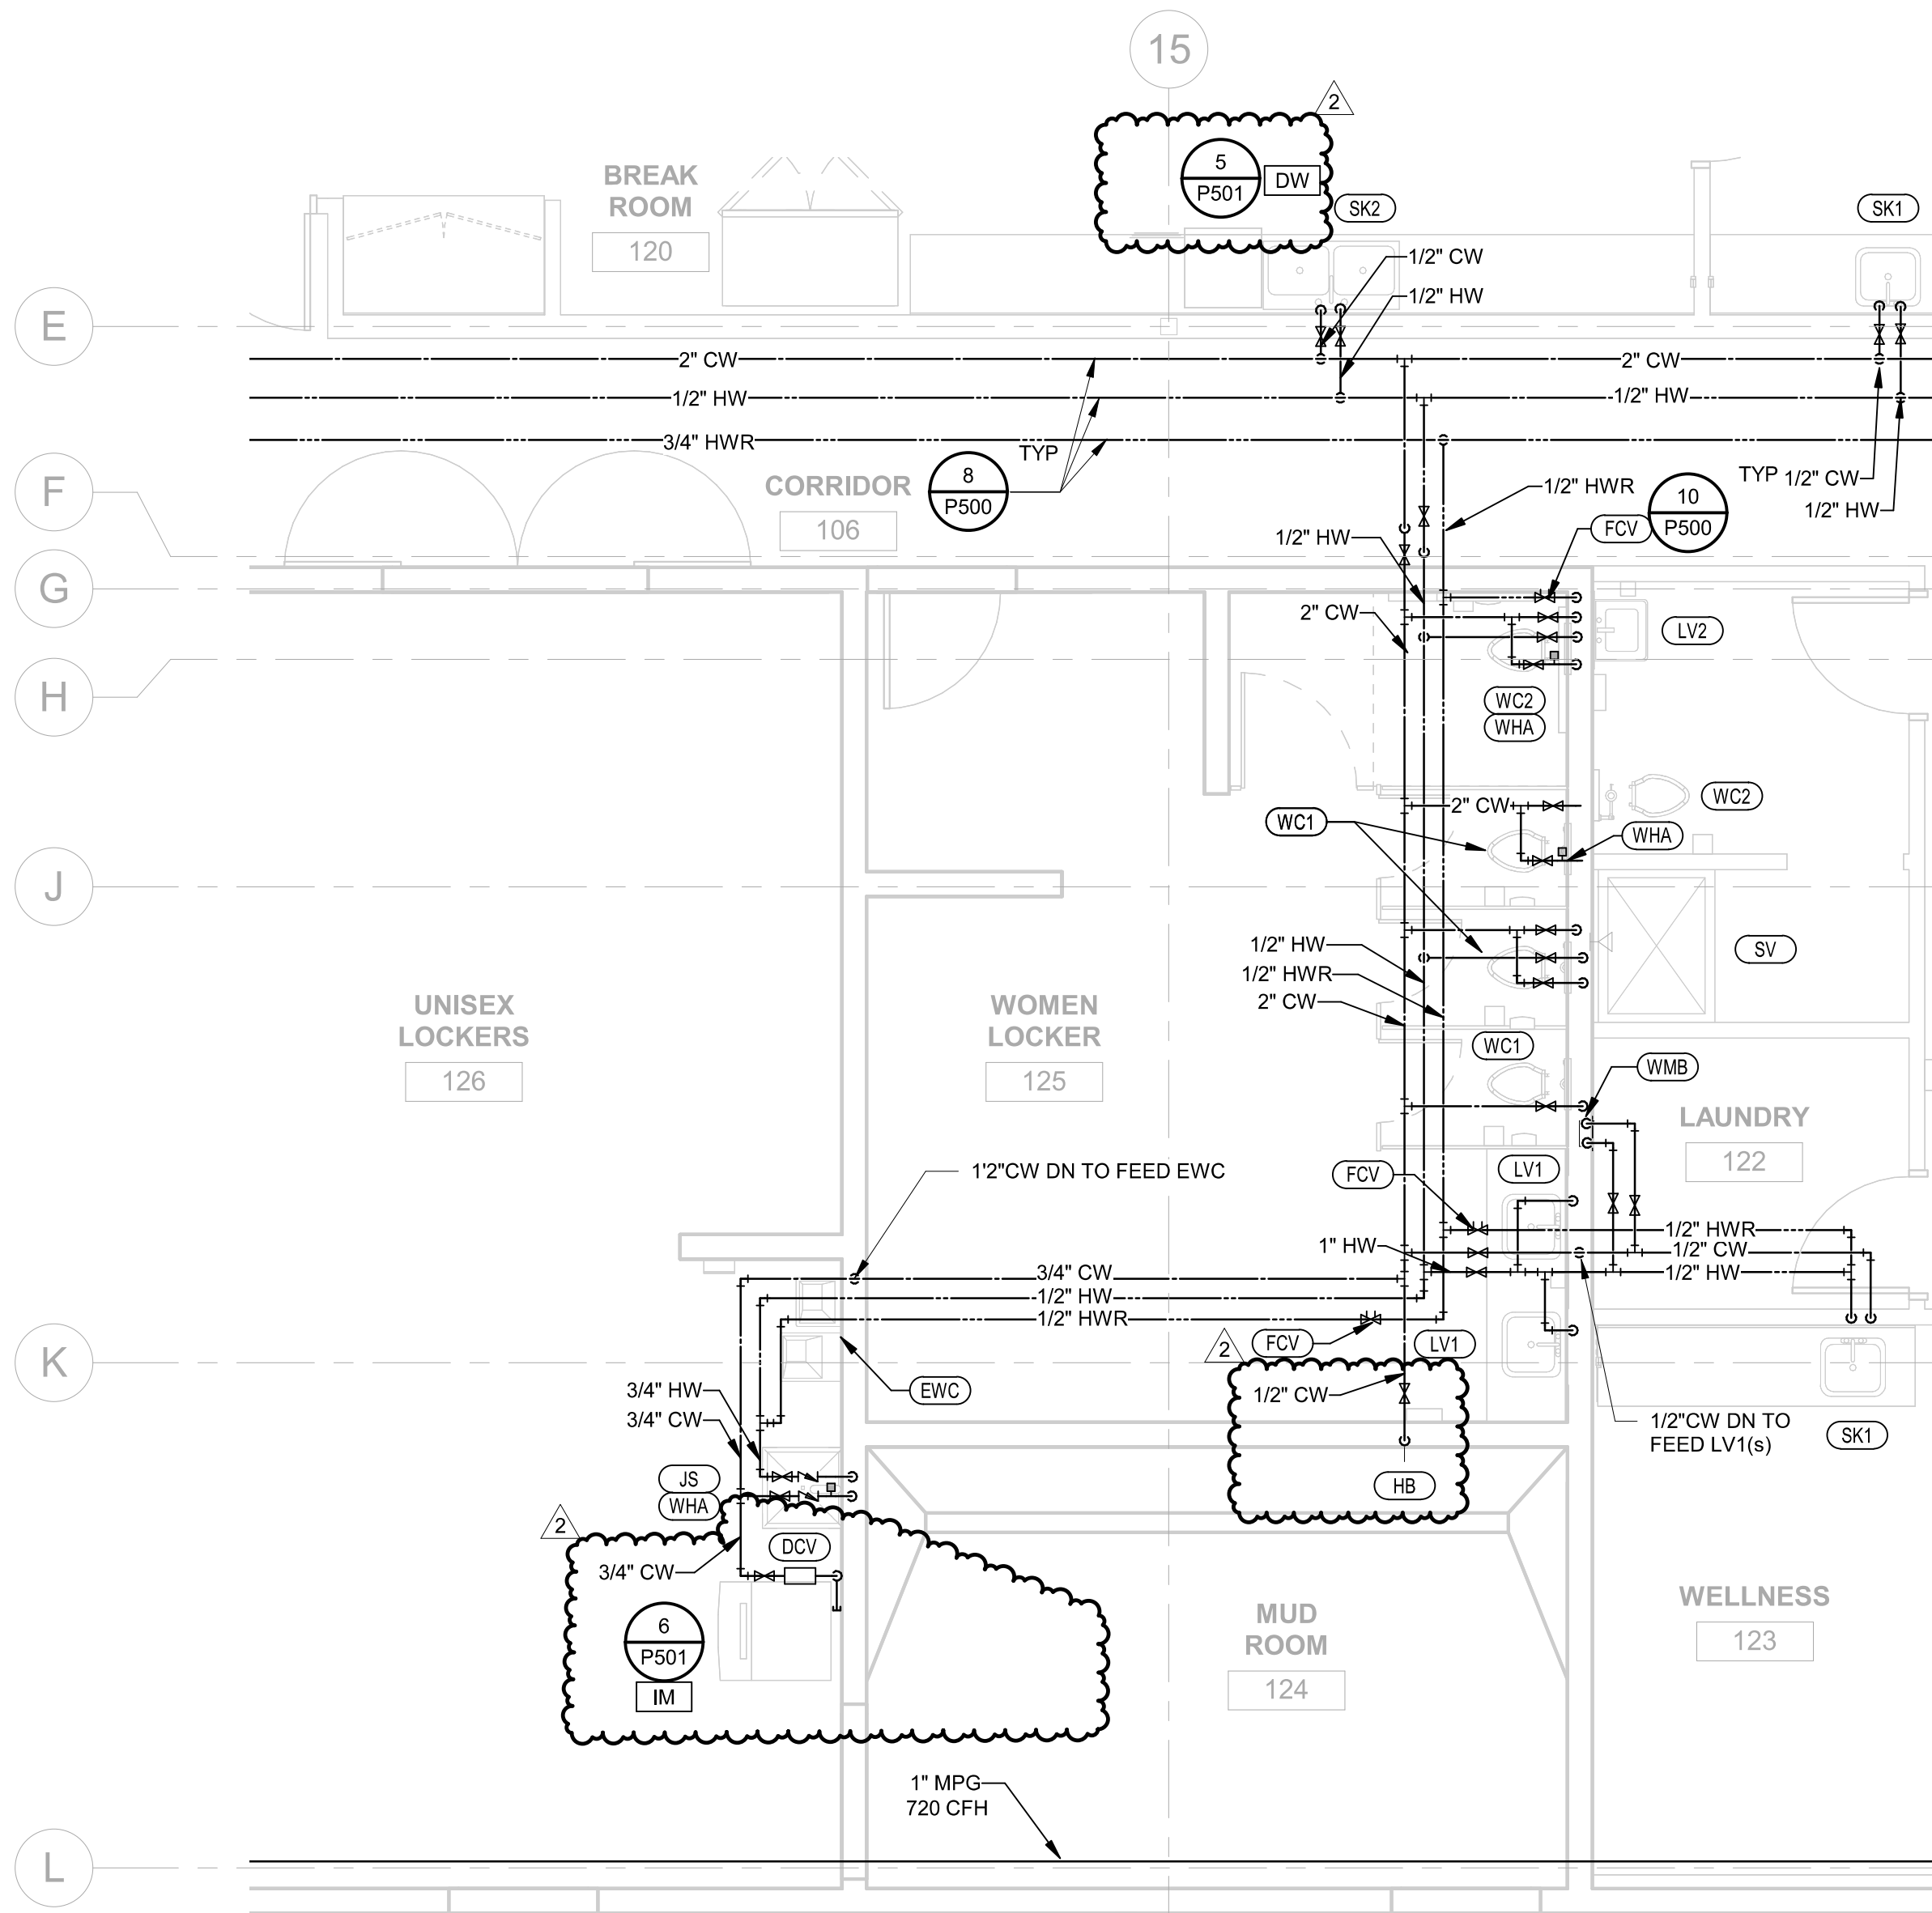


2 PLUMBING LEVEL 1 WATER AND GAS ENLARGED PLAN  
1/4" = 1'-0"

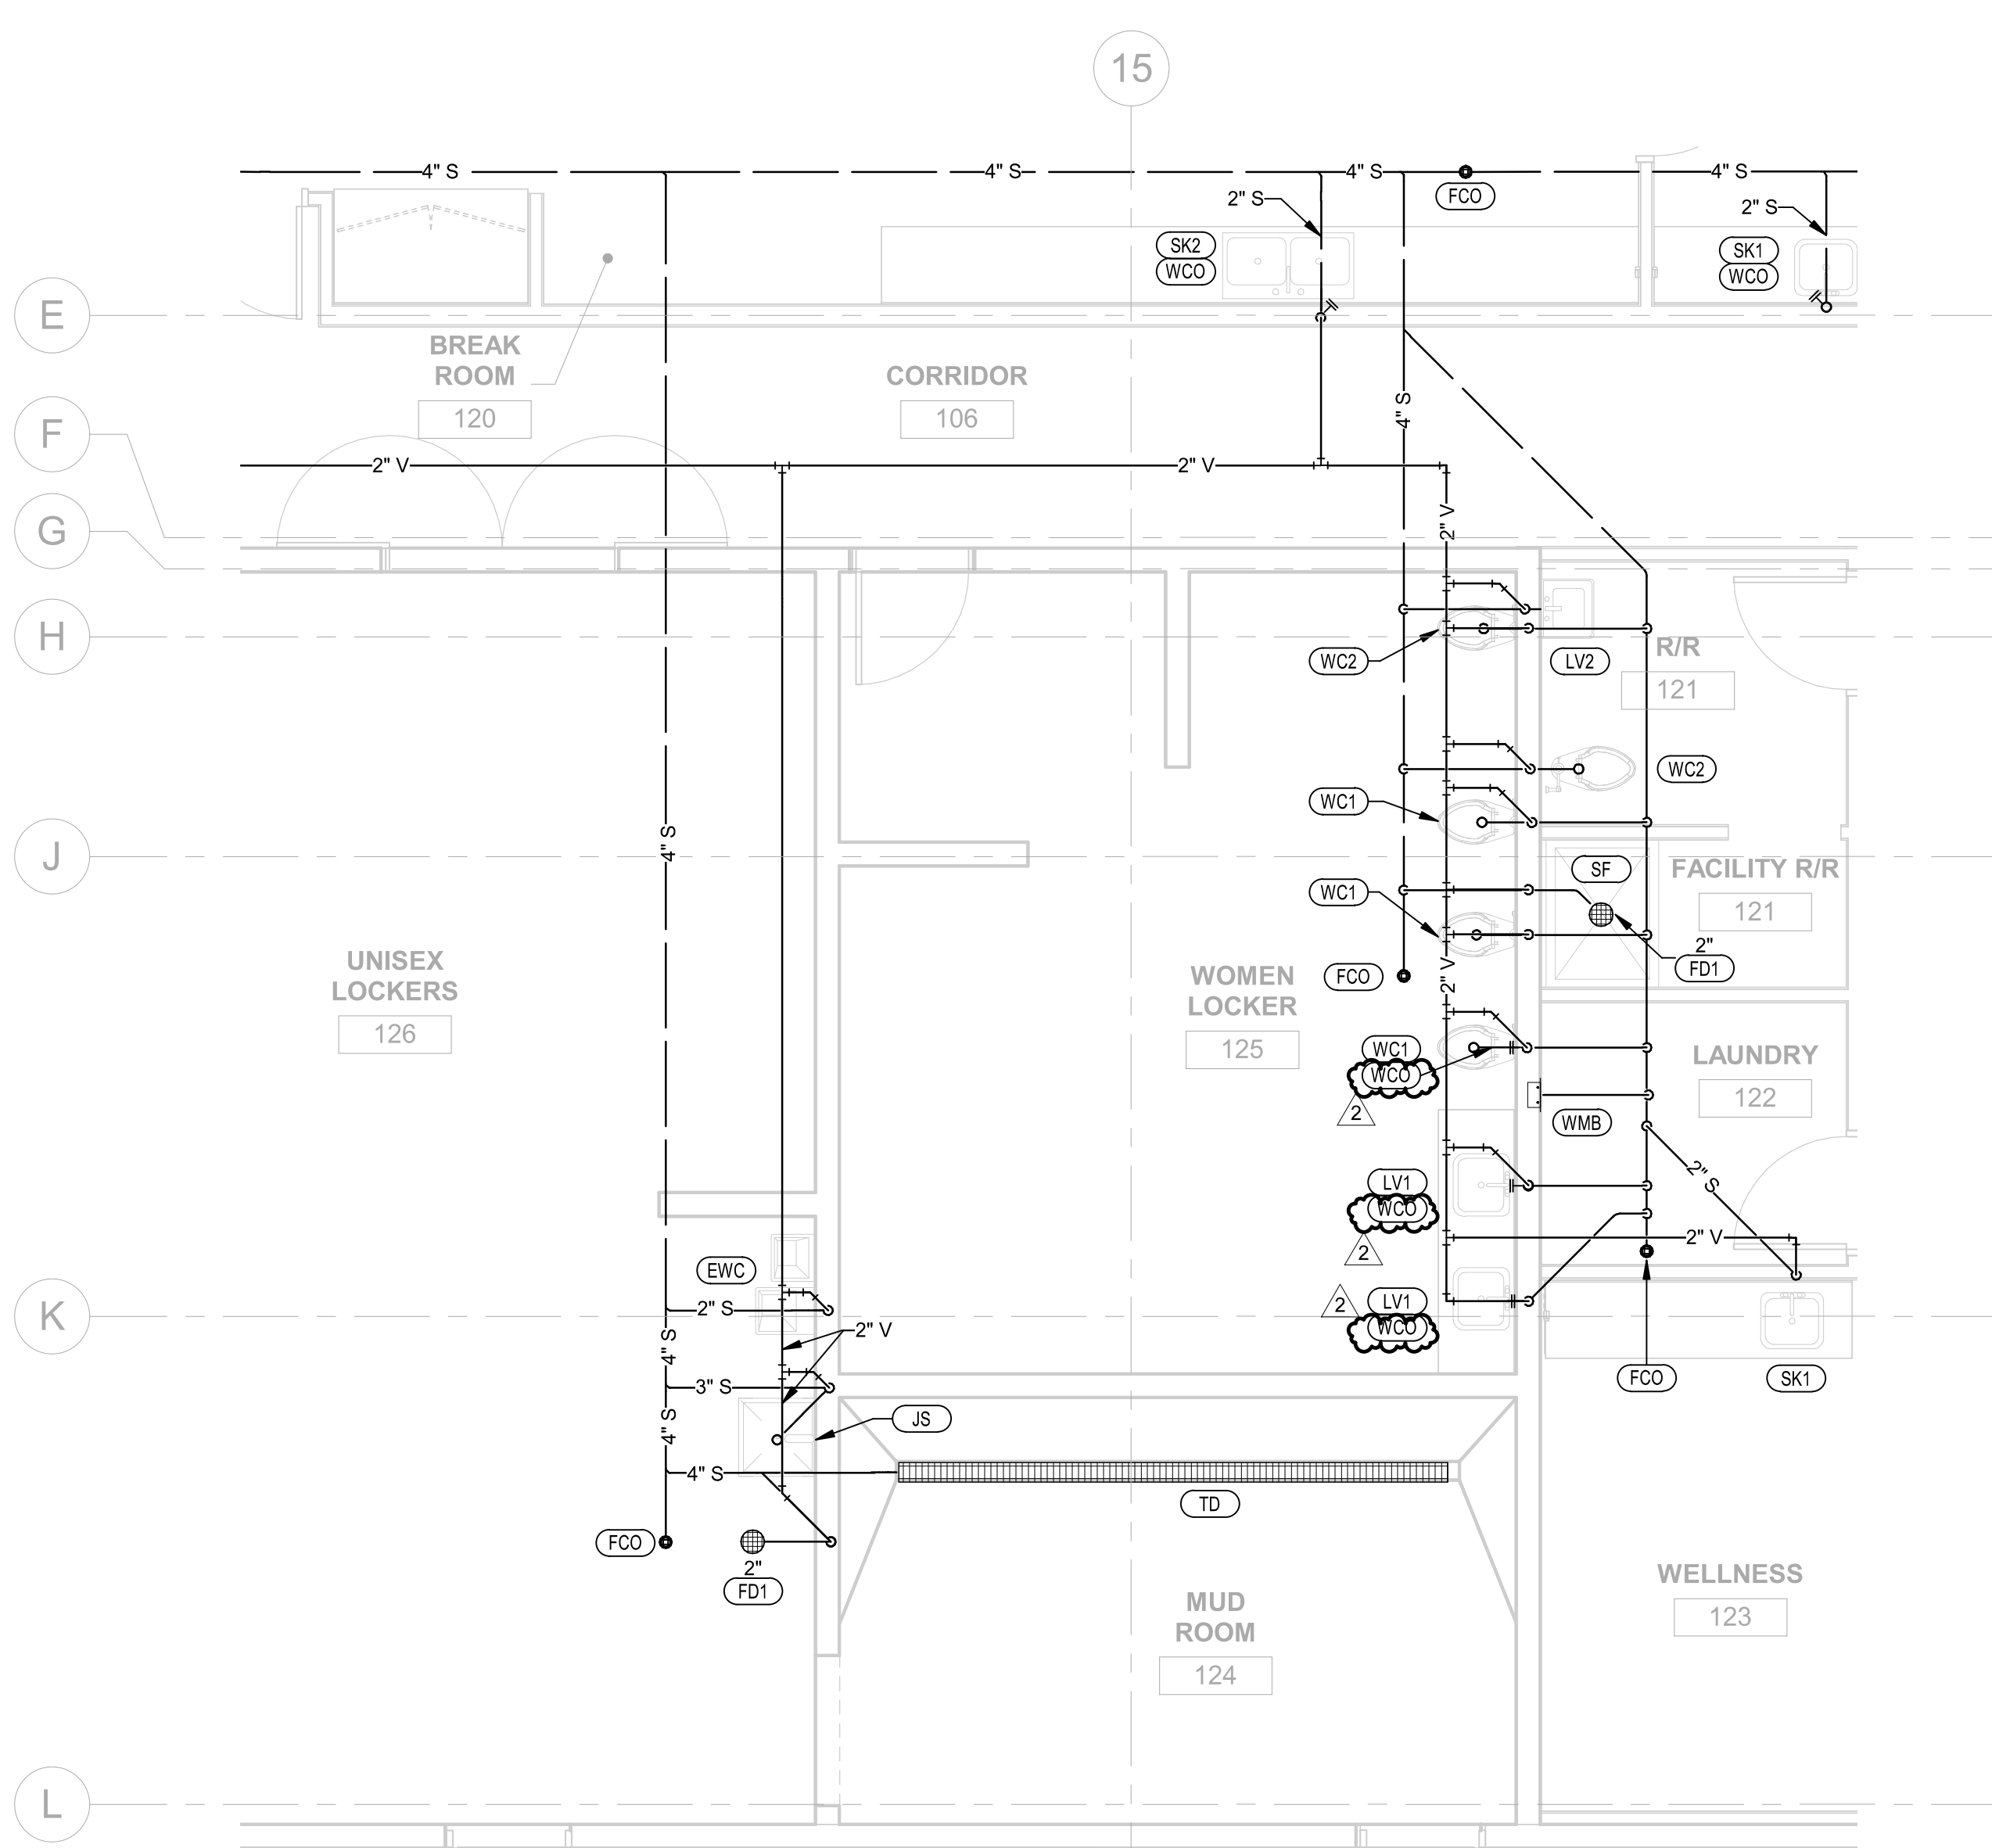


1 PLUMBING LEVEL 1 WASTE AND VENT ENLARGED PLAN  
1/4" = 1'-0"




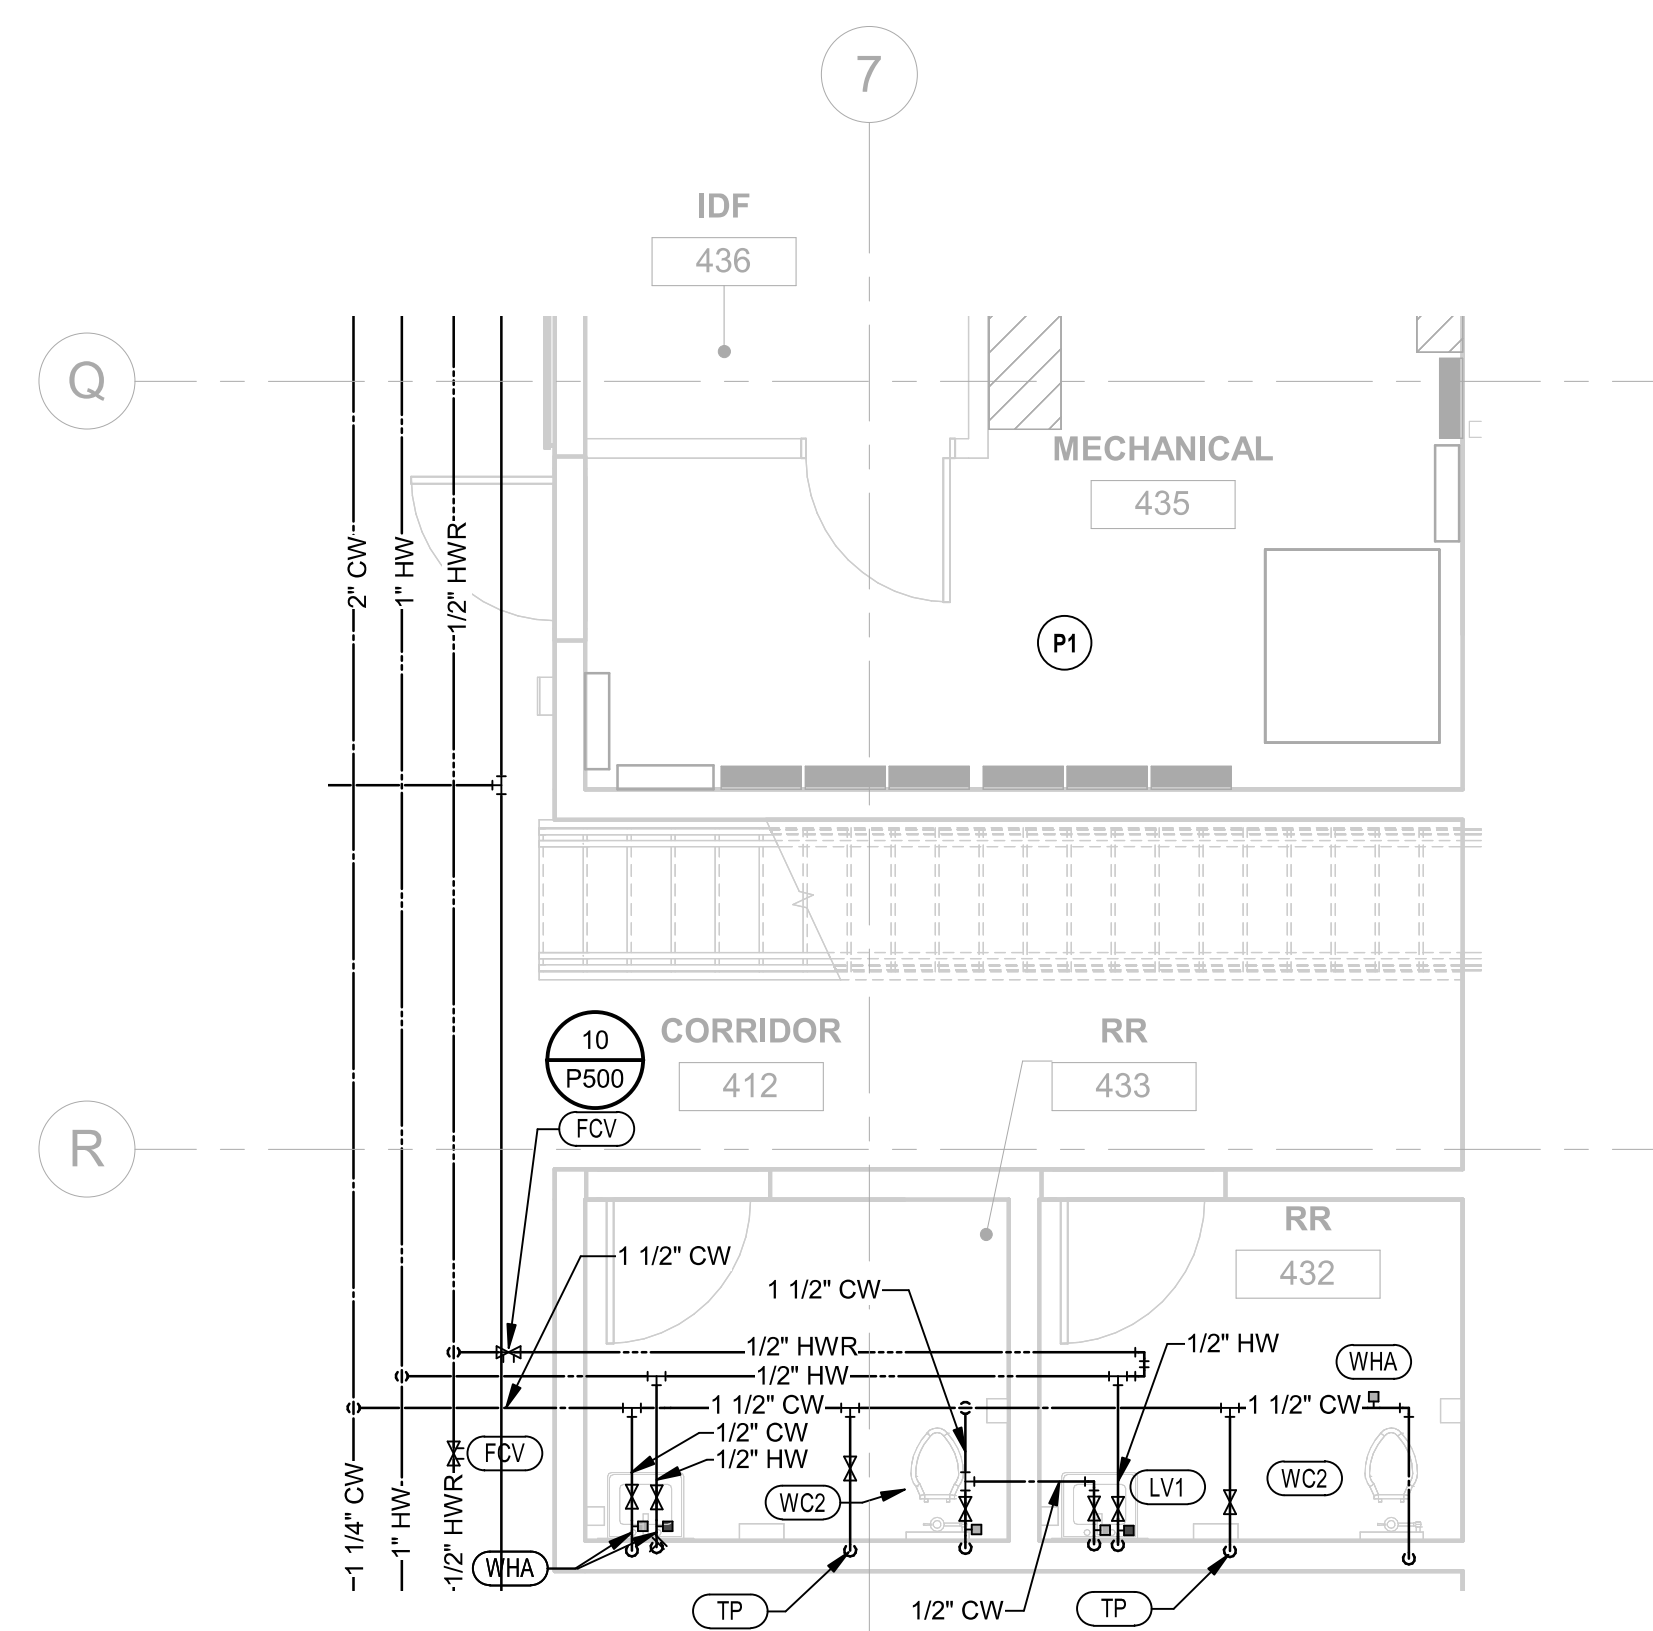


④ PLUMBING LEVEL 1 WATER AND GAS ENLARGED PLAN  
1/4" = 1'-0"

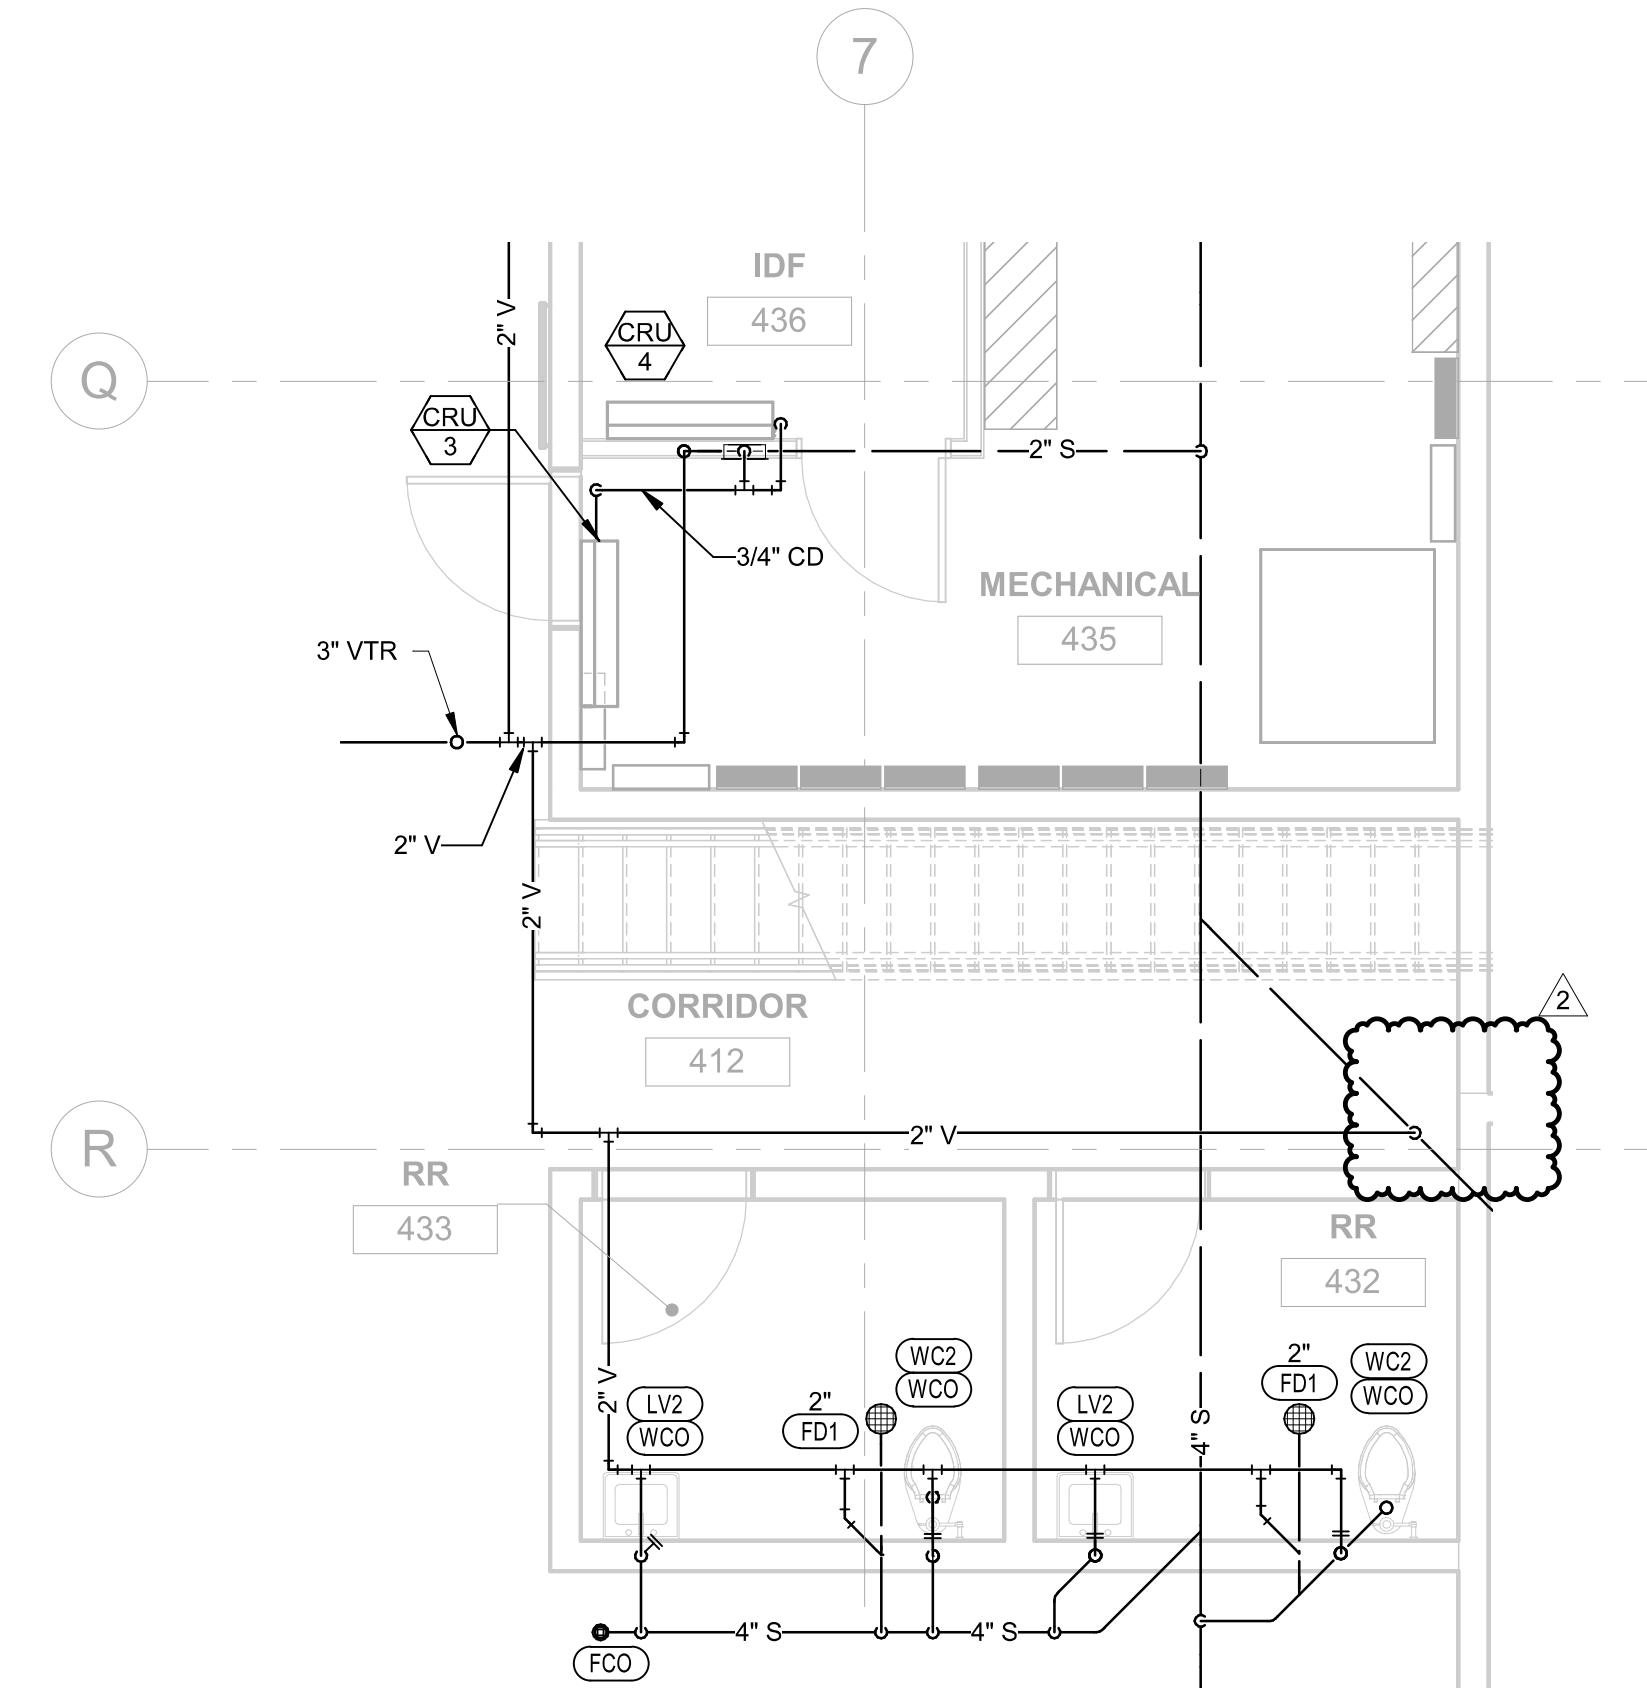

③ PLUMBING LEVEL 1 WASTE AND VENT ENLARGED PLAN  
1/4" = 1'-0"

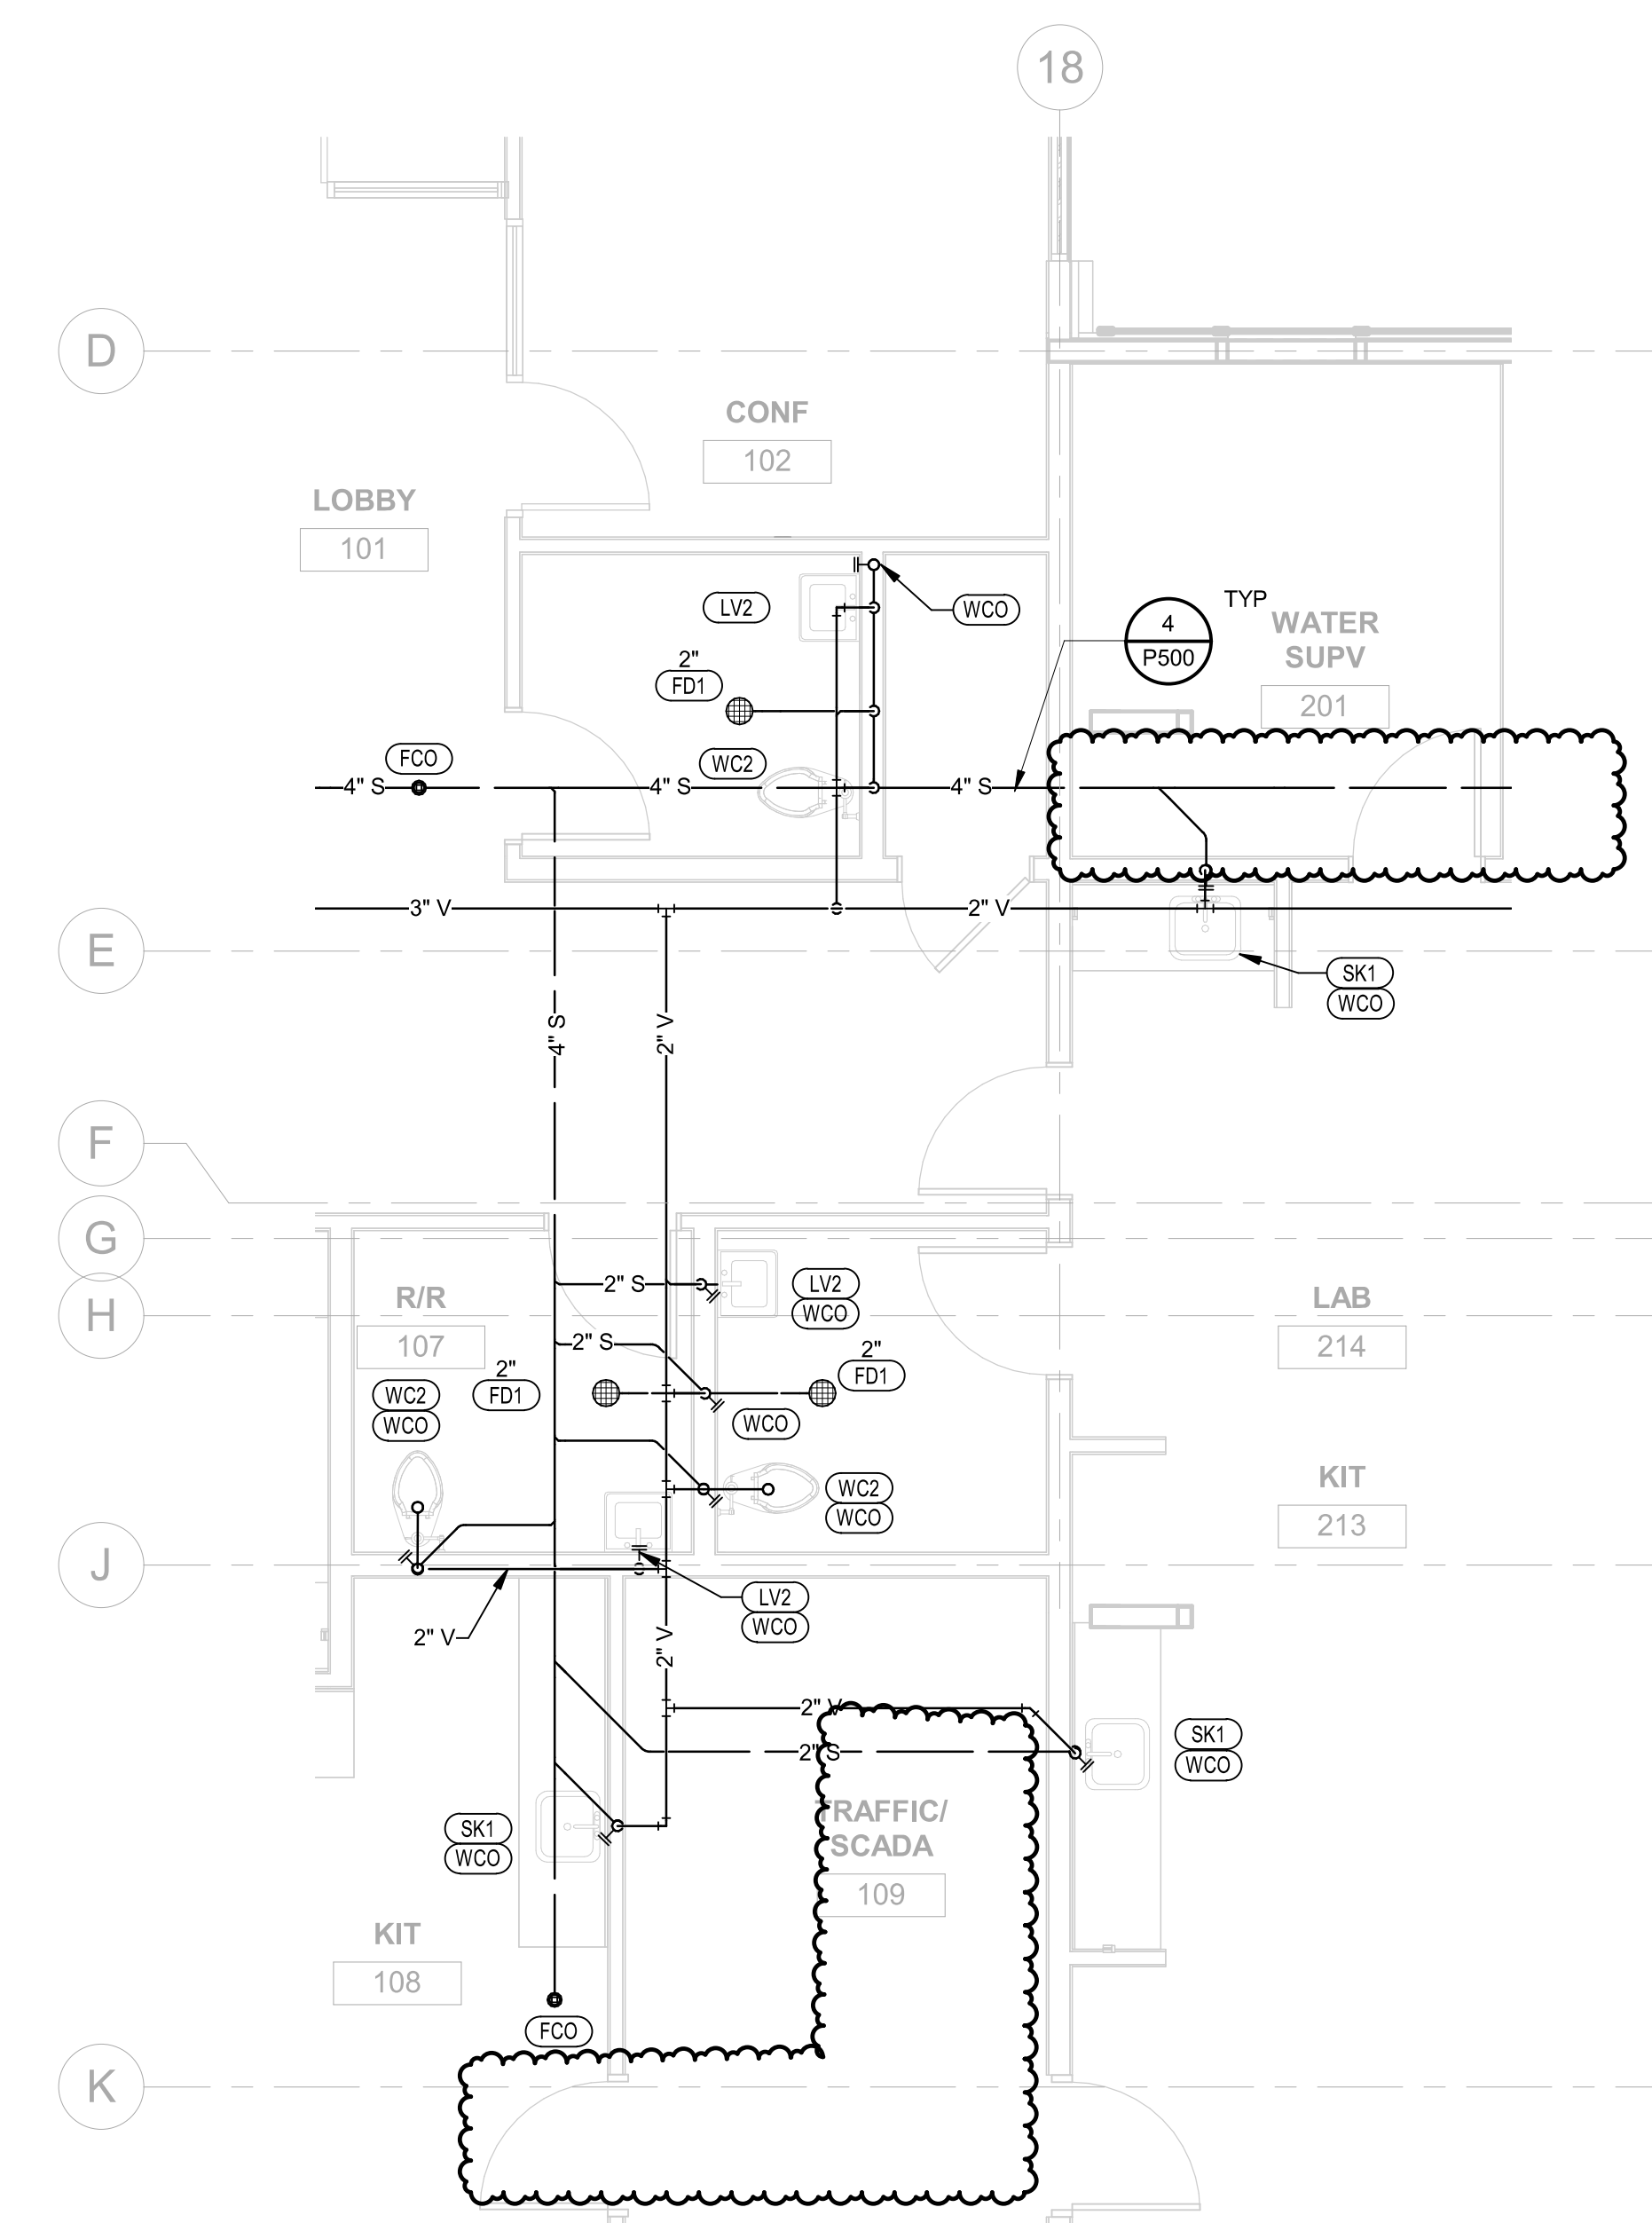


② PLUMBING LEVEL 1 WASTE AND VENT ENLARGED PLAN  
1/4" = 1'-0"

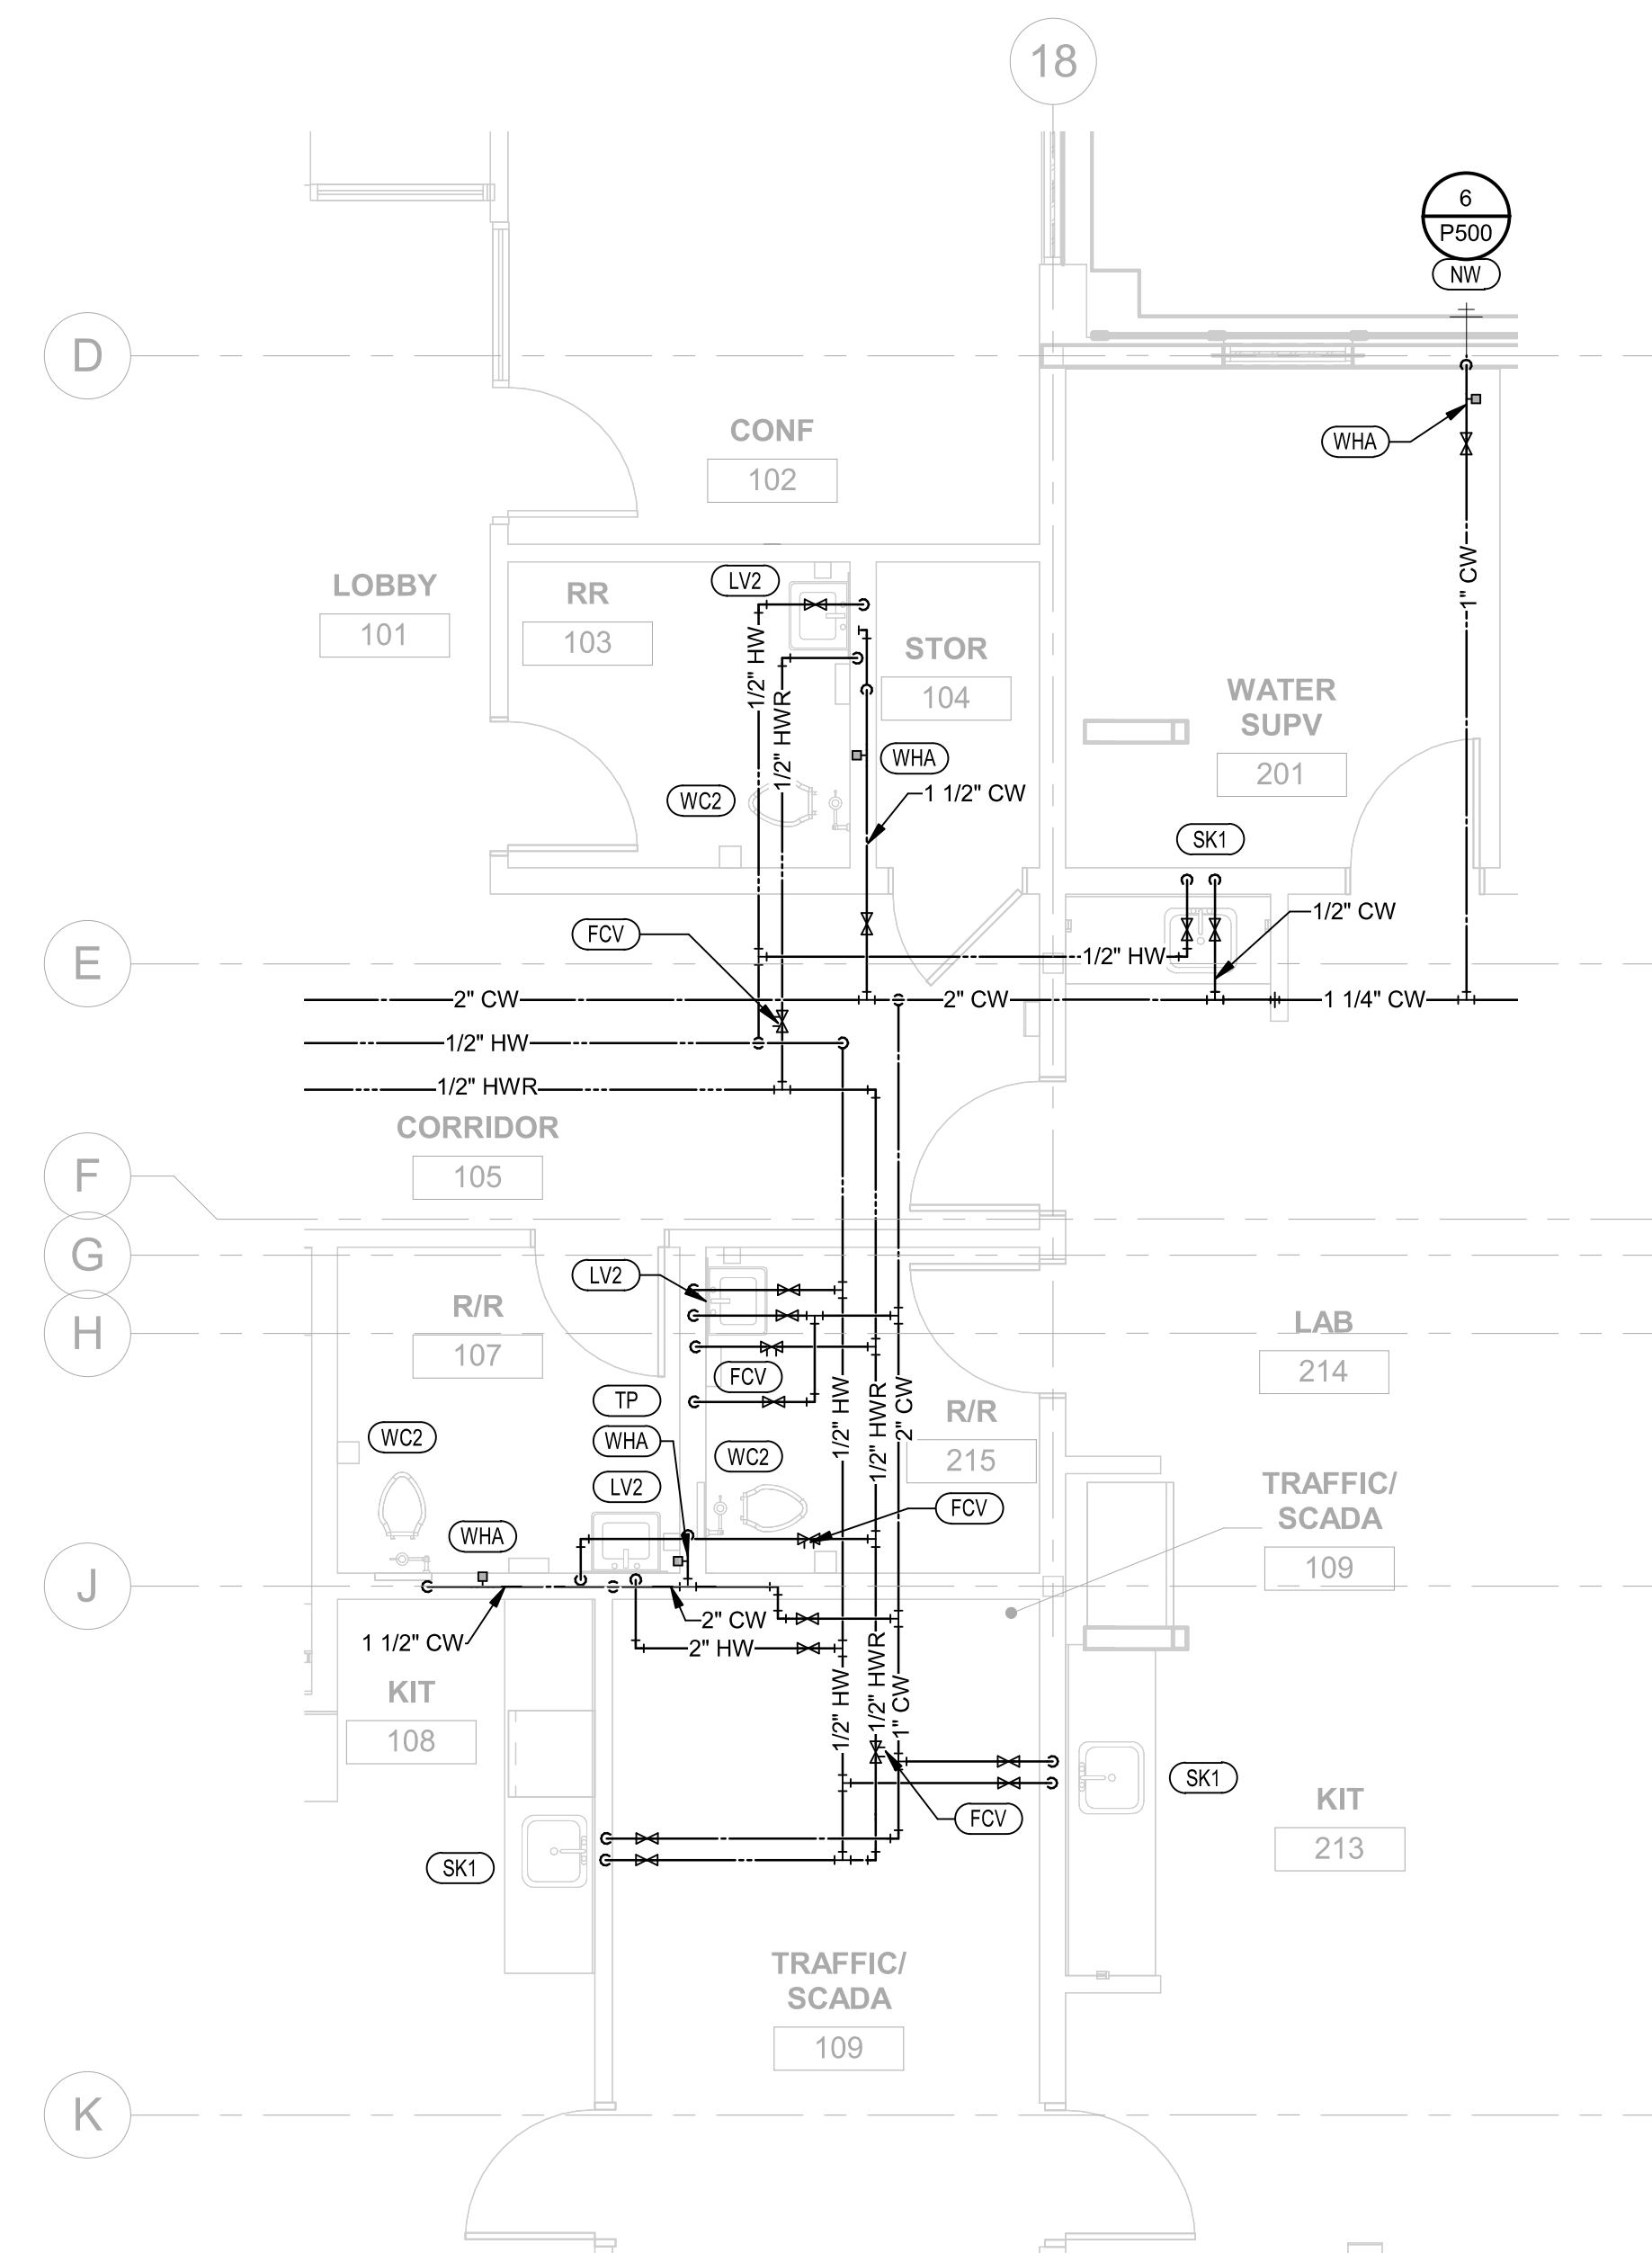

① PLUMBING LEVEL 1 WATER AND GAS ENLARGED PLAN  
1/4" = 1'-0"

**PLUMBING PLAN NOTES:**

P1 DO NOT INSTALL PLUMBING PIPING OVER ELECTRICAL PANELS OR EQUIPMENT.

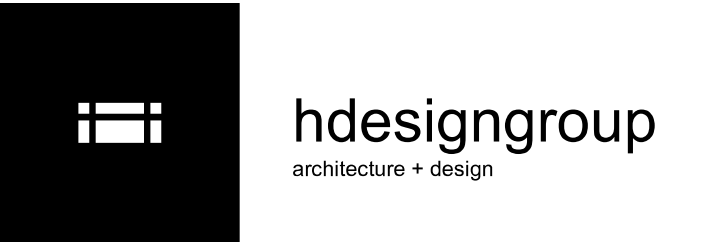

5039 S National Avenue | Springfield, MO 65810 | 417.887.6595

**OWNER**  
CITY OF WENTZVILLE, MISSOURI  
1001 SCHROEDER CREEK BLVD  
WENTZVILLE, MO 63385  
636.327.5101

## PROJECT TEAM

CIVIL ENGINEER  
PREMIER DESIGN GROUP  
100 MIDLAND PARK DRIVE  
WENTZVILLE, MO 63385  
314.925.7444

MAINTENANCE CONSULTANT  
HDR ENGINEERING, INC.  
17725 KATY FREEWAY SUITE 102  
HOUSTON, TX 77094  
816.360.2700

STRUCTURAL ENGINEER  
METTEMAYER ENGINEERING  
2225 W CHESTERFIELD BLVD., SUITE 300  
SPRINGFIELD, MO 65807  
417.890.8002

MEP ENGINEER  
HENDERSON ENGINEERS, INC.  
8345 LENEXA DR., #300  
LENEXA, KS 66214  
913.742.5000



## REVISIONS

[illegible]

PROJECT NO.: 19-040 DRAWN BY: MJ  
DATE: 12.15.22 REVIEWED BY: HEI



01/24/2023

CARL J. HOLDEN  
LICENSE # PE-2020016283


**PROJECT TITLE**  
**CITY OF WENTZVILLE, MO PUBLIC**  
**WORKS FACILITY**

PROJECT ADDRESS:  
1295 INTERSTATE DRIVE  
WENTZVILLE, MO 63385


## PLUMBING ENLARGED PLANS

SHEET  
P402


CARL J. HOLDEN

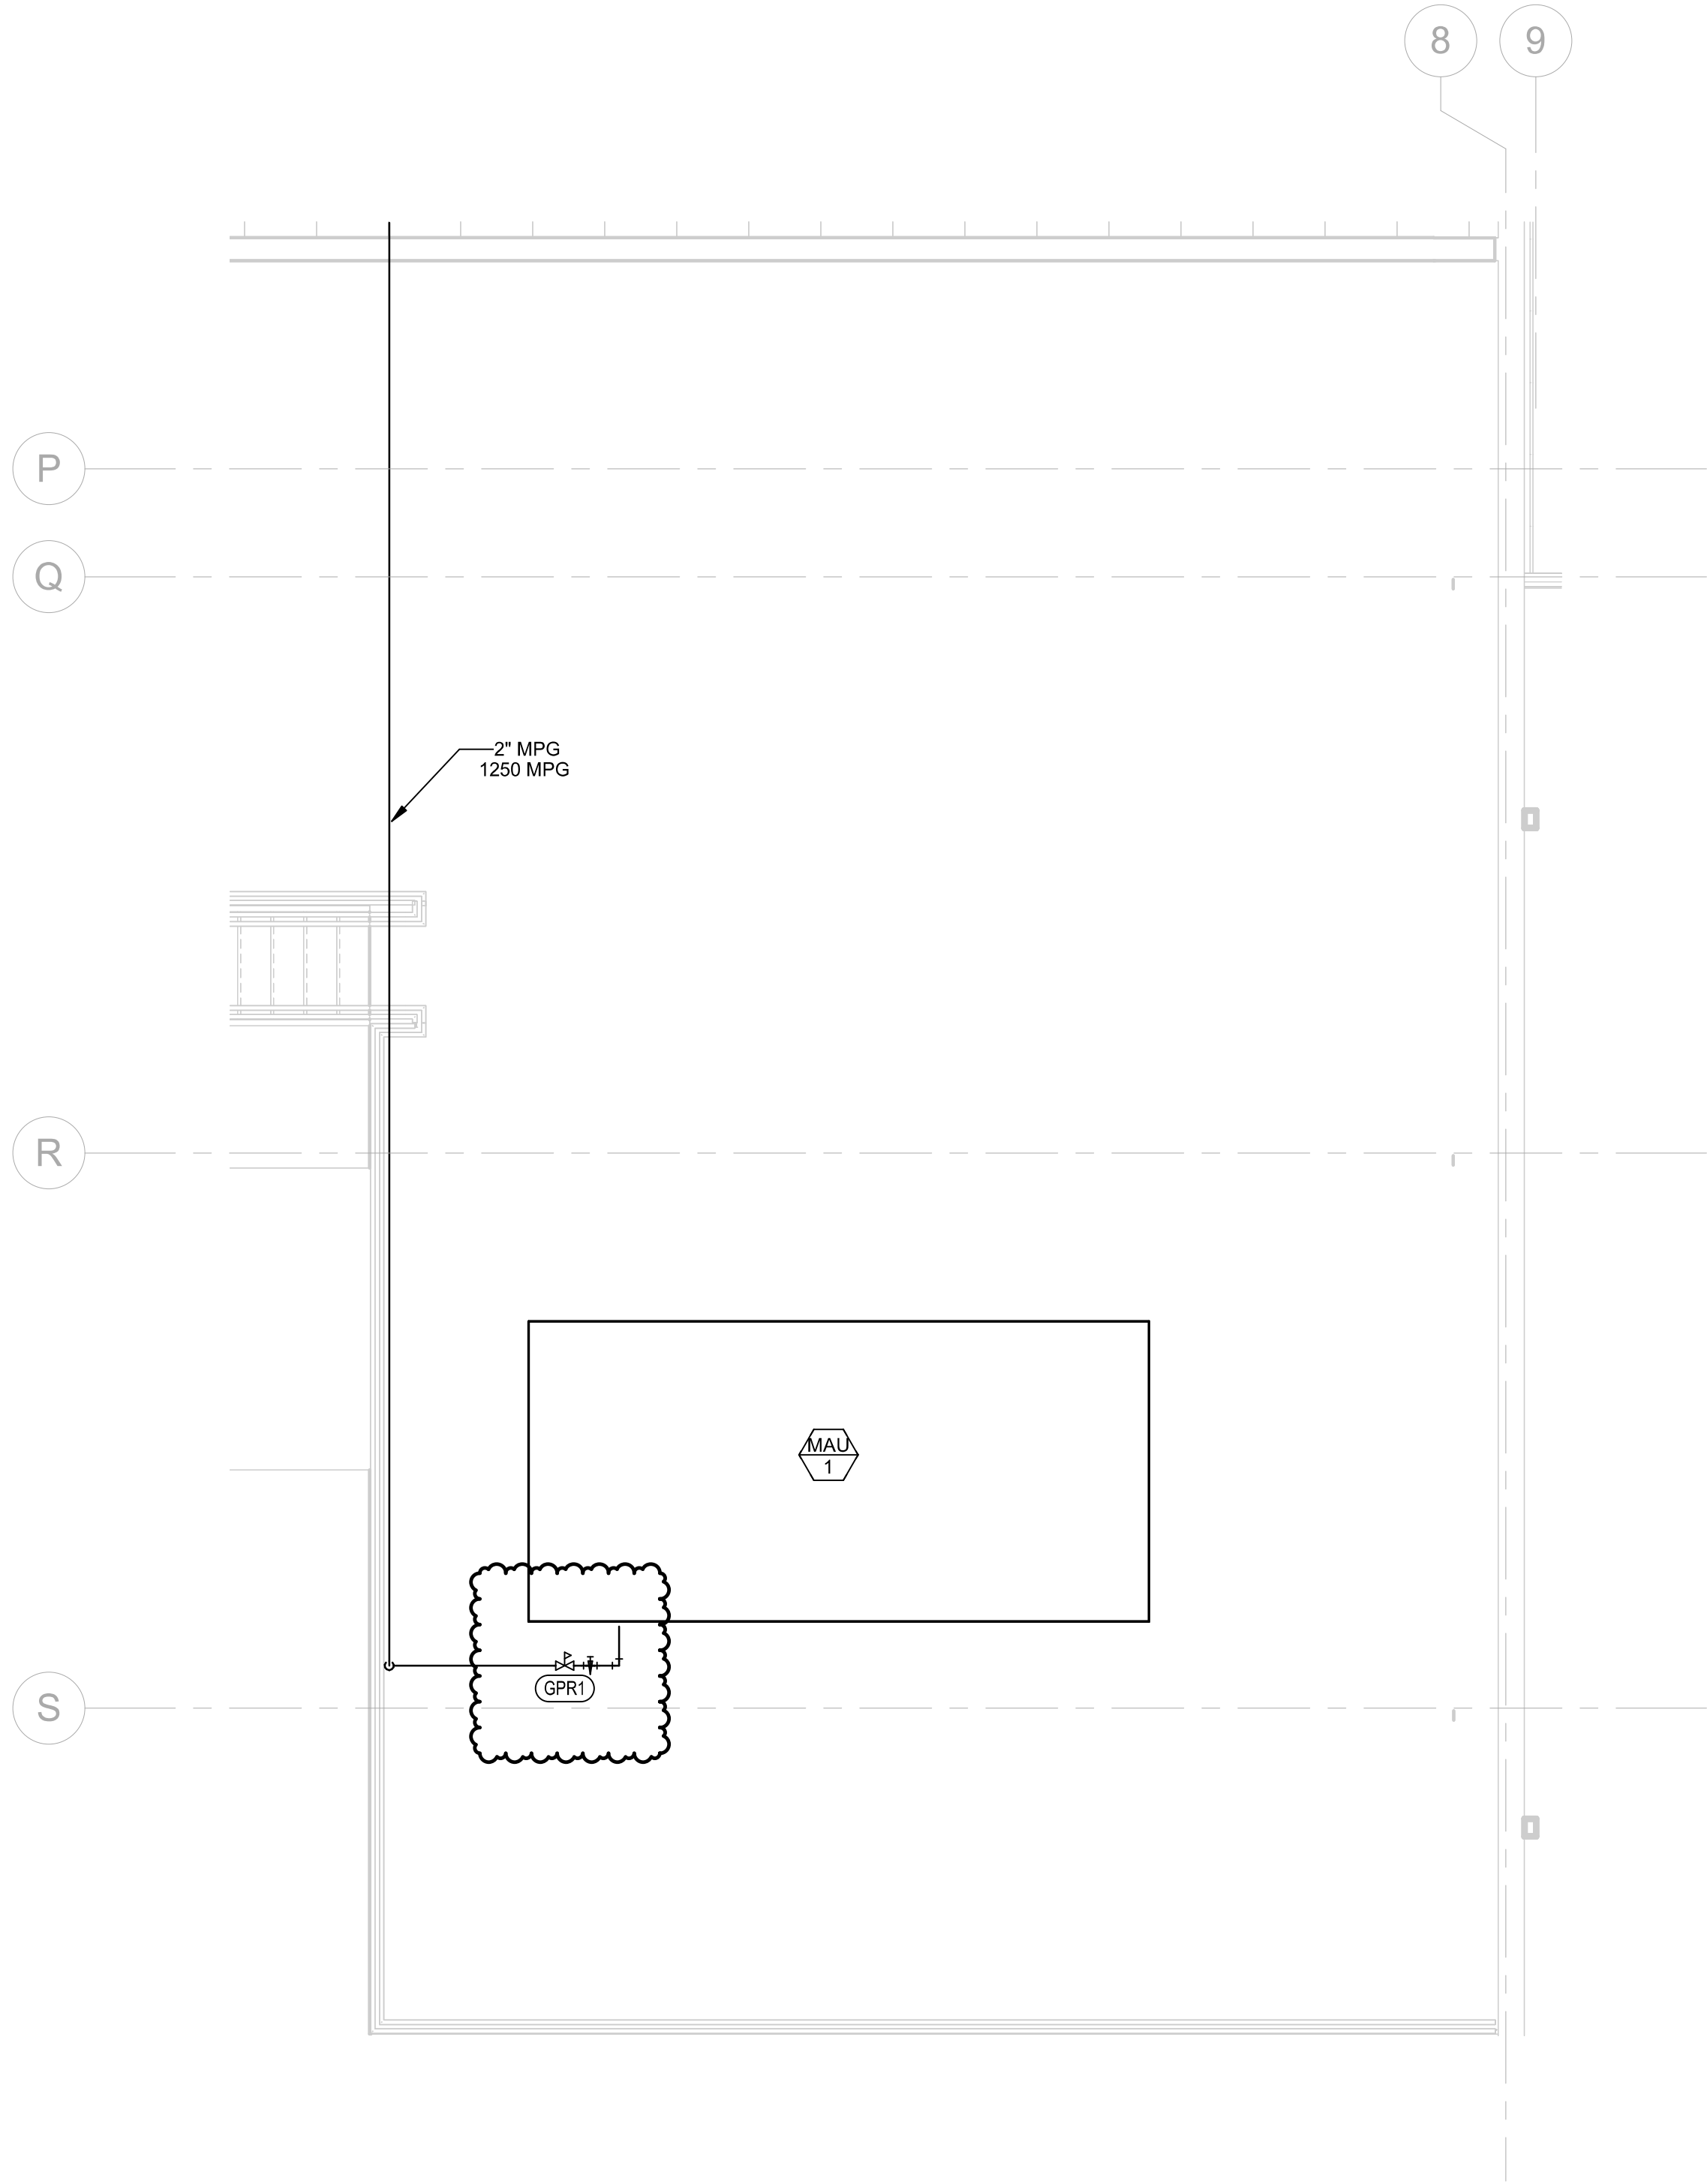


② PLUMBING MEZZANINE WATER AND GAS PLAN  
1/4" = 1'-0"

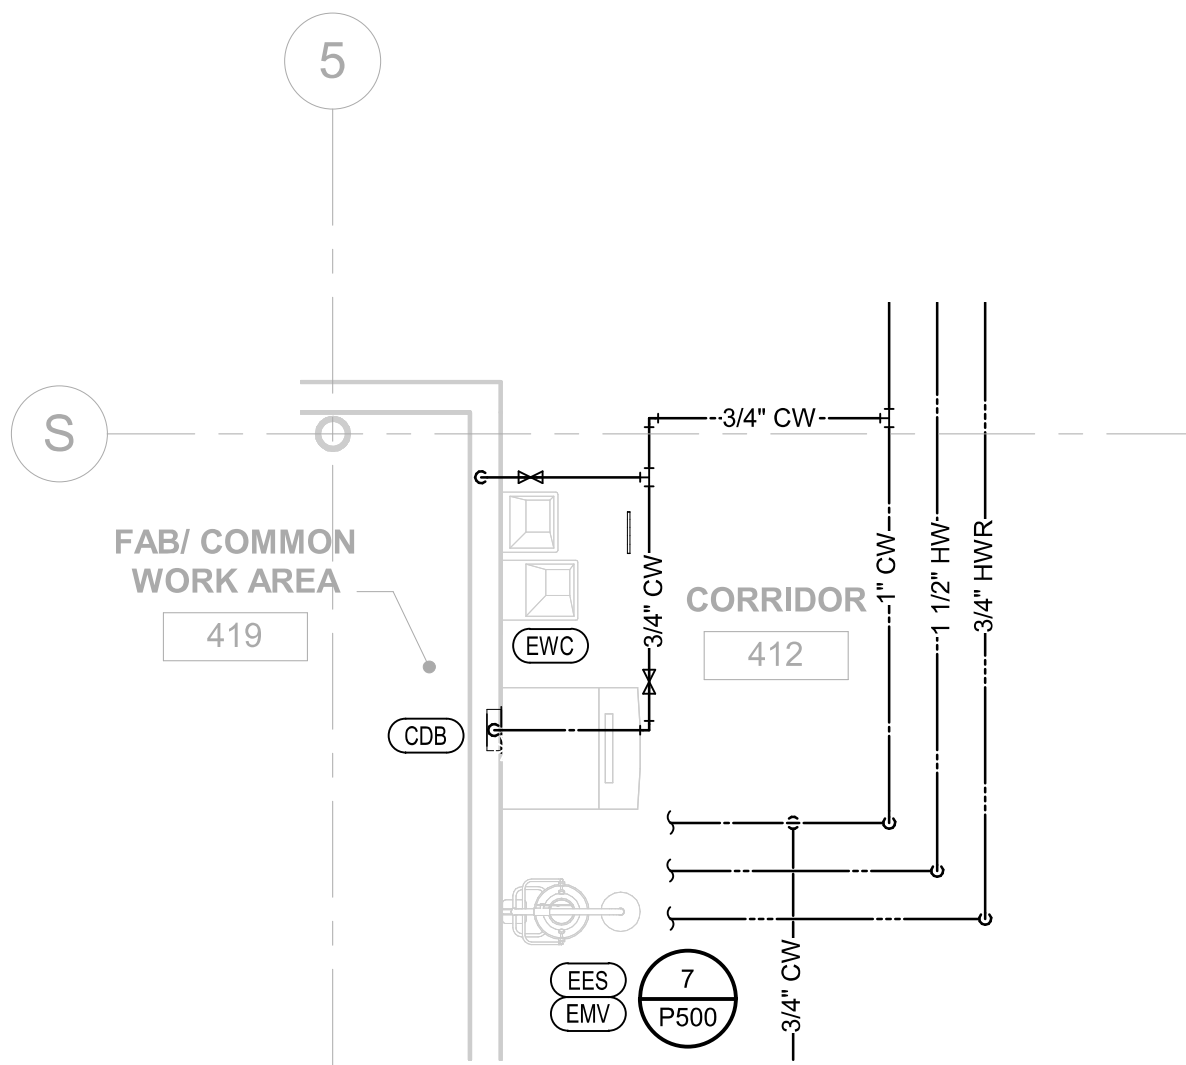

④ PLUMBING LEVEL 1 WASTE AND VENT ENLARGED PLAN  
1/4" = 1'-0"

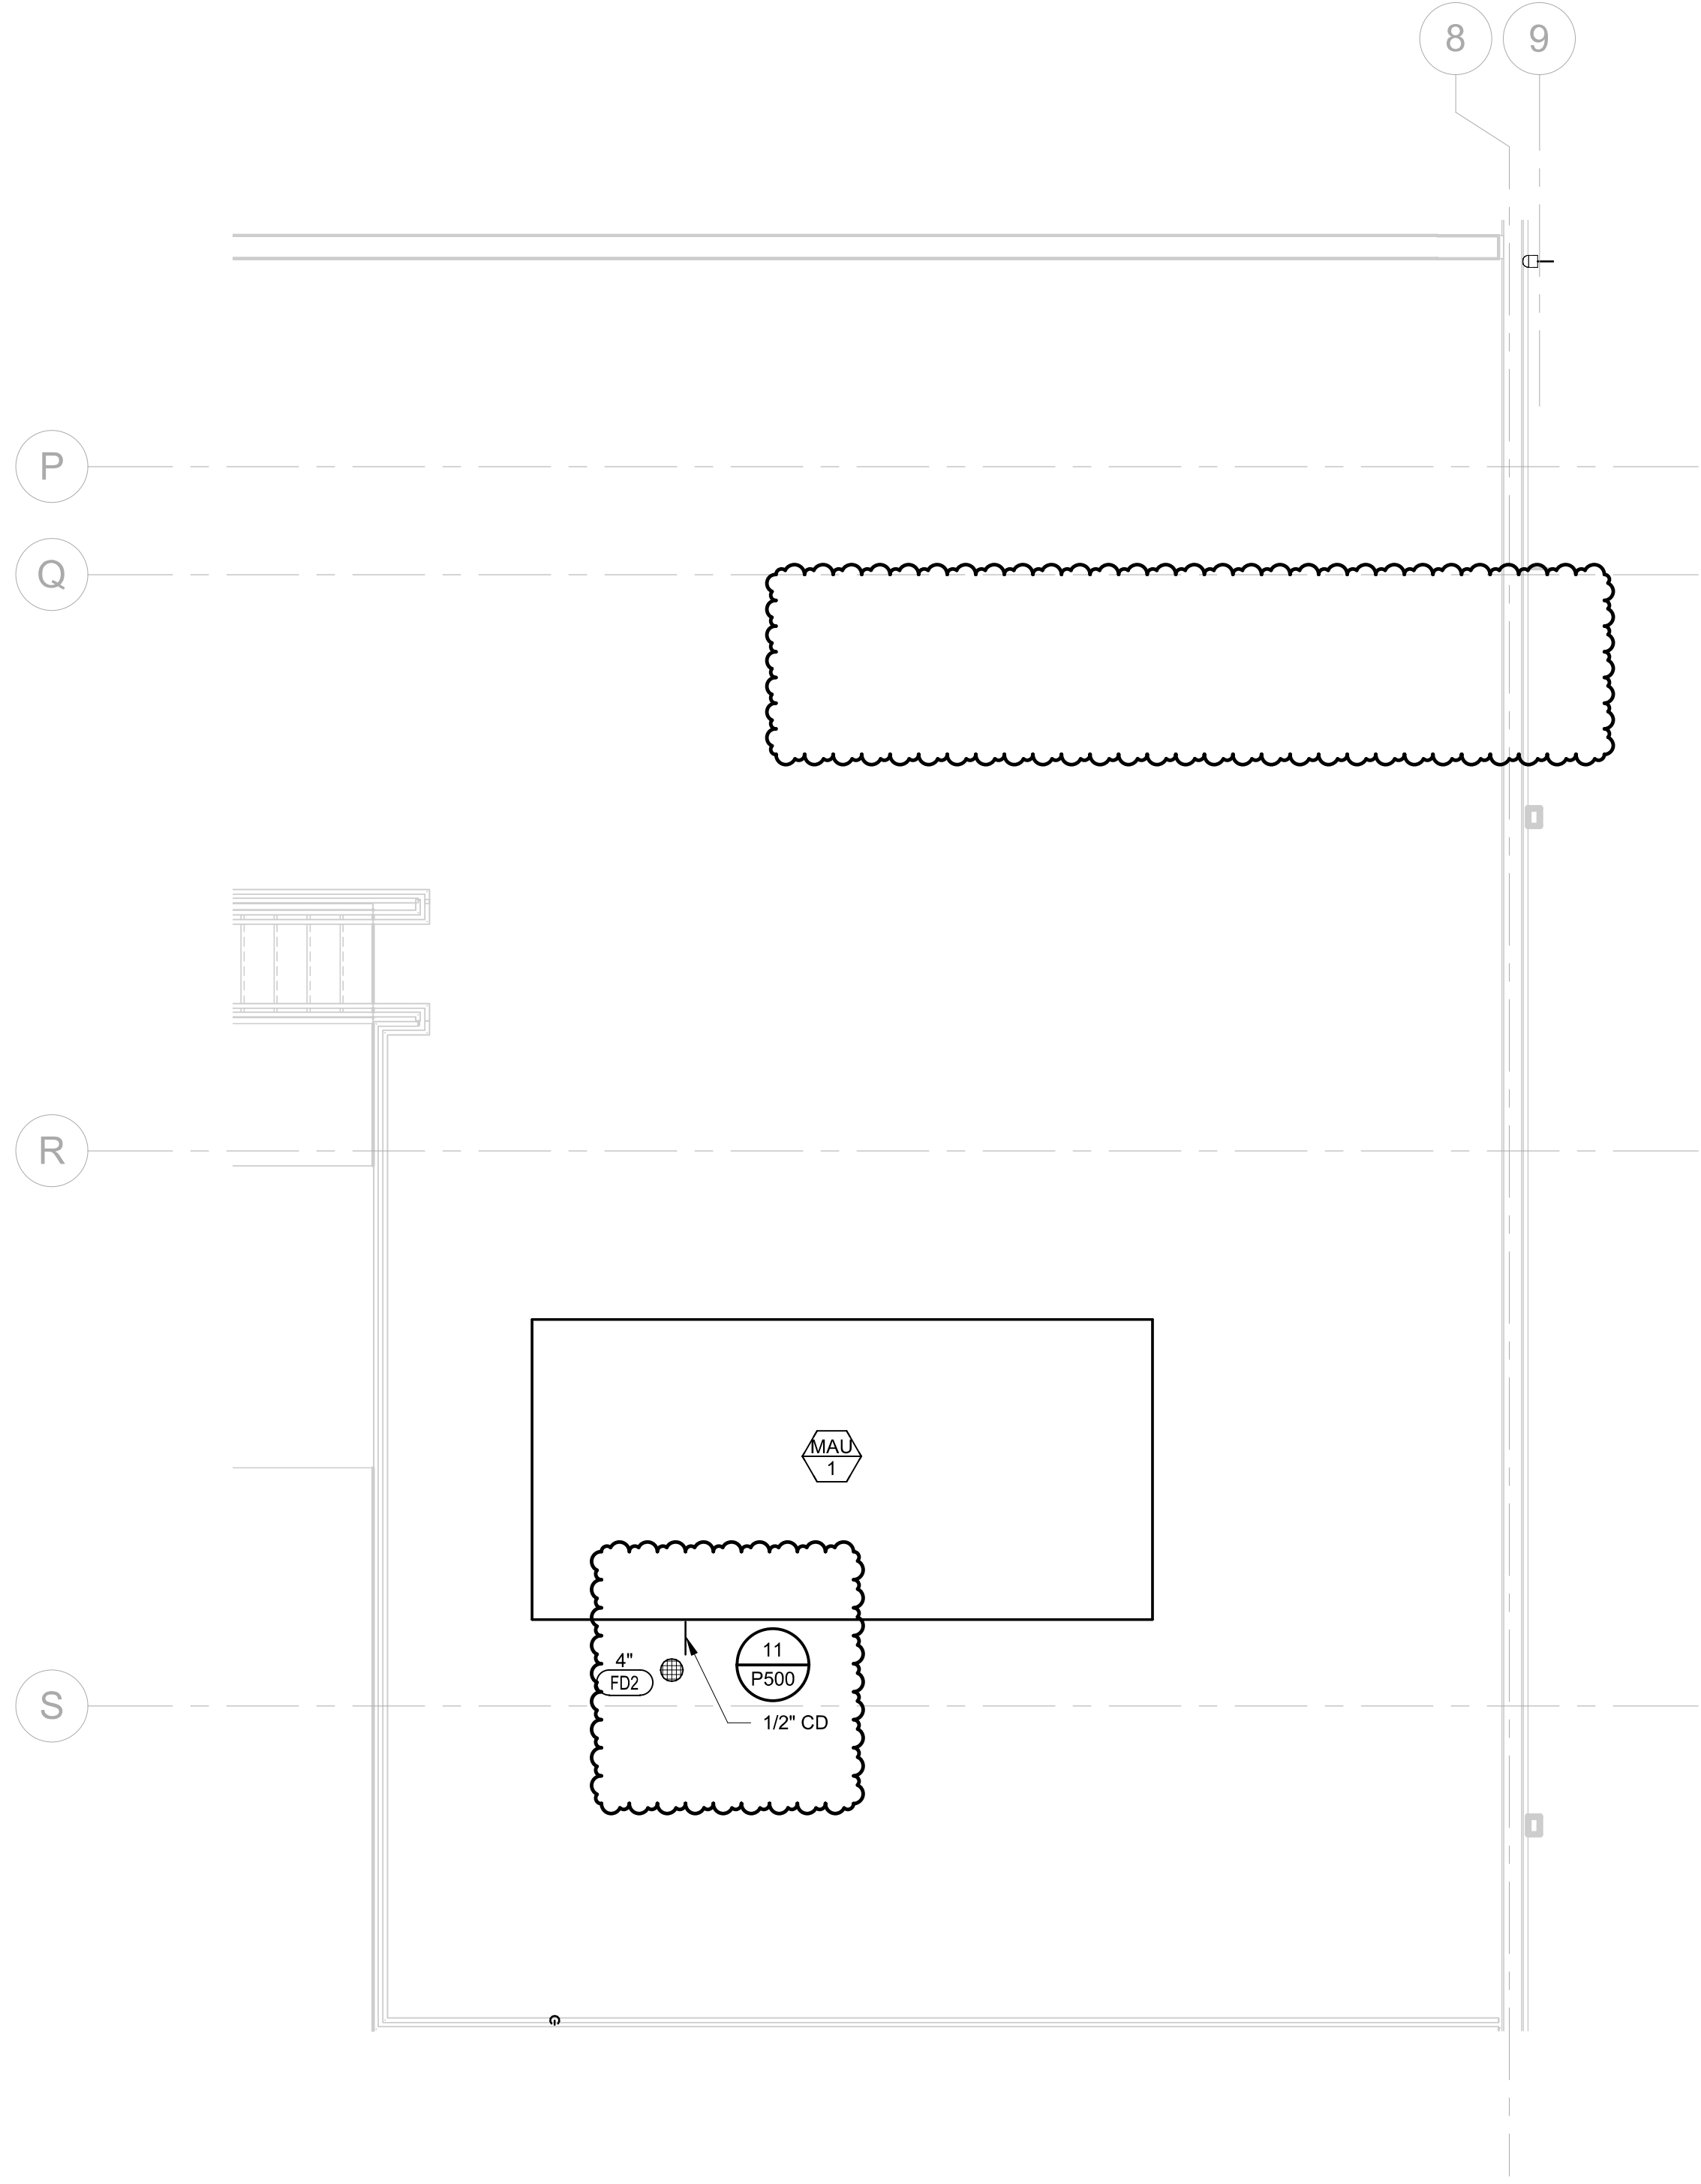

① PLUMBING MEZZANINE WASTE AND VENT ENLARGED PLAN  
1/4" = 1'-0"

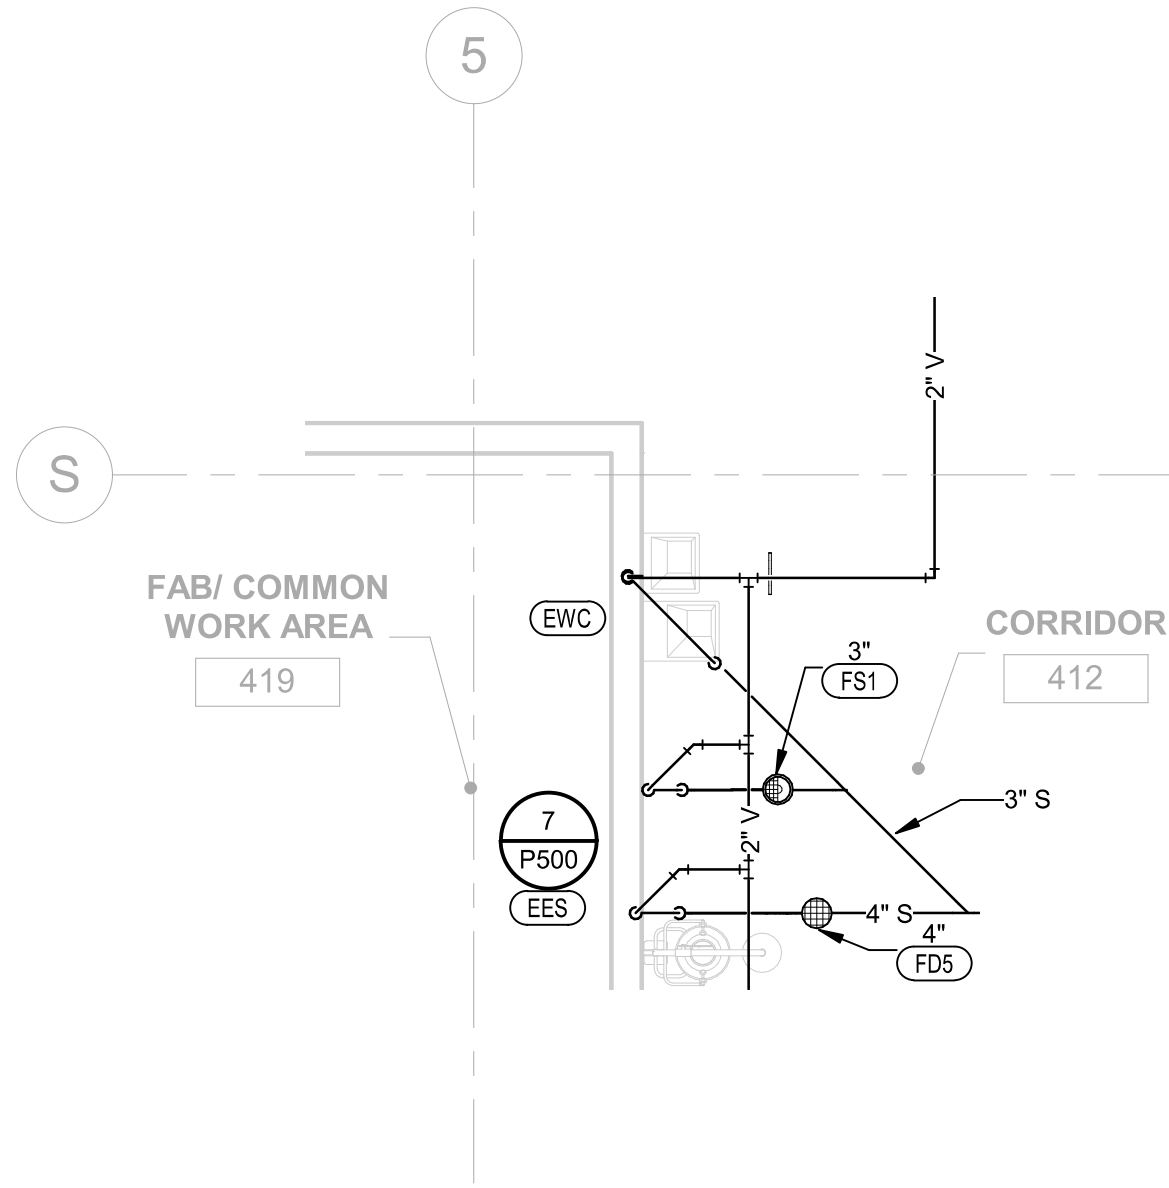

③ PLUMBING LEVEL 1 WATER AND GAS ENLARGED PLAN  
1/4" = 1'-0"




KEY PLAN



5039 S National Avenue | Springfield, MO 65810 | 417.887.6595

**OWNER**  
CITY OF WENTZVILLE, MISSOURI  
1001 SCHROEDER CREEK BLVD  
WENTZVILLE, MO 63385  
636.327.5101


**PROJECT TEAM**  
**CIVIL ENGINEER**  
PREMIER DESIGN GROUP  
100 MIDLAND PARK DRIVE  
WENTZVILLE, MO 63385  
314.925.7444  
**MAINTENANCE CONSULTANT**  
HDR ENGINEERING, INC.  
17725 KATY FREEWAY SUITE 102  
HOUSTON, TX 77054  
816.360.2700  
**STRUCTURAL ENGINEER**  
METTEMAYER ENGINEERING  
2225 W CHESTERFIELD BLVD., SUITE 300  
SPRINGFIELD, MO 65807  
417.890.8002  
**MEP ENGINEER**  
HENDERSON ENGINEERS, INC.  
8345 LENEXA DR., #300  
LENEXA, KS 66214  
913.742.5000  
.  
.

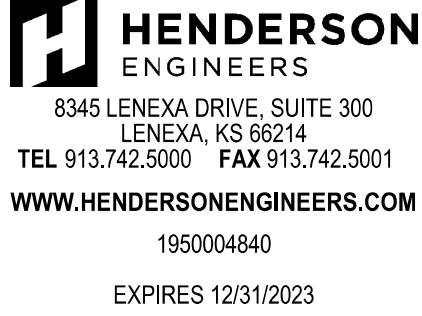

REVISIONS

NO.	DESCRIPTION	DATE
2	ADD 02	01.25.23

PROJECT NO.: 19-040 DRAWN BY: Author  
DATE: 12.15.22 REVIEWED BY: Checker

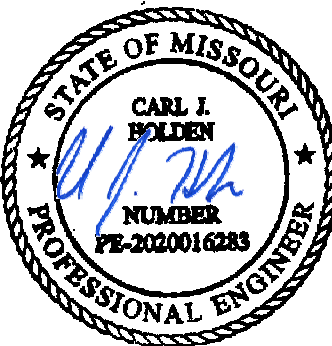

01/24/2023

CARL J. HOLDEN  
LICENSE # PE-2020016283

**PROJECT TITLE**  
CITY OF WENTZVILLE, MO PUBLIC  
WORKS FACILITY




**PROJECT ADDRESS:**  
1295 INTERSTATE DRIVE  
WENTZVILLE, MO 63385

PLUMBING ENLARGED PLANS



**OWNER**  
**CITY OF WENTZVILLE, MISSOURI**  
1001 SCHROEDER CREEK BLVD  
WENTZVILLE, MO 63385  
636.327.5101


**PROJECT TEAM**  
**CIVIL ENGINEER**  
PREMIER DESIGN GROUP  
100 MIDLAND PARK DRIVE  
WENTZVILLE, MO 63385  
314.925.7444  
**MAINTENANCE CONSULTANT**  
HDR ENGINEERING, INC.  
17725 KATY FREEWAY SUITE 102  
HOUSTON, TX 77044  
816.360.2700  
**STRUCTURAL ENGINEER**  
METTEMEYER ENGINEERING  
2225 W CHESTERFIELD BLVD., SUITE 300  
SPRINGFIELD, MO 65807  
417.890.8002  
**MEP ENGINEER**  
HENDERSON ENGINEERS, INC.  
8345 LENEXA DR., #300  
LENEXA, KS 66214  
913.742.5000

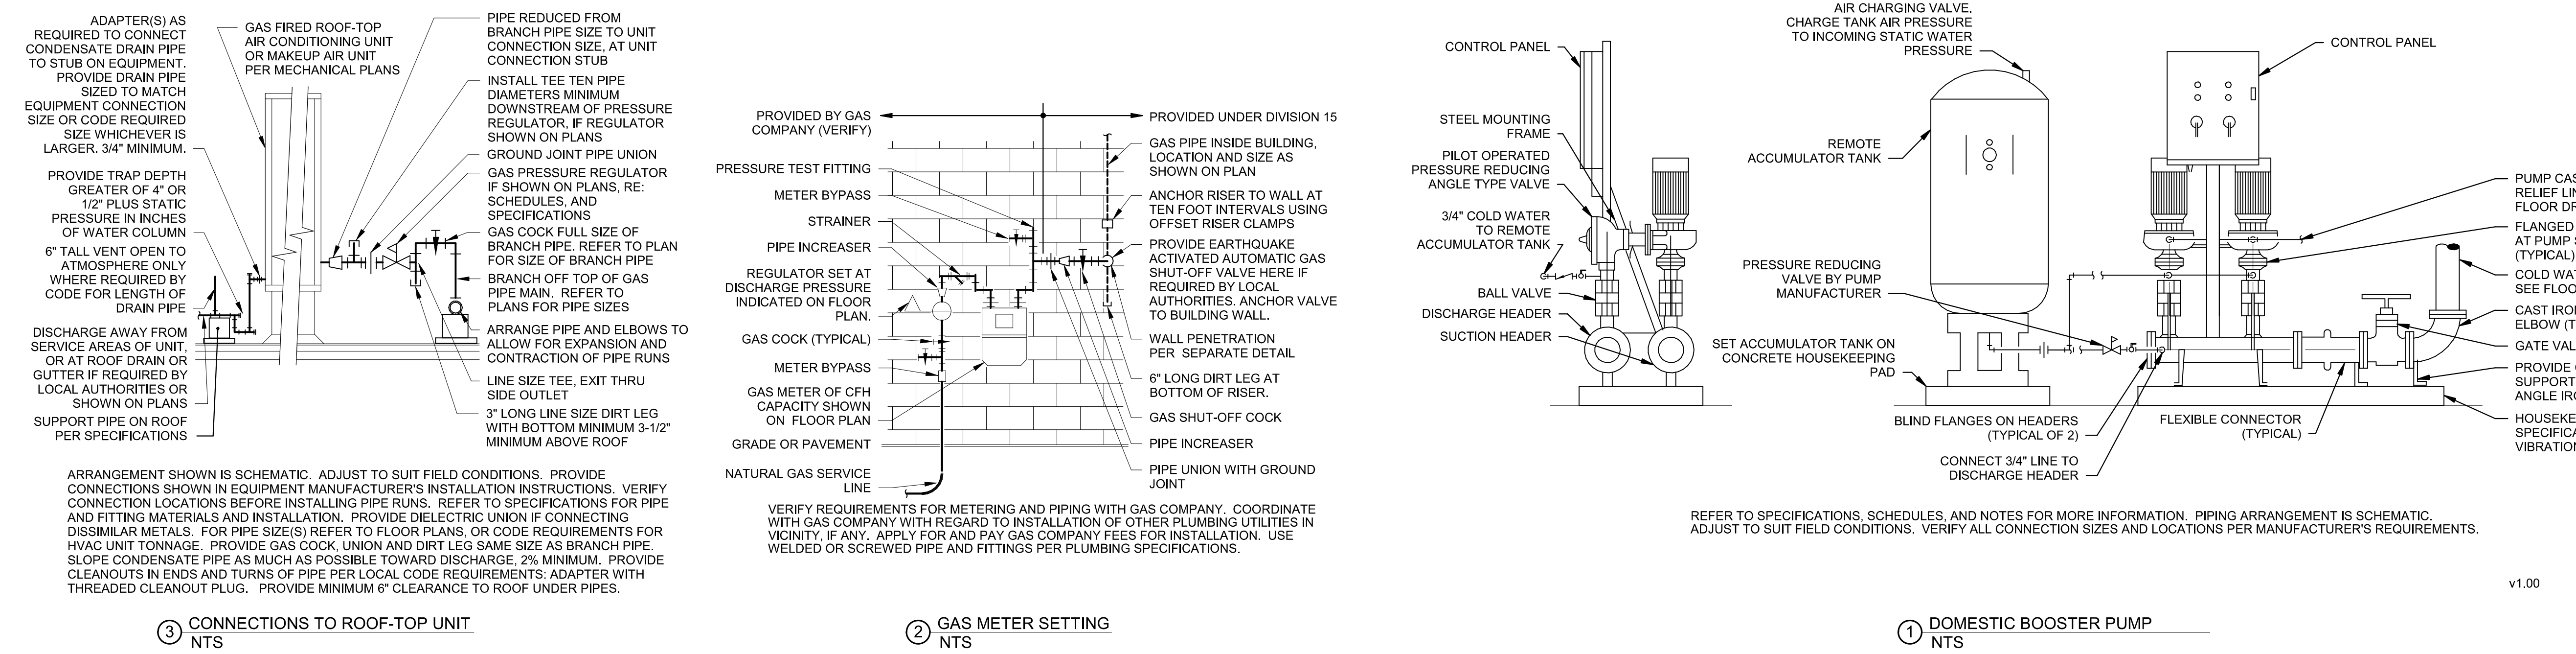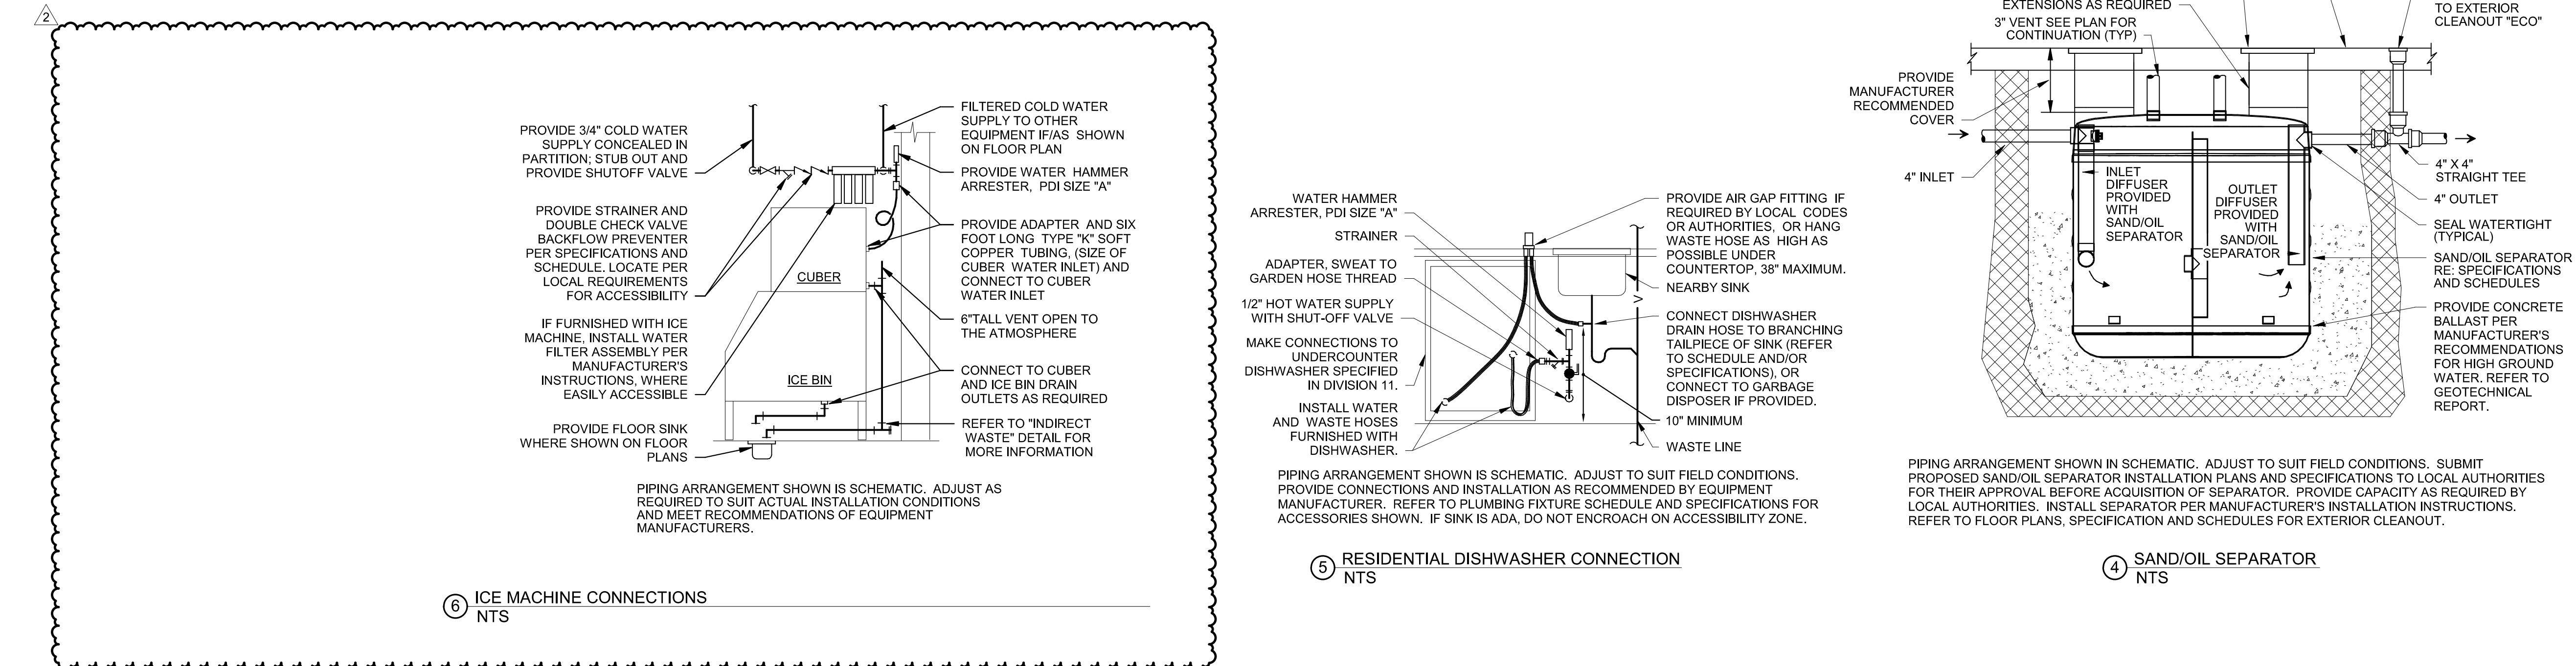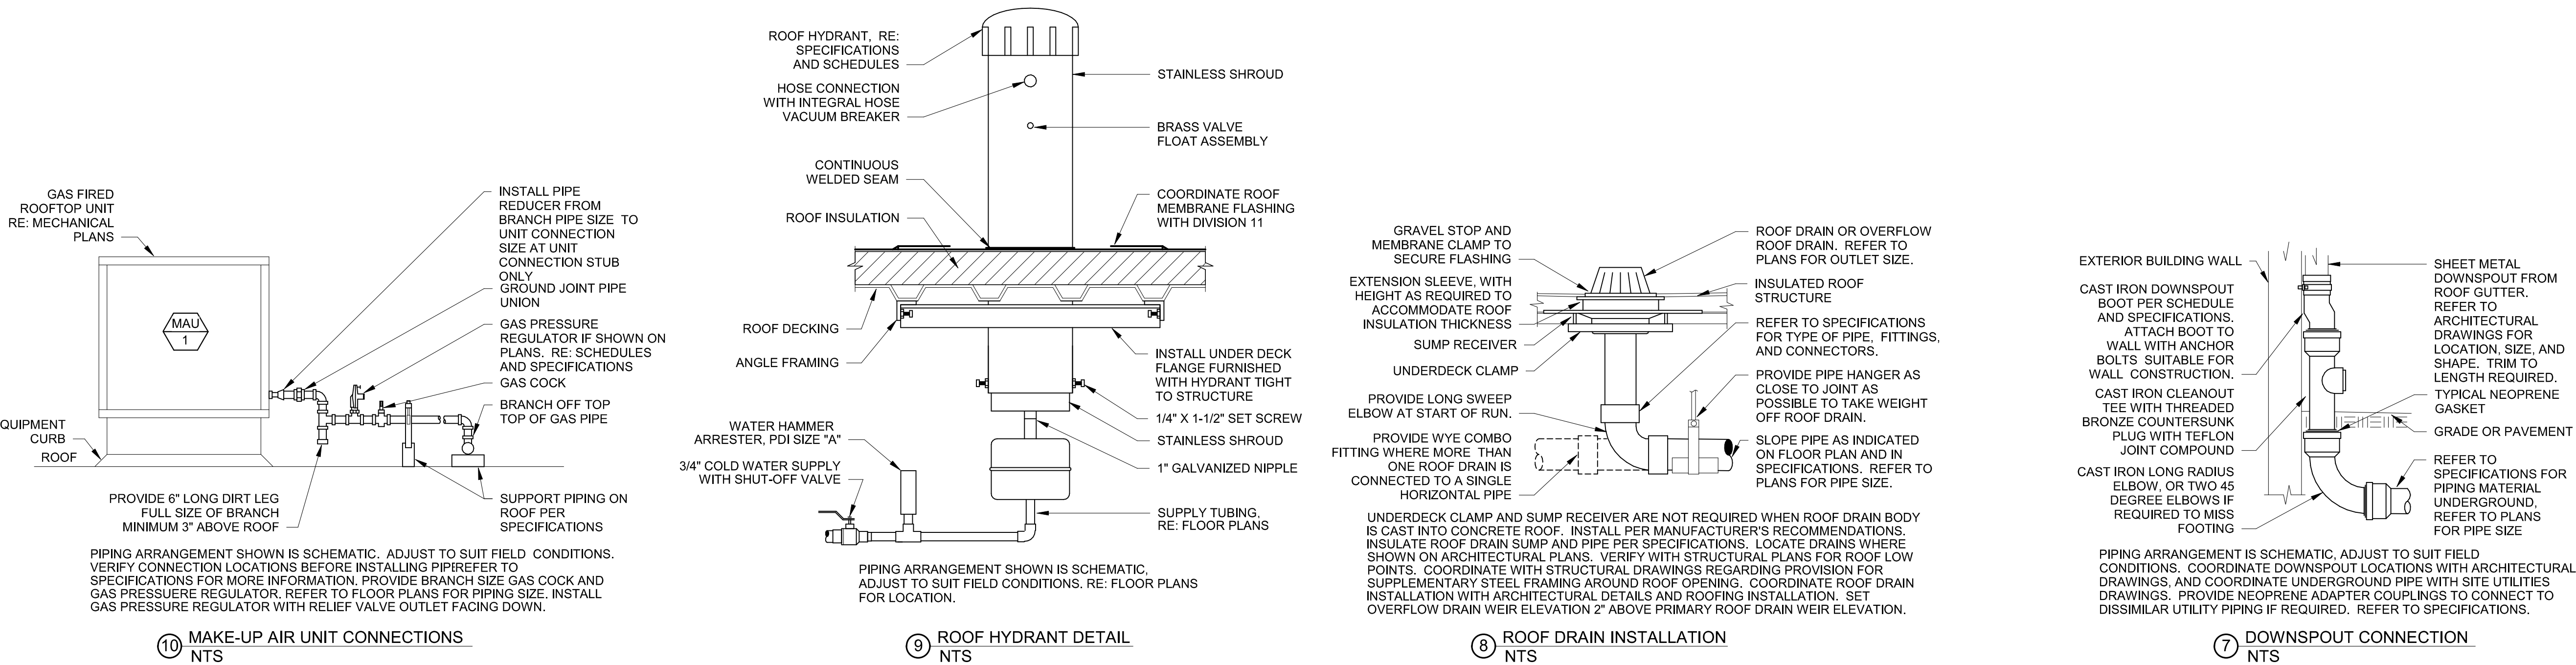

**HENDERSON ENGINEERS**  
8345 LENEXA DRIVE, SUITE 300  
LENEXA, KS 66214  
TEL 913.742.5000 FAX 913.742.5001  
WWW.HENDERSONENGINEERS.COM  
1950004840  
EXPIRES 12/31/2023

REVISIONS		
NO.	DESCRIPTION	DATE
2	ADD 02	01.25.23

PROJECT NO.: 19-040 DRAWN BY: MJ  
DATE: 12.15.22 REVIEWED BY: HEI

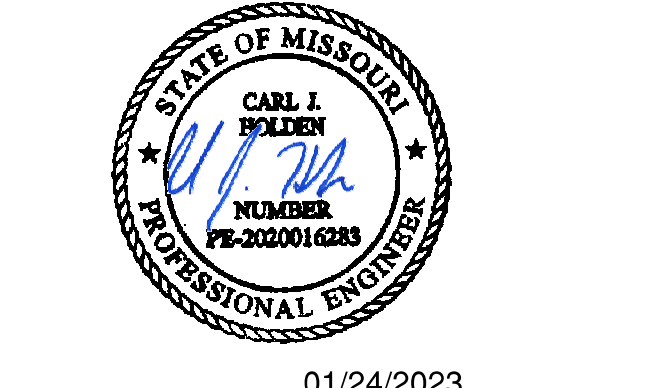

**PROJECT TITLE**  
**CITY OF WENTZVILLE, MO PUBLIC WORKS FACILITY**  
**PROJECT ADDRESS:**  
1295 INTERSTATE DRIVE  
WENTZVILLE, MO 63385

**PLUMBING DETAILS**







ELECTRICAL SYMBOLS

THIS IS A MASTER LEGEND AND NOT ALL SYMBOLS OR ABBREVIATIONS ARE USED.

V3.00

STANDARD MOUNTING HEIGHTS		
AUDIBLE APPLIANCES (CENTERLINE)		84"
ALARMS		48"
ANNUNCIATOR PANELS (DISPLAY)		60"
CONTROLS (TOP OF DEVICE)		48"
EXT SIGNS (WALL MOUNTED)		80"
FIRE ALARM ANNUNCIATOR PANEL (DISPLAY)		60"
FIRE ALARM BELL (EXTERIOR) (CENTERLINE)		120"
FIRE ALARM CONTROL PANEL/UNIT (DISPLAY)		36"
INTERCOM (AREA ONLY)		48"
INTERCOMS (TOP OF DEVICE)		48"
PULL STATIONS (TOP OF DEVICE)		60"
PHOTOCELLS		144"
RECEPTACLES		16"
RECEPTACLES (EXTERIOR)		24"
RECEPTACLES (GARAGES)		27"
RECEPTACLES (POOLS)		44"
RECEPTACLES (ABOVE COUNTER) +6" ABOVE BACKSPASH/COUNTER, 40" MAX		48"
RECEPTACLES IN EQUIPMENT ROOMS		48"
REMOTE INDICATING LIGHT (EQUIPMENT ROOMS)		48"
REMOTE INDICATING LIGHT (FINISHED AREAS)		CEILING
SAFETY SWITCHES (TOP OF DEVICE)		48"
STARTERS (TOP OF DEVICE)		48"
SWITCHES (TOP OF DEVICE)		48"
TELEPHONE, DATA OUTLETS	SAME AS ADJACENT DEVICE, UNO	6"
TELEPHONE TERMINAL BOARD (BOTTOM)		6"
TELEVISION OUTLETS	REFER TO ARCH DRAWINGS	84"
VISIBLE APPLIANCES (CENTERLINE)		84"

INSTALL OUTLET BOXES AT THE MOUNTING HEIGHTS SHOWN ABOVE UNO IN THE CONSTRUCTION DOCUMENTS. MOUNTING HEIGHTS LISTED ABOVE, OR ELSEWHERE IN THE CONSTRUCTION DOCUMENTS, ARE AFF OR AFG TO BOTTOM OF OUTLET BOX UNO. ALL DEVICES SHALL BE INSTALLED IN COMPLIANCE WITH CURRENT ADA AND LOCAL REQUIREMENTS.

ABBREVIATIONS

AF	AMPERE FUSE SIZE	MCC	MOTOR CONTROL CENTER
AFC	ABOVE FINISHED CEILING	MFR	MANUFACTURER
AFF	ABOVE FINISHED FLOOR	MIN	MINIMUM
AFG	ABOVE FINISHED GRADE	MLO	MAIN LUGS ONLY
AHJ	AUTHORITY HAVING JURISDICTION	MLV	MAGNETIC LOW-VOLTAGE
AHU	AIR HANDLING UNIT	MOCB	MAXIMUM OVERCURRENT
AIC	AMPERE INTERRUPTING CAPACITY	MTD	NOT APPLICABLE
AS	AMPERE SWITCH	NF	NON-FUSED
AT	AMPERE TRIP SETTING	NL	NIGHT LIGHT (24HR ON)
ATS	AUTOMATIC TRANSFER SWITCH	NRTL	NATIONALLY RECOGNIZED TESTING LABORATORY (CSA, ETL, NSF, UL)
AV	AUDIO VISUAL	NTS	NOT TO SCALE
BAS	BUILDINGS AUTOMATION SYSTEM	OS	OCCUPANCY SENSOR
BKR	BREAKER	P	POLE
C	CONDUIT	PART	PARTIAL CIRCUIT
CAT	CATEGORY	PHID	PHASE
CATV	CABLE TELEVISION SYSTEM	PNL	PANEL
CCTV	CLOSED CIRCUIT TELEVISION	PNLBD	PANELBOARD
CD	CANDELA	PROVIDE	FURNISH AND INSTALL
CKT	CIRCUIT	PT	POTENTIAL TRANSFORMER
CODE	APPLICABLE CODE	QTY	QUANTITY
	ADOPTED BY JURISDICTION	RREL	RELOCATE
CT	CURRENT TRANSFORMER	RCPT	RECEPTACLE
CTR	CENTER	RLA	RUNNING LOAD AMPS
CVD	CUMULATIVE VOLTAGE DROP	RTU	ROOFTOP UNIT
DEMO	DEMOLITION	SCCR	SHORT-CIRCUIT CURRENT RATING
DDPT	DOUBLE-THROW	SD	SMOKE DUCT DETECTOR
DPST	DOUBLE-POLE, SINGLE-THROW	SF	SQUARE FEET
E/ET/REX	EXISTING TO REMAIN	SPDT	DOUBLE-THROW
EC	ELECTRICAL CONTRACTOR	SPST	SINGLE-POLE, SINGLE-THROW
EF	EXHAUST FAN	SSBJ	SUPPLY-SIDE BONDING JUMPER
EM	EMERGENCY	ST	SHUNT TRIP
EMS	ENERGY MANAGEMENT SYSTEM	SWBD	SWITCHBOARD
ELV	ELECTRONIC LOW-VOLTAGE	SWGR	SWITCHGEAR
ERMS	ENERGY REDUCTION	TBB	TELECOMMUNICATIONS BONDING BACKBONE
EWC	ELECTRIC WATER COOLER	TBD	TO BE DETERMINED
FAAP	FIRE ALARM ANNUNCIATOR PANEL	TGB	TELECOMMUNICATIONS GROUND BUS BAR
FACP	FIRE ALARM CONTROL PANEL	TL	TWISTLOCK
FCA	FAULT CURRENT AMPS AVAILABLE	TMGB	TELECOMMUNICATIONS MAIN GROUND BUS BAR
FCU	FAN COIL UNIT	TXXXFMR	TRANSFORMER
FF	FINISHED FLOOR	TYP	TYPICAL
FLA	FULL LOAD AMPS	UF	UNDERFLOOR
FLR	FLOOR	UG	UNDERGROUND
GC	GENERAL CONTRACTOR	UIS	UNDERSLAB
GEC	GROUNDING ELECTRODE CONDUCTOR	UH	UNIT HEATER
GES	GROUNDING ELECTRODE SYSTEM	UNO	UNLESS NOTED OTHERWISE
GFR	GROUND FAULT RELAY	UPS	UNINTERRUPTIBLE POWER SUPPLY
G	GROUND	VD	VOLTAGE DROP
IG	ISOLATED GROUND	VFD	VARIABLE FREQUENCY DRIVE
ISC	SHORT CIRCUIT CURRENT	VS	VACANCY SENSOR
JB(I)-BOX	JUNCTION BOX	W	WIRE
LF	LINEAR FEET	WI	WITH
LRA	LOOKED ROTOR AMPS	WP	WEATHER PROOF
LTGLTS	LIGHTING LIGHTS	WR	WEATHER RESISTANT
MAU	MAKE-UP AIR UNIT	WT	WATERTIGHT
MAX	MAXIMUM	XP	EXPLOSION PROOF
MCA	MINIMUM CIRCUIT AMPACITY		
MCB	MAIN CIRCUIT BREAKER		

LINE TYPE LEGEND

THROUGHOUT THE DRAWINGS DIFFERENT LINE TYPES ARE USED IN COMBINATION WITH THE SYMBOLS TO INDICATE THE STATUS OF ITEMS AS EXISTING, TO BE DEMOLISHED, TO BE INCLUDED AS PART OF NEW WORK AND/OR ITEMS WHICH ARE ANTICIPATED TO BE PROVIDED IN THE FUTURE. THE STATUS OF ITEMS USING THESE LINE TYPES ARE RELATIVE TO THE VIEW IN WHICH THEY APPEAR. PHASING SHOWN IN DRAWINGS IS NOT INTENDED TO FULLY DESCRIBE ALL NECESSARY CONSTRUCTION PHASING, WHICH IS DETERMINED BY THE CONTRACTOR AS PART OF THEIR RESPONSIBILITIES. ANY SUCH PHASES DESCRIBED IN THE CONSTRUCTION DOCUMENTS ARE GENERAL AND ONLY INTENDED TO INDICATE A BROAD ORDER FOR THE SAKE OF DESCRIBING THE PROJECT. THE FOLLOWING LINE TYPES MAY BE USED ON ANY DEVICE, EQUIPMENT, NOTE, LINE, SHAPE, ETC.

EXISTING	_____
DEMOLISH	-----
NEW	_____
FUTURE	-----

ANNOTATION	
	MECHANICAL OR FIRE PROTECTION PLAN NOTE CALLOUT
	PLUMBING PLAN NOTE CALLOUT
	ELECTRICAL OR FIRE ALARM PLAN NOTE CALLOUT
	TECHNOLOGY PLAN CALLOUT
	PLUMBING EQUIPMENT DESIGNATION. (CONTRACTOR FURNISHED AND INSTALLED). REFER TO PLUMBING FIXTURE OR EQUIPMENT SCHEDULES
	EQUIPMENT DESIGNATION (OWNER FURNISHED, CONTRACTOR INSTALLED)
	MECHANICAL EQUIPMENT DESIGNATION (CONTRACTOR FURNISHED AND INSTALLED UNLESS NOTED OTHERWISE)
	CONNECTION POINT OF NEW WORK TO EXISTING
	DETAIL REFERENCE UPPER NUMBER INDICATES DETAIL NUMBER LOWER NUMBER INDICATES SHEET NUMBER
	SECTION CUT DESIGNATION
	DEDICATED EQUIPMENT ACCESS TILE
	ACCESS PANEL

CIRCUITING & WIRING

	HOMERUN TO PANELBOARD. INFORMATION AT ARROWS ARE CIRCUIT NUMBERS AND PANELBOARD FOR TERMINATION. REFER TO PANELBOARD SCHEDULES FOR BRANCH CIRCUIT CONDUCTOR SIZES.
	INDICATES RELAY NUMBER
	CIRCUIT CONTINUATION OR PARTIAL CIRCUIT
	CONDUIT CONCEALED
	CONDUIT CONCEALED (EMERGENCY)
	CONDUIT IN UNDER FLOOR/GROUND CONSTRUCTION
	EXPOSED CONDUIT
	EXPOSED CONDUIT (EMERGENCY)
	FLEXIBLE CONDUIT
	LOW VOLTAGE CABLE (REFER TO SPECS FOR RACEWAY)
	CONDUIT TURNING DOWN
	CONDUIT TURNING UP
	CONNECTION POINT OR EQUIPMENT TERMINATION
	EQUIPMENT TERMINATION

CONDUCTOR TICK MARK LEGEND

WHERE TICK MARKS ARE SHOWN, THE FOLLOWING SHALL GOVERN:

	SWITCHED HOT (PHASE) CONDUCTORS (SHOWN TRAILING NEUTRAL)
	NEUTRAL (GROUNDED) CONDUCTOR
	UNSWITCHED HOT (PHASE) CONDUCTORS (SHOWN LEADING NEUTRAL)
	NOTE: HASH MARKS INDICATE QUANTITY OF CONDUCTORS
	EQUIPMENT GROUNDING CONDUCTOR IN CONDUIT (GREEN INSULATION OR BARE)
	ISOLATED GROUNDING CONDUCTOR IN CONDUIT (GREEN INSULATION WITH YELLOW TRACER)

BRANCH CIRCUIT CONDUCTOR TABLE

WHERE TICK MARKS ARE NOT SHOWN, THE FOLLOWING SHALL GOVERN:

# OF POLES	HOT (PHASE)* (GROUNDED)**	GROUNDING***
1P	(1)	(1) UNO (1)
2P	(2)	(1) UNO (1)
3P	(3)	(1) UNO (1)

- \* PROVIDE ADDITIONAL CONDUCTORS THROUGH ENTIRE CIRCUIT (SWITCHED, UNSWITCHED/EM, ETC.) AS INDICATED THROUGHOUT CONSTRUCTION DOCUMENTS AND AS REQUIRED FOR A COMPLETE AND WORKING SYSTEM.
- \*\* REFER TO SPECIFICATIONS FOR LIMITATIONS ON SHARING NEUTRAL (GROUNDED) CONDUCTORS. DO NOT CIRCUIT AS A MULTI-WIRE BRANCH CIRCUIT, UNO.
- \*\*\* PROVIDE ADDITIONAL ISOLATED GROUNDING CONDUCTORS WHERE INDICATED.
- REFER TO SPECIFICATIONS, PLANS, NOTES, WIRING AND CONTROL DIAGRAMS FOR ADDITIONAL CIRCUITING REQUIREMENTS.

LIGHTING	
	LIGHT FIXTURE
	a = LOWER CASE LETTER IS SWITCH IDENTIFIER
	A = UPPER CASE LETTER INDICATES LIGHT FIXTURE TYPE
	⊥ = WALL MOUNT
	) = ARROW INDICATED AIMING DIRECTION
	LIGHT FIXTURE CIRCUITED AS A NIGHT LIGHT (NL)
	EMERGENCY LIGHT FIXTURE WITH EMERGENCY LIGHTING BATTERY PACK OR CONNECTED TO EMERGENCY SOURCE
	NIGHT LIGHT/EMERGENCY LIGHT FIXTURE WITH EMERGENCY BATTERY PACK OR CONNECTED TO EMERGENCY SOURCE
	LIGHT FIXTURE WITH DUAL BALLASTS CIRCUITED SEPARATELY (SHADING IMPLIES EMERGENCY LIGHT FIXTURE)
	LIGHTING TRACK (# INDICATES RELAY NUMBER)
	MIRROR LIGHTS
	EXTERIOR PARKING LOT LIGHT FIXTURE
	EXTERIOR PEDESTRIAN POST TOP LIGHT FIXTURE
	EXTERIOR LIT BOLLARD LIGHT
	EXIT SIGN - CEILING / WALL MOUNTED, ARROWS AS INDICATED, FACE HATCHED
	EMERGENCY LIGHTING UNIT EQUIPMENT WITH BATTERY PACK - CEILING/WALL MOUNTED
	AREA (AREA FOR EVACUATION ASSISTANCE) SIGN - CEILING/WALL MOUNTED, ARROWS AS INDICATED

REFER TO LIGHT FIXTURE SCHEDULE FOR MORE INFORMATION

POWER EQUIPMENT & DEVICES

	ELECTRICAL PANELBOARD (SURFACE OR FLUSH MOUNT)
	ELECTRICAL CABINET (SURFACE OR FLUSH MOUNT), TYPE AS NOTED
	PLYWOOD TERMINAL BOARD FOR TELEPHONE SYSTEM, UNO, SIZE AS NOTED
	SWITCHBOARD OR MOTOR CONTROL CENTER ON HOUSEKEEPING PAD
	ELECTRICAL DISTRIBUTION PANELBOARD
	TRANSFORMER
	DISCONNECT SWITCH - "200/3150/3R" DENOTES AMPERES/POLE/FUSE/NEMA ENCLOSURE RATING, NF= NON-FUSED, CB= CIRCUIT BREAKER (200/3/CB), NO VALUE (200/3/150) FOR NEMA ENCLOSURE MEANS STANDARD NEMA 1 RATING
	COMBINATION DISCONNECT (SAFETY) SWITCH AND MOTOR STARTER "30/315/1/3R" DENOTES AMPERES/POLE/FUSE/NEMA STARTER SIZE/NEMA ENCLOSURE RATING, NF= NON-FUSED, CB= CIRCUIT BREAKER (30/3/CB/1), NO VALUE (200/3/150/1) FOR NEMA ENCLOSURE MEANS STANDARD NEMA 1 ENCLOSURE RATING
	MAGNETIC MOTOR STARTER, NEMA SIZE AS NOTED, 3-POLE, UNO
	VARIABLE FREQUENCY DRIVE
	INDICATING LIGHT
	EMERGENCY POWER OFF BUTTON
	STOP-START PUSH BUTTON CONTROL STATION
	HAND-OFF-AUTO PUSH BUTTON CONTROL STATION
	MUSHROOM-TYPE PUSH BUTTON
	OVERHEAD PADDLE FAN

BOXES, LIGHTING CONTROL & WIRING DEVICES	
	SWITCH LETTER DESIGNATIONS AS FOLLOWS: BLANK = SINGLE 2 = TWO POLE 3 = THREE-WAY 4 = FOUR-WAY D = DIMMER F = FAN SPEED CONTROL FH = FRACTIONAL HORSEPOWER MANUAL CONTROLLER IH = INTEGRAL HORSEPOWER MANUAL CONTROLLER K = KEYPAD LW = LOW VOLTAGE / DIGITAL M = MANUAL MOTOR STARTER DISCONNECT OS# = OCCUPANCY SENSOR P = SPST PILOT LIGHT WP = WEATHER PROOF # = REFER TO LIGHTING CONTROL DEVICE SCHEDULE
	AUTOMATIC LOAD CONTROL RELAY
	BRANCH CIRCUIT TRANSFER SWITCH
	CEILING / WALL MOUNTED OCCUPANCY SENSOR (# INDICATES TYPE PER SCHEDULE)
	CORNER 90 DEGREE SENSING ONE-DIRECTION SENSING, CEILING/WALL MOUNT CEILING MOUNT, TWO DIRECTION SENSING CEILING MOUNT, FOUR DIRECTION SENSING
	CONTACTOR (SIZE, COIL VOLTAGE AND NUMBER OF POLES AS INDICATED)
	TRACK-MOUNTED CURRENT LIMITER (## INDICATES AMPERAGE)
	DAYLIGHT SENSOR (# INDICATES TYPE PER SCHEDULE)
	LIGHTING CONTROLS PROCESSOR AND/OR EQUIPMENT
	POWER PACK (# INDICATES TYPE PER SCHEDULE)
	PHOTOELECTRIC SWITCH
	ROOM CONTROLLER (# INDICATES TYPE PER SCHEDULE)
	TIME SWITCH
	SIMPLEX RECEPTACLE - NEMA 5-20R, UNO
	DUPLEX RECEPTACLE - NEMA 5-20R, UNO
	DOUBLE DUPLEX RECEPTACLE - NEMA 5-20R, UNO
	SPECIAL RECEPTACLE - NEMA TYPE AS NOTED
	TWIST-LOCK TYPE RECEPTACLE
	BLANK FACE GFCI FEED THROUGH DEVICE
	GFCI TYPE RECEPTACLE*
	ISOLATED GROUND TYPE RECEPTACLE*
	EMERGENCY RECEPTACLE*
	RECEPTACLE INSTALLED ABOVE COUNTER OR BACKSPLASH*
	RECEPTACLE INSTALLED IN CEILING*
	RECEPTACLE INSTALLED IN FLOOR*
	RECEPTACLE INSTALLED VIA DROP CORD*
	RECEPTACLE LETTER DESIGNATIONS AS FOLLOWS: CH = CLOCK HANGER TYPE G-RPPT = PROTECTED BY GFCI CIRCUIT BREAKER OR UPSTREAM GFCI DEVICE H = HORIZONTALLY MOUNTED S = MANUALLY CONTROLLED SP / TVSS = SURGE PROTECTION TR = TAMPER RESISTANT TV = TELEVISION USB = USB/DUPLEX WP = WEATHER PROOF COVER WR = WEATHER RESISTANT
	MULTI-OUTLET ASSEMBLY
	TELEPHONE OUTLET
	DATA OUTLET
	MULTI-SERVICE OUTLET, TELEPHONE AND DATA
	ABOVE COUNTER, TYP FLOOR, TYP
	MULTI-SERVICE POWER POLE WITH TELEPHONE, DATA AND POWER OUTLETS A = TYPE, REFER TO PLANS, SCHEDULES AND SPECIFICATIONS
	MULTI-SERVICE FLOOR BOX WITH TELEPHONE, DATA AND POWER OUTLETS A = TYPE, REFER TO PLANS, SCHEDULES AND SPECIFICATIONS
	POKE THROUGH, A = TYPE, REFER TO PLANS, SCHEDULES AND SPECIFICATIONS
	THERMOSTAT
	CEILING/FLOOR MOUNT JUNCTION/OUTLET BOX
	WALL MOUNT JUNCTION/OUTLET BOX

\* SYMBOL DEMONSTRATED WITH DUPLEX RECEPTACLE, WHEN USED IN COMBINATION WITH OTHER DEVICES MEANING IS SIMILAR FOR THOSE DEVICE TYPES.  
REFER TO LIGHTING CONTROL DEVICE SCHEDULE FOR MORE INFORMATION.

ELECTRICAL ONE-LINE & RISER DIAGRAM	
	SWITCH (RATING AS INDICATED)
	DRAWOUT CIRCUIT BREAKER (RATINGS AS INDICATED)
	FUSED SWITCH (RATING, POLES AND FUSE TYPE AS INDICATED)
	COMBINATION FUSED SWITCH/STARTER AND STARTER SIZE
	CIRCUIT BREAKER (RATINGS AS INDICATED)
	COMBINATION CIRCUIT BREAKER/STARTER AND STARTER SIZE
	PANELBOARD, SINGLE OR MULTI-SECTION (REFER TO SCHEDULES)
	ISOLATED POWER PANELBOARD W/ INTEGRAL TRANSFORMER (REFER TO SCHEDULES)
	TRANSFORMER (TYPE AND RATINGS AS INDICATED)
	SHIELDED TRANSFORMER (TYPE AND RATINGS AS INDICATED)
	AUTOMATIC TRANSFER SWITCH (RATINGS AS INDICATED)
	AUTOMATIC TRANSFER SWITCH WITH BYPASS (RATINGS AS INDICATED)
	GENERATOR (RATINGS AS INDICATED)
	NON-SEPARATELY DERIVED SOURCE OR SEPARATELY DERIVED SOURCE
	SWITCHGEAR, SWITCHBOARD AND/OR DISTRIBUTION PANELBOARD (TYPE, RATING, DEVICES AND ACCESSORIES AS INDICATED)
	COMBINATION DIGITAL VOLT METER/AMMETER
	CIRCUIT IDENTIFICATION (REFER TO CIRCUIT SCHEDULE)
	GROUND FAULT RELAY
	PHASE FAILURE RELAY
	KIRK-KEY INTERLOCK (# INDICATES KEY PAIR)
	SHUNT TRIP
	AMMETER (RANGE AS SPECIFIED OR REQUIRED)
	VOLTMETER (RANGE AS SPECIFIED OR REQUIRED)
	UTILITY METER (AS REQUIRED BY UTILITY)
	AMMETER SWITCH
	VOLTMETER SWITCH
	WATT-HOUR METER, "D" DENOTES DEMAND REGISTER, "15" DENOTES MINUTES OF DEMAND INTERVAL
	CURRENT TRANSFORMER RATING AS SPECIFIED OR REQUIRED
	POTENTIAL TRANSFORMER RATING AS SPECIFIED OR REQUIRED
	SURGE-PROTECTIVE DEVICE
	GROUND CONNECTION
	GROUND CONNECTION WITH TEST WELL
	GROUND ROD
	LIGHTNING ARRESTER
	CAPACITOR
	CONTACT (OPEN OR CLOSED)
	HEATER
	MOTOR
	BLOCK LOAD KW OR KVA
	FAULT POINT REFERENCED IN SHORT CIRCUIT CURRENT AND VOLTAGE DROP SPREADSHEET
	× FR × FP#

APPLICABLE DESIGN CODES IN ST. CHARLES COUNTY, MISSOURI:  
INTERNATIONAL BUILDING CODE: 2015  
INTERNATIONAL ENERGY CODE: 2015  
NFPFA 70 (NATIONAL ELECTRICAL CODE): 2014  
\*PROJECT IS DESIGNED IN COMPLIANCE WITH THE ABOVE CODES. THIS IS NOT AN EXHAUSTIVE LIST. PROJECT SHALL COMPLY WITH ALL APPLICABLE CODES, STANDARDS, AND LOCAL REQUIREMENTS. REFER TO THE SPECIFICATIONS FOR ADDITIONAL REQUIREMENTS.



OWNER  
CITY OF WENTZVILLE, MISSOURI  
1001 SCHROEDER CREEK BLVD  
WENTZVILLE, MO 63385  
636.327.5101

PROJECT TEAM  
CIVIL ENGINEER  
PREMIER DESIGN GROUP  
100 MIDLAND PARK DRIVE  
WENTZVILLE, MO 63385  
314.925.7444  
MAINTENANCE CONSULTANT  
HDR ENGINEERING, INC.  
17725 KATY FREEWAY SUITE 102  
HOUSTON, TX 77054  
816.360.2700  
STRUCTURAL ENGINEER  
METTEMEYER ENGINEERING  
2225 W CHESTERFIELD BLVD., SUITE 300  
SPRINGFIELD, MO 65807  
417.890.8002  
MEP ENGINEER  
HENDERSON ENGINEERS, INC.  
8345 LENEKA DR., #300  
LENEKA, KS 66214  
913.742.5000



REVISIONS		
NO.	DESCRIPTION	DATE
2	ADD 02	01.25.23

PROJECT NO.: 19-040 DRAWN BY: NS  
DATE: 12.15.22 REVIEWED BY: HEI



01/24/2023

DOUGLAS M. EVERHART  
LICENSE # PE-2019007648

PROJECT TITLE  
CITY OF WENTZVILLE, MO PUBLIC  
WORKS FACILITY  
PROJECT ADDRESS:  
1295 INTERSTATE DRIVE  
WENTZVILLE, MO 63385

ELECTRICAL LEGEND








MEP ENGINEER  
HENDERSON ENGINEERS, INC.  
8345 LENEXA DR., #300  
LENEXA, KS 66214  
913.742.5000

EXPIRES 12/31/2023

PROJECT NO.: 19-040 DRAWN BY: NS  
DATE: 12.15.22 REVIEWED BY: HEI

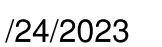


PROJECT ADDRESS:  
1295 INTERSTATE DRIVE  
WENTZVILLE, MO 63385

SHEET  
E100A





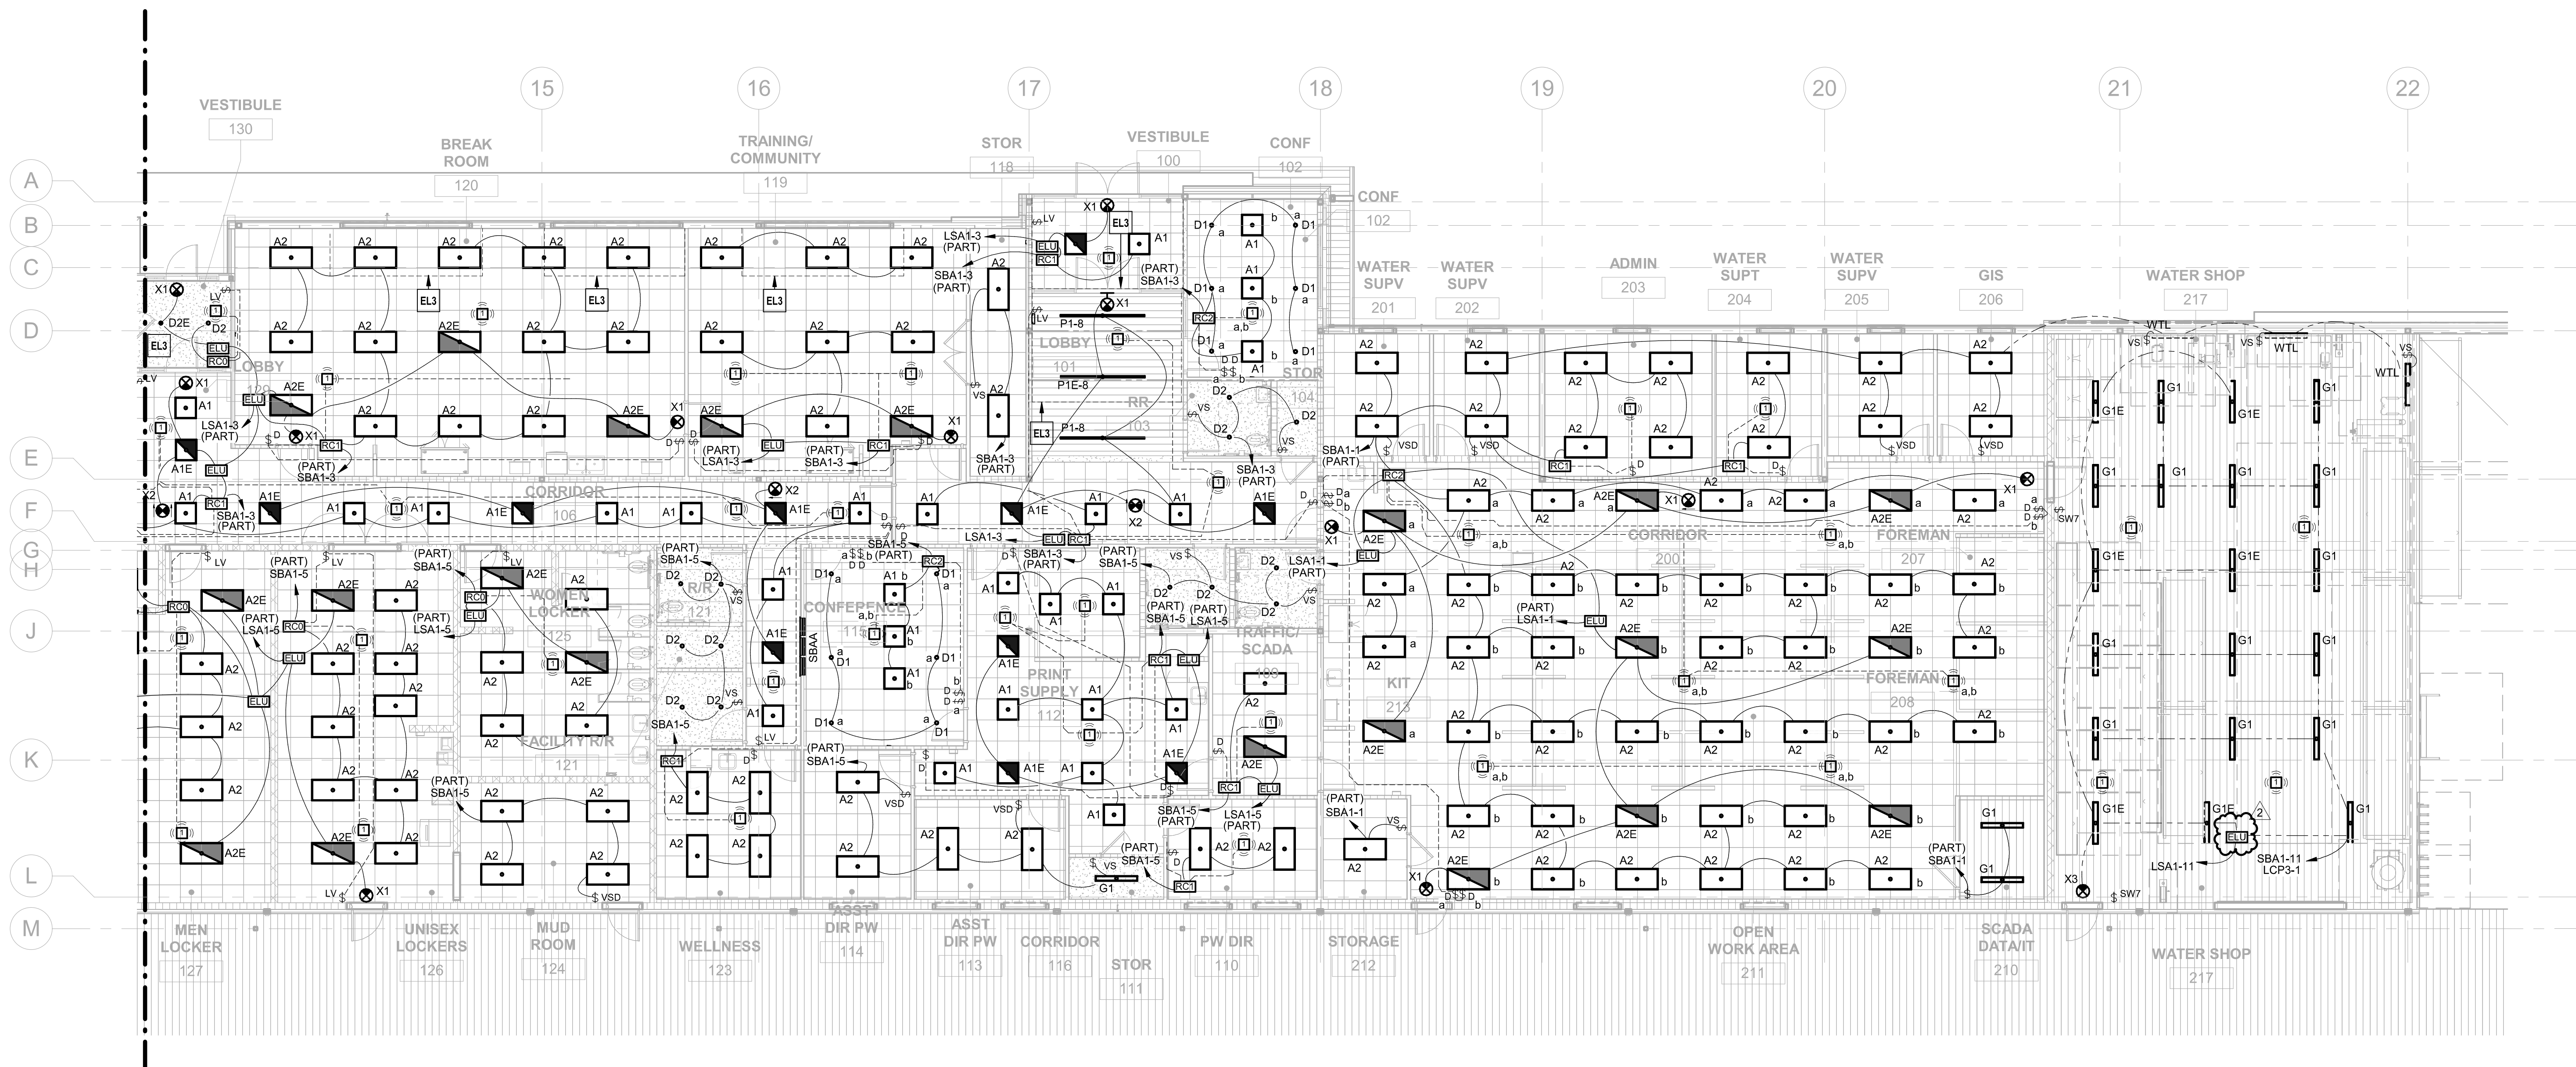

LIGHTING GENERAL NOTES:

- [illegible]

LIGHTING SUPPLEMENTAL SPECIFICATIONS:

2. REFER TO THE ARCHITECTURAL DRAWINGS FOR LIGHT FIXTURE LOCATIONS, MOUNTING HEIGHTS, TRACK LENGTHS AND ADDITIONAL MOUNTING INFORMATION. CONTRACTOR SHALL BE RESPONSIBLE FOR OBTAINING ALL NECESSARY PERMITS. ALL ISSUES ARE RESOLVED PRIOR TO INSTALLATION OF LIGHT FIXTURES. CONTACT ARCHITECT/ENGINEER IMMEDIATELY IF THERE ARE DISCREPANCIES.
3. THROUGH WIRING OF RECESSED LIGHT FIXTURES, IN SUSPENDED OR TRACK MOUNTING, CONNECT EACH LIGHT FIXTURE BY A WHIP TO A JUNCTION BOX. PROVIDE CABLE WHIPS OF SUFFICIENT LENGTHS TO ALLOW FOR RELOCATING EACH LIGHT FIXTURE. CABLE WHIPS SHALL BE 1/2" O.D. WITH 1/8" WALL THICKNESS. CABLE WHIPS SHALL NOT EXCEED 6'-0" OF UNSUPPORTED LENGTHS.
4. ALL EMERGENCY LIGHTS AND EXIT SIGNS WITH INTEGRAL BATTERY BACK-UP SHALL BE CONNECTED TO A SEPARATE UNSWITCHED CONDUCTOR BYPASSING ALL OTHER CONTROLS AND DETECTORS. LINE VOLTAGE DETECTORS AND DETECTORS SHALL NOT BE SWITCHED. REFER TO MANUFACTURER'S WRITTEN INSTRUCTIONS FOR PROPER INSTALLATION AND TESTING. ALLOW 24 HOURS FOR BATTERY CHARGE AFTER BATTERY TESTING AT LOW LEVEL TESTING. IN ORDER TO PREVENT BATTERY DAMAGE, DO NOT TURN OFF POWER FOR EXTENDED PERIODS OF TIME AFTER EMERGENCY LIGHT HAS BEEN POWERED.
5. PROVIDE A NEUTRAL CONDUCTOR TO ALL WALL MOUNTED LINE VOLTAGE SWITCHES. PROVIDE A SEPARATE NEUTRAL. IF NEUTRAL TERMINATION IS NOT REQUIRED FOR THE DEVICE THEN CAP CONDUCTOR AND TAG AS "NEUTRAL FOR FUTURE USE".
6. COORDINATE ALL OCCUPANCY/VACANCY SENSOR SETTINGS WITH OWNER AND ADJUST AS NECESSARY FOR PROPER OPERATION. SENSOR SETTINGS MUST COMPLY WITH AHI AND LOCAL ENERGY CODE REQUIREMENTS.
7. DO NOT INSTALL OCCUPANCY/VACANCY SENSORS WITHIN 48" OF AIR DIFFUSER OR SIMILAR OBSTRUCTION THAT MAY ADVERSELY AFFECT THE SENSOR PERFORMANCE. COORDINATE FINAL SENSOR LOCATION WITH OWNER PRIOR TO INSTALLATION. IN ACCORDANCE WITH MANUFACTURER'S RECOMMENDATIONS.

☐ **ELECTRICAL PLAN NOTES:**

EL3 DAYLIGHT ZONE INDICATED BY LINE HAS LESS THAN 150W OF GENERAL LIGHTING WITHIN THE PRIMARY SIDELIT DAYLIGHT ZONE AND THUS DOES NOT REQUIRE SEPARATE DAYLIGHT CONTROLS.



## KEY PLAN



# hdesigngroup

architecture + design

5039 S National Avenue | Springfield, MO 65810 | 417.887.6595

**OWNER**

**CITY OF WENTZVILLE, MISSOURI**  
1001 SCHROEDER CREEK BLVD  
WENTZVILLE, MO 63385  
636.327.5101

## PROJECT TEAM

CIVIL ENGINEER  
PREMIER DESIGN GROUP  
100 MIDLAND PARK DRIVE  
WENTZVILLE, MO 63385  
314.925.7444

MAINTENANCE CONSULTANT  
HDR ENGINEERING, INC.  
17725 KATY FREEWAY SUITE 100  
HOUSTON, TX 77094  
816.360.2700

STRUCTURAL ENGINEER  
METTEMAYER ENGINEERING  
2225 W CHESTERFIELD BLVD., SUITE 300  
SPRINGFIELD, MO 65807  
417.890.8002

MEP ENGINEER  
HENDERSON ENGINEERS, INC.  
8345 LENEXA DR., #300  
LENEXA, KS 66214  
913.742.5000




8345 LENEXA DRIVE, SUITE 300  
LENEXA, KS 66214  
TEL 913.742.5000 FAX 913.742.5001  
[WWW.HENDERSONENGINEERS.COM](http://WWW.HENDERSONENGINEERS.COM)

1950004840  
EXPIRES 12/31/2023

## REVISIONS

[illegible]

PROJECT NO.: 19-040 DRAWN BY: NS  
DATE: 12.15.22 REVIEWED BY: HE

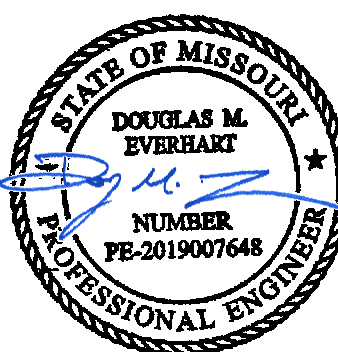

01/24/2023

DOUGLAS M. EVERHART  
LICENSE # PE-2019007648


PROJECT TITLE  
CITY OF WENTZVILLE, MO PUBLIC  
WORKS FACILITY

PROJECT ADDRESS:  
1295 INTERSTATE DRIVE  
WENTZVILLE MO 63385


**LIGHTING LEVEL 1 RCP - AREA A**

E101A



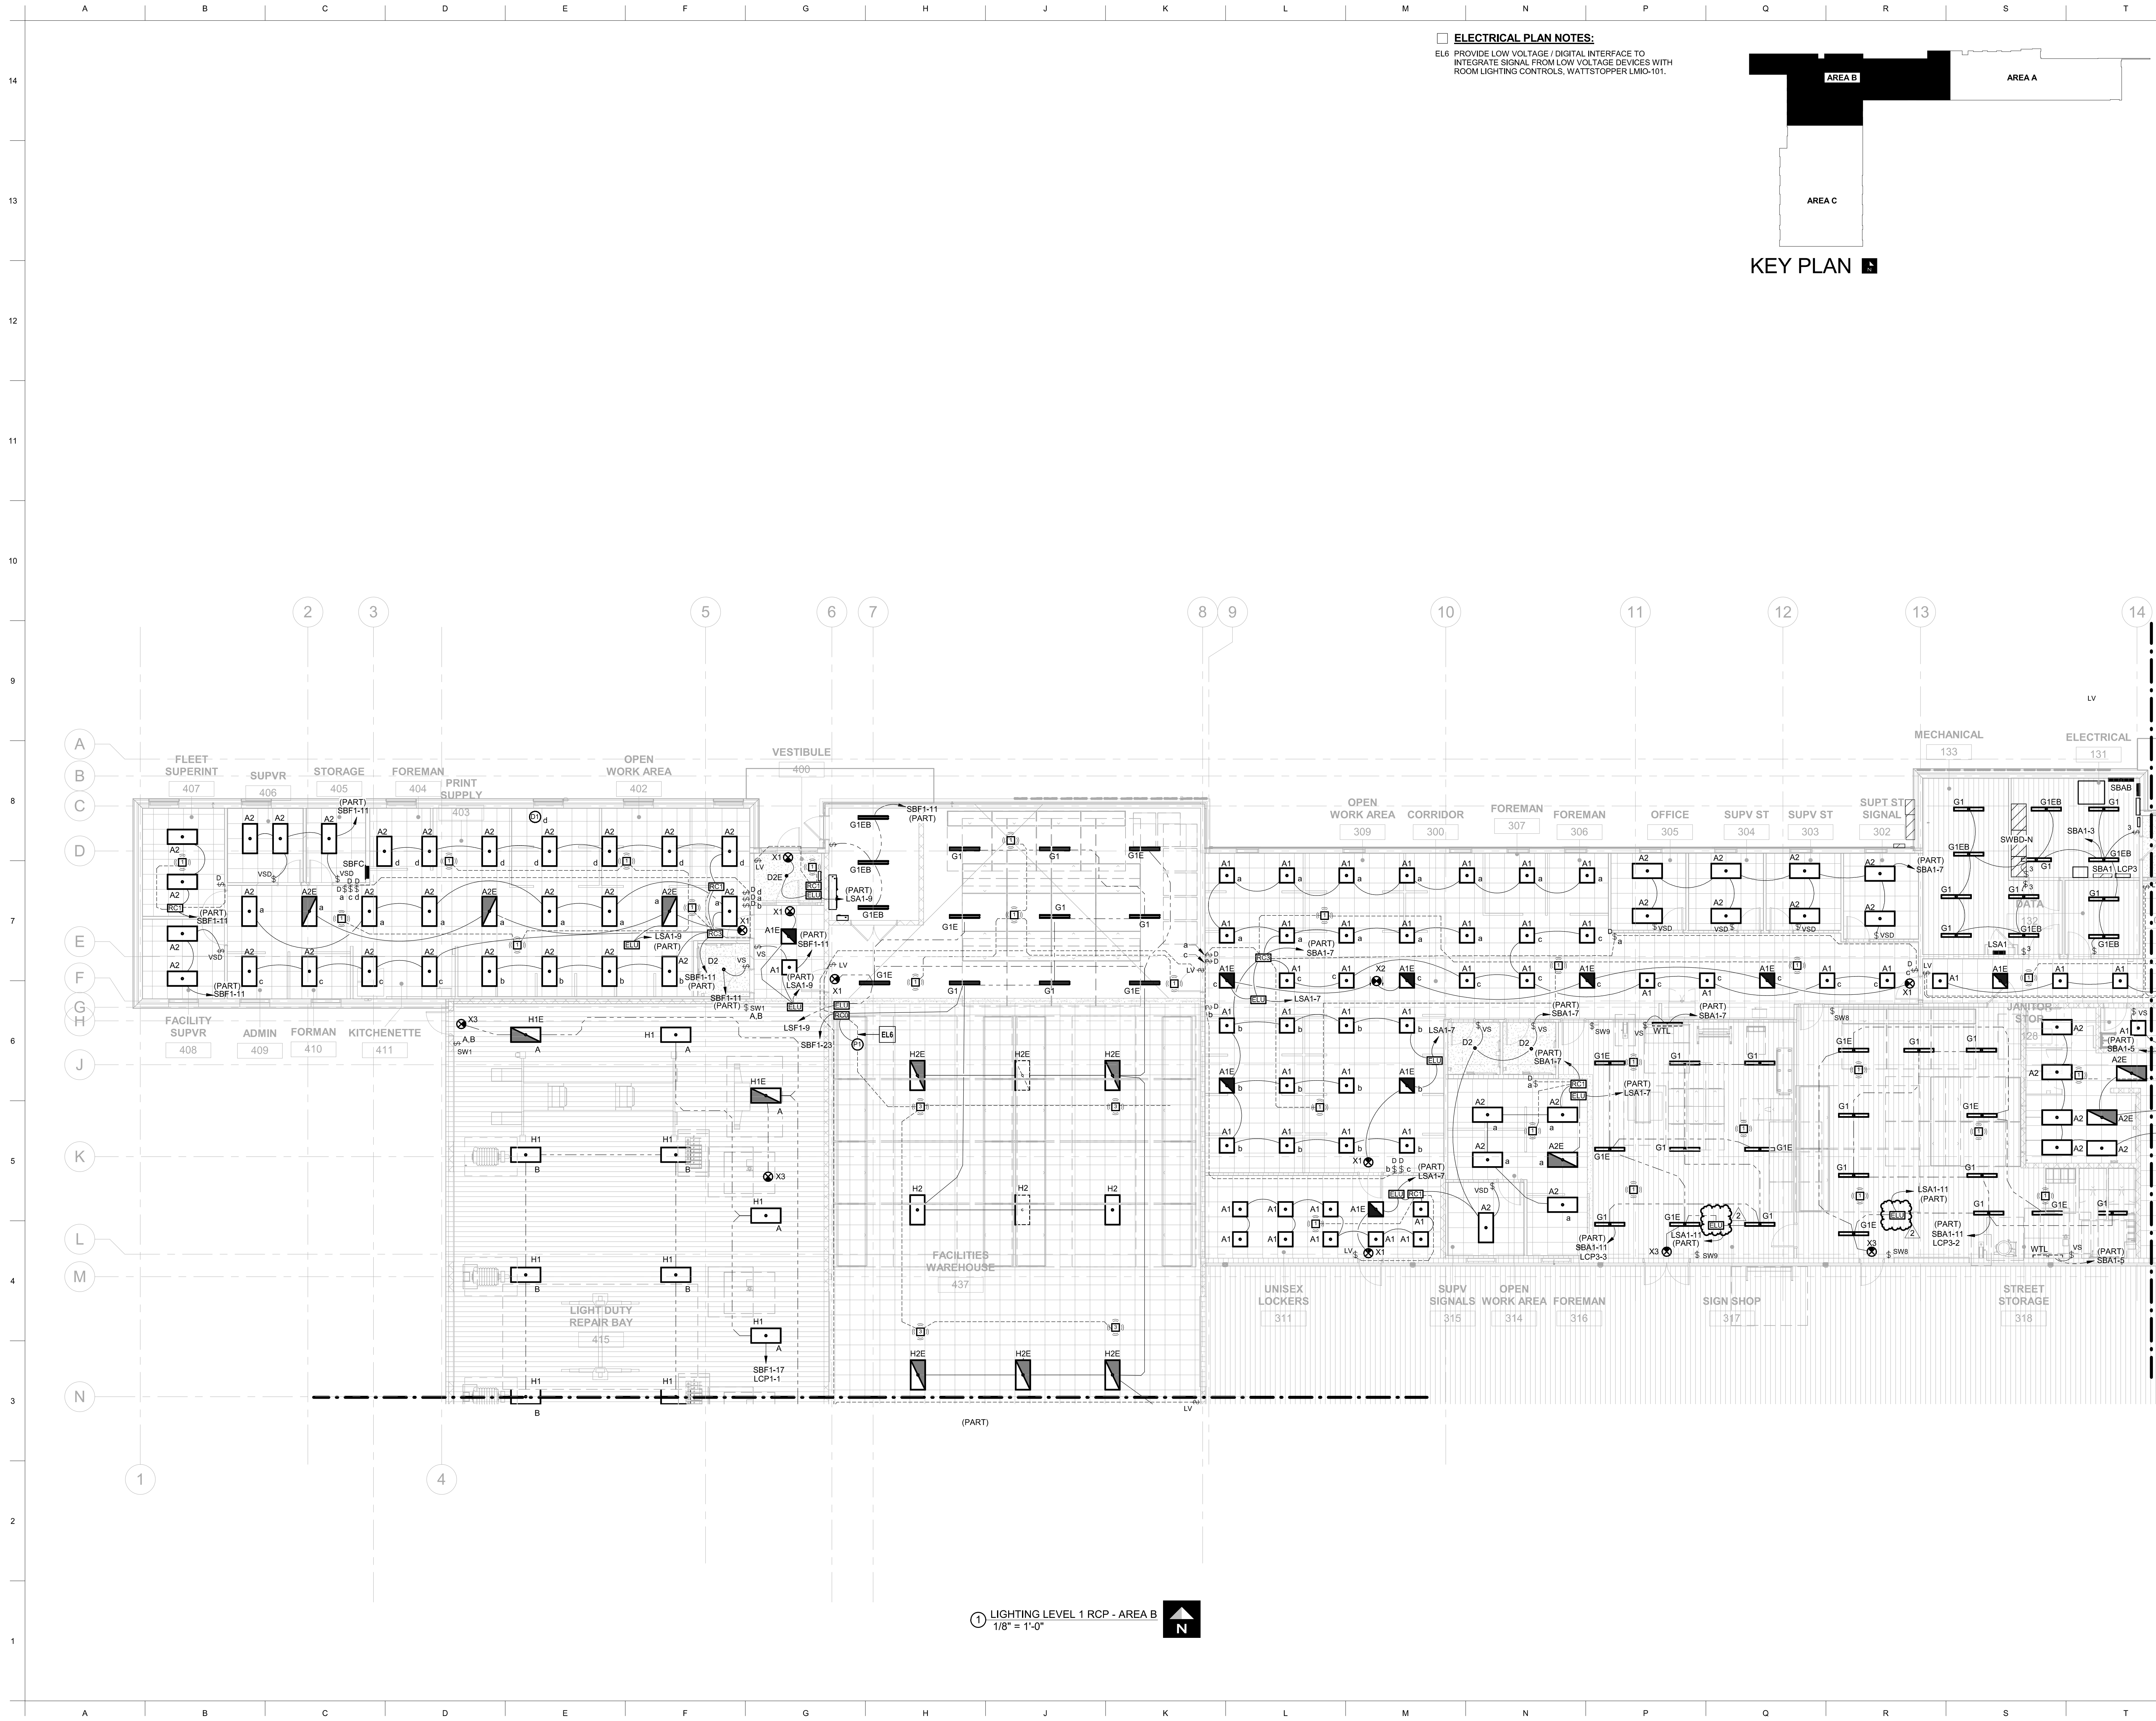

**ELECTRICAL PLAN NOTES:**  
EL6 PROVIDE LOW VOLTAGE / DIGITAL INTERFACE TO  
INTEGRATE SIGNAL FROM LOW VOLTAGE DEVICES WITH  
ROOM LIGHTING CONTROLS, WATTSTOPPER LMO-101.

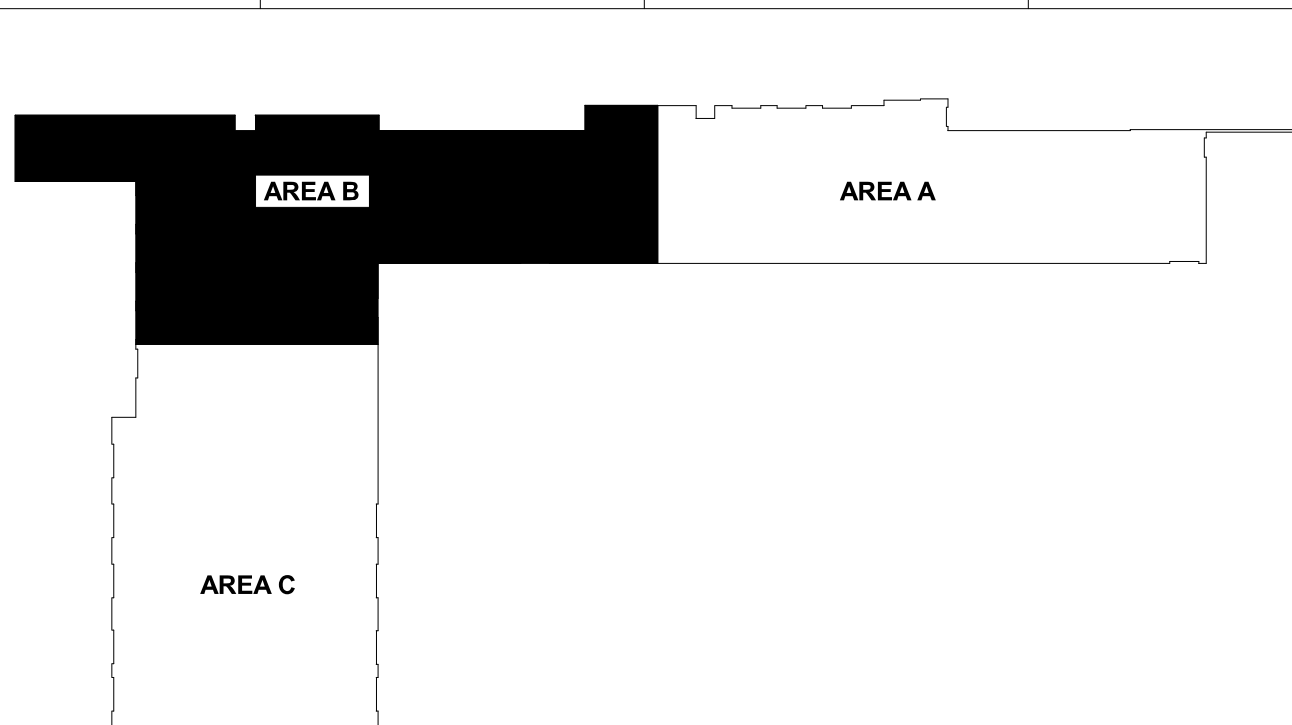

KEY PLAN



5039 S National Avenue | Springfield, MO 65810 | 417.887.6595

**OWNER**  
CITY OF WENTZVILLE, MISSOURI  
1001 SCHROEDER CREEK BLVD  
WENTZVILLE, MO 63385  
636.327.5101

**PROJECT TEAM**  
CIVIL ENGINEER  
PREMIER DESIGN GROUP  
100 MIDLAND PARK DRIVE  
WENTZVILLE, MO 63385  
314.925.7444  
MAINTENANCE CONSULTANT  
HDR ENGINEERING, INC.  
17725 KATY FREEWAY SUITE 102  
HOUSTON, TX 77054  
816.360.2700  
STRUCTURAL ENGINEER  
METTEMAYER ENGINEERING  
2225 W CHESTERFIELD BLVD., SUITE 300  
SPRINGFIELD, MO 65807  
417.890.8002  
MEP ENGINEER  
HENDERSON ENGINEERS, INC.  
8345 LENEXA DR., #300  
LENEXA, KS 66214  
913.742.5000



NO.	DESCRIPTION	DATE
1	ADD 02	01.25.23
2		
3		
PROJECT NO.: 19-040 DRAWN BY: NS  
DATE: 12.15.22 REVIEWED BY: HEI





01/24/2023

DOUGLAS M. EVERHART  
LICENSE # PE-2019007648

**PROJECT TITLE**  
CITY OF WENTZVILLE, MO PUBLIC  
WORKS FACILITY  
PROJECT ADDRESS:  
1295 INTERSTATE DRIVE  
WENTZVILLE, MO 63385


LIGHTING LEVEL 1 RCP - AREA B

E101B

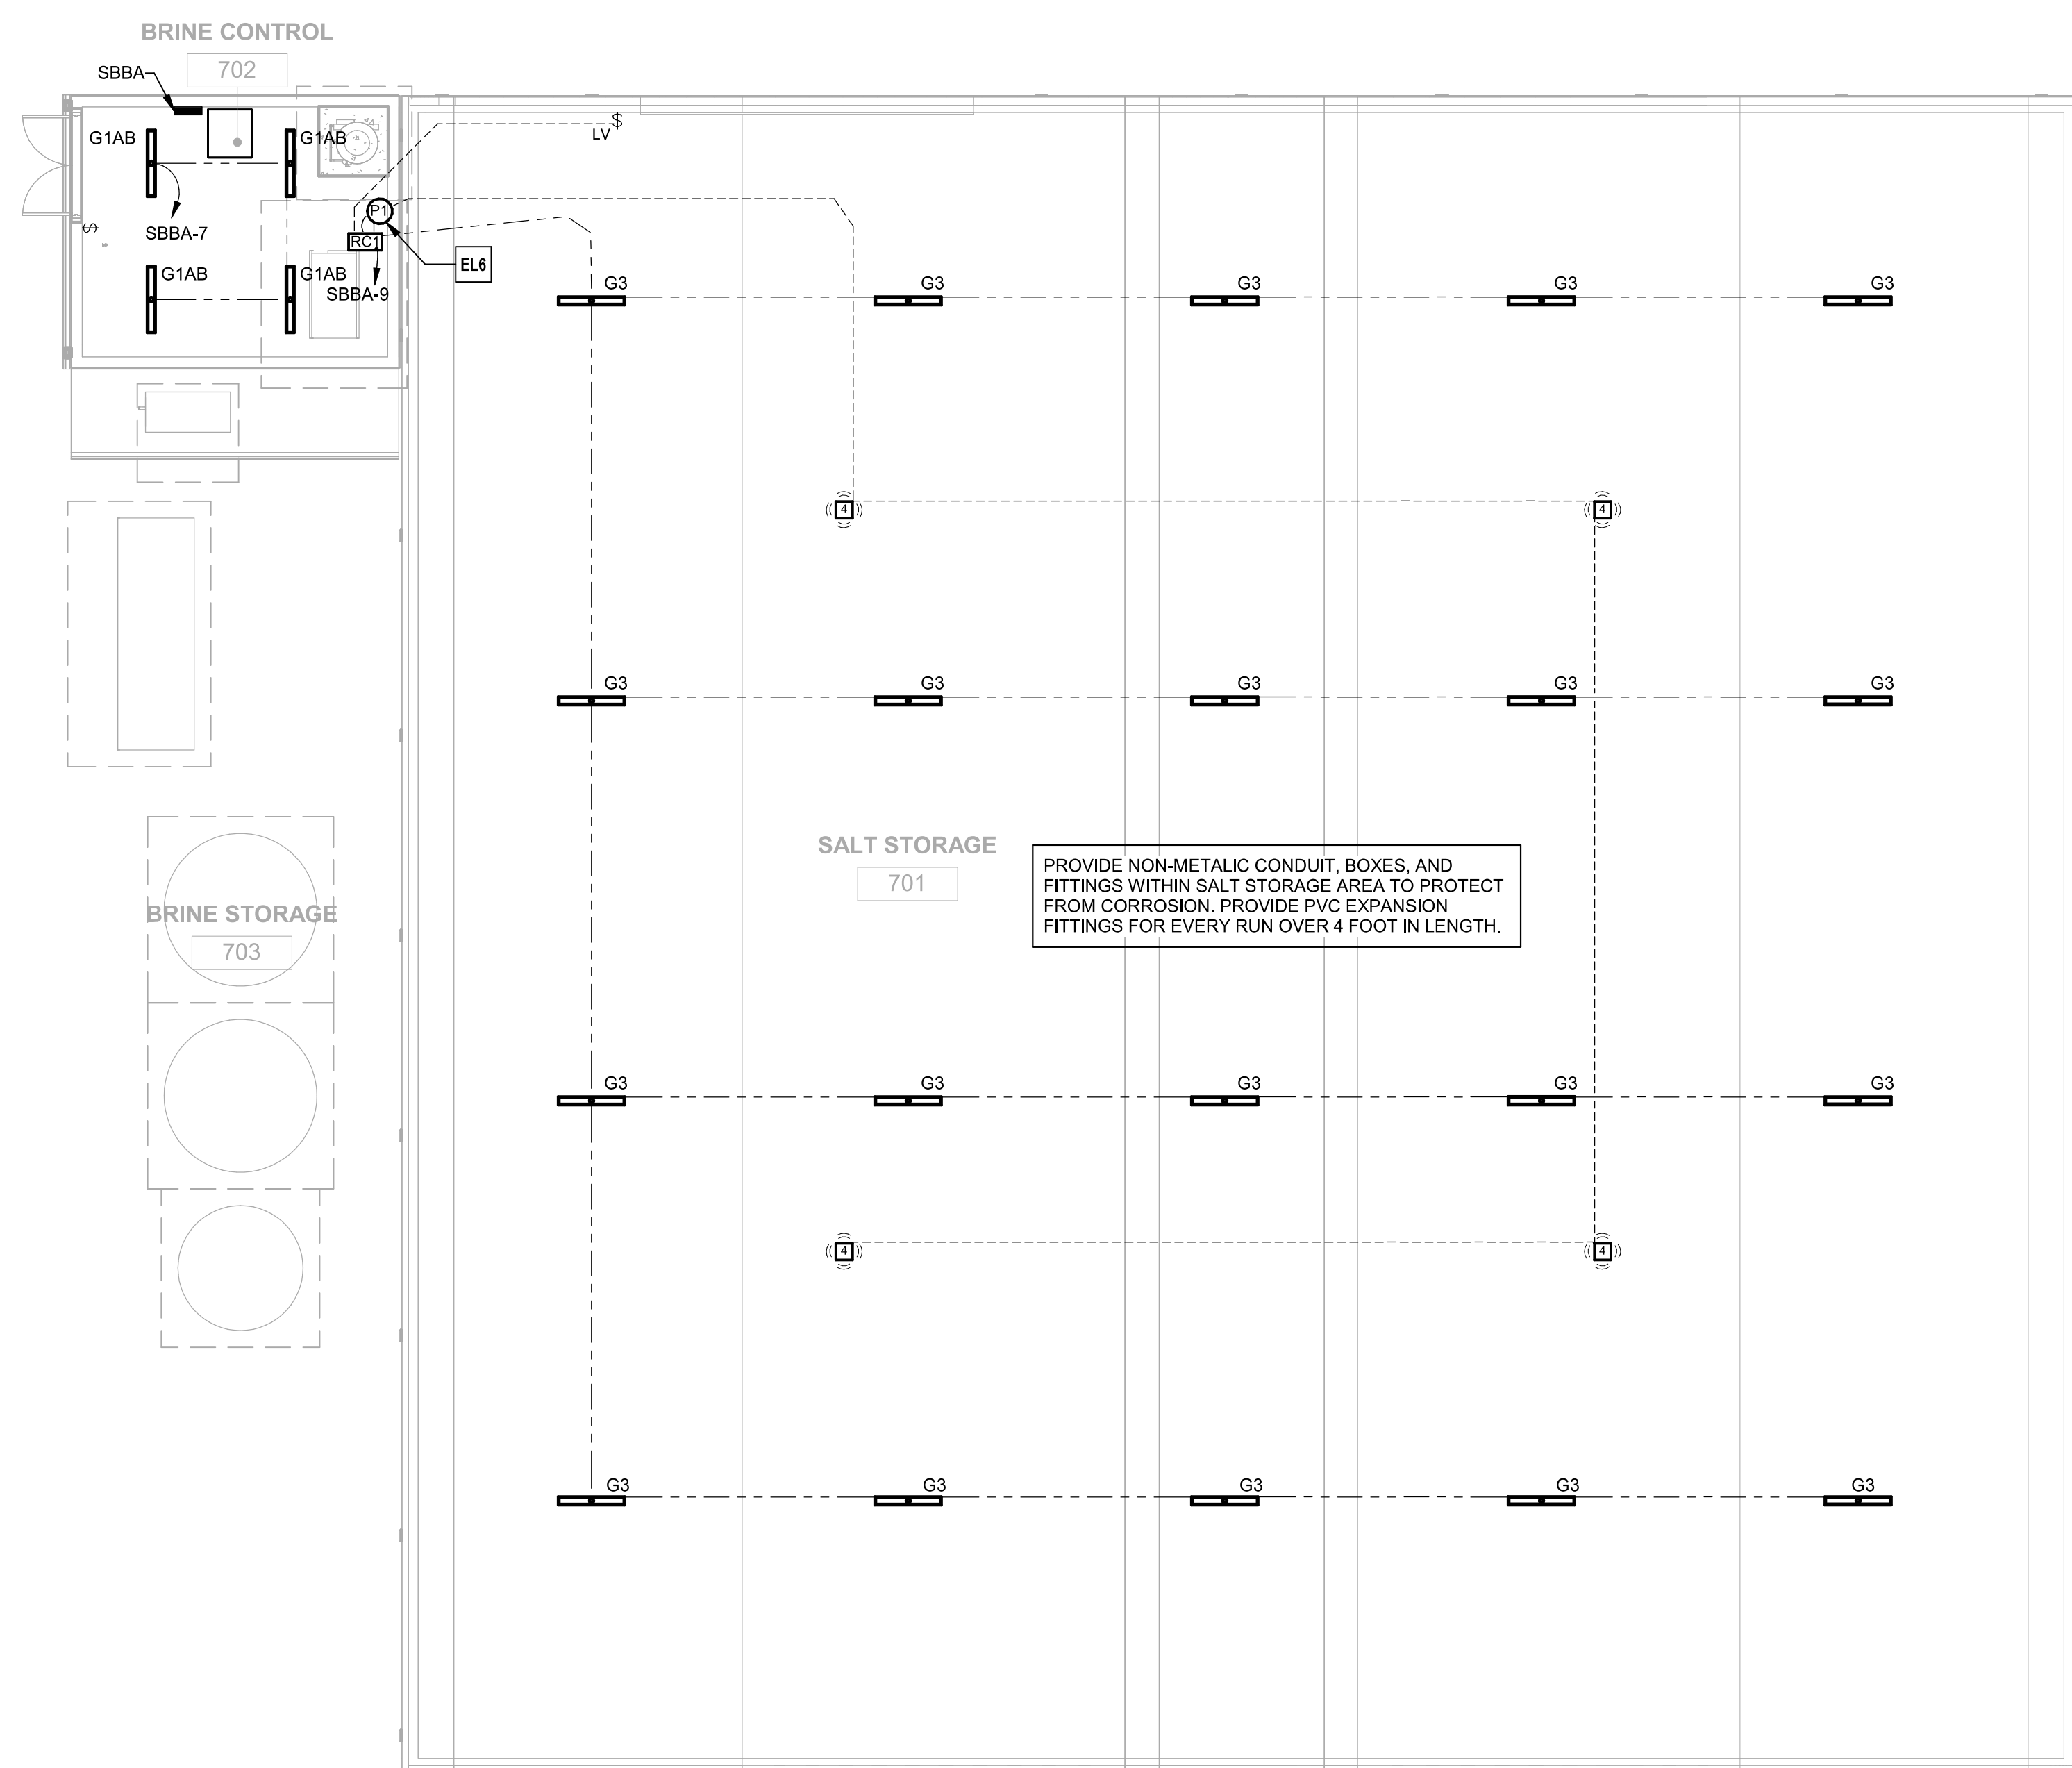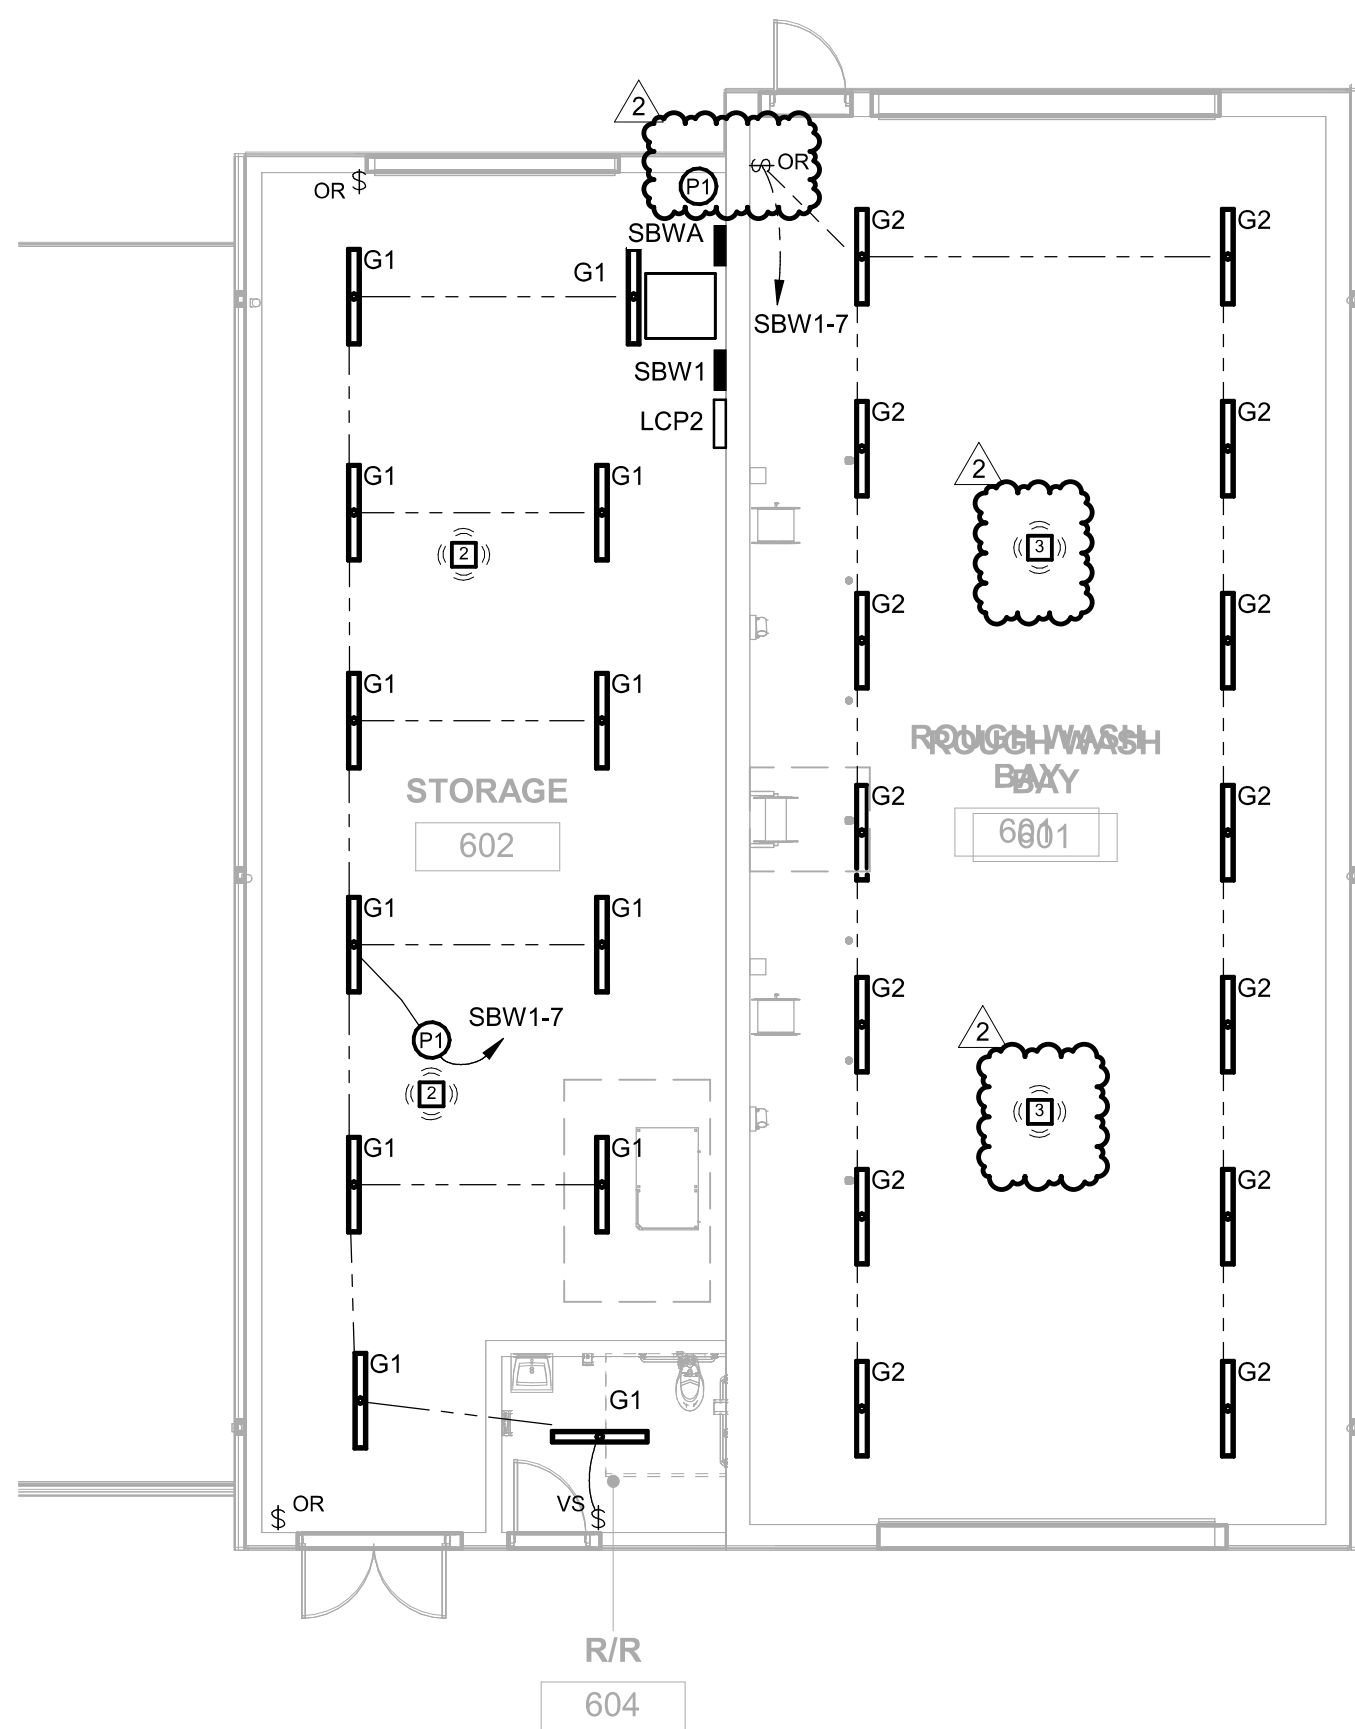

☐ **ELECTRICAL PLAN NOTES:**

 EL6 PROVIDE LOW VOLTAGE / DIGITAL INTERFACE TO INTEGRATE SIGNAL FROM LOW VOLTAGE DEVICES WITH ROOM LIGHTING CONTROLS, WATTSTOPPER LMIO-101.



# hdesigngroup

architecture + design

5039 S National Avenue | Springfield, MO 65810 | 417.887.6595

**OWNER**  
CITY OF WENTZVILLE, MISSOURI  
1001 SCHROEDER CREEK BLVD  
WENTZVILLE, MO 63385  
636.327.5101

## PROJECT TEAM

CIVIL ENGINEER  
PREMIER DESIGN GROUP  
100 MIDLAND PARK DRIVE  
WENTZVILLE, MO 63385  
314.925.7444  
.  
MAINTENANCE CONSULTANT  
HDR ENGINEERING, INC.  
17725 KATY FREEWAY SUITE 102  
HOUSTON, TX 77094  
816.360.2700

MAINTENANCE CONSULTANT  
HDR ENGINEERING, INC.  
17725 KATY FREEWAY SUITE 102  
HOUSTON, TX 77094  
816.360.2700

STRUCTURAL ENGINEER  
METTEMAYER ENGINEERING  
2225 W CHESTERFIELD BLVD., SUITE 300  
SPRINGFIELD, MO 65807  
417.890.8002

MEP ENGINEER  
HENDERSON ENGINEERS, INC.  
8345 LENEXA DR., #300  
LENEXA, KS 66214  
913.742.5000




8345 LENEXA DRIVE, SUITE 300  
LENEXA, KS 66214  
TEL 913.742.5000 FAX 913.742.5001  
**WWW.HENDERSONENGINEERS.COM**

1950004840  
EXPIRES 12/31/2023

## REVISIONS

[illegible]

PROJECT NO.: 19-040 DRAWN BY: Author  
DATE: 12.15.22 REVIEWED BY: Checker

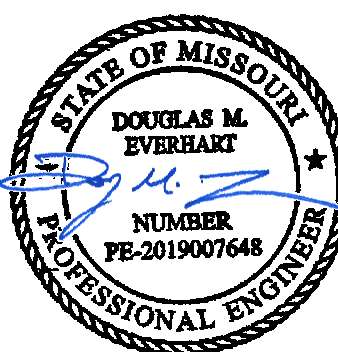

01/24/2023

DOUGLAS M. EVERHART  
LICENSE # PE-2019007648


PROJECT TITLE  
CITY OF WENTZVILLE, MO PUBLIC  
WORKS FACILITY

PROJECT ADDRESS:  
1295 INTERSTATE DRIVE  
WENTZVILLE, MO 63385

### LIGHTING LEVEL 1 RCP - WASH & SALT STORAGE BUILDINGS

# E102

① LIGHTING LEVEL 1 RCP - WASH AND SALT STORAGE BUILDINGS  
1/8" = 1'-0"

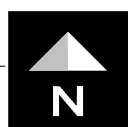


DOUGLAS M. EVERHART








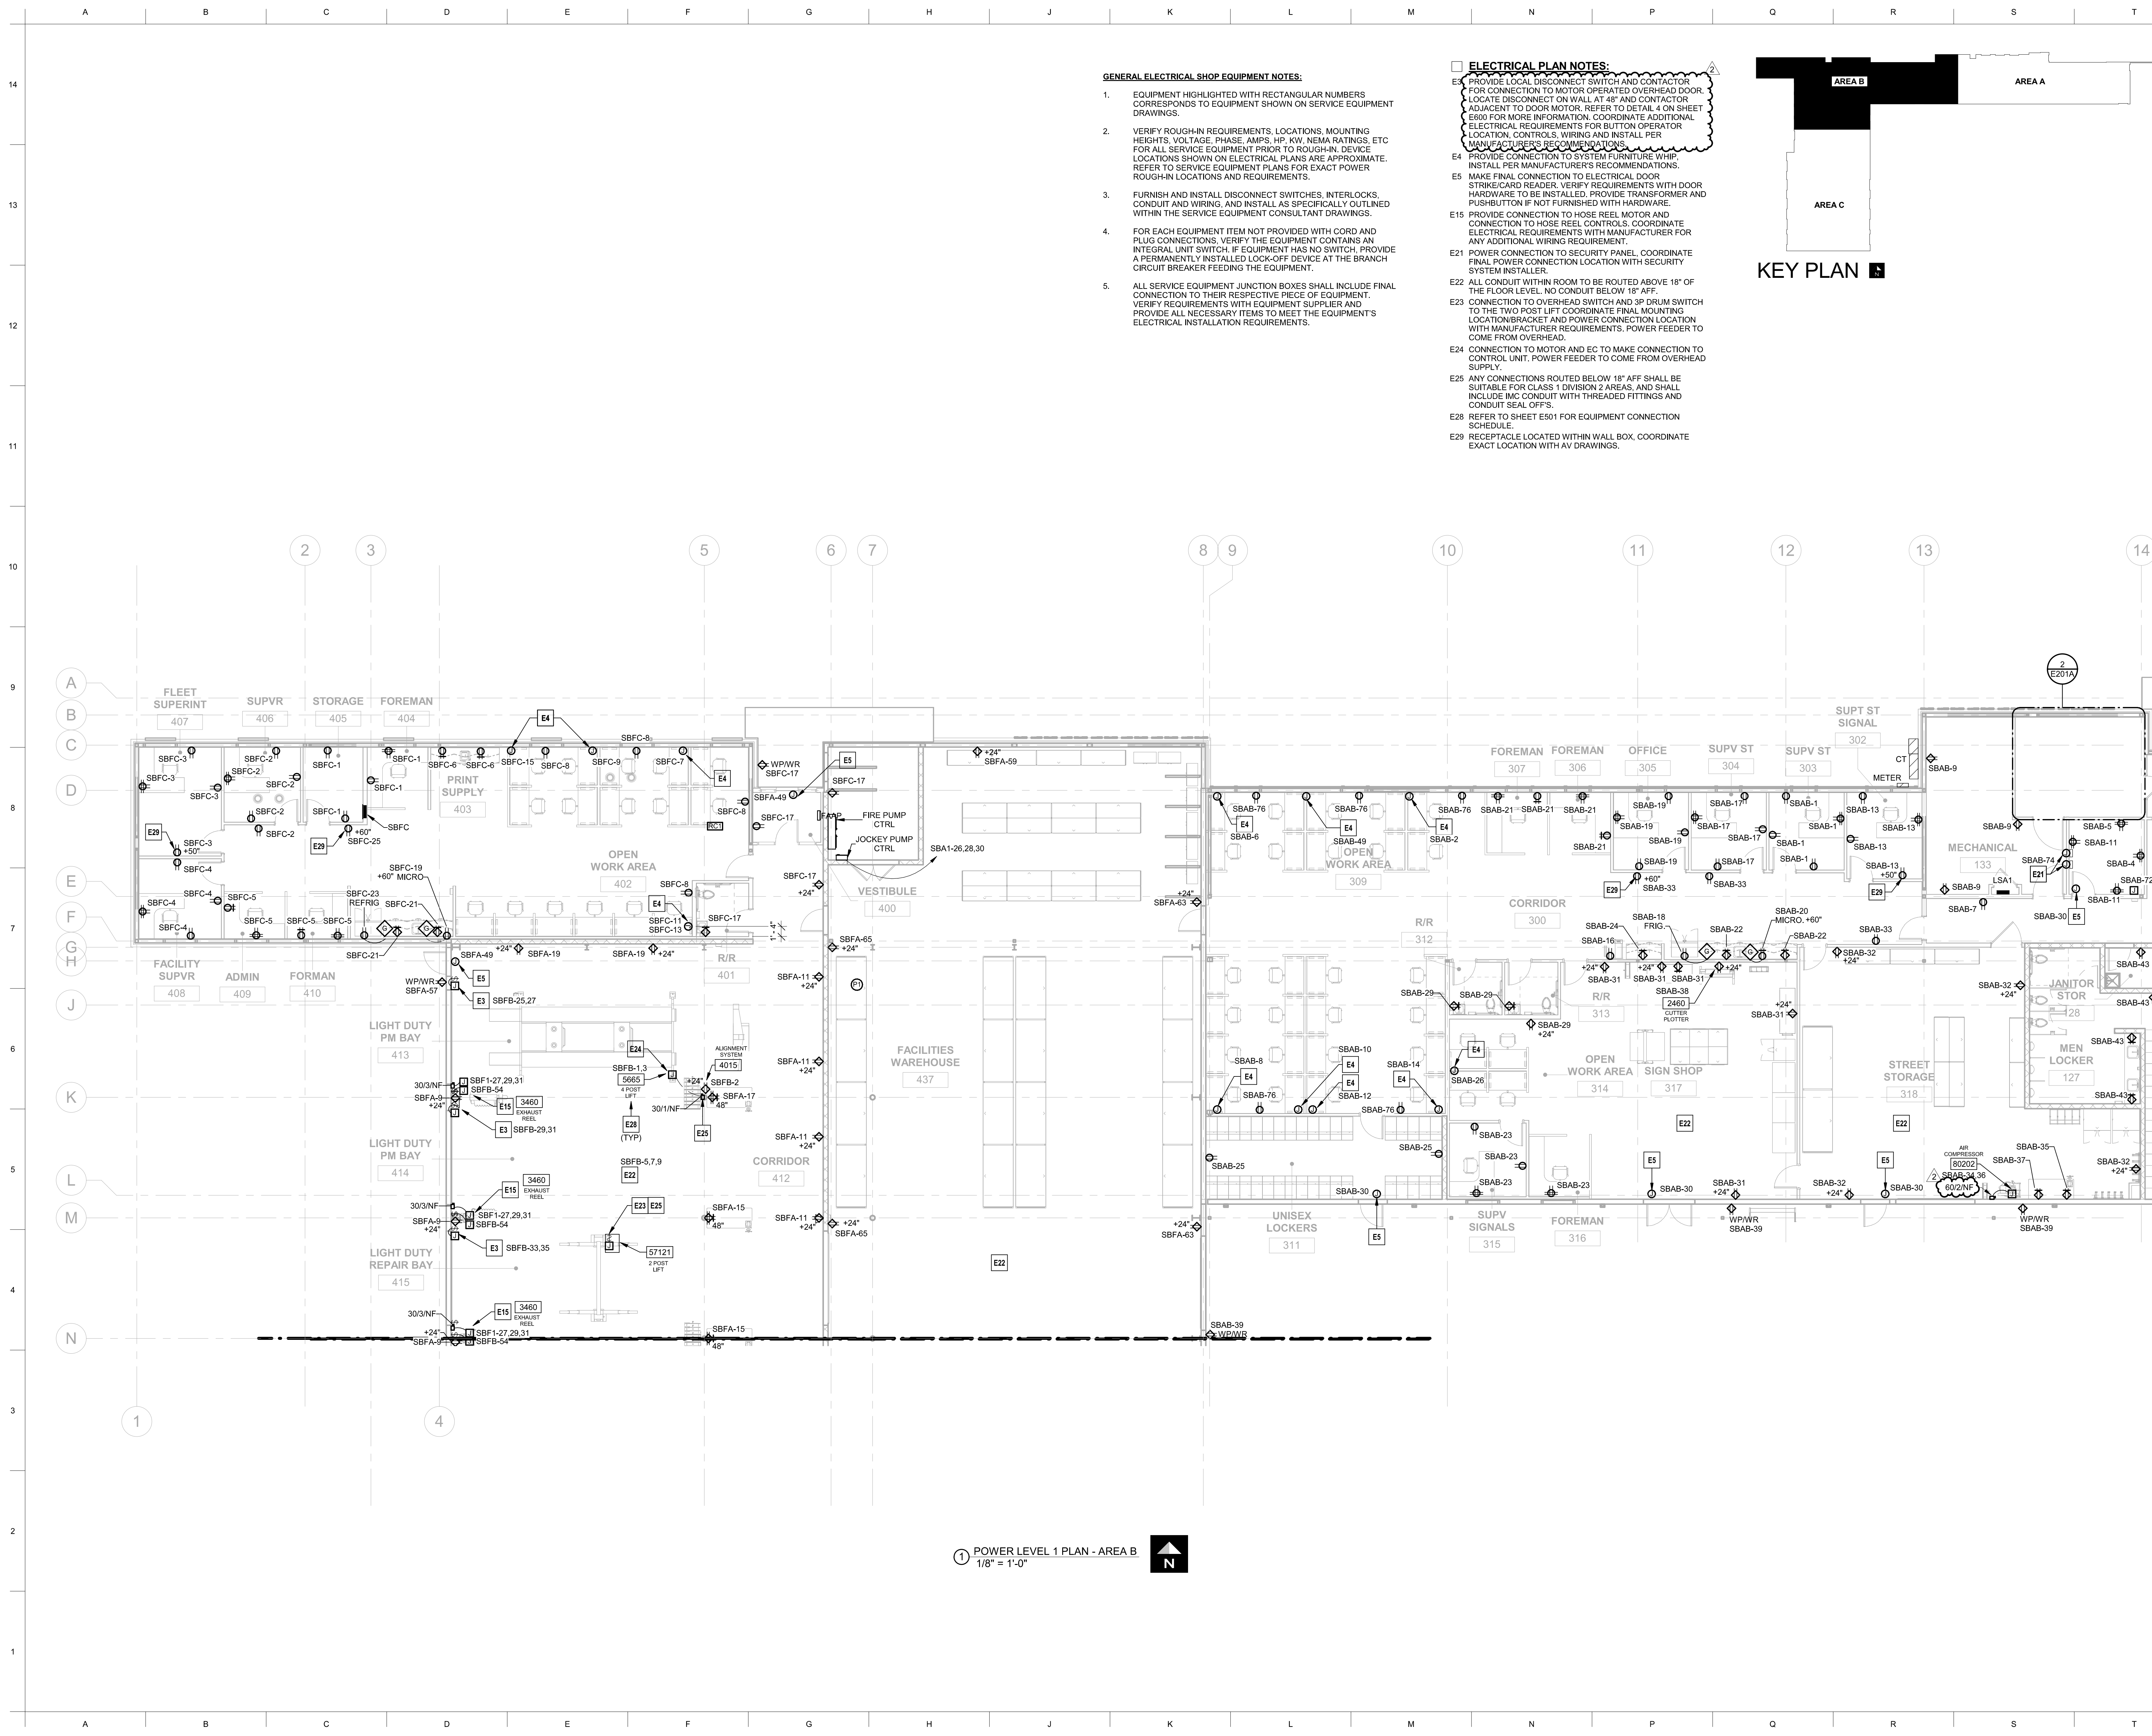

- GENERAL ELECTRICAL SHOP EQUIPMENT NOTES:**
- EQUIPMENT HIGHLIGHTED WITH RECTANGULAR NUMBERS CORRESPONDS TO EQUIPMENT SHOWN ON SERVICE EQUIPMENT DRAWINGS.
  - VERIFY ROUGH-IN REQUIREMENTS, LOCATIONS, MOUNTING HEIGHTS, VOLTAGE, PHASE, AMPS, HP, KW, NEMA RATINGS, ETC FOR ALL SERVICE EQUIPMENT PRIOR TO ROUGH-IN. DEVICE LOCATIONS SHOWN ON ELECTRICAL PLANS ARE APPROXIMATE. REFER TO SERVICE EQUIPMENT PLANS FOR EXACT POWER ROUGH-IN LOCATIONS AND REQUIREMENTS.
  - FURNISH AND INSTALL DISCONNECT SWITCHES, INTERLOCKS, CONDUIT AND WIRING, AND INSTALL AS SPECIFICALLY OUTLINED WITHIN THE SERVICE EQUIPMENT CONSULTANT DRAWINGS.
  - FOR EACH EQUIPMENT ITEM NOT PROVIDED WITH CORD AND PLUG CONNECTIONS, VERIFY THE EQUIPMENT CONTAINS AN INTEGRAL UNIT SWITCH. IF EQUIPMENT HAS NO SWITCH, PROVIDE A PERMANENTLY INSTALLED LOCK-OFF DEVICE AT THE BRANCH CIRCUIT BREAKER FEEDING THE EQUIPMENT.
  - ALL SERVICE EQUIPMENT JUNCTION BOXES SHALL INCLUDE FINAL CONNECTION TO THEIR RESPECTIVE PIECE OF EQUIPMENT. VERIFY REQUIREMENTS WITH EQUIPMENT SUPPLIER AND PROVIDE ALL NECESSARY ITEMS TO MEET THE EQUIPMENT'S ELECTRICAL INSTALLATION REQUIREMENTS.

- ELECTRICAL PLAN NOTES:**
- PROVIDE LOCAL DISCONNECT SWITCH AND CONTACTOR FOR CONNECTION TO MOTOR OPERATED OVERHEAD DOOR. LOCATE DISCONNECT ON WALL AT 48" AND CONTACTOR ADJACENT TO DOOR MOTOR. REFER TO DETAIL 4 ON SHEET E600 FOR MORE INFORMATION. COORDINATE ADDITIONAL ELECTRICAL REQUIREMENTS FOR BUTTON OPERATOR LOCATION, CONTROLS, WIRING AND INSTALL PER MANUFACTURER'S RECOMMENDATIONS.
  - PROVIDE CONNECTION TO SYSTEM FURNITURE WHIP. INSTALL PER MANUFACTURER'S RECOMMENDATIONS.
  - MAKE FINAL CONNECTION TO ELECTRICAL DOOR STRIKE/CARD READER. VERIFY REQUIREMENTS WITH DOOR HARDWARE TO BE INSTALLED. PROVIDE TRANSFORMER AND PUSHBUTTON IF NOT FURNISHED WITH HARDWARE.
  - PROVIDE CONNECTION TO HOSE REEL MOTOR AND CONNECTION TO HOSE REEL CONTROLS. COORDINATE ELECTRICAL REQUIREMENTS WITH MANUFACTURER FOR ANY ADDITIONAL WIRING REQUIREMENT.
  - POWER CONNECTION TO SECURITY PANEL. COORDINATE FINAL POWER CONNECTION LOCATION WITH SECURITY SYSTEM INSTALLER.
  - ALL CONDUIT WITHIN ROOM TO BE ROUTED ABOVE 18" OF THE FLOOR LEVEL. NO CONDUIT BELOW 18" AFF.
  - CONNECTION TO OVERHEAD SWITCH AND 3P DRUM SWITCH TO THE TWO POST LIFT COORDINATE FINAL MOUNTING LOCATION/BRAKET AND POWER CONNECTION LOCATION WITH MANUFACTURER REQUIREMENTS. POWER FEEDER TO COME FROM OVERHEAD.
  - CONNECTION TO MOTOR AND EC TO MAKE CONNECTION TO CONTROL UNIT. POWER FEEDER TO COME FROM OVERHEAD SUPPLY.
  - ANY CONNECTIONS ROUTED BELOW 18" AFF SHALL BE SUITABLE FOR CLASS 1 DIVISION 2 AREAS, AND SHALL INCLUDE IMC CONDUIT WITH THREADED FITTINGS AND CONDUIT SEAL OFF'S.
  - REFER TO SHEET E501 FOR EQUIPMENT CONNECTION SCHEDULE.
  - RECEPTACLE LOCATED WITHIN WALL BOX, COORDINATE EXACT LOCATION WITH AV DRAWINGS.

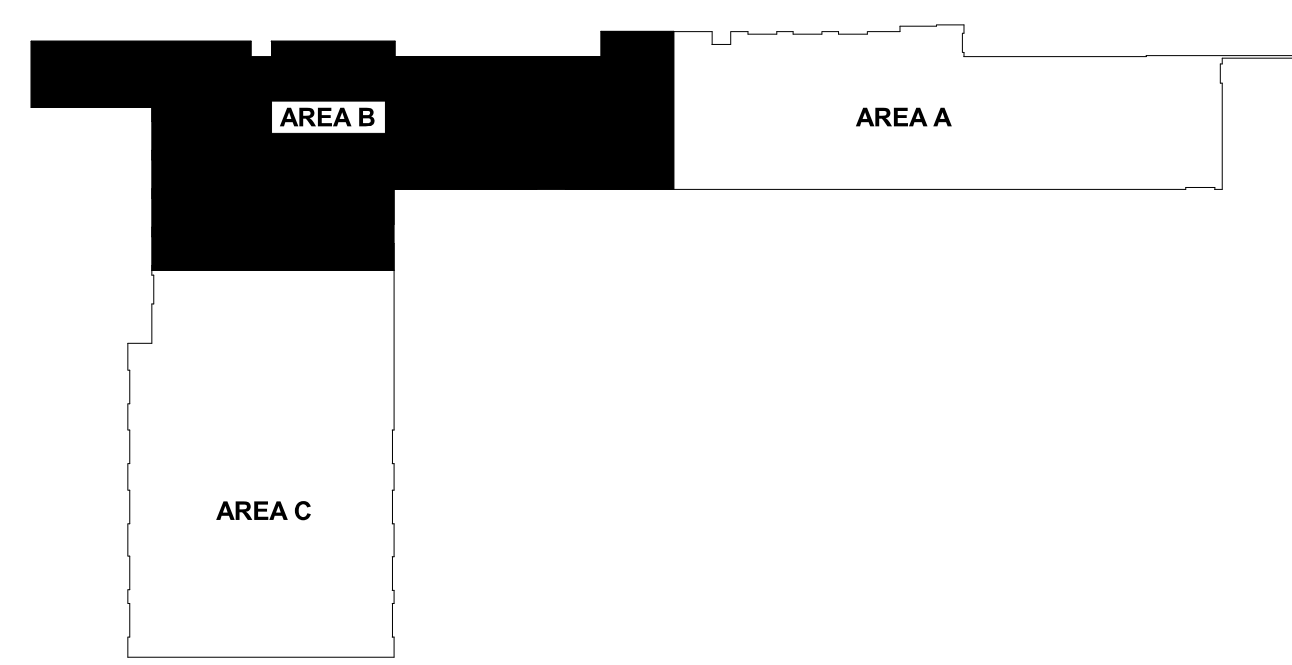

KEY PLAN

POWER LEVEL 1 PLAN - AREA B  
1/8" = 1'-0"




**OWNER**  
**CITY OF WENTZVILLE, MISSOURI**  
1001 SCHROEDER CREEK BLVD  
WENTZVILLE, MO 63385  
636.327.5101

**PROJECT TEAM**  
**CIVIL ENGINEER**  
PREMIER DESIGN GROUP  
100 MIDLAND PARK DRIVE  
WENTZVILLE, MO 63385  
314.925.7444  
**MAINTENANCE CONSULTANT**  
HDR ENGINEERING, INC.  
17725 KATY FREEWAY SUITE 102  
HOUSTON, TX 77054  
816.360.2700  
**STRUCTURAL ENGINEER**  
METTEMAYER ENGINEERING  
2225 W CHESTERFIELD BLVD., SUITE 300  
SPRINGFIELD, MO 65807  
417.890.8002  
**MEP ENGINEER**  
HENDERSON ENGINEERS, INC.  
8345 LENEKA DR., #300  
LENEKA, KS 66214  
913.742.5000

**HENDERSON ENGINEERS**  
8345 LENEKA DRIVE, SUITE 300  
LENEKA, KS 66214  
TEL 913.742.5000 FAX 913.742.5001  
WWW.HENDERSONENGINEERS.COM  
1950004840  
EXPIRES 12/31/2023

NO.	DESCRIPTION	DATE
2	ADD 02	01.25.23

PROJECT NO.: 19-040 DRAWN BY: NS  
DATE: 12.15.22 REVIEWED BY: HEI

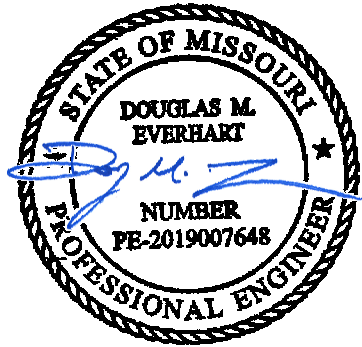


01/24/2023

DOUGLAS M. EVERHART  
LICENSE # PE-2019007648

**PROJECT TITLE**  
**CITY OF WENTZVILLE, MO PUBLIC WORKS FACILITY**  
**PROJECT ADDRESS:**  
1295 INTERSTATE DRIVE  
WENTZVILLE, MO 63385

POWER LEVEL 1 PLAN - AREA B



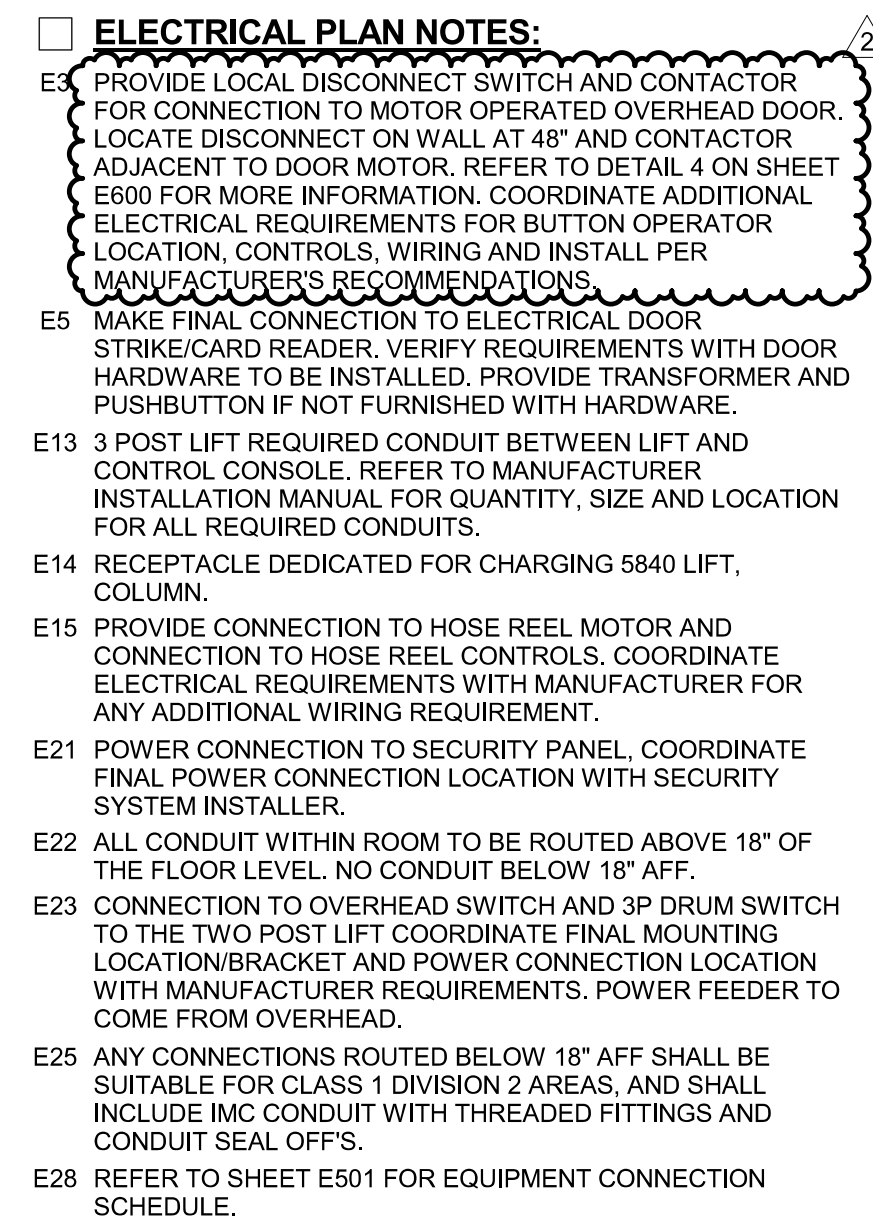

KEY PLAN 



5039 S National Avenue | Springfield, MO 65810 | 417.887.6595

**OWNER**  
CITY OF WENTZVILLE, MISSOURI  
1001 SCHROEDER CREEK BLVD  
WENTZVILLE, MO 63385  
636.327.5101

## PROJECT TEAM

CIVIL ENGINEER  
PREMIER DESIGN GROUP  
100 MIDLAND PARK DRIVE  
WENTZVILLE, MO 63385  
314.925.7444

MAINTENANCE CONSULTANT  
HDR ENGINEERING, INC.  
17725 KATY FREEWAY SUITE 100  
HOUSTON, TX 77094  
816.360.2700

STRUCTURAL ENGINEER  
METTEMAYER ENGINEERING  
2225 W CHESTERFIELD BLVD., SUITE 300  
SPRINGFIELD, MO 65807  
417.890.8002

MEP ENGINEER  
HENDERSON ENGINEERS, INC.  
8345 LENEXA DR., #300  
LENEXA, KS 66214  
913.742.5000




8345 LENEXA DRIVE, SUITE 300  
LENEXA, KS 66214  
TEL 913.742.5000 FAX 913.742.5001  
**WWW.HENDERSONENGINEERS.COM**  
1950004840  
EXPIRES 12/31/2023

## REVISIONS

[illegible]

PROJECT NO.: 19-040 DRAWN BY: N  
DATE: 12.15.22 REVIEWED BY: HI

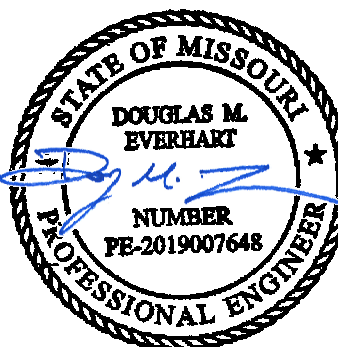

01/24/2023

DOUGLAS M. EVERHART  
LICENSE # PE-2019007648

PROJECT TITLE  
CITY OF WENTZVILLE, MO PUBLIC  
WORKS FACILITY

PROJECT ADDRESS:  
1295 INTERSTATE DRIVE  
WENTZVILLE, MO 63385

POWER LEVEL 1 PLAN - AREA C


① POWER LEVEL 1 PLAN - AREA C  
1/8" = 1'-0"



E201C





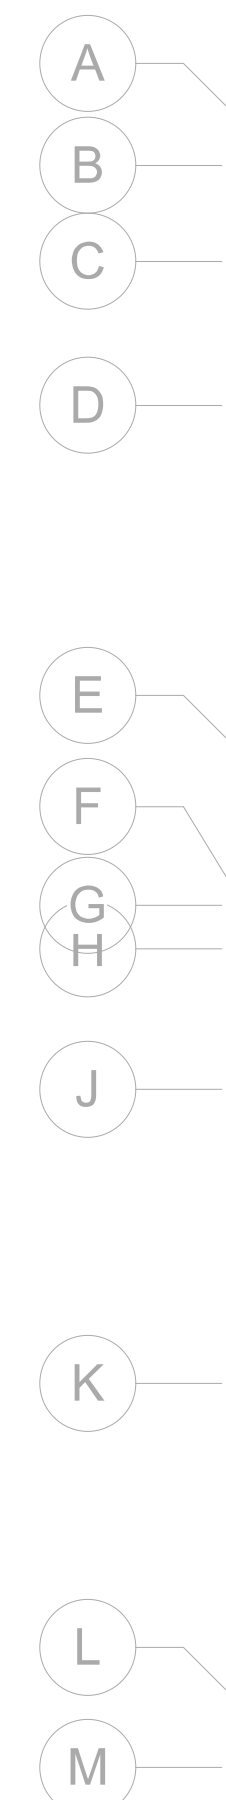

E16 EC TO PROVIDE DISCONNECT MOUNTED ON SIDE OF EQUIPMENT.

E17 DISCONNECT IS PROVIDED INTEGRAL WITH THE UNIT.



E32 PROVIDE CARLTON SC200DV DUAL VOLTAGE TWO-GANG SQUARE JUNCTION BOX AT 96" AFF AND INSTALL NUTONE BLK342L CHIME KIT. BOTH CHIMES SHALL RING WITH PUSH BUTTON IN CORRIDOR 105.

E33 PROVIDE LOW VOLTAGE CONNECTION FROM CHIME TO PUSH BUTTON PER MANUFACTURER'S RECOMMENDATIONS. COORDINATE EXACT LOCATION OF PUSH BUTTON WITH ARCHITECT PRIOR TO ROUGH-IN.



1 SHEET




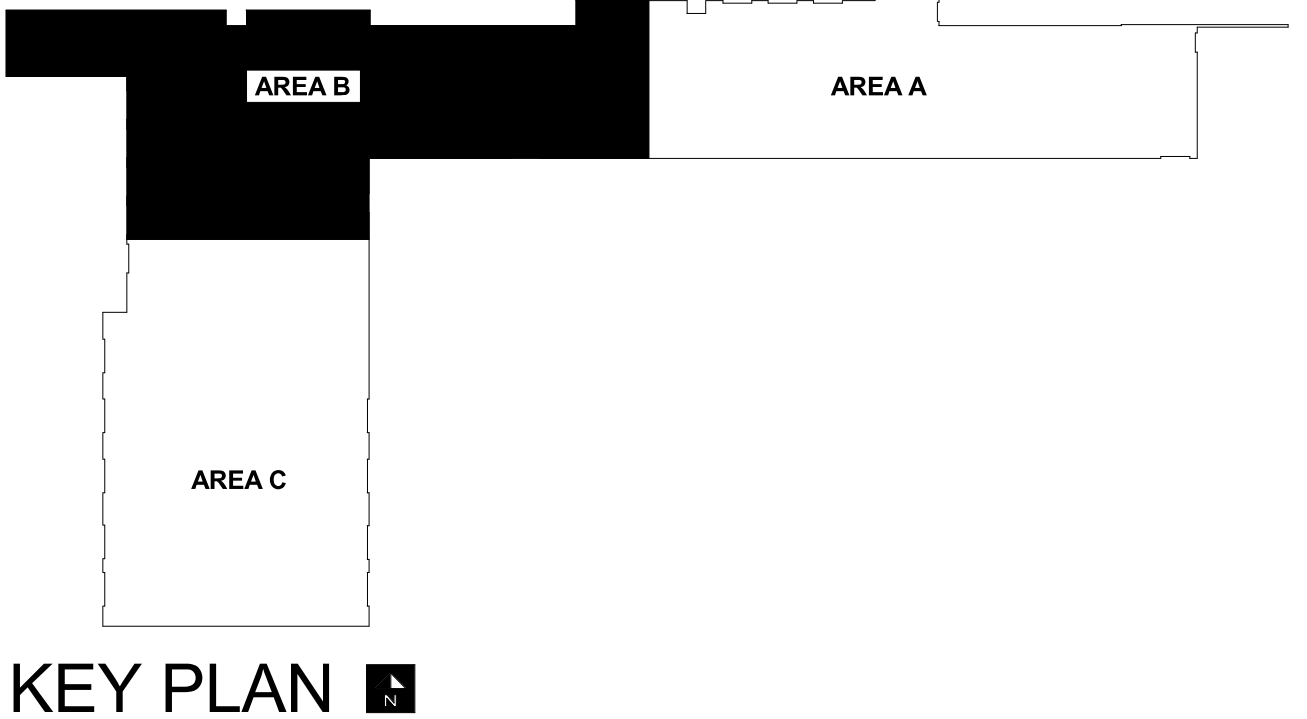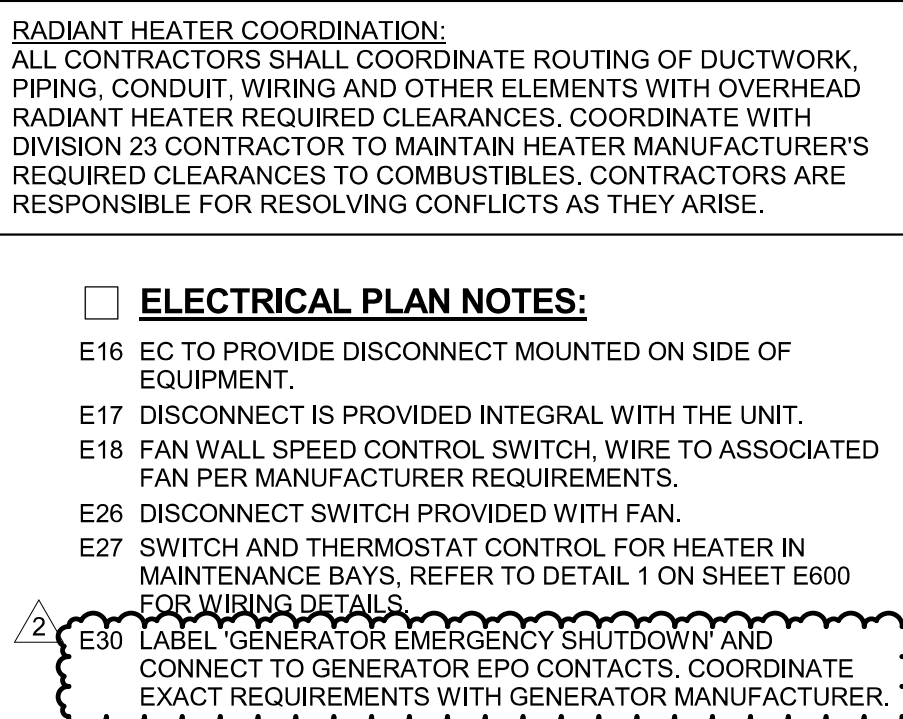



## PROJECT TEAM

MEP ENGINEER  
HENDERSON ENGINEERS, INC.  
8345 LENEXA DR., #300  
LENEXA, KS 66214  
913.742.5000

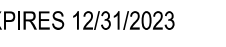[illegible]


PROJECT NO.: 19-040 DRAWN BY: NS  
DATE: 12.15.22 REVIEWED BY: HEI



PROJECT ADDRESS:  
1295 INTERSTATE DRIVE  
WENTZVILLE, MO 63385

SHEET

SHEET  
E301C

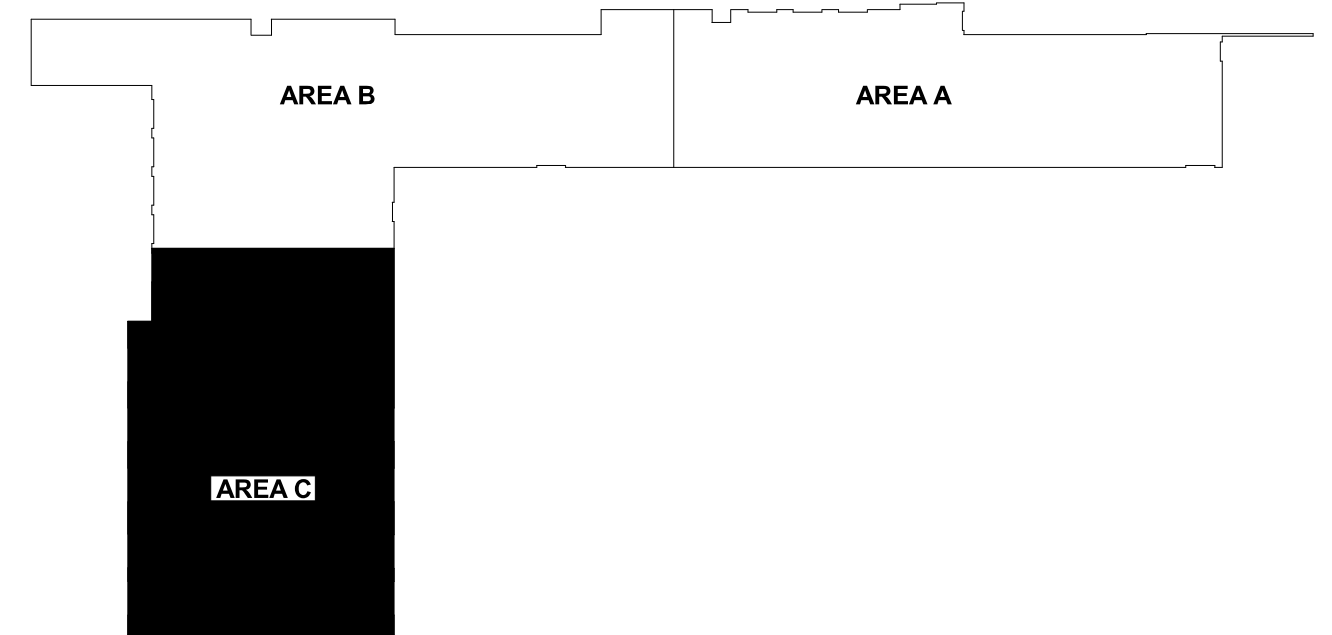


**RADIANT HEATER COORDINATION:**  
ALL CONTRACTORS SHALL COORDINATE ROUTING OF DUCTWORK, PIPING, CONDUIT, WIRING AND OTHER ELEMENTS WITH OVERHEAD RADIANT HEATER REQUIRED CLEARANCES. COORDINATE WITH DIVISION 23 CONTRACTOR TO MAINTAIN HEATER MANUFACTURER'S REQUIRED CLEARANCES TO COMBUSTIBLES. CONTRACTORS ARE RESPONSIBLE FOR RESOLVING CONFLICTS AS THEY ARISE.

☐ **ELECTRICAL PLAN NOTES:**

E16 EC TO PROVIDE DISCONNECT MOUNTED ON SIDE OF EQUIPMENT.

E18 FAN WALL SPEED CONTROL SWITCH, WIRE TO ASSOCIATED FAN PER MANUFACTURER REQUIREMENTS.

E26 DISCONNECT SWITCH PROVIDED WITH FAN.

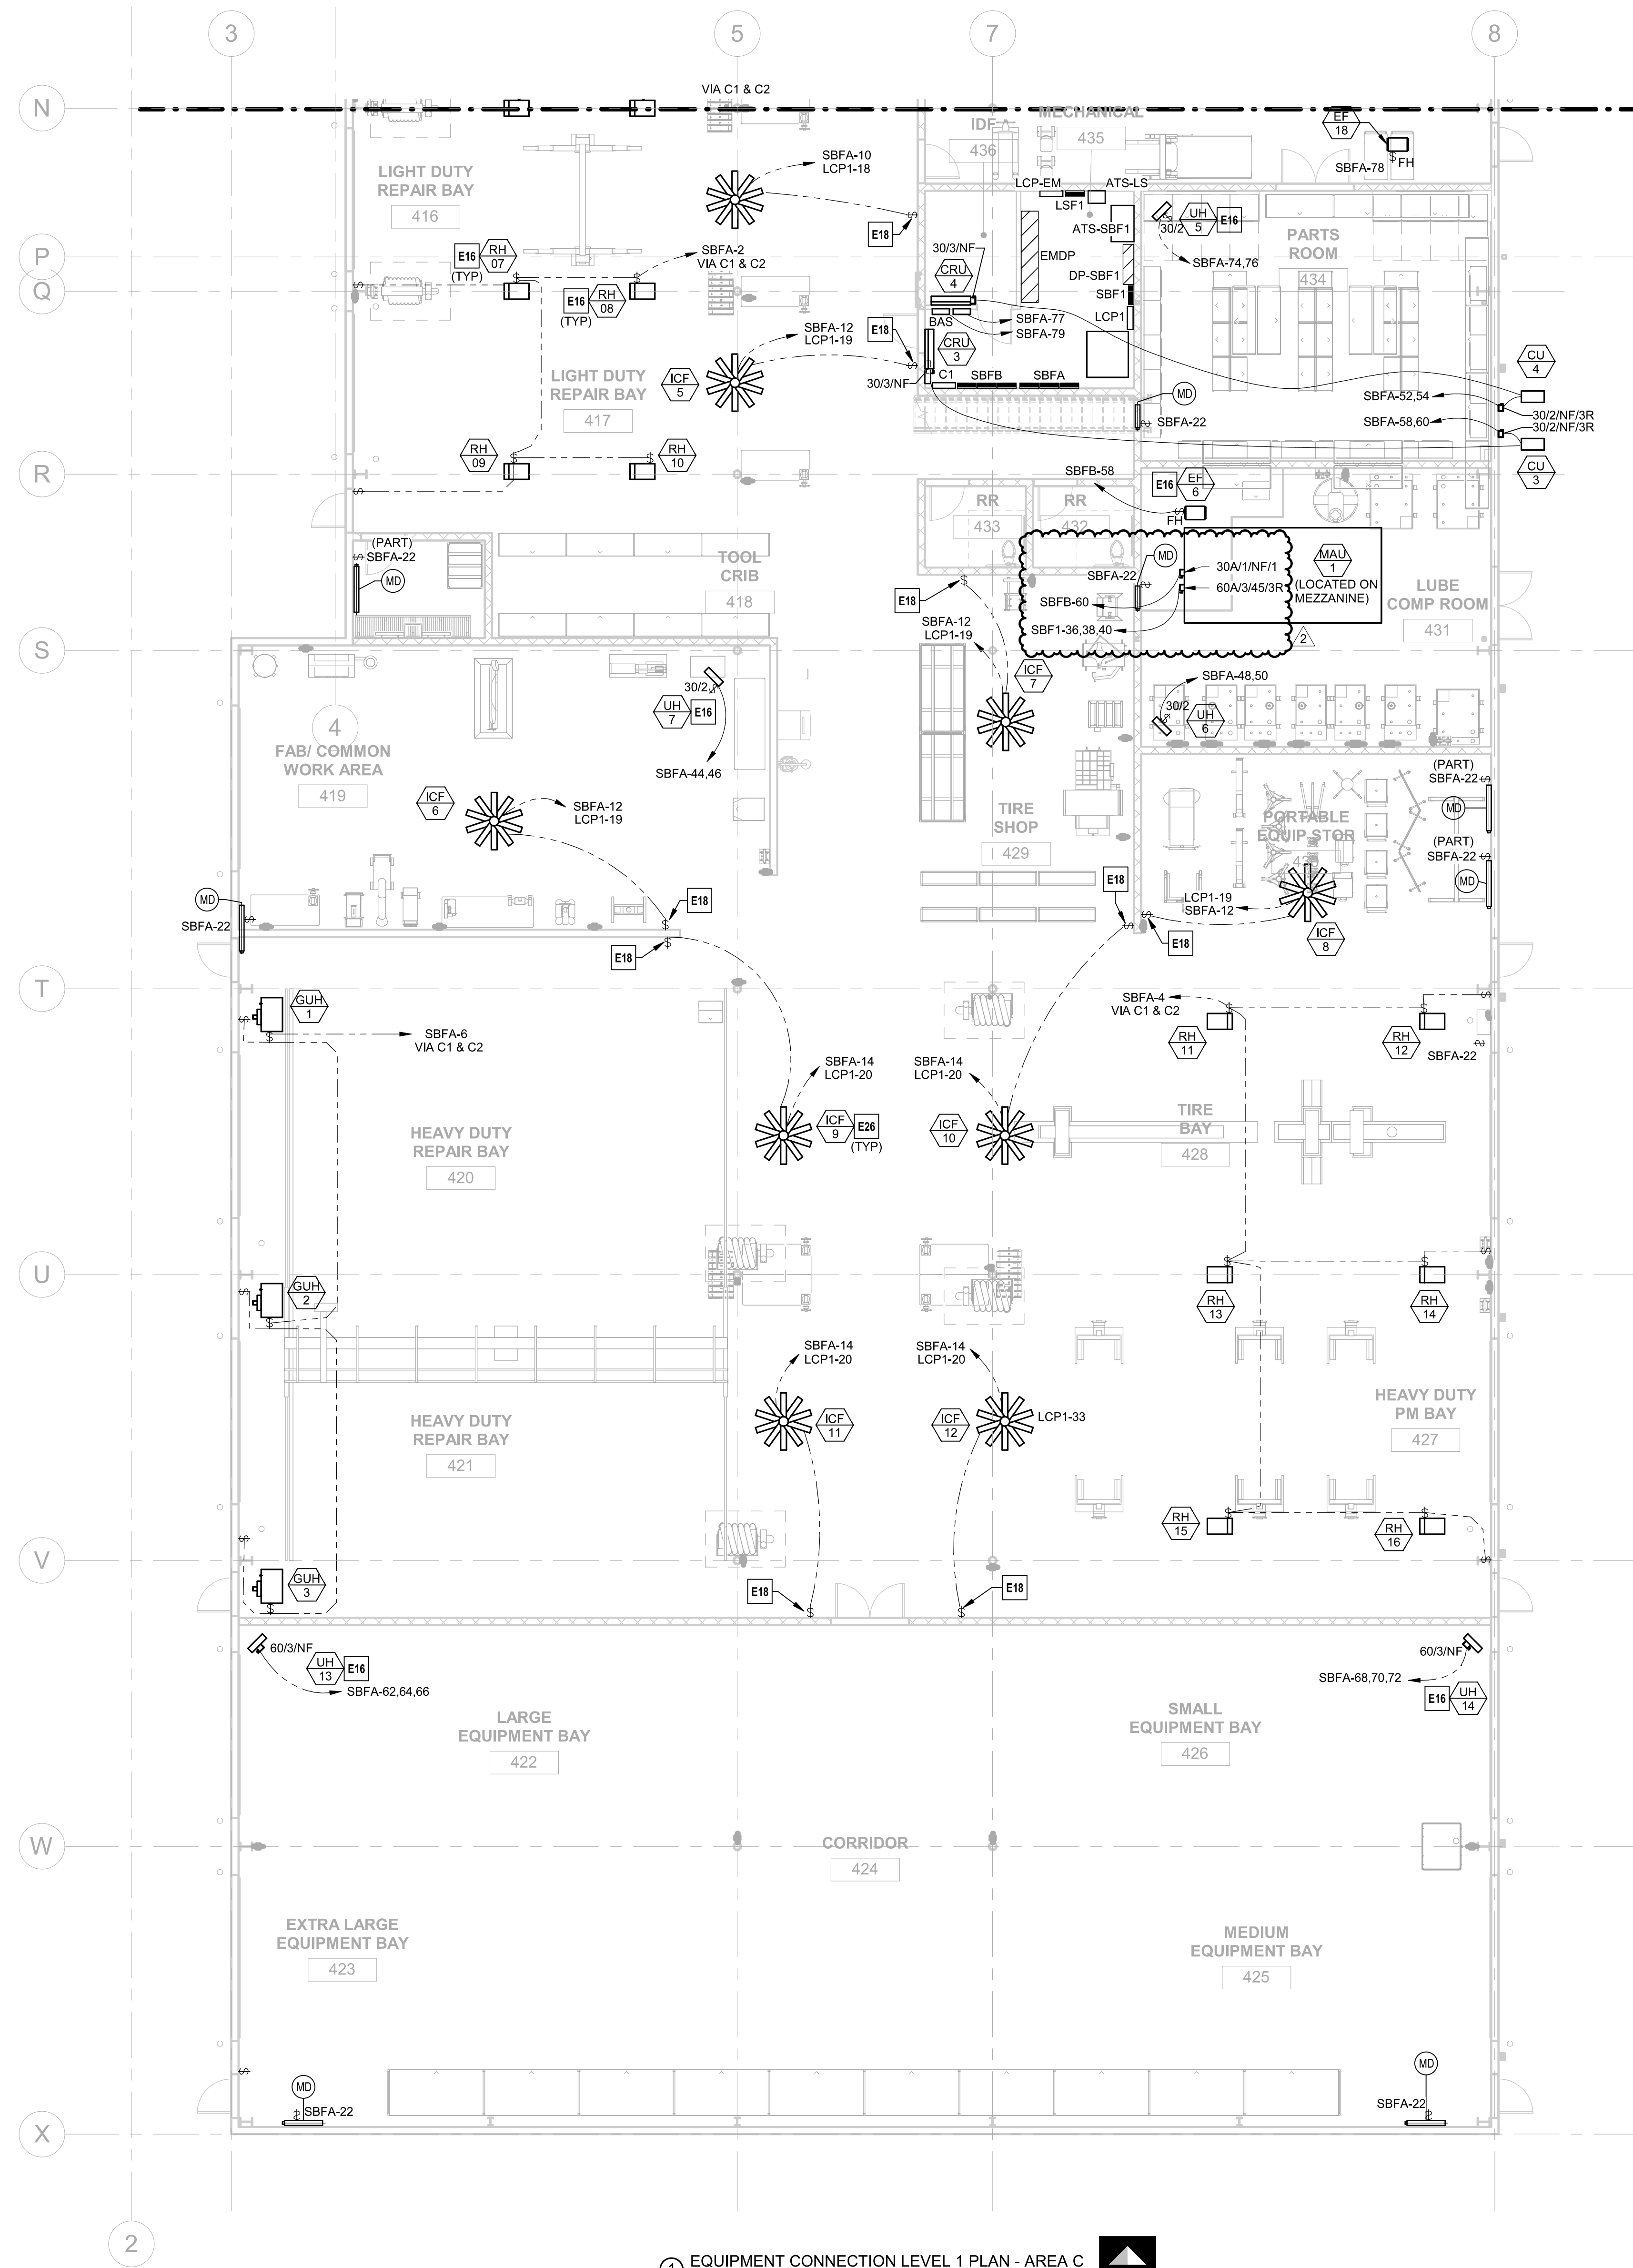


① EQUIPMENT CONNECTION LEVEL 1 PLAN - AREA C  
1/8" = 1'-0"








DOUGLAS M. EVERHART

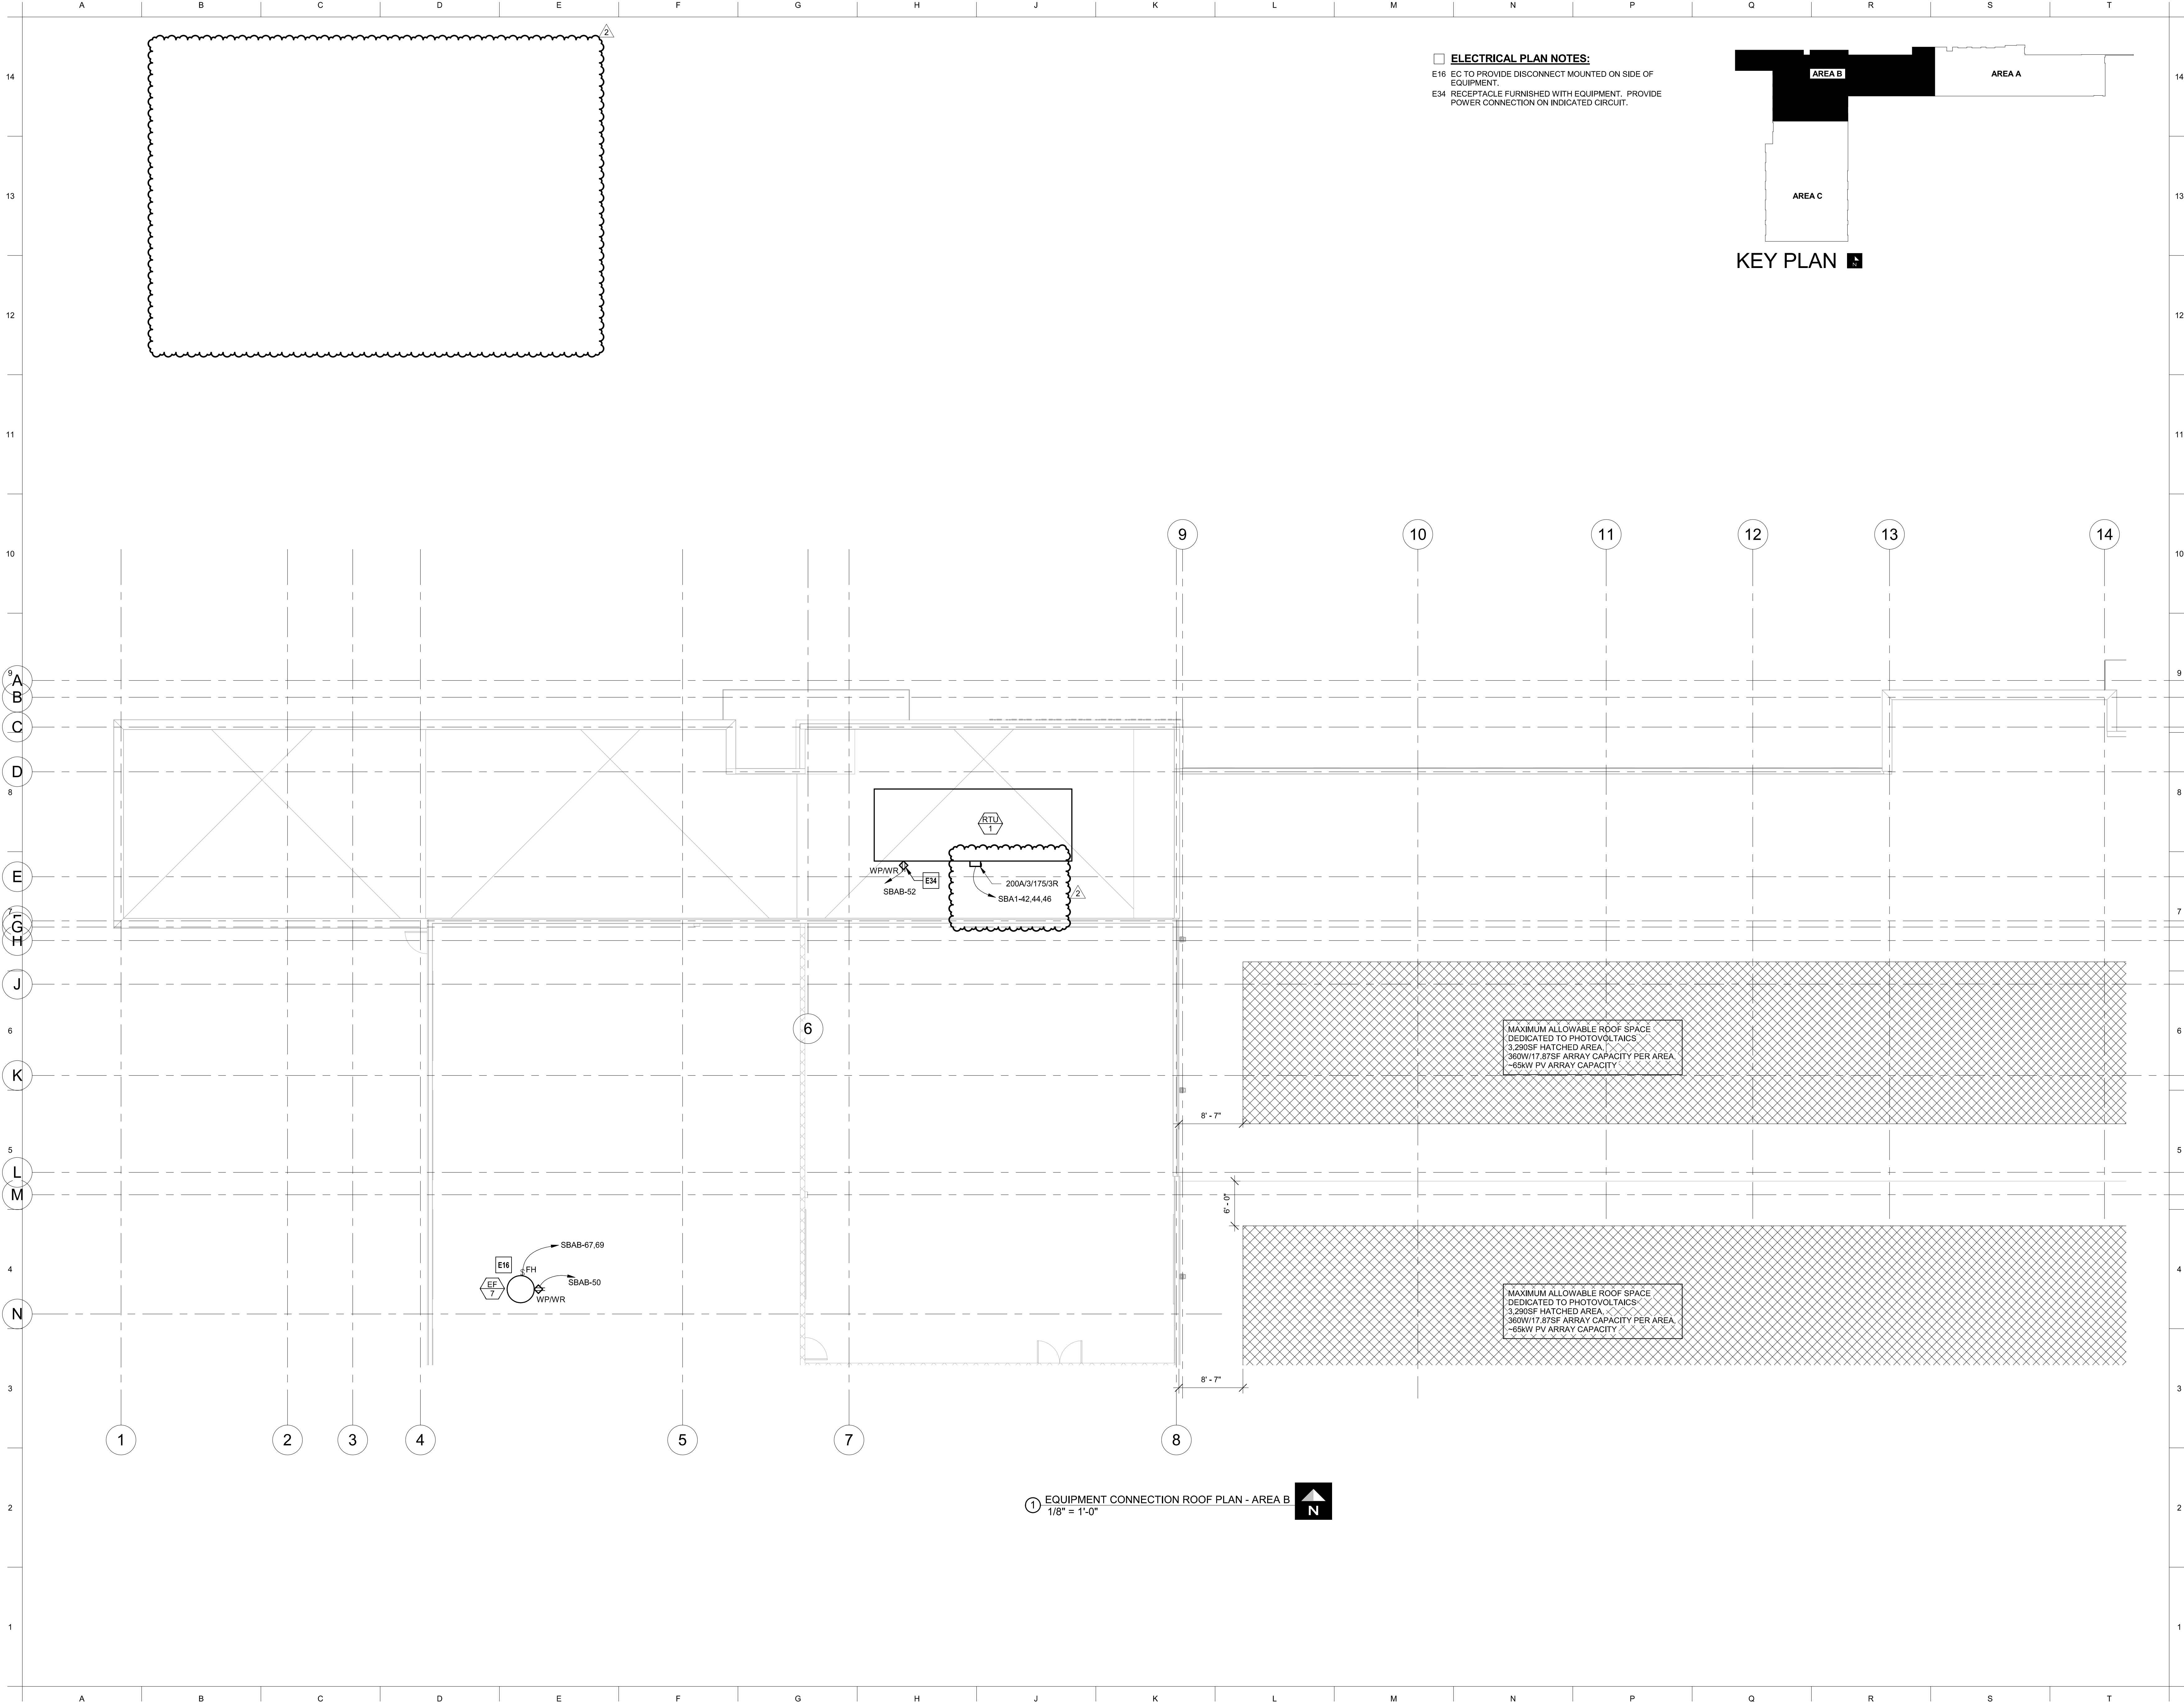

**ELECTRICAL PLAN NOTES:**  
E16 EC TO PROVIDE DISCONNECT MOUNTED ON SIDE OF EQUIPMENT.  
E34 RECEPTACLE FURNISHED WITH EQUIPMENT. PROVIDE POWER CONNECTION ON INDICATED CIRCUIT.

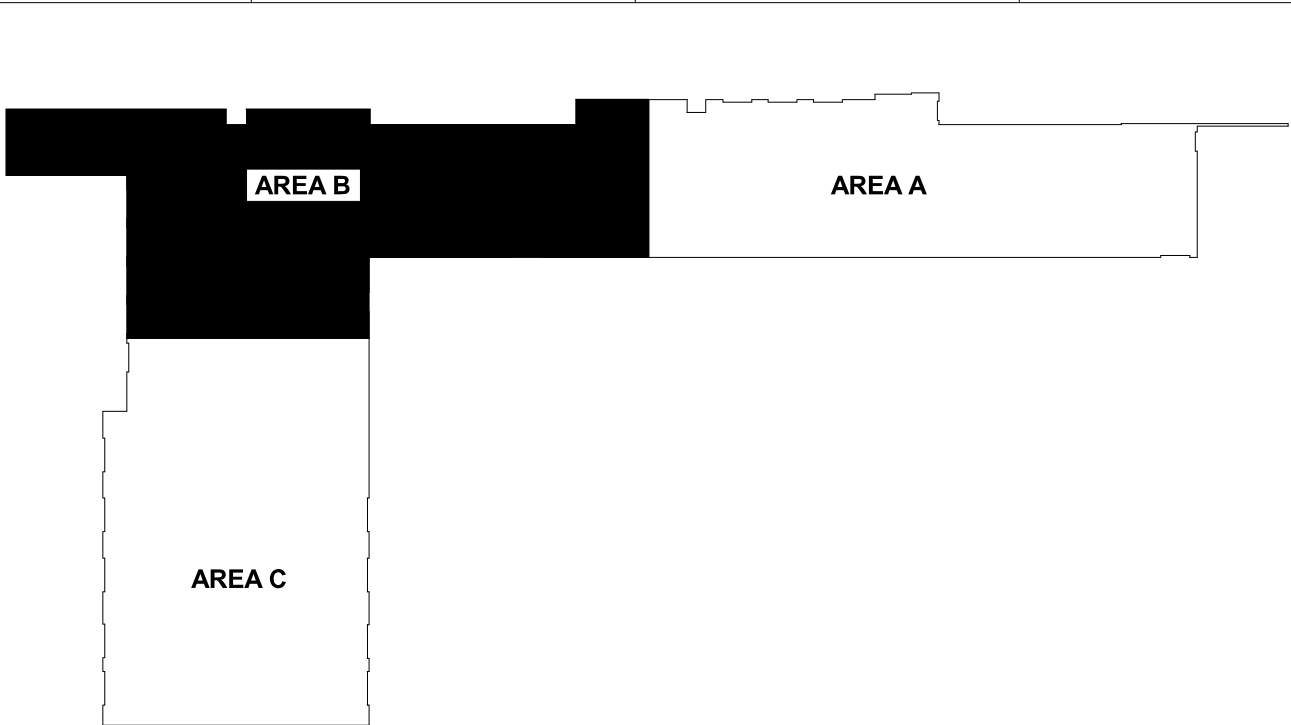

KEY PLAN



5039 S National Avenue | Springfield, MO 65810 | 417.887.6595

**OWNER**  
CITY OF WENTZVILLE, MISSOURI  
1001 SCHROEDER CREEK BLVD  
WENTZVILLE, MO 63385  
636.327.5101

**PROJECT TEAM**  
**CIVIL ENGINEER**  
PREMIER DESIGN GROUP  
100 MIDLAND PARK DRIVE  
WENTZVILLE, MO 63385  
314.925.7444  
**MAINTENANCE CONSULTANT**  
HDR ENGINEERING, INC.  
17725 KATY FREEWAY SUITE 102  
HOUSTON, TX 77054  
816.360.2700  
**STRUCTURAL ENGINEER**  
METTEMAYER ENGINEERING  
2225 W CHESTERFIELD BLVD., SUITE 300  
SPRINGFIELD, MO 65807  
417.890.8002  
**MEP ENGINEER**  
HENDERSON ENGINEERS, INC.  
8345 LENEKA DR., #300  
LENEKA, KS 66214  
913.742.5000  
.  
.

**HENDERSON ENGINEERS**  
8345 LENEKA DRIVE, SUITE 300  
LENEKA, KS 66214  
TEL 913.742.5000 FAX 913.742.5001  
WWW.HENDERSONENGINEERS.COM  
1950004840  
EXPIRES 12/31/2023

NO.	DESCRIPTION	DATE
2	ADD 02	01.25.23

PROJECT NO.: 19-040 DRAWN BY: NS  
DATE: 12.15.22 REVIEWED BY: HEI



01/24/2023

DOUGLAS M. EVERHART  
LICENSE # PE-2019007648

**PROJECT TITLE**  
CITY OF WENTZVILLE, MO PUBLIC  
WORKS FACILITY

**PROJECT ADDRESS:**  
1295 INTERSTATE DRIVE  
WENTZVILLE, MO 63385

**EQUIPMENT CONNECTION ROOF PLAN  
- AREA B**

**E303B**

SHEET












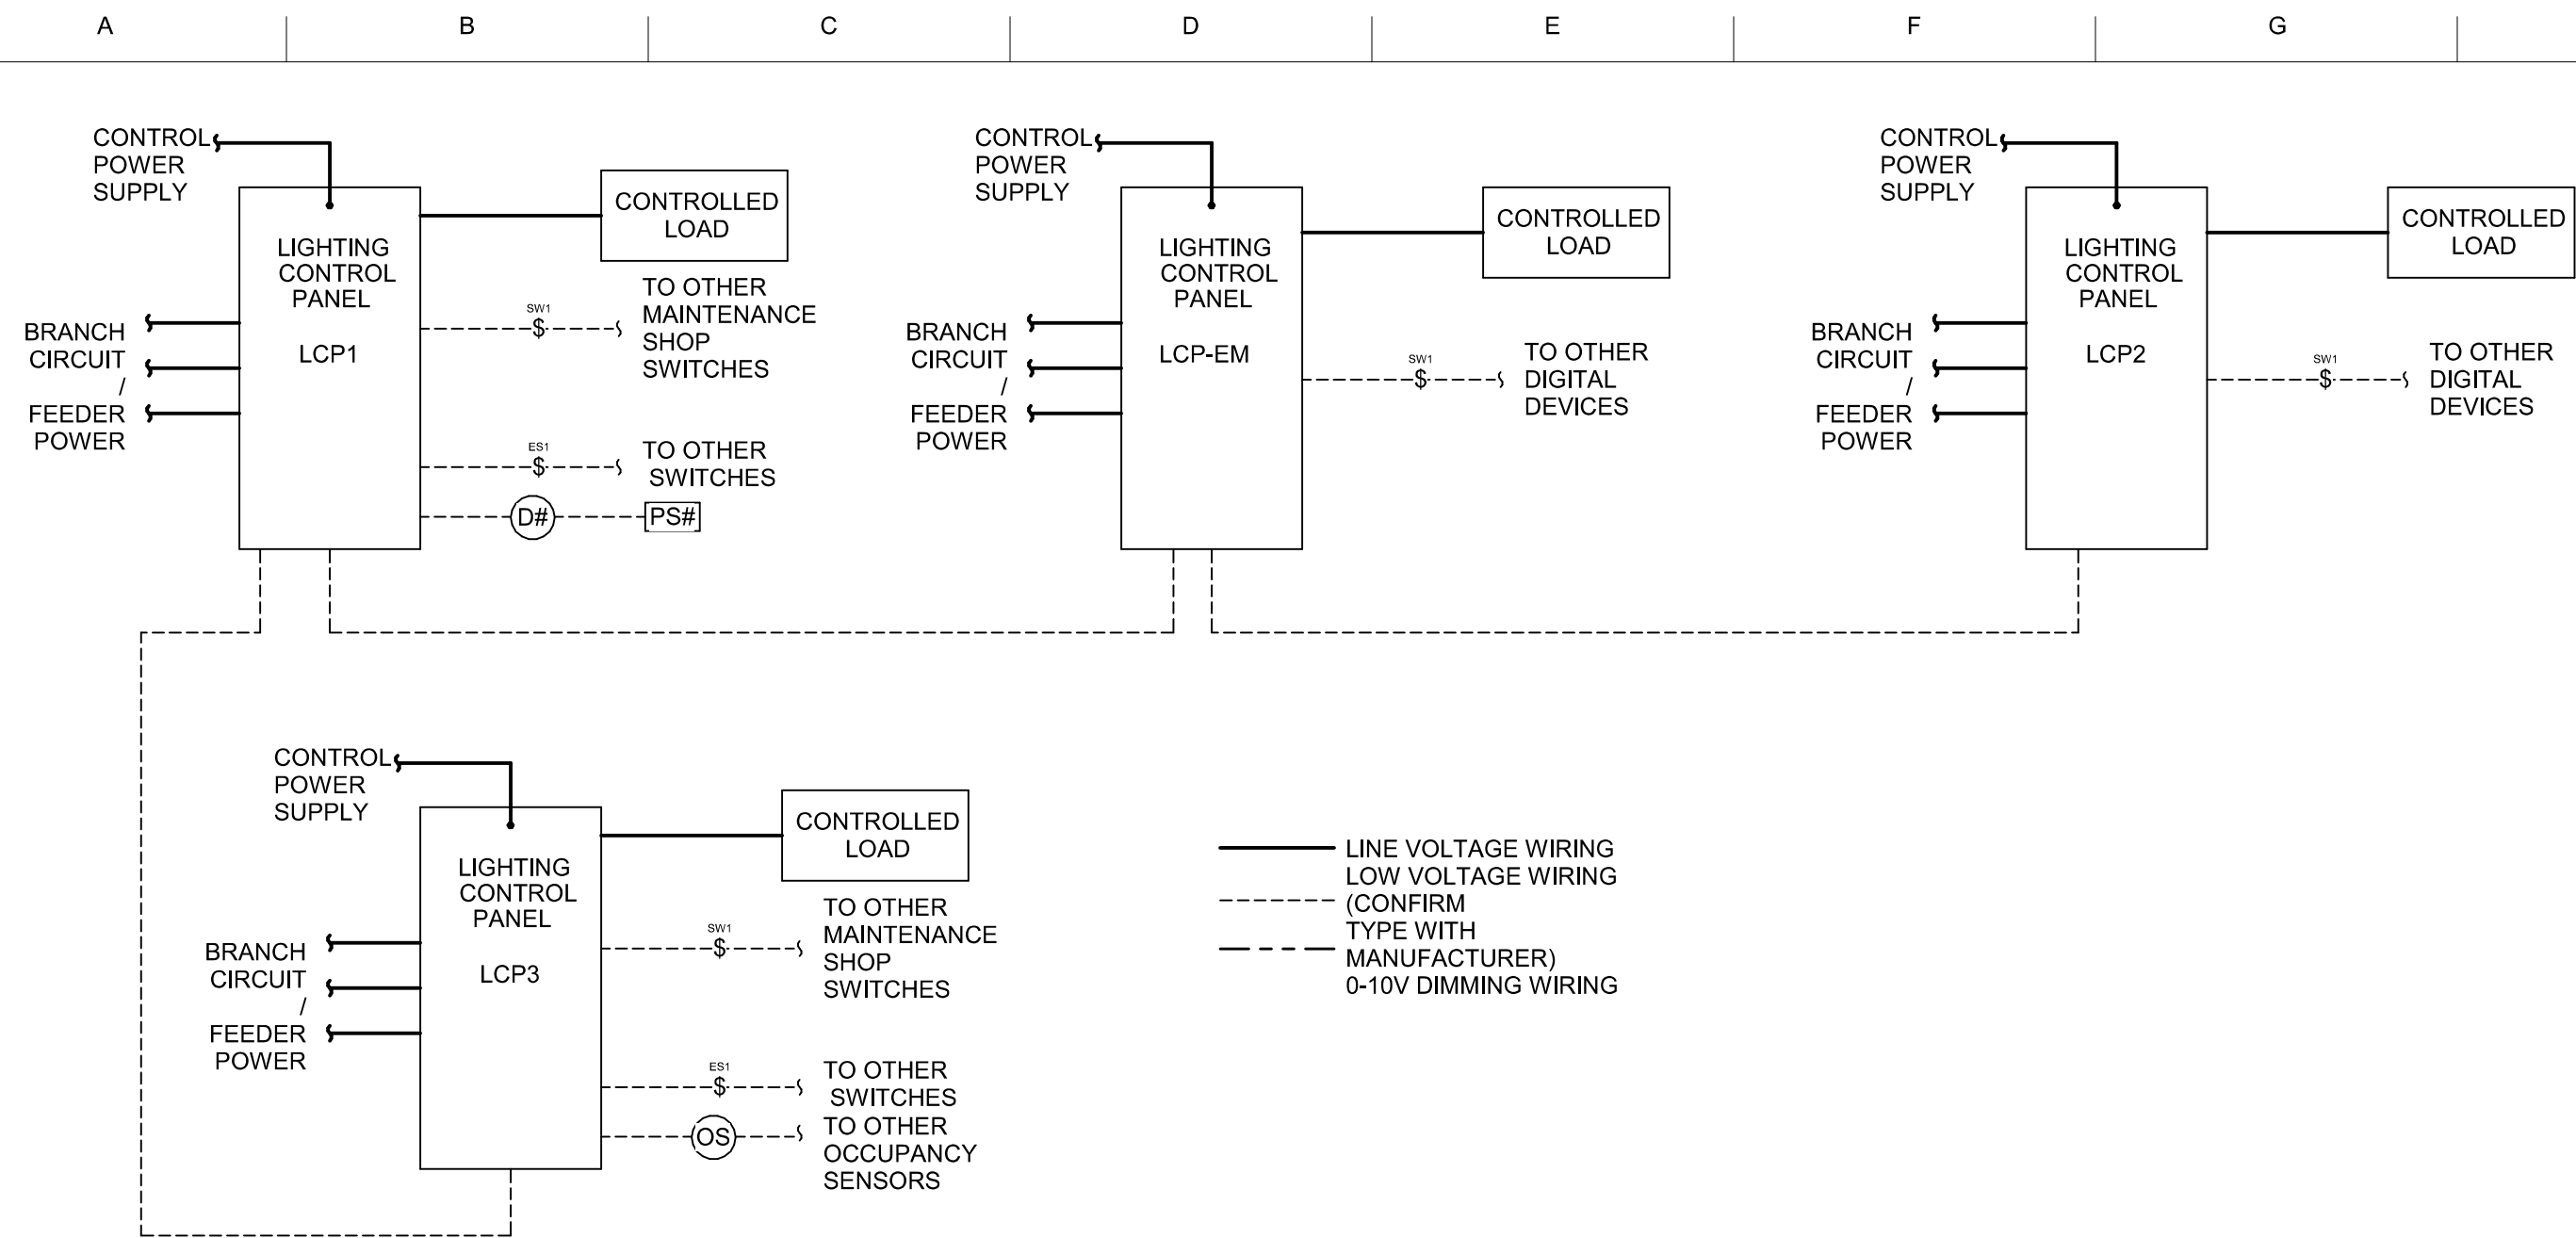


## NOTES:

- REFER TO LIGHTING CONTROL DEVICE SCHEDULE FOR DEVICE AND EQUIPMENT SPECIFICATIONS.
- DETAIL IS DIAGRAMMATIC AND IS BASED ON LEGRAND. THIS REPRESENTS THE GENERAL SCOPE OF WORK AND LOCATION OF DEVICES IN RELATION TO EACH OTHER ALONG THE POWER CIRCUIT. DIAGRAMS MAY BE DIFFERENT FOR ALLOWED EQUIVALENT MANUFACTURERS. ELECTRICAL CONTRACTOR SHALL COORDINATE FULL SYSTEM REQUIREMENTS WITH SELECTED MANUFACTURER. PROVIDE ALL PARTS AND PIECES REQUIRED FOR A FULLY FUNCTIONAL SYSTEM. REFER TO FINAL APPROVED MANUFACTURER'S INSTALLATION INSTRUCTIONS AND WIRING DIAGRAMS FOR INSTALLATION.
- CIRCUITING SHOWN ON PLAN(S) CORRESPONDS TO LIGHTING CONTROL INTENT. IF CIRCUITING IS FIELD-MODIFIED, ENSURE THAT SYSTEM PROGRAMMING WITH REVISED CIRCUITING MEETS ORIGINAL LIGHTING CONTROL INTENT. UPDATE LIGHTING CONTROL PANEL SCHEDULE(S) IN RECORD DRAWINGS. REFER TO LIGHTING CONTROL PANEL SCHEDULE(S) FOR MORE INFORMATION.
- INTEGRAL TIMECLOCK SHALL BE ASTRONOMIC, PROGRAMMABLE WITH 7 DAY / HOLIDAY SCHEDULING, AND HAVE 24 HOUR BATTERY BACK-UP.
- COORDINATE WITH OWNER FOR PROGRAMMABLE TIMECLOCK SCHEDULES. PROVIDE GENERAL CONTRACTOR WITH OPERATIONS MANUALS FOR ALL COMPONENTS OF LIGHTING CONTROL SYSTEM. LEAVE A TYPEWRITTEN SCHEDULE INCLUDING ANY FIELD CONDITION CHANGES IN EACH LIGHTING CONTROL PANEL DOOR.
- PROVIDE SYSTEM PROGRAMMING AS REQUIRED FOR SYSTEM TO OPERATE PER THESE CONTRACT DOCUMENTS.
- PROVIDE SYSTEM COMMISSIONING AS REQUIRED PER ENERGY CODE.


## SITE VISITS:

- CONTRACTOR IS RESPONSIBLE FOR COORDINATING ALL SITE VISITS WITH MANUFACTURER PER MANUFACTURER'S REQUIRED TIME FRAME.

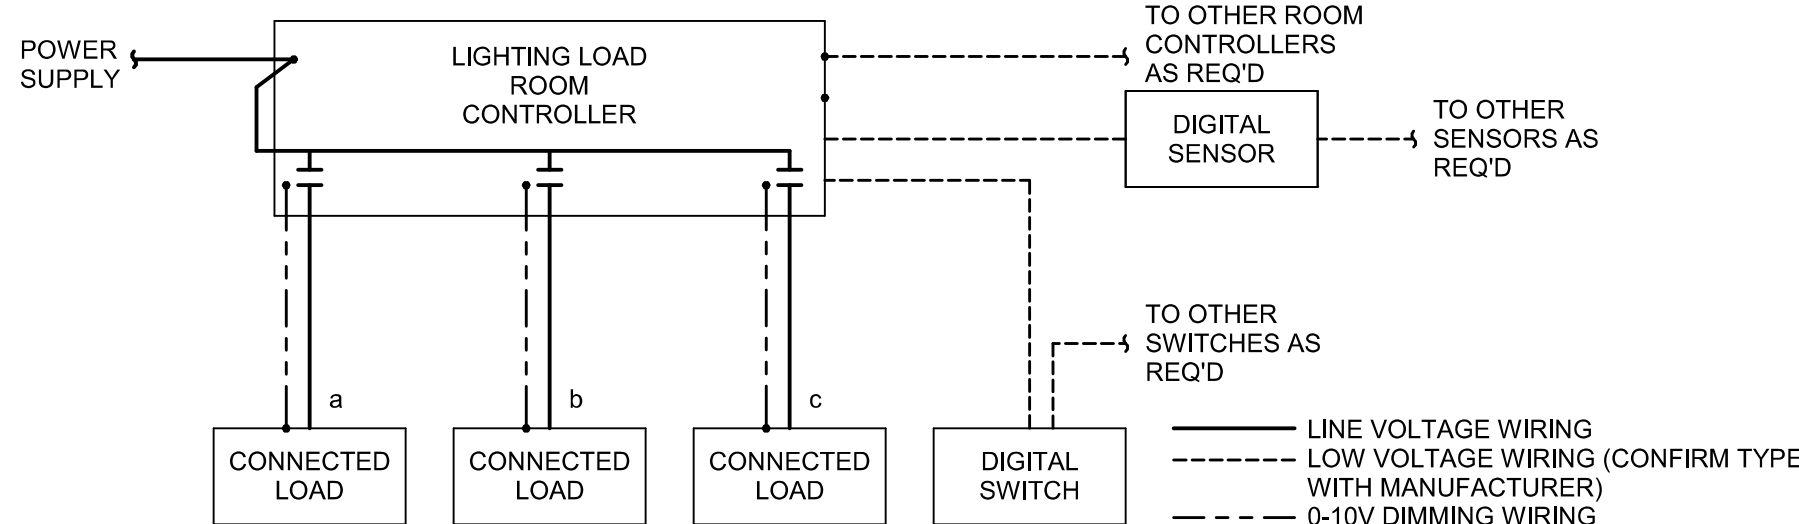**1** LIGHTING CONTROL DIAGRAM  
NONE

## NOTES:

- REFER TO LIGHTING CONTROL DEVICE SCHEDULE FOR DEVICE AND EQUIPMENT SPECIFICATIONS.
- QUANTITY OF RELAYS SHOWN IS GENERIC. REFER TO PLANS, LIGHTING CONTROL DEVICE SCHEDULE, AND SHOP DRAWINGS FOR FINAL QUANTITY PER ROOM CONTROLLER.
- DETAIL IS DIAGRAMMATIC AND IS BASED ON LEGRAND. THIS REPRESENTS THE GENERAL SCOPE OF WORK AND LOCATION OF DEVICES IN RELATION TO EACH OTHER ALONG THE POWER CIRCUIT. DIAGRAMS MAY BE DIFFERENT FOR ALLOWED EQUIVALENT MANUFACTURERS. ELECTRICAL CONTRACTOR SHALL COORDINATE FULL SYSTEM REQUIREMENTS WITH SELECTED MANUFACTURER. PROVIDE ALL PARTS AND PIECES REQUIRED FOR A FULLY FUNCTIONAL SYSTEM. REFER TO FINAL APPROVED MANUFACTURER'S INSTALLATION INSTRUCTIONS AND WIRING DIAGRAMS FOR INSTALLATION.
- CIRCUITING SHOWN ON THE PLAN CORRESPONDS TO THE LIGHTING CONTROL INTENT. IF CIRCUITING IS CHANGED IN THE FIELD, ENSURE THAT SYSTEM PROGRAMMING WITH REVISED CIRCUITING MEETS THE ORIGINAL LIGHTING CONTROL INTENT. UPDATE LIGHTING CONTROL PANEL SCHEDULES IN RECORD DRAWINGS.
- PROVIDE SYSTEM COMMISSIONING AS REQUIRED PER ENERGY CODE.

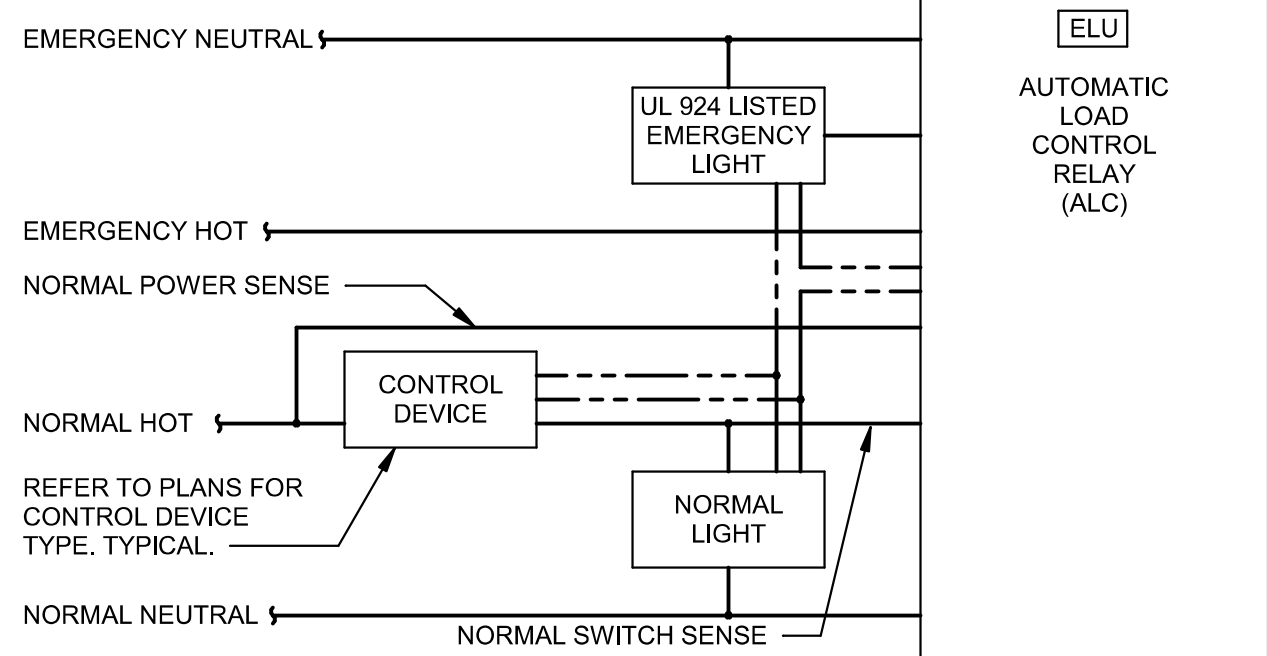**2** ROOM CONTROLLER DETAIL 2 ZONE - ON/OFF OR ON/OFF/0-10V DIMMING  
CONTROL  
NONE

## NOTES:

- OPERATION: EMERGENCY AND NORMAL LIGHT FIXTURES ARE CONTROLLED TOGETHER. UPON NORMAL POWER LOSS, EMERGENCY LIGHT FIXTURES SHALL AUTOMATICALLY TURN ON TO FULL OUTPUT.
- REFER TO SPECIFICATIONS FOR MORE INFORMATION. PROVIDE SUBMITTAL FOR ENGINEER'S REVIEW PRIOR TO PURCHASE.
- LOCATE ALC WHERE ACCESSIBLE. REFER TO LIGHTING PLANS FOR MORE INFORMATION.
- WIRING DETAIL IS DIAGRAMMATIC ONLY AND BASED ON LVS CONTROLS DEVICE. REFER TO MANUFACTURER'S INSTALLATION INSTRUCTIONS FOR SPECIFIC WIRING DIAGRAM.

EMERGENCY LIGHT FIXTURES MUST ALSO BE UL924 LISTED PER NEC 700.24.

**3** (LOADS CONTROLLED TOGETHER) 0-10V AUTOMATIC LOAD CONTROL RELAY DETAIL  
NTS

## MULTI-BUTTON SWITCH SCHEDULE

\*NOTE: PROVIDE FACTORY BUTTON ENGRAVING FOR ALL MULTI-BUTTON SWITCHES WITH MORE THAN ONE BUTTON UNLESS NOTED OTHERWISE, REFER TO BUTTON LABEL COLUMN FOR TEXT.

SWITCH	BUTTON	BUTTON LABEL	CONTROLLED LOAD	BUTTON OPERATION
SW1	1	GENERAL	ZONE A	ON
	2	GENERAL	ZONE A	OFF
	3	GENERAL	ZONE B	ON
	4	GENERAL	ZONE B	OFF
SW2	1	GENERAL	ZONE C	ON
	2	GENERAL	ZONE C	OFF
	3	GENERAL	ZONE E	ON
	4	GENERAL	ZONE E	OFF
SW3	1	GENERAL	ZONE C	ON
	2	GENERAL	ZONE C	OFF
	3	GENERAL	ZONE D	ON
	4	GENERAL	ZONE D	OFF
SW4	1	GENERAL	ZONE C	ON
	2	GENERAL	ZONE C	OFF
	3	GENERAL	ZONE D	ON
	4	GENERAL	ZONE D	OFF
SW5	1	GENERAL	ZONE C	ON
	2	GENERAL	ZONE C	OFF
	3	GENERAL	ZONE F	ON
	4	GENERAL	ZONE F	OFF
SW6	1	GENERAL	ZONE G	ON
	2	GENERAL	ZONE G	OFF
	1	GENERAL	ZONE H	ON
	2	GENERAL	ZONE H	OFF
SW7	1	GENERAL	ZONE I	ON
	2	GENERAL	ZONE I	OFF
SW8	1	GENERAL	ZONE J	ON
	2	GENERAL	ZONE J	OFF
SW9	1	GENERAL	ZONE E21	ON/OFF
	2	REAR EXT LTGS	ZONE E22	ON/OFF
ES1	3	FRONT LTGS	ZONE E23	ON/OFF
	4	REAR CANOPY	ZONE E24	ON/OFF
ES2	1	REAR EXT LTGS	ZONE E21	ON/OFF
	2	REAR EXT LTGS	ZONE E22	ON/OFF
	3	FRONT LTGS	ZONE E23	ON/OFF
	4	REAR CANOPY	ZONE E24	ON/OFF

## LIGHTING CONTROL PANEL SCHEDULE

PANEL NAME:		LCP-EM		MOUNTING:	SURFACE	
LOCATION:		ELECTRICAL ROOM		VOLTAGE:	277-480	
RELAY	CIRCUIT	LOAD CONTROLLED		MODULE TYPE	LOAD (WATTS)	ZONE
1	LSF1-1	EXTERIOR WALL PACK - A		ON/OFF	252	E21
2	LSF1-1	EXTERIOR WALL PACK - B		ON/OFF	252	E22
3	LSF1-3	EXTERIOR CANOPY		ON/OFF	60	E23
4	LSF1-5	LTG - MAINTENANCE SHOP ZONE A		ON/OFF	360	A
5	LSF1-7	LTG - MAINTENANCE SHOP ZONE C		ON/OFF	270	C
6	LSF1-7	LTG - MAINTENANCE SHOP ZONE D		ON/OFF	180	D
7	LSF1-7	LTG - MAINTENANCE SHOP ZONE E		ON/OFF	90	E
8	LSF1-7	LTG - MAINTENANCE SHOP ZONE F		ON/OFF	180	F
9	LSF1-7	LTG - MAINTENANCE SHOP ZONE G		ON/OFF	360	G
11		SPARE				
12		SPARE				

NOTE: RELAY NUMBERING ON SCHEDULE IS INTENDED TO COMMUNICATE DESIGN INTENT AND IS FOR INFORMATIONAL PURPOSES ONLY. THE CONTRACTOR IS RESPONSIBLE FOR COORDINATING FINAL RELAY CONFIGURATION WITH LIGHTING CONTROL VENDOR AND FIELD CONDITIONS.

## LIGHTING CONTROL PANEL NOTES

## LIGHTING CONTROL PANEL SCHEDULE

PANEL NAME: LOCATION:		LCP1 ELECTRICAL ROOM	MOUNTING: VOLTAGE:	SURFACE 277-480	
RELAY	CIRCUIT	LOAD CONTROLLED	MODULE TYPE	LOAD (WATTS)	ZONE
1	SBF1-17	LTG - MAINTENANCE SHOP ZONE A	ON/OFF	630	A
2	SBF1-17	LTG - MAINTENANCE SHOP ZONE B	ON/OFF	720	B
3	SBF1-19	LTG - MAINTENANCE SHOP ZONE C	ON/OFF	450	C
4	SBF1-19	LTG - MAINTENANCE SHOP ZONE D	ON/OFF	540	D
5	SBF1-19	LTG - MAINTENANCE SHOP ZONE E	ON/OFF	270	E
6	SBF1-19	LTG - MAINTENANCE SHOP ZONE F	ON/OFF	720	F
7	SBF1-21	LTG - MAINTENANCE SHOP ZONE G	ON/OFF	990	G
8		SPARE			
9		SPARE			
10	SBF1-1-3	SITE LIGHTING - FRONT PARKING LOT	ON/OFF	744	E23
11	SBF1-5	SITE LIGHTING - FRONT BUILDING WALL PACKS	ON/OFF	160	E23
12	SBF1-7	SITE LIGHTING - FRONT BUILDING CANOPY	ON/OFF	140	E23
13	SBF1-9	SITE LIGHTING - REAR CANOPY A	ON/OFF	610	E21
14	SBF1-9	SITE LIGHTING - REAR CANOPY B	ON/OFF	488	E22
15	SBF1-13,15	SITE PARKING - POLES EAST 1	ON/OFF	133	E21
16	SBF1-13,15	SITE PARKING - POLES EAST 2	ON/OFF	266	E22
17	SBFA-5	SITE - WALL WASHERS	ON/OFF	55	E23
18	SBFA-10	MECH FAN: ICF-1,2,3,4	ON/OFF	282	-
19	SBFA-12	MECH FAN: ICF-5,6,7,8	ON/OFF	282	-
20	SBFA-14	MECH FAN: ICF-9,10,11,12	ON/OFF	282	-
21		SPARE			-
22		SPARE			-
23		SPARE			-
24		SPARE			-

NOTE: RELAY NUMBERING ON SCHEDULE IS INTENDED TO COMMUNICATE DESIGN INTENT AND IS FOR INFORMATIONAL PURPOSES ONLY. THE CONTRACTOR IS RESPONSIBLE FOR COORDINATING FINAL RELAY CONFIGURATION WITH LIGHTING CONTROL VENDOR AND FIELD CONDITIONS.

## LIGHTING CONTROL PANEL NOTES

## LIGHTING CONTROL PANEL SCHEDULE

PANEL NAME: LOCATION:		LCP2 ELECTRICAL ROOM	MOUNTING: VOLTAGE:	SURFACE 277-480		
RELAY	CIRCUIT	LOAD CONTROLLED		MODULE TYPE	LOAD (WATTS)	ZONE
1	SBW1-1	BACK PARKING SITE CANOPY A		ON/OFF	304	E21
2	SBW1-1	BACK PARKING SITE CANOPY B		ON/OFF	182	E22
3,4	SBW1-3,5	BACK PARKING SITE POLES A		ON/OFF	1116	E21
5,6	SBW1-3,5	BACK PARKING SITE POLES B		ON/OFF	992	E22
7	SBW1-1	BACK PARKING SITE CANOPY B		ON/OFF	1464	E24
8		SPARE				

NOTE: RELAY NUMBERING ON SCHEDULE IS INTENDED TO COMMUNICATE DESIGN INTENT AND IS FOR INFORMATIONAL PURPOSES ONLY. THE CONTRACTOR IS RESPONSIBLE FOR COORDINATING FINAL RELAY CONFIGURATION WITH LIGHTING CONTROL VENDOR AND FIELD CONDITIONS.

## LIGHTING CONTROL PANEL NOTES

## LIGHTING CONTROL PANEL SCHEDULE

PANEL NAME:		LCP3	MOUNTING:		SURFACE	
LOCATION:		ELECTRICAL ROOM	VOLTAGE:		277-480	
RELAY	CIRCUIT	LOAD CONTROLLED		MODULE TYPE	LOAD (WATTS)	ZONE
1	SBA1-11	LTG - WATER SHOP		ON/OFF	325	H
2	SBA1-11	LTG - STREET SHOP MAINTENANCE		ON/OFF	175	I
3	SBA1-11	LTG - SIGN SHOP MAINTENANCE		ON/OFF	125	J
4		SPARE		ON/OFF		

NOTE: RELAY NUMBERING ON SCHEDULE IS INTENDED TO COMMUNICATE DESIGN INTENT AND IS FOR INFORMATIONAL PURPOSES ONLY. THE CONTRACTOR IS RESPONSIBLE FOR COORDINATING FINAL RELAY CONFIGURATION WITH LIGHTING CONTROL VENDOR AND FIELD CONDITIONS.

## LIGHTING CONTROL PANEL NOTES

## LIGHTING CONTROL SEQUENCE OF OPERATIONS

## A. HOURS OF OPERATION

General Note: Confirm all timelock schedules and sensor time delays with owner prior to final programming.

Occupied Hours: Mon-Sat 6:00 AM - 9:00 PM, Sun 8:00 AM - 7:00 PM  
Business Hours: Mon-Sat 8:00 AM - 7:00 PM, Sun 10:00 AM - 5:00 PM

## B. GENERAL REQUIREMENTS

- Emergency Lighting: Emergency egress lighting is powered from generator/ats via dedicated emergency lighting panel. Upon loss of power, all lights designated as emergency shall turn on at full emergency output.

## C. OPEN OFFICES/CONFERENCE ROOM/TRAINING ROOM/LARGE BREAK ROOM/WAREHOUSE/LARGE OFFICES

- Timelock: Space is networked to a room controller.
- Manual Control: Occupant can manually turn lights on/off and adjust dimming level via local switch(es).
- Occupancy: Lights shall automatically turn on to 50%. Occupant can then manually operate local switch to adjust dimming level of fixtures.
- Vacancy: After 20 minutes, all controlled loads shall turn off.

## D. CORRIDORS AND VESTIBULES

- Timelock: Space is networked to a room controller.
- Manual Control: Occupant can manually turn lights on/off via local switch(es).
- Occupancy: Lights shall automatically turn on to 100%.
- Vacancy: After 20 minutes all controlled loads shall turn off.

## E. RESTROOMS AND LOCKER ROOMS

- Timelock: Space is networked to a room controller.
- Manual Control: Occupant can manually turn lights on/off via local switch(es).
- Occupancy: Lights shall automatically turn on.
- Vacancy: After 20 minutes all controlled loads shall turn off.

## F. SMALL CLOSETS (&lt;50 SF)/SMALL OFFICES

- Timelock: Space is stand-alone (not networked).
- Manual Control: Occupant can manually control lights via local switch(es).
- Occupancy: Occupant must manually turn on lights (and if applicable, controlled receptacles).
- Vacancy: After 20 minutes, all controlled loads shall turn off.

## G. ELECTRICAL / EQUIPMENT ROOMS

- Timelock: Space is stand-alone (not networked).
- Manual Control: Occupant can manually control lights via local switch.

## H. WATER SHOP/SION SHOP/ STREET SHOP

 
- Timelock: Space is networked to a central timelock but is controlled locally.
- Manual Control: Occupant can manually turn lights on/off via local switch(es).
- Occupancy: Lights shall automatically turn on during occupied hours as determined by time clock schedule.
- Vacancy: During occupied hours, after 20 minutes lights shall reduce to 50% minimum. During unoccupied hours, after 20 minutes all controlled loads shall turn off.

## I. MAINTENANCE BAYS

- Timelock: Space is networked to a central timelock but is controlled locally.
- Manual Control: Occupant can manually turn lights on/off via local switch(es) for override for after hours operation when required.
- Occupancy: Lights shall automatically turn on during occupied hours as determined by time clock schedule.
- Vacancy: Lighting within bays shall turn off based on timelock schedule.

## J. SITE LIGHTING

- Timelock: Site lighting is networked to a central timelock to turn on/off via time clock operation.
- Manual Control: Occupant can manually turn lights on/off via exterior switch(es) for override for after hours operation when required via ES1 and ES2.
- Occupancy: Lights shall automatically turn on during time clock schedule.

hdesigngroup  
architecture + design

5039 S National Avenue | Springfield, MO 65810 | 417.867.6595

## OWNER

CITY OF WENTZVILLE, MISSOURI  
1001 SCHROEDER CREEK BLVD  
WENTZVILLE, MO 63385  
636.327.5101

## PROJECT TEAM

CIVIL ENGINEER  
PREMIER DESIGN GROUP  
100 MIDLAND PARK DRIVE  
WENTZVILLE, MO 63385  
314.925.7444MAINTENANCE CONSULTANT  
HDR ENGINEERING, INC.  
17725 KATY FREEWAY SUITE 102  
HOUSTON, TX 77044  
816.360.2700STRUCTURAL ENGINEER  
METTEMAYER ENGINEERING  
2225 W CHESTERFIELD BLVD., SUITE 300  
SPRINGFIELD, MO 65807  
417.890.8002MEP ENGINEER  
HENDERSON ENGINEERS, INC.  
8345 LEXA DR., #300  
LEXA, KS 66214  
913.742.5000

.

.


.

.

.

.



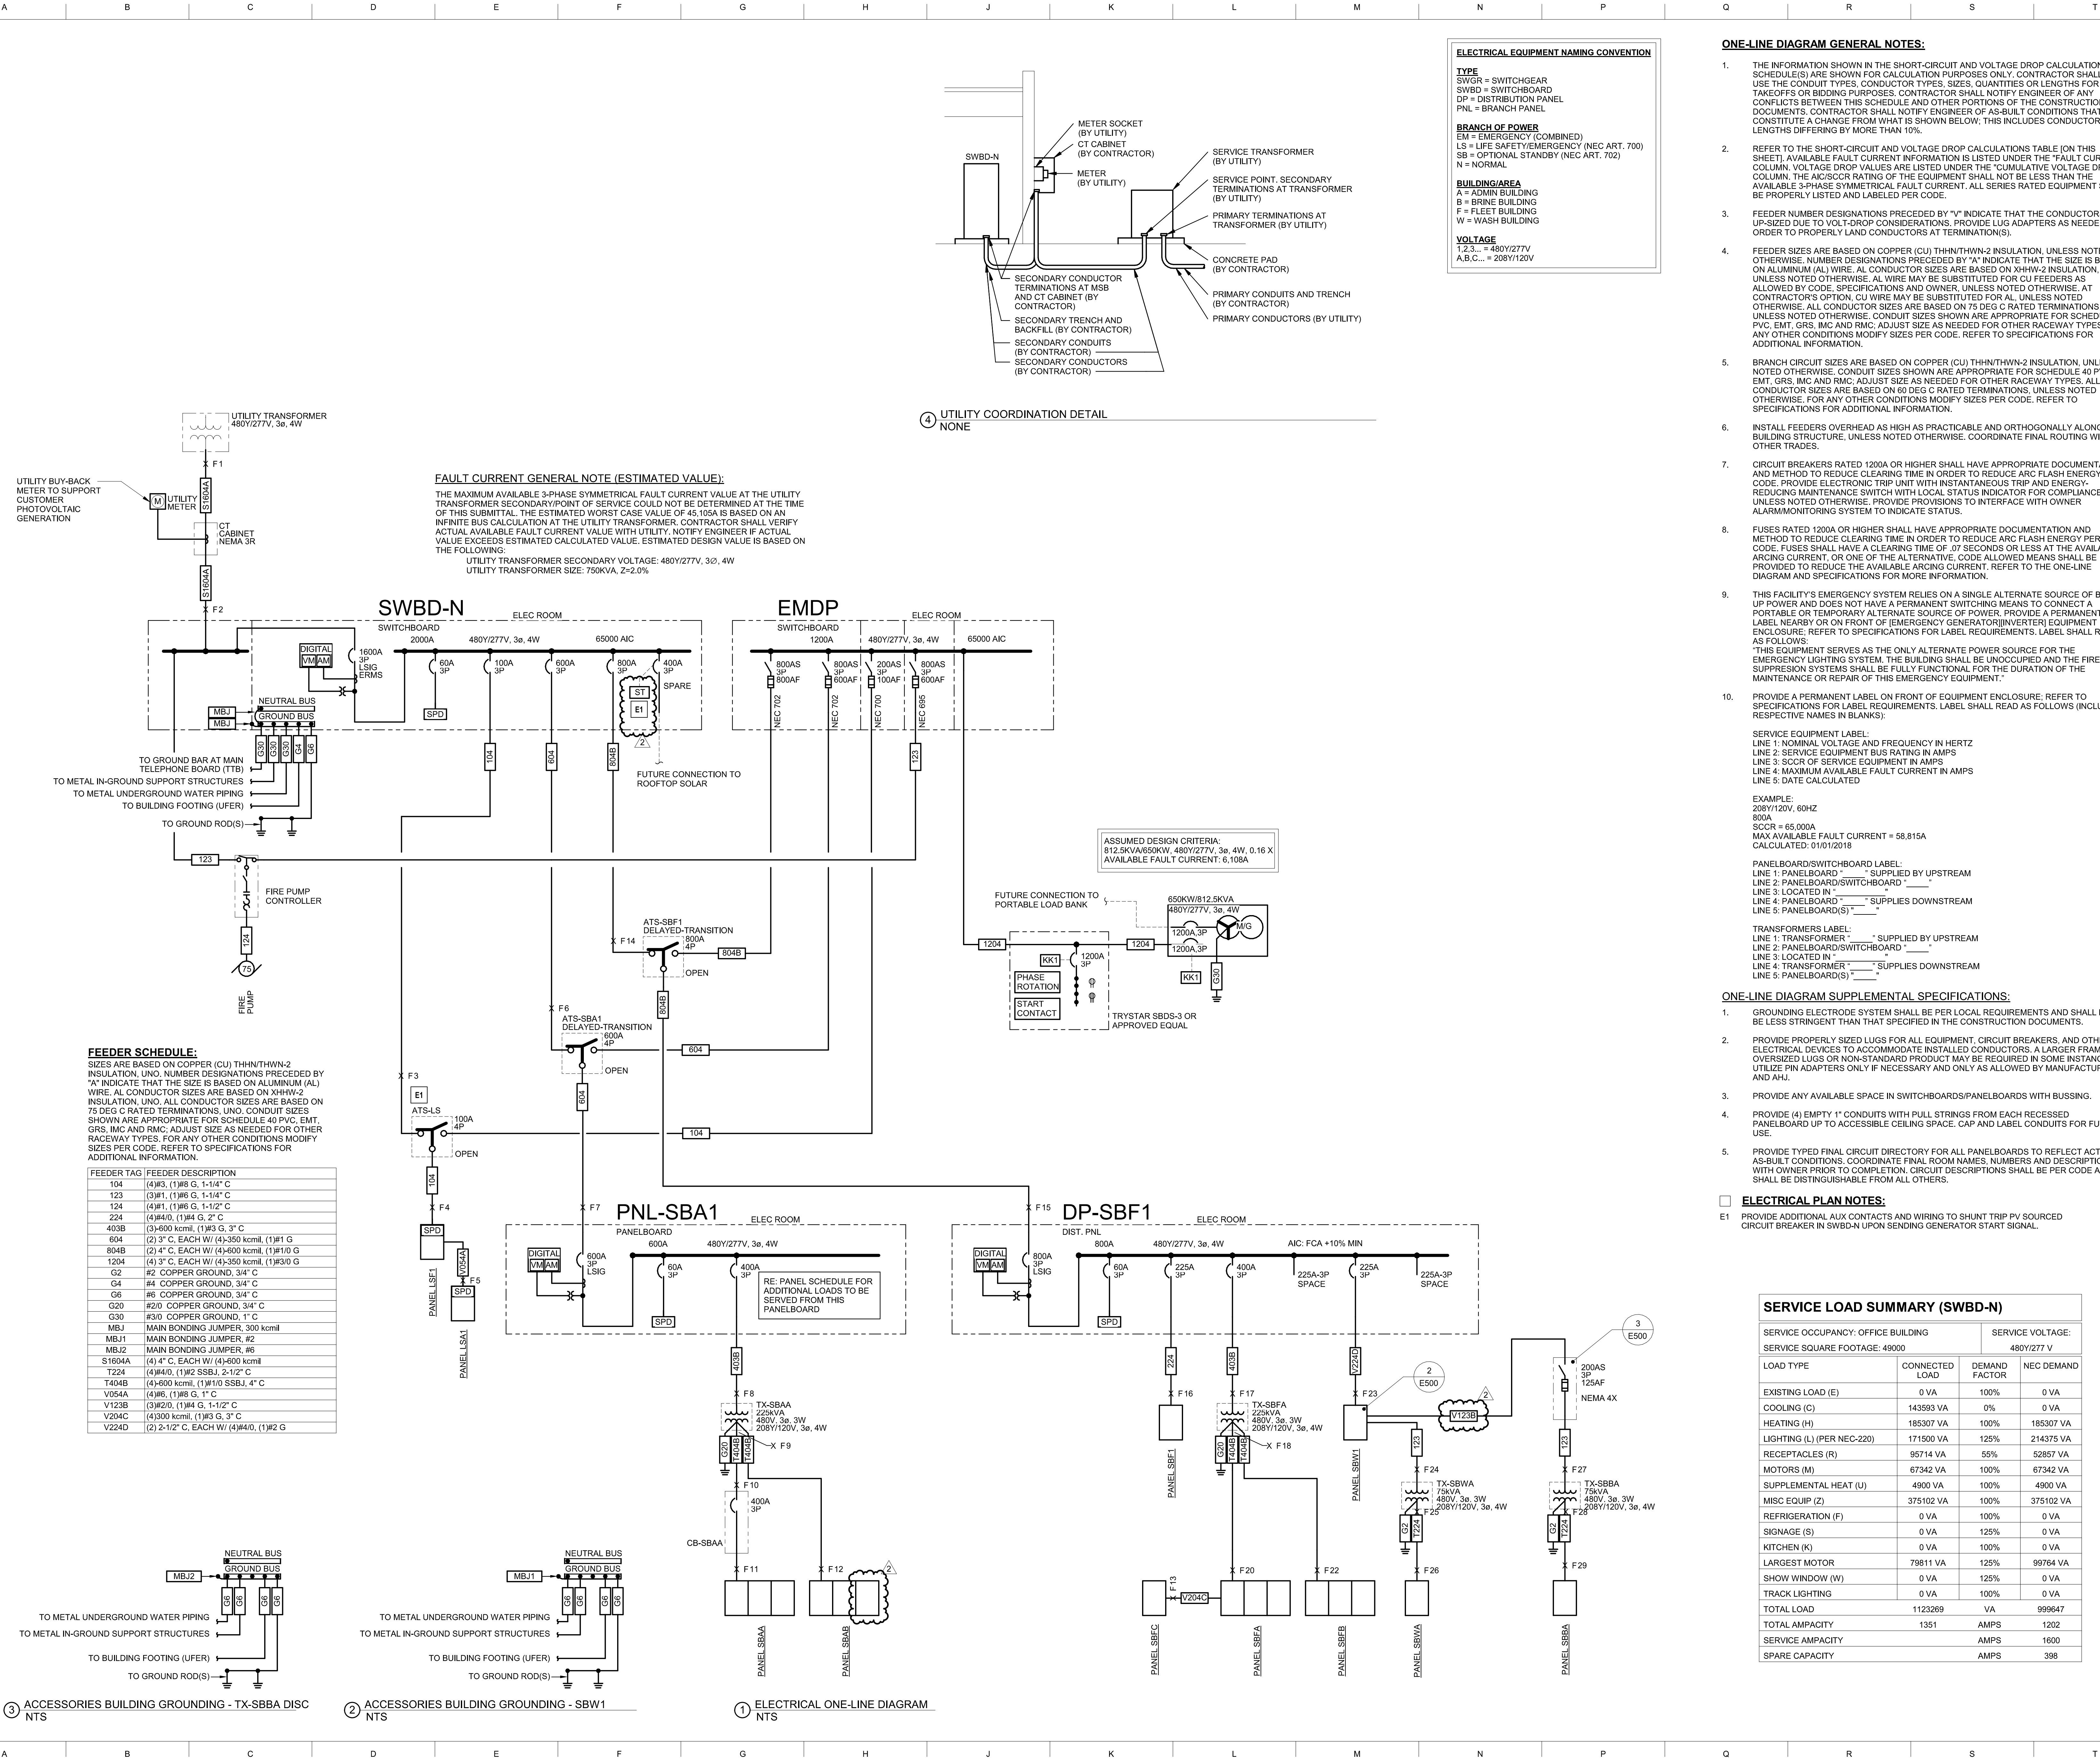

3 ACCESSORIES BUILDING GROUNDING - TX-SBBA DISC NTS

2 ACCESSORIES BUILDING GROUNDING - SBW1 NTS

1 ELECTRICAL ONE-LINE DIAGRAM NTS

**OWNER**  
**CITY OF WENTZVILLE, MISSOURI**  
1001 SCHROEDER CREEK BLVD  
WENTZVILLE, MO 63385  
636.327.5101

**PROJECT TEAM**  
**CIVIL ENGINEER**  
PREMIER DESIGN GROUP  
100 MIDLAND PARK DRIVE  
WENTZVILLE, MO 63385  
314.925.7444  
**MAINTENANCE CONSULTANT**  
HDR ENGINEERING, INC.  
17725 KATY FREEWAY SUITE 102  
HOUSTON, TX 77064  
816.360.2700  
**STRUCTURAL ENGINEER**  
METTEMEYER ENGINEERING  
2225 W CHESTERFIELD BLVD., SUITE 300  
SPRINGFIELD, MO 65807  
417.890.8002  
**MEP ENGINEER**  
HENDERSON ENGINEERS, INC.  
8345 LEXENIA DR., #300  
LEXENIA, KS 66214  
913.742.5000

**HENDERSON ENGINEERS**  
8345 LEXENIA DRIVE, SUITE 300  
LEXENIA, KS 66214  
TEL 913.742.5000 FAX 913.742.5001  
WWW.HENDERSONENGINEERS.COM  
1950004840  
EXPIRES 12/31/2023

REVISIONS		
NO.	DESCRIPTION	DATE
2	ADD 02	01.25.23

PROJECT NO.: 19-040 DRAWN BY: NS  
DATE: 12.15.22 REVIEWED BY: HEI



01/24/2023

DOUGLAS M. EVERHART  
LICENSE # PE-2019007648

**PROJECT TITLE**  
**CITY OF WENTZVILLE, MO PUBLIC WORKS FACILITY**  
**PROJECT ADDRESS:**  
1295 INTERSTATE DRIVE  
WENTZVILLE, MO 63385

**ELECTRICAL ONE-LINE DIAGRAM**



## Short-Circuit and Voltage Drop Calculations

Distances are for calculation purposes only and shall not be used for contractor takeoffs nor bidding - Contractor shall notify Engineer of any field condition that results in a change of 10% or greater circuit distance

The following calculations are based on the "Point-by-Point" method where:  
ISC (2) = ISC(1) x M(1)  
ISC (1) = short circuit current at fault point 1  
ISC (2) = short circuit current at fault point 2

$$M = 1 / (1 + f)$$

E = Line to line volts  
IP = Primary short circuit current  
Vp = Primary voltage  
IS = Secondary short circuit current  
Vs = Secondary voltage  
L = Length of circuit  
C = "C" Factor from Bussman table where "C" = 1 / impedance per linear foot

Feeder Types: NM - Non Magnetic Conduit, M - Magnetic Conduit, FB - Feeder Busway, PB - Plug-in Busway, TX - Transformer

$$\text{Feeder: } f(30) = \frac{1.732 \times L \times I_{sc}}{C \times E}$$

$$\text{Feeder: } f(100) = \frac{2 \times L \times I_{sc}}{C \times E}$$

$$\text{XFMR: } f(30) = \frac{I_{piscab} \times V_p \times 1.73 \times \%Z}{100,000 \times KVA}$$

$$\text{XFMR: } f(100) = \frac{I_{piscab} \times V_p \times \%Z}{100,000 \times KVA}$$

$$I_s(ica) = \frac{V_p \times M \times I_{piscab}}{V_s}$$

VOLTAGE DROP (30):

$$\%VD = (I_R \times \cos(\arccos(pf)) + X \sin(\arccos(pf))) \times L / W \times 1.73 / E$$

VOLTAGE DROP (100):

$$\%VD = (I_R \times \cos(\arccos(pf)) + X \sin(\arccos(pf))) \times 2 \times L / W \times 1 / E$$

%VD CUM = Cumulative Voltage Drop from Fault Point 1 to Fault Point #

R = resistance in ohms per LF

X = reactances in ohms per LF

System Voltage: 480Y/277V - 3 phase																									Date of Calculations: 12/08/2022											
Fault Point (#)	Bus/Feeder Description	Source (Fault Point)	Phase	Source Isc (amps)	Conduit type TX	Material	Feeder Quantity of Parallel Sets and Bus/Phase & Neutral Size	Conductor 'C' Value	Busway 'C' Value	L-L Voltage (E)	Circuit Length (L)	Load Power Factor (pf)	Circuit Load (Amperage)	Resistance (R)	Conductor Reactance (X)	Arccos (pf) (Radians)	Type	Degree Rise	KVA	Transformer New Xfmr Z	Existing Xfmr Z	Secondary Voltage	Tap Setting	f	M	Fault Current (amps)	Voltage Drop (%VD)	Cumulative Voltage Drop (%VD)	Fault Point (#)							
1	Utility Service Point	45,105	at the secondary of the utility transformer										Source Isc = 6X Motor Contribution = 48,945																							
1	Motor Contribution	640	The connected full load motor amps (includes compressors) on the system																																	
2	SWBD-N	1	3	48,945	M	CU	4 Set(s) of 600 kcmil	22965	--	480	70	0.9	1,000	0.000025	0.000048	0.451027				0.135	0.88	43,139	-0.27%	-0.27%	2											
3	ATLS-LS	2	3	43,139	M	CU	1 Set(s) of 3 AWG	4774	--	480	240	0.95	20	0.000250	0.000059	0.317560				7.826	0.11	4,888	-0.44%	-0.72%	3											
4	PANEL LSF1	3	3	4,888	M	CU	1 Set(s) of 3 AWG	4774	--	480	10	0.95	20	0.000250	0.000059	0.317560				0.037	0.96	4,714	-0.02%	-0.74%	4											
5	PANEL LSA1	4	3	4,714	M	CU	1 Set(s) of 6 AWG	2425	--	480	240	0.95	20	0.000490	0.000064	0.317560				1.863	0.37	1,757	-0.84%	-1.58%	5											
6	ATS-SBA1	2	3	43,139	M	CU	2 Set(s) of 350 kcmil	19704	--	480	20	0.8	480	0.000039	0.000050	0.643501				0.079	0.93	39,981	-0.11%	-0.36%	6											
7	PANEL SBA1	6	3	39,981	M	CU	2 Set(s) of 350 kcmil	19704	--	480	10	0.8	480	0.000039	0.000050	0.643501				0.037	0.96	36,569	-0.05%	-0.43%	7											
8	PRIMARY TX-SBA	7	3	36,569	M	CU	1 Set(s) of 600 kcmil	22965	--	480	20	0.8	480	0.000025	0.000048	0.643501				0.121	0.89	34,399	-0.17%	-0.60%	8											
9	SECONDARY TX-SBAA	8	3	34,399	TX				--	480							DOE	150	225	4.29			208													
10	CB-SBAA	9	3	12,302	M	CU	1 Set(s) of 600 kcmil	22965	--	208	20	0.7	240	0.000025	0.000048	0.795399				0.089	0.92	11,295	-0.21%	-0.81%	10											
11	PANEL SBAA	10	3	11,295	M	CU	1 Set(s) of 600 kcmil	22965	--	208	120	0.7	240	0.000025	0.000048	0.795399				0.491	0.67	7,573	-1.24%	-2.05%	11											
12	PANEL SBAB	9	3	12,302	M	CU	1 Set(s) of 600 kcmil	22965	--	208	20	0.7	200	0.000025	0.000048	0.795399				0.089	0.92	11,295	-0.17%	-0.77%	12											
13	PANEL SBFC	20	3	10,395	M	CU	1 Set(s) of 300 kcmil	18177	--	208	185	0.7	100	0.000045	0.000051	0.795399				0.881	0.53	5,526	-1.05%	-2.76%	13											
14	ATS-SBF1	2	3	43,139	M	CU	2 Set(s) of 600 kcmil	22965	--	480	240	0.9	550	0.000025	0.000048	0.451027				0.813	0.55	23,789	-1.03%	-1.31%	14											
15	DP-SBF1	14	3	23,789	M	CU	2 Set(s) of 600 kcmil	22965	--	480	20	0.9	600	0.000025	0.000048	0.451027				0.037	0.96	22,932	-0.09%	-1.40%	15											
16	PANEL SBF1	15	3	22,932	M	CU	1 Set(s) of 400 AWG	15082	--	480	20	0.9	150	0.000063	0.000051	0.451027				0.110	0.90	20,864	-0.09%	-1.49%	16											
17	PRIMARY TX-SBFA	15	3	22,932	M	CU	1 Set(s) of 600 kcmil	22965	--	480	20	0.9	300	0.000025	0.000048	0.451027				0.072	0.93	21,390	-0.09%	-1.50%	17											
18	SECONDARY TX-SBFA	17	3	21,390	TX				--	480							DOE	150	225	4.29			208													
19	SPARE								--																											
20	PANEL SBFA	18	3	11,243	M	CU	1 Set(s) of 600 kcmil	22965	--	208	20	0.9	300	0.000025	0.000048	0.451027				0.082	0.92	10,395	-0.22%	-1.71%	20											
21	SPARE								--																											
22	PANEL SBFB	18	3	11,243	M	CU	1 Set(s) of 600 kcmil	22965	--	208	20	0.9	300	0.000025	0.000048	0.451027				0.082	0.92	10,395	-0.22%	-1.71%	22											
23	PANEL SBW1	15	3	22,932	M	CU	2 Set(s) of 400 AWG	15082	--	480	350	0.9	150	0.000063	0.000051	0.451027				1.509	0.40	9,141	-1.17%	-2.59%	23											
24	PRIMARY TX-SBWA	23	3	9,141	M	CU	1 Set(s) of 1 AWG	7293	--	480	10	0.9	78	0.000160	0.000057	0.451027				0.045	0.96	8,745	-0.05%	-2.62%	24											
25	SECONDARY TX-SBWA	24	3	8,745	TX				--	480							DOE	150	75	3.61			208													
26	PANEL SBWA	25	3	4,485	M	CU	1 Set(s) of 400 AWG	15082	--	208	10	0.9	180	0.000063	0.000051	0.451027				0.025	0.98	4,377	-0.12%	-2.74%	26											
27	PRIMARY TX-SBBA	23	3	9,141	M	CU	1 Set(s) of 20 AWG	10755	--	480	130	0.9	45	0.000100	0.000054	0.451027				0.399	0.71	6,835	-0.24%	-2.82%	27											
28	SECONDARY TX-SBAA	27	3	6,835	TX				--	480							DOE	150	75	3.61			208													
29	PANEL SBAA	28	3	4,172	M	CU	1 Set(s) of 400 AWG	15082	--	208	10	0.9	100	0.000063	0.000051	0.451027				0.023	0.98	4,078	-0.07%	-2.88%	29											

## GENERATOR LOAD SCHEDULE

GENERATOR TYPE: <b>STATIONARY</b>	
GENERATOR USAGE: <b>STANDBY</b>	
GENERATOR FUEL: <b>DIESEL</b>	
FUEL TANK LOCATION: <b>SUB-BASE (BELLY TANK)</b>	
OUTPUT VOLTAGE / HZ: <b>480Y/277V, 60HZ</b>	
GENERATOR LOCATION: <b>EXTERIOR ON GRADE W/ SOUND ATTENUATION</b>	
MAX AMBIENT AIR TEMP (°F): <b>105 F</b>	
ELEVATION AMSL (FT): <b>1,000'</b>	
MIN RUN-TIME W/ ON-SITE FUEL: <b>36</b>	
# OF GENSETS: <b>BASIS OF DESIGN IS FOR 1 GENSET</b>	

ATS#	LOAD STEP	PRIORITY	CODE CLASSIFIED LOAD TYPE			LOAD DESCRIPTION	PANELBOARDS / LOADS INCLUDED IN STEP (INCLUDES DOWNSTREAM LOADS AND SUBPANELS)	MAX INSTANTANEOUS VOLTAGE DIP (%)	MAX FREQUENCY DIP (%)	LIGHTING (LED)	COMPUTERS	INVERTER / UPS	FIRE PUMP (MOTOR)	ELEVATOR (MOTOR)	FULL LOAD (RUNNING KVA)										FULL LOAD (KVA)	NOTES (#)	V2.00
			NEC ARTICLE 700 EMERGENCY	NEC ARTICLE 701 LEGALLY REQUIRED STAND-BY	NEC ARTICLE 702 OPTICAL STANDBY										ELEC HEATING (RESISTIVE)	HVAC (MOTORS)	REFRIGERATION (MOTORS)	MISC MOTORS	WELDING EQUIPMENT	RECEPTACLES	MISC / OTHER	125% OF EXISTING PEAK LOAD	FUTURE LOAD				
ATS-LS	1	1.1	X			EMERGENCY LIGHTING		20	20	4.9														5	3		
FIRE PUMP	2	1.1	X			FIRE PUMP CONTROLLER		15	15				72.5											73	2.6		
ATS-SBF 1	3	2.1			X	FLEET MAINTENANCE		15	15	14.7	28	2			20	36.3	3.4	69.8	27		100			301	1.4		
ATS-SB A1	4	3.1			X	OFFICE AREA		15	15	8.4	33.5	2			73.8	53	23.4			20	25			239	1.5		
MAXIMUM FULL LOAD (KVA):																								618			

GENERAL NOTES:

A. THE INFORMATION PROVIDED IN THIS SCHEDULE IS PRELIMINARY AND SUBJECT TO CHANGE. IT IS PROVIDED TO ASSIST IN GENERATOR SIZING AND SELECTION. THIS INFORMATION NEITHER EXTENDS NOR ALTERS ANY CONTRACTUAL OBLIGATIONS OF THE ENGINEER OR CONTRACTOR. FINAL LOADS AND RELATED INFORMATION IN THIS SCHEDULE SHOULD BE VERIFIED BY THE CONTRACTOR AND IS SUBJECT TO THE REVIEW AND APPROVAL OF THE ENGINEER OF RECORD. AUTHORITY HAVING JURISDICTION AND OWNER, PRIOR TO IMPLEMENTATION, REFER TO ONE LINE/ISSER DIAGRAM FOR TRANSFER SWITCH AND GROUNDING INFORMATION. REFER TO RELATED CONSTRUCTION DOCUMENTS INCLUDING SPECIFICATIONS FOR ADDITIONAL REQUIREMENTS.

B. UNLESS NOTED OTHERWISE, PER NEC 700.4, 701.4 & 702.4, THE GENERATOR SYSTEM CAPACITY SHALL BE CALCULATED IN ACCORDANCE WITH NEC 220 OR OTHER APPROVED METHOD. NOTE THAT THE ACTUAL PEAK LOAD MAY BE SIGNIFICANTLY LESS THAN THIS CODE MINIMUM VALUE UNDER MOST CONDITIONS. IN ADDITION, THE LOADS SHOWN IN THIS SCHEDULE ARE BASED ON RUNNING FULL LOAD CURRENTS AT NOMINAL VOLTAGES AND DO NOT ACCOUNT FOR TEMPORARY STARTING IN-RUSH CURRENTS.

C. THE FINAL GENERATOR SIZING SHALL BE PERFORMED BY AN APPROVED GENERATOR MANUFACTURER OR REPRESENTATIVE AND SUBMITTED TO THE ENGINEER FOR REVIEW AND APPROVAL. PRIOR TO ORDER, GENERATOR SUPPLIER SHALL BE RESPONSIBLE TO INCLUDE WITH GENERATOR PACKAGE ALL NECESSARY COMPONENTS, INCLUDING: ALTERNATOR, BATTERY CHARGER, CONTROL PANEL, EMISSION/EXHAUST SYSTEM, ENCLOSURE, FUEL TANK, GAUGES AND STARTER IN ACCORDANCE WITH ALL FEDERAL, STATE AND LOCAL REQUIREMENTS. GENERATOR SET AND RELATED COMPONENTS SHALL BE SUITABLE FOR LOCAL ELEVATION, ENVIRONMENT AND SEISMIC DESIGN CATEGORY. DE-RATE GENERATOR AND PROVIDE NECESSARY COMPONENTS AS NEEDED BASED ON AMBIENT TEMPERATURE, ELEVATION AND OTHER RELEVANT FACTORS.

D. IF TRANSIENT RESPONSE REQUIREMENTS CANNOT BE REASONABLY MET WITH AVAILABLE PRODUCT OFFERINGS THEN PROVIDE SUBMITTAL WITH BEST FIT FOR ENGINEER EVALUATION. REFER TO SPECIFICATIONS FOR ALLOWED STEADY-STATE TOLERANCES.

E. MAXIMUM TIME DELAY FOR NEC ARTICLE 700 EMERGENCY LOADS IS 10 SECONDS. MAXIMUM TIME DELAY FOR LEGALLY REQUIRED STANDBY LOADS IS 60 SECONDS, UNLESS NOTED OTHERWISE.

F. MAXIMUM RECOVERY TIME SHALL NOT EXCEED 3 SECONDS, UNLESS NOTED OTHERWISE.

G. LOADS LISTED ABOVE ARE BASED ON A POWER FACTOR NO LESS THAN 0.80, UNLESS NOTED OTHERWISE.

- NOTES:
- AS ALLOWED PER NEC 702.4, AN ACTIVE LOAD MANAGEMENT SYSTEM SHALL BE INSTALLED TO AUTOMATICALLY MANAGE THE CONNECTED LOAD. THE STANDBY SOURCE SHALL HAVE CAPACITY SUFFICIENT TO SUPPLY THE MAXIMUM LOAD THAT WILL BE CONNECTED. LOADS ON THIS STEP SHALL DISCONNECT FROM STANDBY SOURCE IF INSUFFICIENT CAPACITY IS AVAILABLE.
  - SYSTEM SHALL COMPLY WITH NEC 886 FOR FIRE PUMPS.
  - THE MAJORITY OF THIS LOAD IS NON-LINEAR.
  - THIS STEP INCLUDES (2) 7.5-HP HAZU MOTORS WITH VFD STARTER, 10-HP ACROSS-THE-LINE LIFT MOTOR, (2) 25-HP ACROSS-THE-LINE SHOP AIR COMPRESSOR MOTORS, AND 5-HP ACROSS-THE-LINE BRINE AIR COMPRESSOR.
  - THIS STEP INCLUDES (2) 1.5-HP DOMESTIC WATER BOOSTER PUMP MOTORS WITH VFD STARTER.
  - THIS STEP INCLUDES (2) 1-HP FIRE PUMP WITH WYE-DELTA STARTER.
  - PROVIDE SUBMITTAL INFORMATION AND PRICING FOR SUB-BASE FUEL TANK WITH ON-SITE FUEL STORAGE FOR INDICATED MINIMUM RUN TIME AT FULL RATED LOAD.
  - PROVIDE WEATHERPROOF SOUND-ATTENUATED ENCLOSURE TO LIMIT MAXIMUM OPERATIONAL SOUND OUTPUT TO 70 @9A AT 23' FROM ENCLOSURE.
  - PROVIDE WITH ENCLOSURE WIND RATED TO 120 MPH.
  - GENERATOR SHALL COMPLY WITH EPA EMISSION STANDARDS FOR EMERGENCY (STAND-BY) APPLICATIONS.

OWNER  
CITY OF WENTZVILLE, MISSOURI  
1001 SCHROEDER CREEK BLVD  
WENTZVILLE, MO 63385  
636.327.5101

### PROJECT TEAM

CIVIL ENGINEER  
PREMIER DESIGN GROUP  
100 MIDLAND PARK DRIVE  
WENTZVILLE, MO 63385  
314.925.7444



PANELBOARD: SBA1 (NEW)																		EQUIPMENT GROUND BUS																																																																																									
BUS AMPS: 600A MAIN SIZE/TYPE: 600A MCB VOLTS/PHASE: 480Y/277 V 3P/4W SUPPLIED BY: SWBD-N																		FAULT CURRENT: AIC RATED: SERVES: MOUNTING: LOCATION:										REFER TO SHORT CIRCUIT TABLE ON SHEET E502 FULLY RATED FCA +10% MINIMUM GENERAL BUILDING POWER SURFACE ELECTRICAL 131																																																																															
LINE-SIDE LUGS: MECHANICAL																																																																																																											
CKT NO.	DESCRIPTION	LOAD TYPE	NOTES	WIRE SIZE	BKR AMP	P	PHASE A	PHASE B	PHASE C	P	BKR AMP	WIRE SIZE	NOTES	LOAD TYPE	DESCRIPTION	CKT NO.																																																																																											
1	LTG - WATER SHOP/OPEN OFF	L		12	20	1	2040	3200				2	20	12	H	PWR - VAV 3	2																																																																																										
3	LTG - A WING ROOMS (1)	L		12	20	1		1884	3200			2	20	12	H	PWR - VAV 21	4																																																																																										
5	LTG - A WING ROOMS (2)	L		12	20	1						2	20	12	H	PWR - VAV 21	6																																																																																										
7	LTG - B WING ROOMS (1)	L		12	20	1	1915	2250				2	15	12	H	PWR - VAV 11	8																																																																																										
9	SPARE			12	20	1		0	2200			2	15	12	H	PWR - VAV 11	10																																																																																										
11	LTG - WATER/SIGN/STREET	L		12	20	1						2	15	12	H	PWR - VAV 12	12																																																																																										
13	SPARE			12	20	1	0	2533				3	20	12	H	PWR - VAV 12	14																																																																																										
15	SPARE			12	20	1		0	2533			3	20	12	H	PWR - VAV 12	16																																																																																										
17	PWR - VAV 1.2	H		12	15	1						3	40	8	VD	M	PWR - BP	18																																																																																									
19	PWR - VAV 4	H		12	15	1	1500	3667				3	40	8	VD	M	PWR - BP	20																																																																																									
21	PWR - VAV 5.6	H		12	15	1		2900	3667			3	40	8	VD	M	PWR - BP	22																																																																																									
23	PWR - VAV 7.8	H		12	15	1			2500	3667		3	15	12	M	JOCKEY PUMP CTRL	24																																																																																										
25	PWR - VAV 9.10	H		12	15	1	1900	776				3	15	12	M	JOCKEY PUMP CTRL	26																																																																																										
27	PWR - VAV 13,16	H		12	15	1		2900	776			3	15	12	M	JOCKEY PUMP CTRL	28																																																																																										
29	PWR - VAV 14	H		12	15	1			1400	776		1	20			SPARE	30																																																																																										
31	PWR - VAV 15	H		12	20	1	3400	0				1	20			SPARE	32																																																																																										
33	PWR - VAV 17,18	H		12	15	1		2500	0			1	20			SPARE	34																																																																																										
35	PWR - VAV 19	H		12	15	1			1900	0		1	20			SPARE	36																																																																																										
37	PWR - VAV 20	H		12	15	1	3800	0				1	20			SPACE FOR BREAKER	38																																																																																										
39	PWR - VAV 22	H		12	15	1		900	0			1	20			SPACE FOR BREAKER	40																																																																																										
41	PWR - VAV 23	H		12	15	1			1500	42234		3	175	2/0	C	MECH PWR - RTU 1	42																																																																																										
43	PWR - VAV 24	H	VD	10	20	1	3400	42234				3	175	2/0	C	MECH PWR - RTU 1	44																																																																																										
45	PWR - VAV 25	H	VD	8	25	1		5000	42234			1	20			SPARE	46																																																																																										
47	PWR - VAV 26,27,28	H		12	20	1		1500	0			1	20			SPARE	48																																																																																										
49	SPARE			12	20	1	0	0				1	20			SPACE FOR BREAKER	50																																																																																										
51	SPARE			20	1			0	48758			1	20			SPACE FOR BREAKER	52																																																																																										
53	SPARE			20	1				0	47417		3	400	OL	--	TX-SBAA	54																																																																																										
55	SPARE			20	1		0	47349				3	400	OL	--	TX-SBAA	56																																																																																										
57	SPARE			20	1			0	0			3	400	OL	--	TX-SBAA	58																																																																																										
59	SPARE			20	1				0	0		3	400	OL	--	TX-SBAA	60																																																																																										
TOTAL LOAD (VA):							119964 VA		119452 VA		114284 VA																																																																																																
TOTAL AMPS:							436 A		434 A		413 A																																																																																																
LOAD TYPE																		CONNECTED LOAD																		DEMAND FACTOR																		NEC DEMAND																		PANELBOARD NOTES																		PANELBOARD TOTALS																	
EXISTING LOAD (E)																		0 VA																		100%																		0 VA																		TOTAL CONNECTED LOAD																		356133 VA																	
COOLING (C)																		139641 VA																		100%																		139641 VA																		TOTAL NEC LOAD																		254365 VA																	
HEATING (H)																		82300 VA																		0%																		0 VA																																																					
LIGHTING (L)																		8347 VA																		125%																		10434 VA																																																					
RECEPTACLES (R)																		58610 VA																		56%																		34305 VA																		TOTAL CONNECTED CURRENT																		428 A																	
MOTORS (M)																		6264 VA																		100%																		6264 VA																		TOTAL NEC DEMAND CURRENT																		306 A																	
SUPPLEMENTAL HEAT (U)																		0 VA																		100%																		0 VA																																																					
MISC EQUIP (Z)																		48971 VA																		100%																		48971 VA																																																					
REFRIGERATION (F)																		0 VA																		100%																		0 VA																																																					
SIGNAGE (S)																		0 VA																		125%																		0 VA																																																					
KITCHEN (K)																		0 VA																		100%																		0 VA																																																					
LARGEST MOTOR																		11000 VA																		125%																		13750 VA																																																					
SHOW WINDOW (W)																		0 VA																		125%																		0 VA																																																					
TRACK LIGHTING																		0 VA																		100%																		0 VA																																																					

PANELBOARD: SBAA (NEW)																		EQUIPMENT GROUND BUS																			
BUS AMPS: 400A MAIN SIZE/TYPE: 400A MCB VOLTS/PHASE: 208Y/120 V 3P/4W SUPPLIED BY: SBA1 VA TX-SBAA																		FAULT CURRENT: AIC RATED: SERVES: MOUNTING: LOCATION:										REFER TO SHORT CIRCUIT TABLE ON SHEET E502 FULLY RATED FCA +10% MINIMUM GENERAL BUILDING POWER RECESSED CORRIDOR 106									
LINE-SIDE LUGS: MECHANICAL																																					
CKT NO.	DESCRIPTION	LOAD TYPE	NOTES	WIRE SIZE	BKR AMP	P	PHASE A	PHASE B	PHASE C	P	BKR AMP	WIRE SIZE	NOTES	LOAD TYPE	DESCRIPTION	CKT NO.																					
1	RCPT - FOREMAN 207-209	R		12	20	1	540	1080				1	20	12	R	RCPT - PW DIRC 110	2																				
3	RCPT - GIG 206	R	VD	10	20	1		900	720			1	20	12	R	RCPT - TRAF/SCADA 109 (1)	4																				
5	RCPT - WATER SUPV 205	R	VD	10	20	1			900	540			1	20	12	R	RCPT - TRAF/SCADA 109 (2)	6																			
7	RCPT - WATER SUPV 204	R		12	20	1	720	720				1	20	12	R	RCPT - RR 107/215	8																				
9	RCPT - ADMIN 203	R		12	20	1		900	373			1	20	12	R	RCPT - CONF 115	10																				
11	RCPT - ADMIN 203	R		12	20	1						540	720	1	20	12	R	RCPT - CUST ADMIN 117	12																		
13	RCPT - WATER SUPV 202	R		12	20	1	900	900				1	20	12	R	RCPT - ASSD DIR PW 113	14																				
15	RCPT - WATER SUPV 201	R		12	20	1		900	720			1	20	12	R	RCPT - DIR PW 114	16																				
17	RCPT - OPEN OFF 211 (1)	R		10	20	1				900	1440	1	20	12	M	PWR - EF4	18																				
19	RCPT - OPEN OFF 211 (2)	R		12	20	1	900	360				1	20	12	R	RCPT - CONF 115 FB	20																				
21	OFFICE 211 FURN WHIP 1	R		12	20	1		900	720			1	20	12	R	RCPT - WELLNESS 123	22																				
23	OFFICE 211 FURN WHIP 2	R		12	20	1				900	360	1	20	12	R	RCPT - WELLNESS 123 COUNTER	24																				
25	OFFICE 211 FURN WHIP 3	R		12	20	1	900	1200				1	20	12	Z	WELLNESS 123 MICR	26																				
27	OFFICE 211 FURN WHIP 4	R		12	20	1		900	600			1	20	12	Z	WELLNESS 123 FRIDGE	28																				
29	OFFICE 211 FURN WHIP 5	R		12	20	1				900	360	1	20	12	R	CORRIDOR 116 COUNTER	30																				
31	OFFICE 211 FURN WHIP 6	R		12	20	1	900	600				1	20	12	Z	CORRIDOR 116 FRIDGE	32																				
33	OFFICE 211 MICROWAVE	Z		12	20	1		1200	1200			1	20	12	Z	CORRIDOR 116 MICRO	34																				
35	OFFICE 211 FRIDGE	Z		12	20	1				1200	360	1	20	12	R	RCPT - CORR 116 COUNTER	36																				
37	OFFICE 211 COUNTER RCPT	R		12	20	1	360	1000				1	20	12	Z	CORRIDOR 116 COPIER	38																				
39	OFFICE 211 COPIER	Z	VD	10	20	1		1200	540			1	20	12	R	RCPT - CORR 116 GEN	40																				
41	PWR - TV MONITOR	R		12	20	1				360	590	1	20	12	R	RCPT - RILUCK 125/126	42																				
43	RCPT - UNISEX LCK 126	R		12	20	1	540	180				1	20	12	GF	RCPT - UNISEX LCK 126	44																				
45	ICE MACHINE - LCK RM 126	Z		10	20	1		1400	900			1	20	12	R	RCPT - CONF 102	46																				
47	RCPT - CONF 102 FB	R		12	20	1		360	720	1	20	12			R	RCPT - CORR 105	48																				
49	RCPT - TRAIN RM 119	R		12	20	1	900	1200				1	20	12	Z	PWR - VEST 100 DR (1)	50																				
51	TRAIN RM 119 FB (1-3)	R		12	20	1		900	1200			1	20	12	Z	PWR - VEST 100 DR (2)	52																				
53	TRAIN RM 119 FB (4-6)	R		12	20	1			900	1080	1	20	10	VD	R	RCPT - WATER SHOP 217	54																				
55	TRAIN RM 119 FB (7-9)	R		12	20	1	360	500				1	20	12	Z	PWR - DOOR CAME	56																				
57	PWR - VEST 100 DR TX	Z		12	20	1		500	720			1	20	12	R	RCPT - EXTERIOR WALL	58																				
59	TRAIN RM 119 COUNTER 1	R		12	20	1				780	960	1	20	10	Z	TABLE - GEN RCPT	60																				
61	TRAIN RM 119 COUNTER 2	R		12	20	1	180	500				1	20	12	R	PWR - DR CARD READERS	62																				
63	TRAIN RM 119 FRIDGE	Z		12	20	1		1200	360			1	20	12	R	PWR - IT RM RCPT 1	64																				
65	TRAIN RM 119 MICRO	Z		12	20	1				900	360	1	20	12	R	PWR - IT RM RCPT 2	66																				
67	RCPT - BREAK RM 120	R		12	20	1	900	360				1	20	12	R	PWR - IT RM RCPT 3	68																				
69	RCPT - BREAK RM 120 COUNTER 1	R		12	20	1		360	1600			1	20	12	Z	PWR - WASHIR	70																				
71	RCPT - BREAK RM 120 COUNTER 2	R		12	20	1				360	2080	2	30	10	Z	PWR - DRYER	72																				
73	PWR - BREAK RM DISHWASH	Z		12	20	1	600	2080				1	20	10			SPARE	74																			














**OWNER**  
CITY OF WENTZVILLE, MISSOURI  
1001 SCHROEDER CREEK BLVD  
WENTZVILLE, MO 63385  
636.327.5101

**PROJECT TEAM**  
CIVIL ENGINEER  
PREMIER DESIGN GROUP  
100 MIDLAND PARK DRIVE  
WENTZVILLE, MO 63385  
314.925.7444  
MAINTENANCE CONSULTANT  
HDR ENGINEERING, INC.  
17725 KATY FREEWAY SUITE 102  
HOUSTON, TX 77064  
816.360.2700  
STRUCTURAL ENGINEER  
METTEMAYER ENGINEERING  
2225 W CHESTERFIELD BLVD., SUITE 300  
SPRINGFIELD, MO 65807  
417.890.8002  
MEP ENGINEER  
HENDERSON ENGINEERS, INC.  
8345 LENEKA DR., #300  
LENEKA, KS 66214  
913.742.5000

## FLOOR BOX SCHEDULE

PLAN MARK	MANUFACTURER	ALTERNATE MANUFACTURER	TRIM	COVER	DESCRIPTION	POWER				DATA			AV			NOTES
						GANG(S)	DEVICE QTY	DEVICE TYPE	CONDUIT SIZE (IN)	CONDUIT QTY	GANG(S)	CONDUIT SIZE (IN)	CONDUIT QTY	GANG(S)	CONDUIT SIZE (IN)	
F	FSR	WIREMOLD HUBBELL STEEL CITY	TBD	FL-500P SERIES	SHALLOW MULTI GANG RECTANGLE BOX	1	1	DUPLEX TR								
						1			1	1	1	1	1	1-1/4"	1	


Notes:

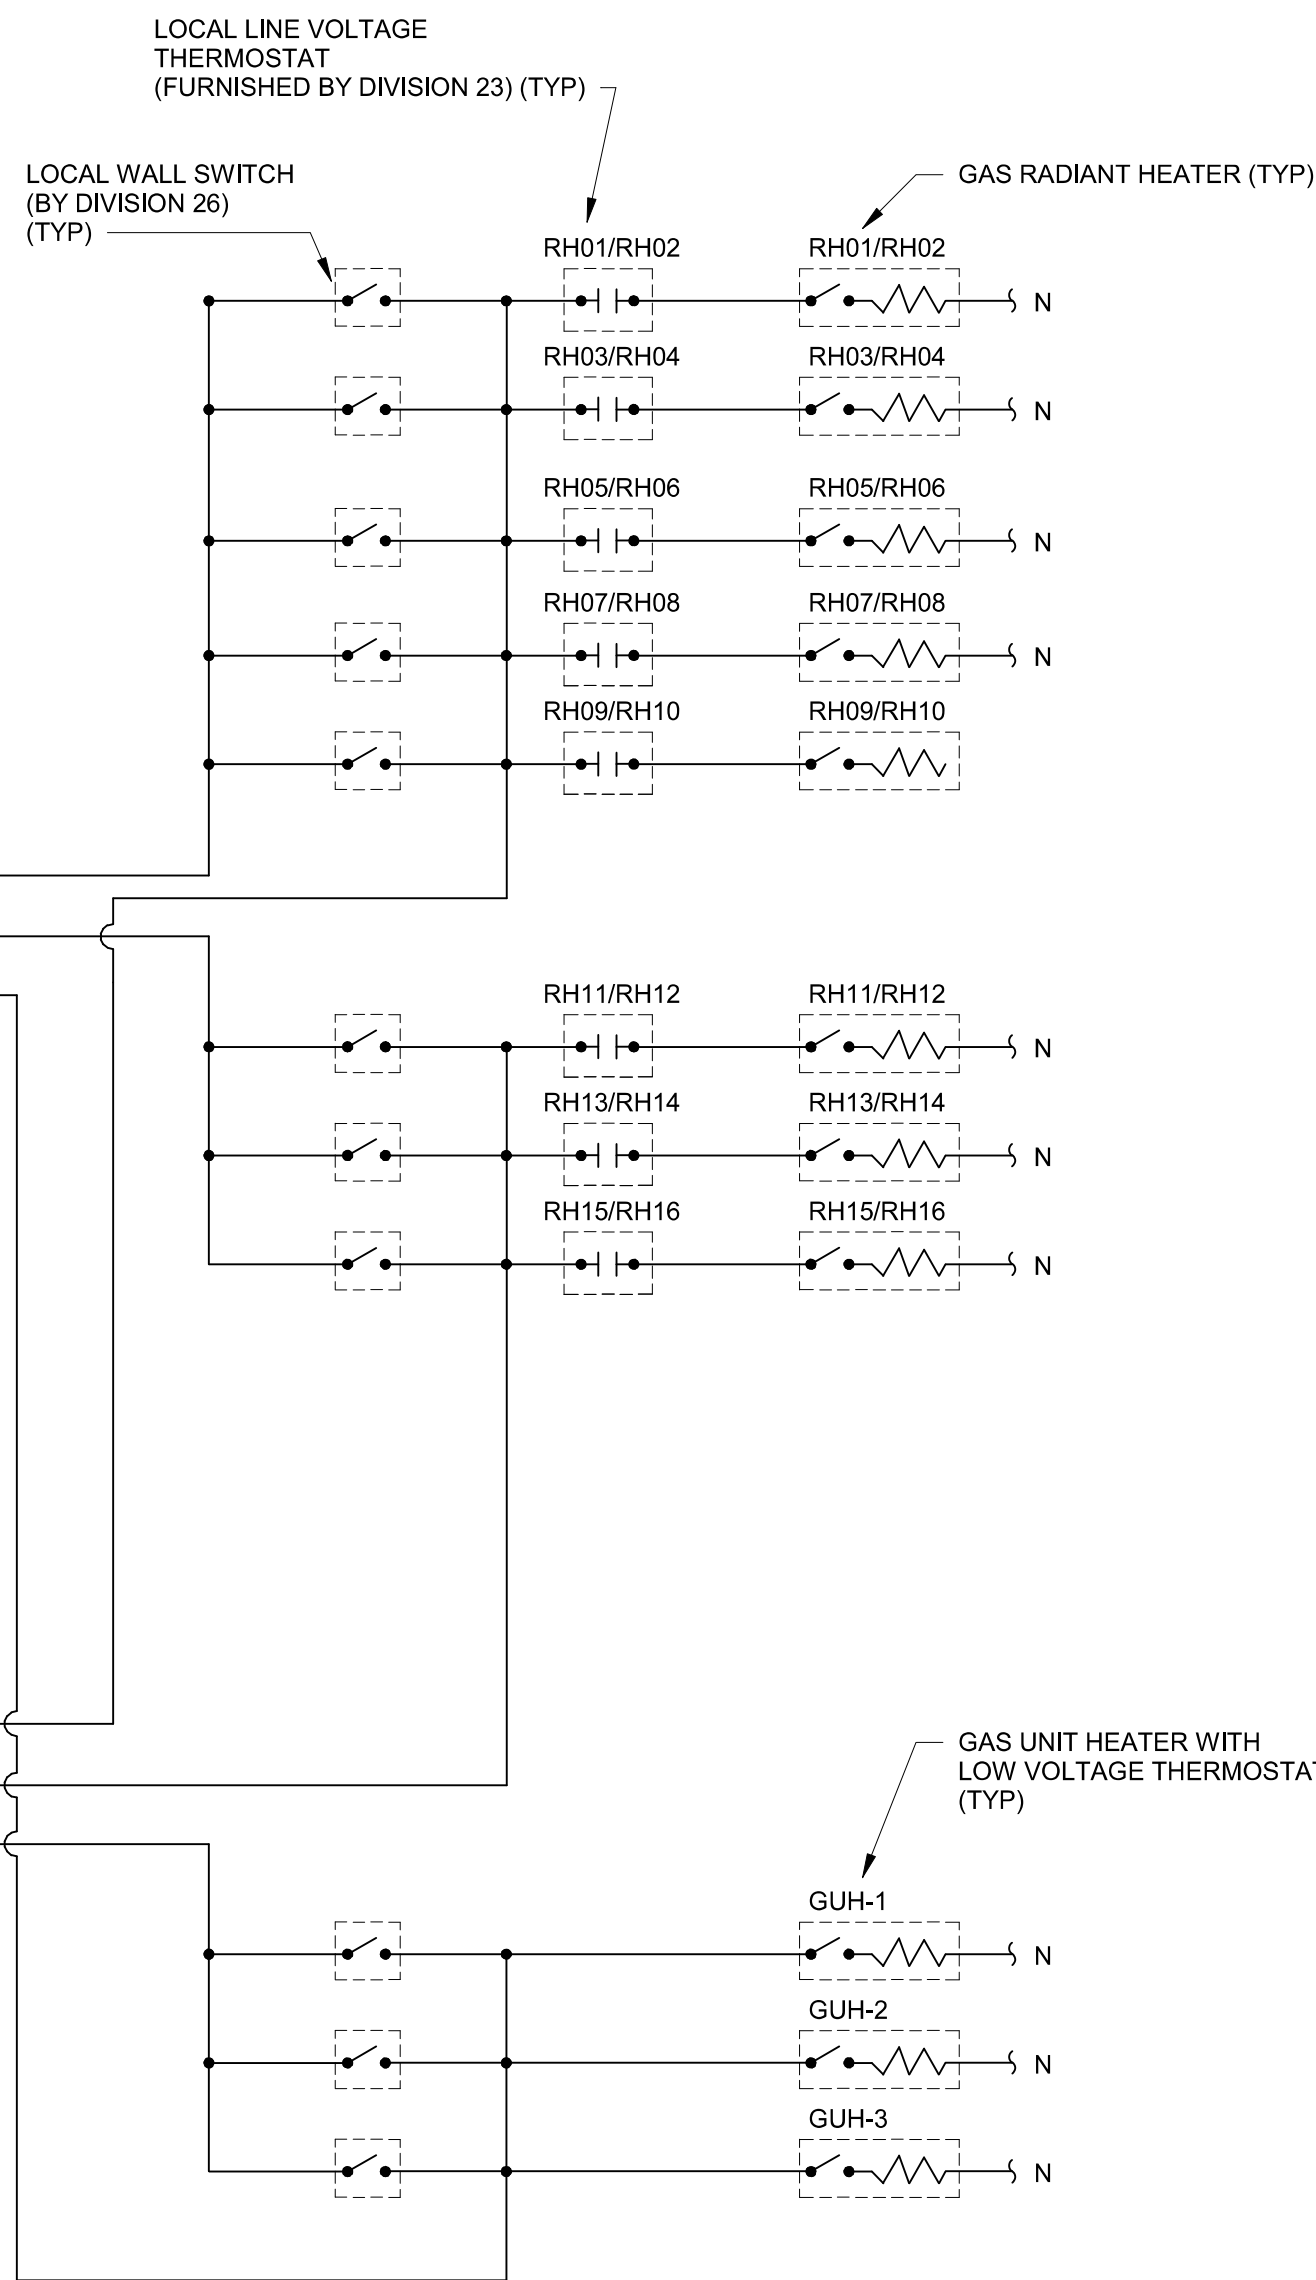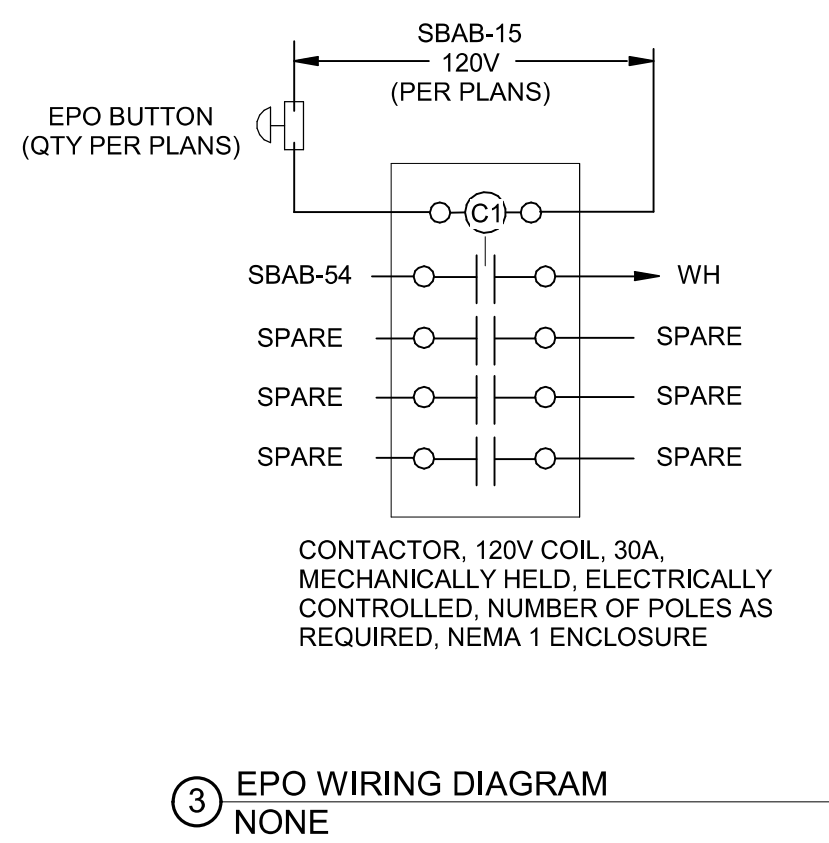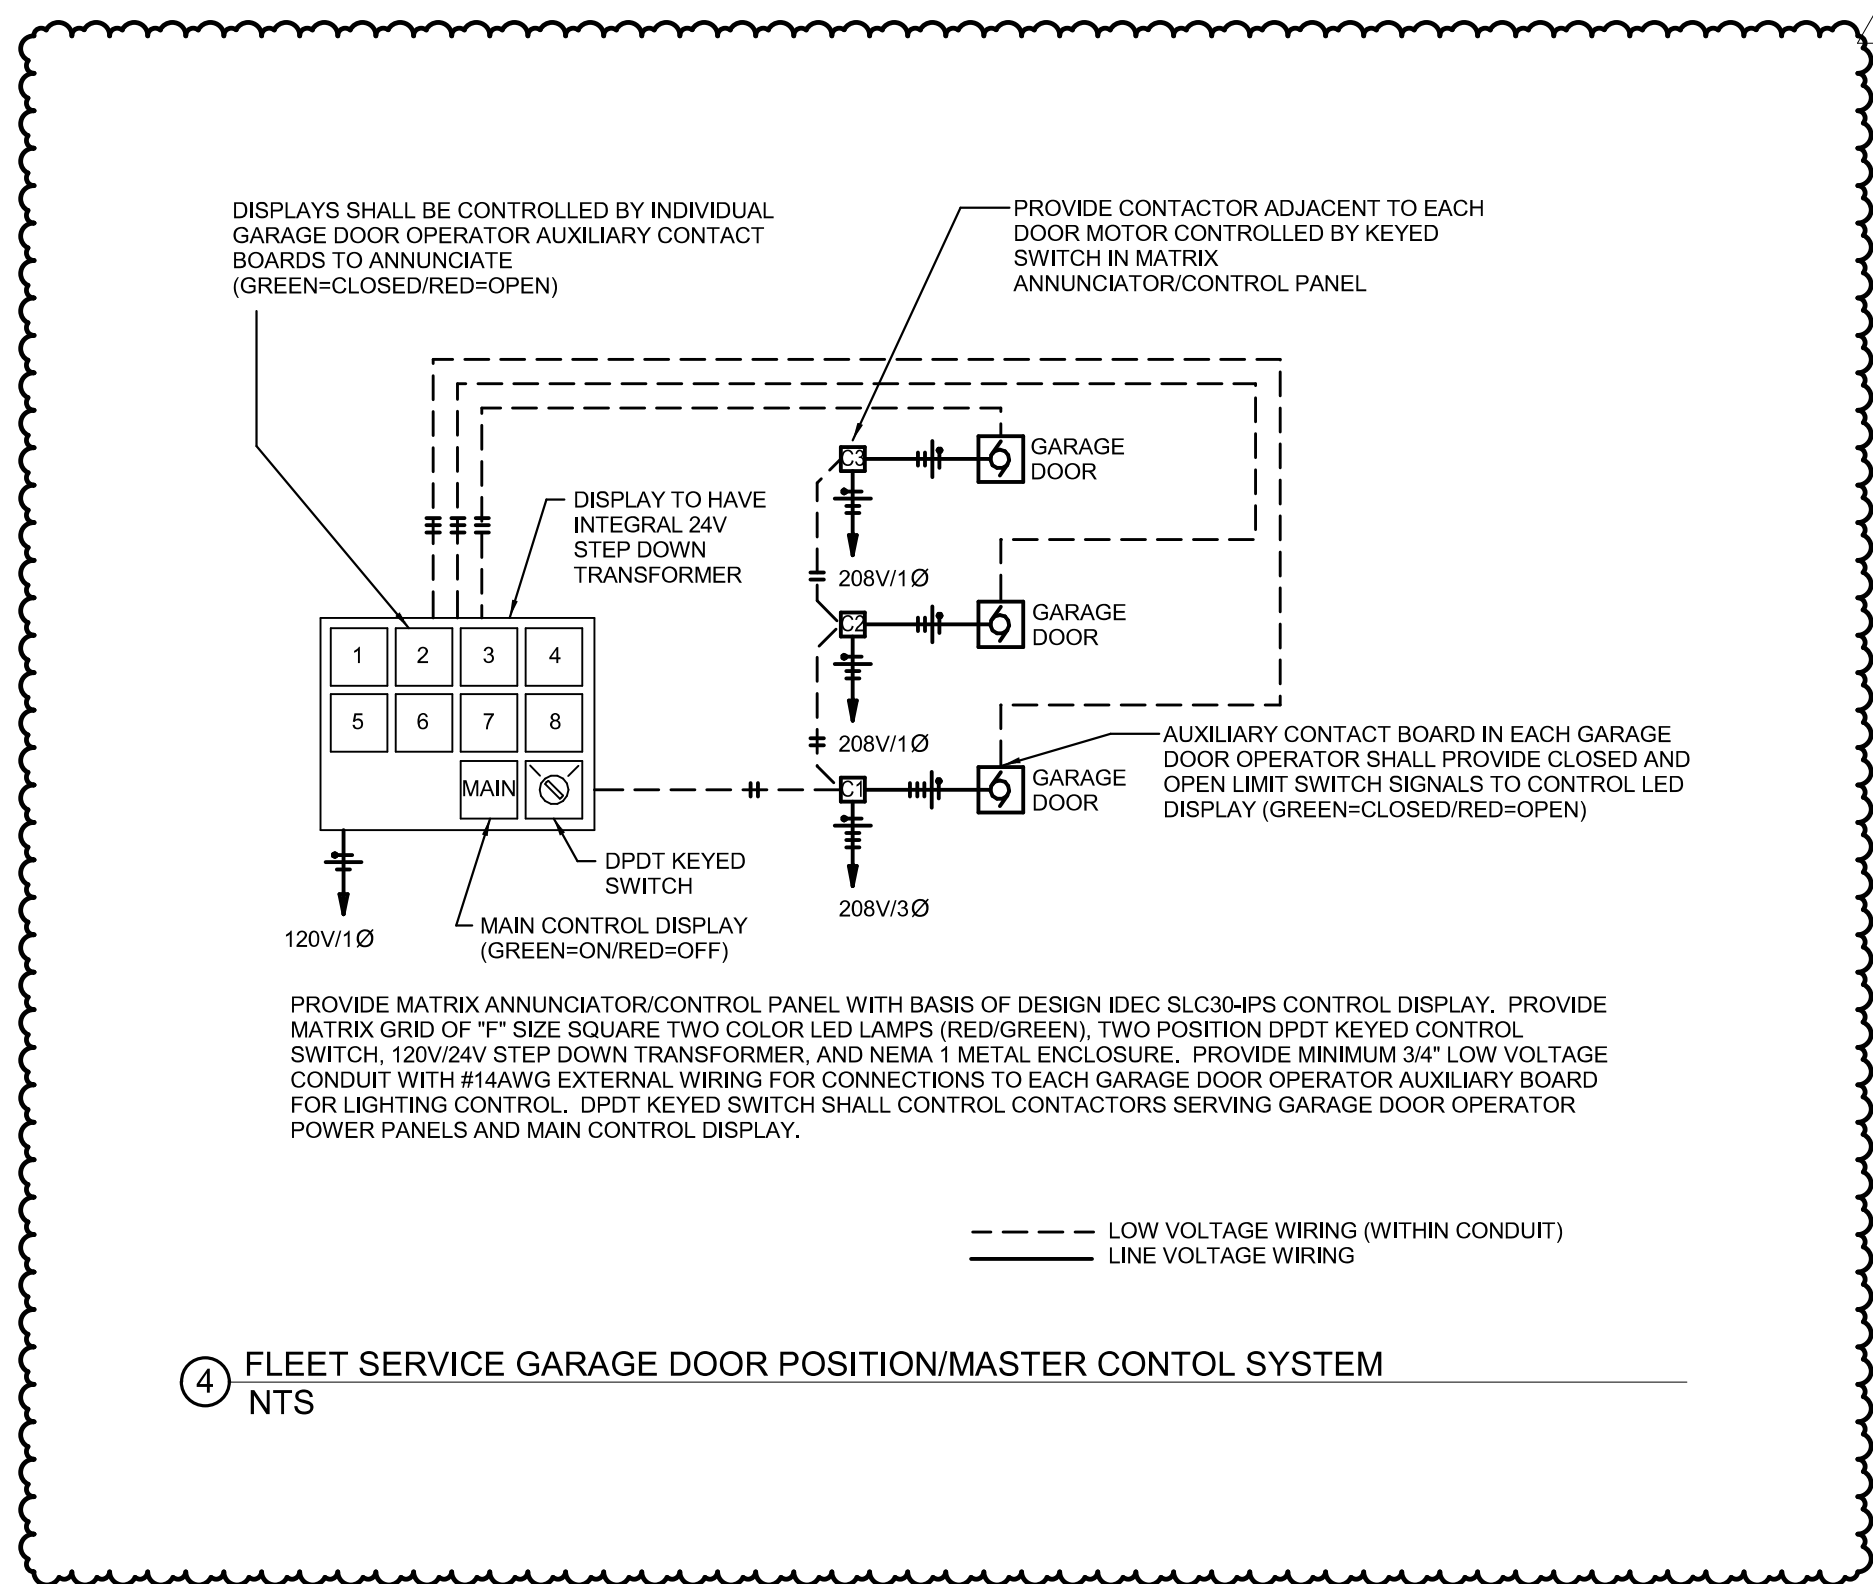

CONTACTOR SCHEDULE				
PANEL NAME:	C1	ELECTRICAL ROOM	MOUNTING:	SURFACE
LOCATION:			VOLTAGE:	120V
RELAY	CIRCUIT	LOAD CONTROLLED	MODULE TYPE	LOAD (WATTS)
R1	SBFA-2	HEATERS RH01 THROUGH RH10	ON/OFF	168
R2	SBFA-4	HEATERS RH11 THROUGH RH22	ON/OFF	168
R3	SBFA-6	HEATERS GUH1 THROUGH GUH3	ON/OFF	1500
R4	-	SPARE	-	-
R5	-	SPARE	-	-
R6	-	SPARE	-	-

CONTACTOR SCHEDULE				
PANEL NAME:	C2	ELECTRICAL ROOM	MOUNTING:	SURFACE
LOCATION:			VOLTAGE:	120V
RELAY	CIRCUIT	LOAD CONTROLLED	MODULE TYPE	LOAD (WATTS)
R1	SBFA-2	HEATERS RH01 THROUGH RH10	ON/OFF	168
R2	SBFA-4	HEATERS RH11 THROUGH RH16	ON/OFF	168
R3	SBFA-6	HEATERS GUH1 THROUGH GUH3	ON/OFF	1500
R4	-	SPARE	-	-
R5	-	SPARE	-	-
R6	-	SPARE	-	-

① HEATER CONTROL WIRING DIAGRAM  
NONE

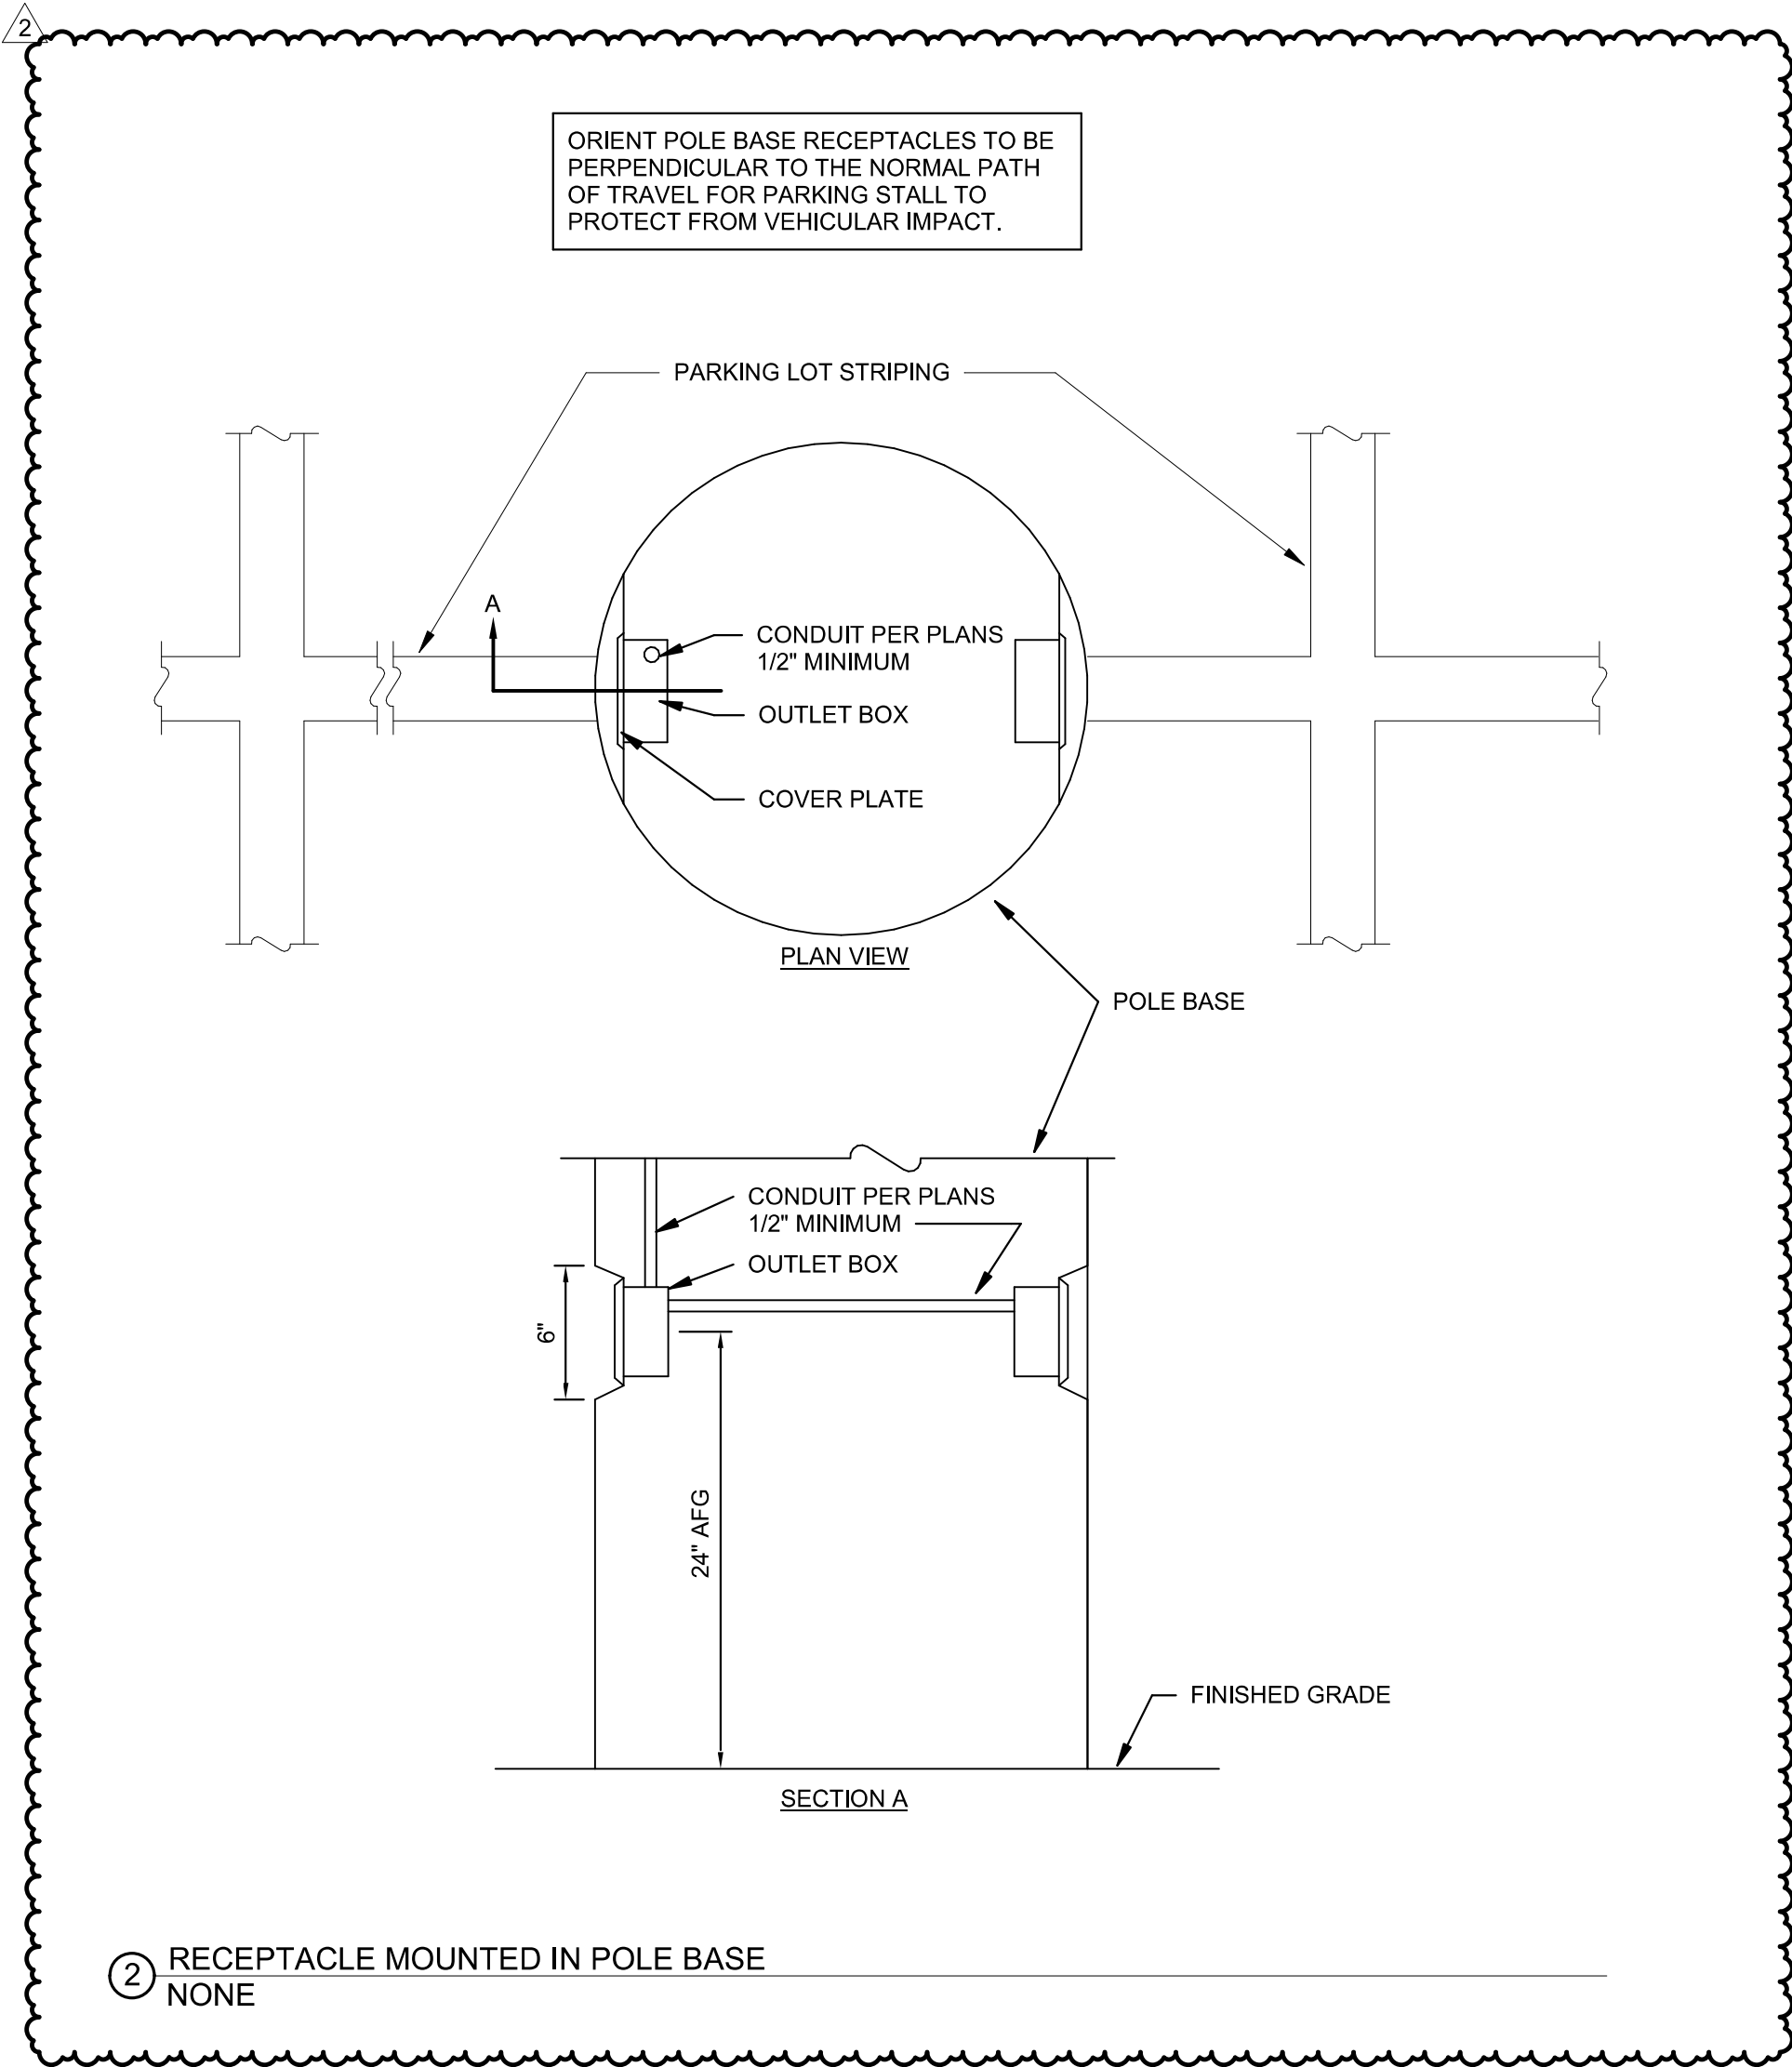

REVISIONS		
NO.	DESCRIPTION	DATE
2	ADD 02	01.25.23

PROJECT NO.: 19-040 DRAWN BY: Author  
DATE: 12.15.22 REVIEWED BY: Checker



01/24/2023


DOUGLAS M. EVERHART  
LICENSE # PE-2019007648

**PROJECT TITLE**  
CITY OF WENTZVILLE, MO PUBLIC WORKS FACILITY

PROJECT ADDRESS:  
1295 INTERSTATE DRIVE  
WENTZVILLE, MO 63385

**ELECTRICAL DETAILS AND SCHEDULES**



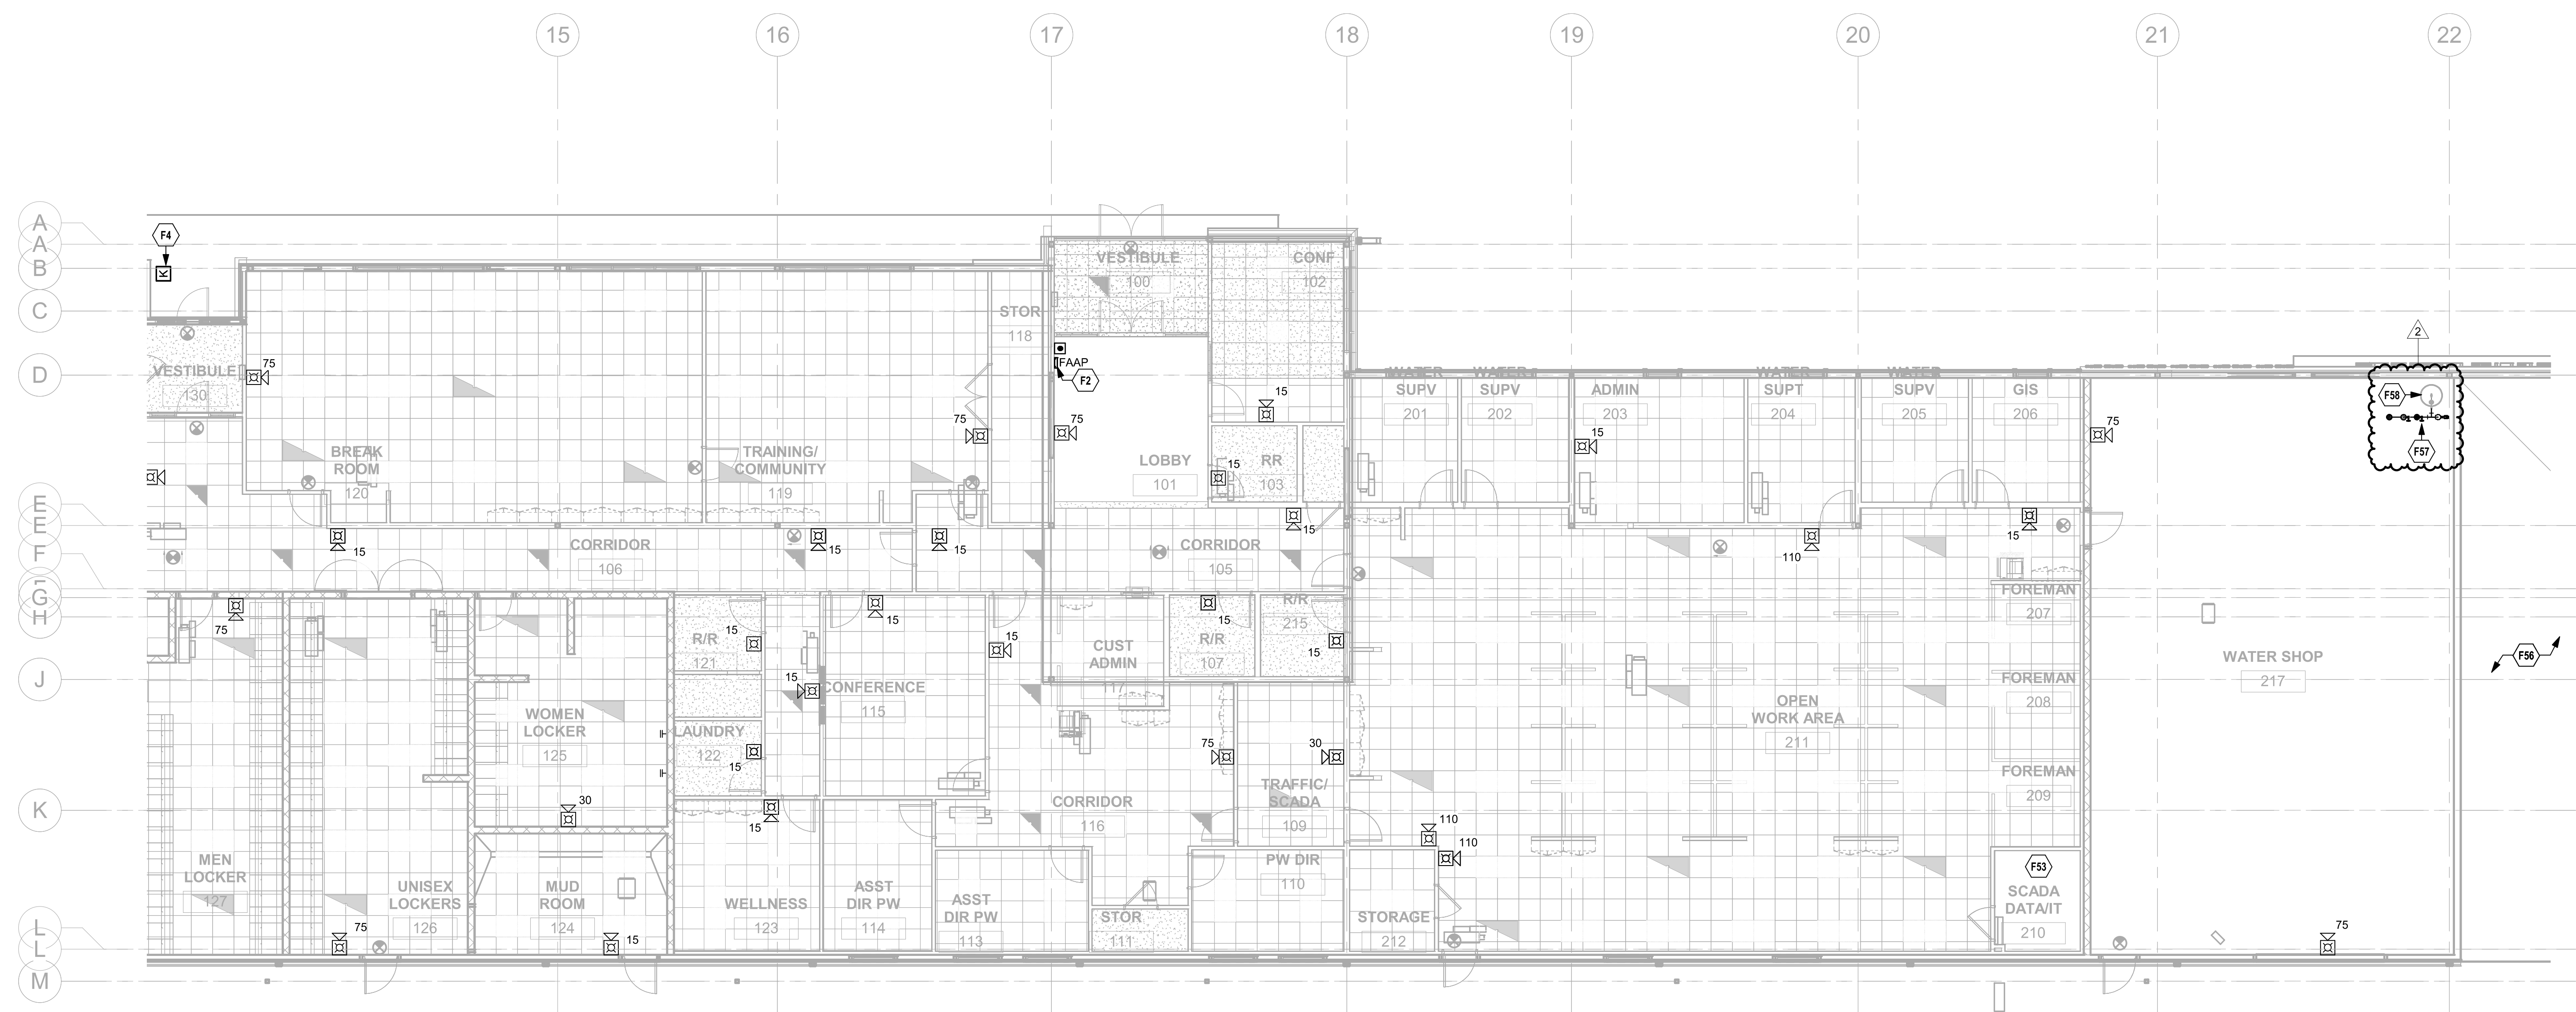

① FIRE PROTECTION LEVEL 1 PLAN - AREA A  
1/8" = 1'-0"



 **FIRE PROTECTION PLAN NOTES:**


F2 PROVIDE NEW REMOTE FIRE ALARM ANNUNCIATOR PANEL

F4 PROVIDE FIRE DEPARTMENT KEY BOX FOR FIRE DEPARTMENT ACCESS. PROVIDE EQUIPMENT AND CONNECTIONS NECESSARY TO MONITOR KEY BOX INTERNAL SUPERVISORY SWITCH(ES), AS REQUIRED.

F53 INSTALL SPRINKLER PIPING TIGHT TO STRUCTURE.

F56 PROTECT AREA BELOW EXTERIOR CANOPY PROJECTION WITH ANTIFREEZE WET-PIPE SPRINKLER SYSTEM.

F57 PROVIDE WET SYSTEM WITH TYCO LFP ANTIFREEZE PLUS PER NFPA 13 STANDARD AND MANUFACTURER REQUIREMENTS.

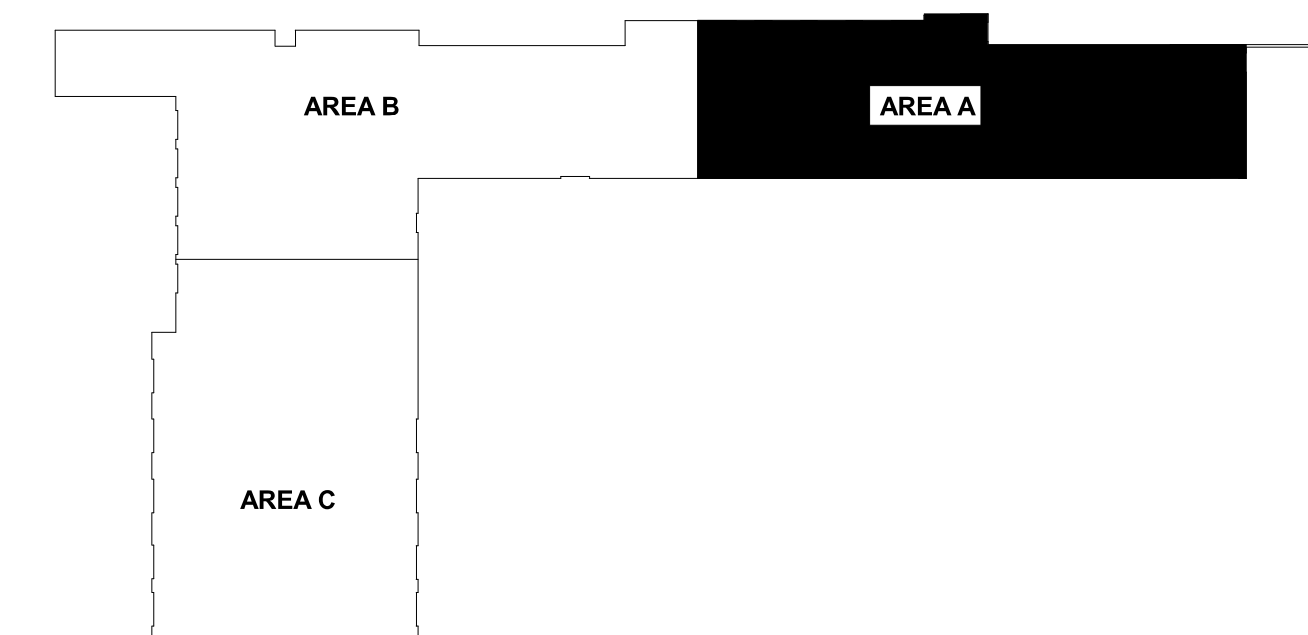

KEY PLAN 



5039 S National Avenue | Springfield, MO 65810 | 417.887.6595

**OWNER**  
CITY OF WENTZVILLE, MISSOURI  
1001 SCHROEDER CREEK BLVD  
WENTZVILLE, MO 63385  
636.327.5101

## PROJECT TEAM

CIVIL ENGINEER  
PREMIER DESIGN GROUP  
100 MIDLAND PARK DRIVE  
WENTZVILLE, MO 63385  
314.925.7444

MAINTENANCE CONSULTANT  
HDR ENGINEERING, INC.  
17725 KATY FREEWAY SUITE 102  
HOUSTON, TX 77094  
816.360.2700

STRUCTURAL ENGINEER  
METTEMAYER ENGINEERING  
2225 W CHESTERFIELD BLVD., SUITE 300  
SPRINGFIELD, MO 65807  
417.890.8002

MEP ENGINEER  
HENDERSON ENGINEERS, INC.  
8345 LENEXA DR., #300  
LENEXA, KS 66214  
913.742.5000



8345 LENEXA DRIVE, SUITE 300  
LENEXA, KS 66214  
TEL 913.742.5000 FAX 913.742.5001  
[WWW.HENDERSONENGINEERS.COM](http://WWW.HENDERSONENGINEERS.COM)

1950004840  
EXPIRES 12/31/2023

## REVISIONS

[illegible]

PROJECT NO.: 19-040 DRAWN BY: KPM  
DATE: 12.15.22 REVIEWED BY: HEI



CHRISTOPHER J. CULP  
LICENSE # PE-2013037646

**PROJECT TITLE**  
**CITY OF WENTZVILLE, MO PUBLIC**  
**WORKS FACILITY**

PROJECT ADDRESS:  
1295 INTERSTATE DRIVE  
WENTZVILLE, MO 63385


**FIRE PROTECTION LEVEL 1 PLAN -  
AREA A**

SHEET


FP101A



## PROJECT TEAM

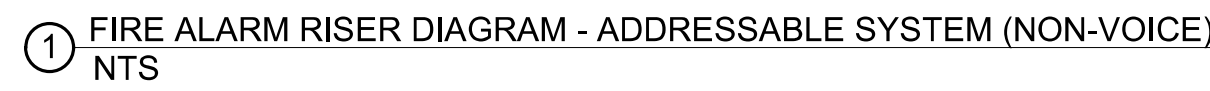


## ④ FIRE ALARM SEQUENCE OF OPERATIONS NTS

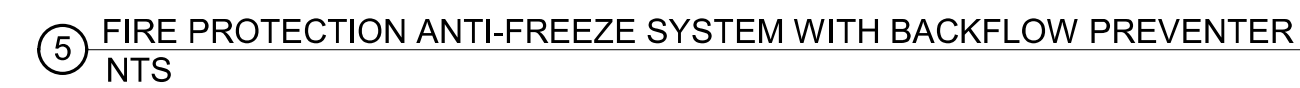

1950004840  
EXPIRES 12/31/2023

PROJECT NO.: 19-040 DRAWN BY: Author  
DATE: 12.15.22 REVIEWED BY: Checker

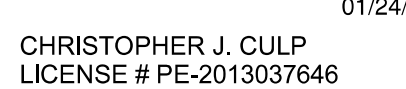

## FIRE PROTECTION DETAILS


SHEET  
FP500

## PROJECT TEAM

MEP ENGINEER  
HENDERSON ENGINEERS, INC.  
8345 LENEXA DR., #300  
LENEXA, KS 66214  
913.742.5000

## REVISIONS

PROJECT NO.: 19-040 DRAWN BY: KZ  
DATE: 12.15.22 REVIEWED BY: RLR

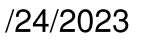

PROJECT ADDRESS:  
1295 INTERSTATE DRIVE  
WENTZVILLE, MO 63385

TN100

